


- 1) MFD notes shall refer to Supplier Operating Conditions.
2) For Meter Operating Conditions please look at Meter & Mass Balance Doc. # 1555-204.
3)
4)
5)
6)
7)
8)

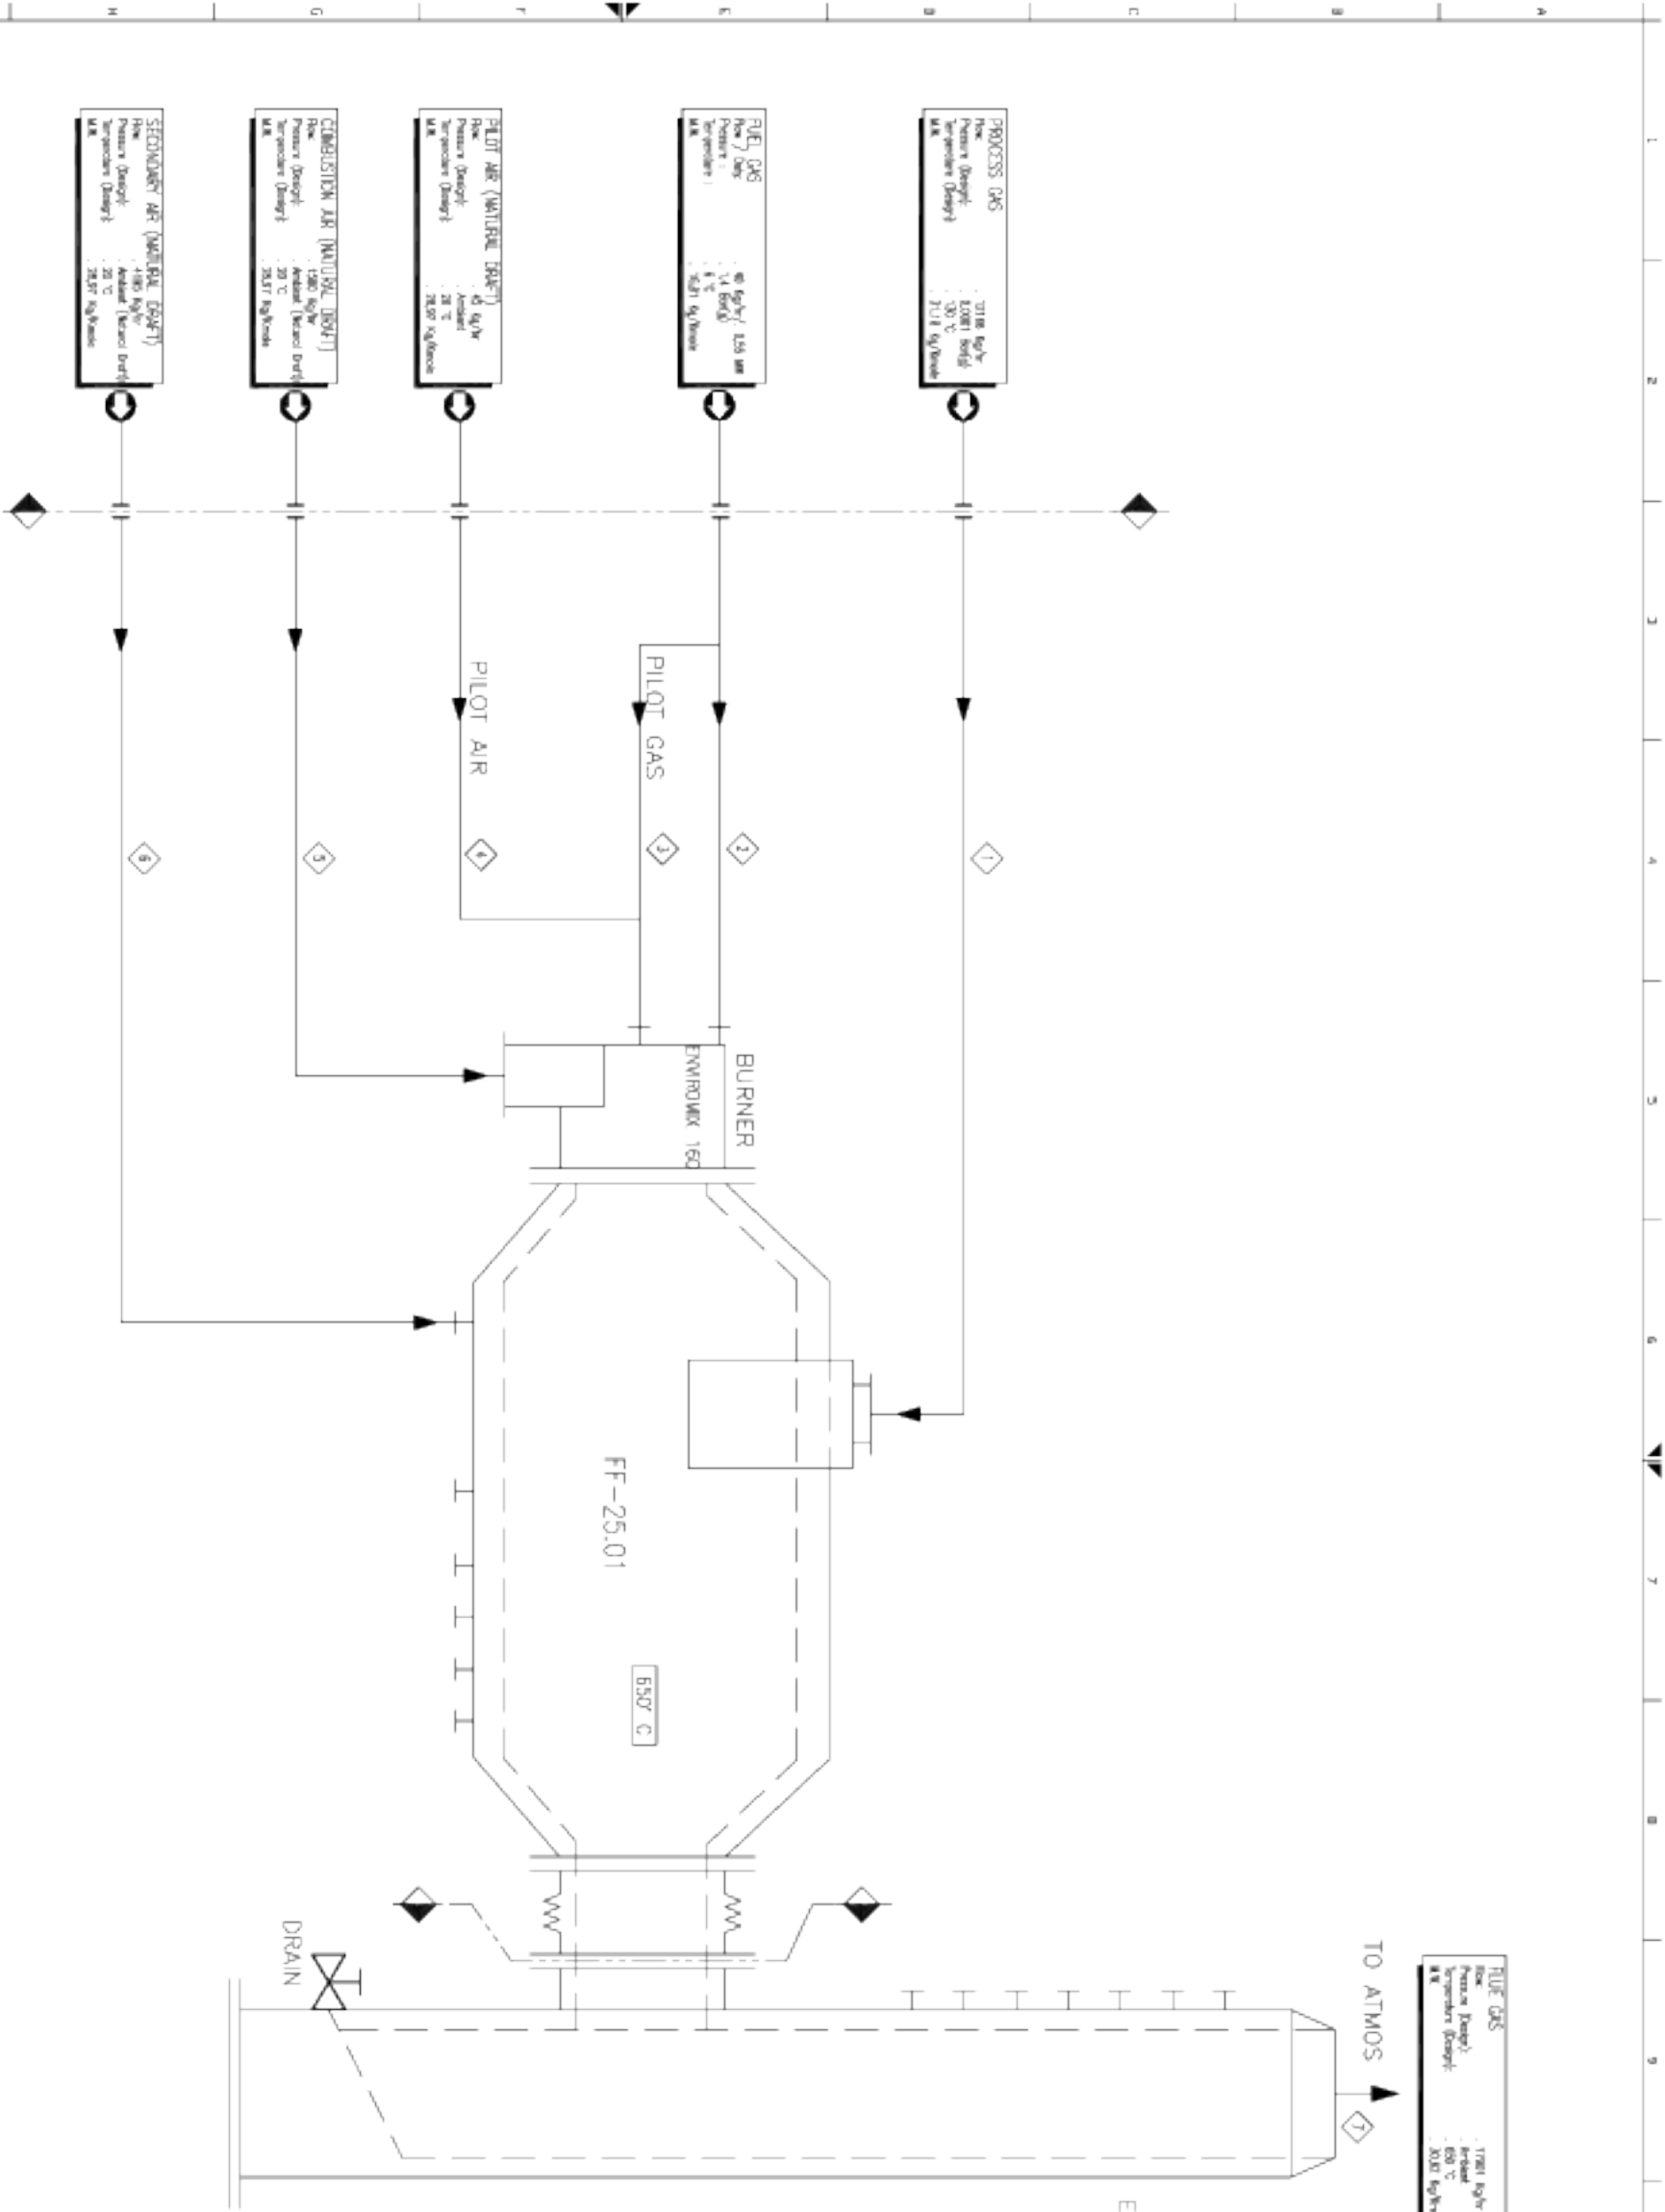

FINAL
CERTIFIED

DATE	07/03/2018	Rev. 1	LOCATION	CANADA
CLIENT	HAMMORTHY CONSTRUCTION ENGINEERING SRL			
PROJECT	PROCESS FLOW DIAGRAM			
DESIGNER	N. 1505-101			
CHECKER	11/04/17-6540			
APPROVER	11/04/17-6540			
SCALE	1:1			
UNIT	mm			
PROJECT	PROCESS FLOW DIAGRAM			
DESIGNER	N. 1505-101			
CHECKER	11/04/17-6540			
APPROVER	11/04/17-6540			
SCALE	1:1			
UNIT	mm			