


SECTION 19-19

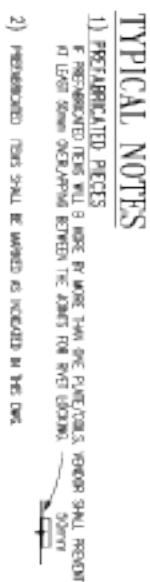

FOR ASSEMBLY SEE DWG 1565-109

[illegible]