



THIS DRAWING IS THE EXCLUSIVE PROPERTY OF MACTRONIC A DIVISION OF FLARE INDUSTRIES AND MAY NOT BE REPRODUCED WITHOUT PERMISSION

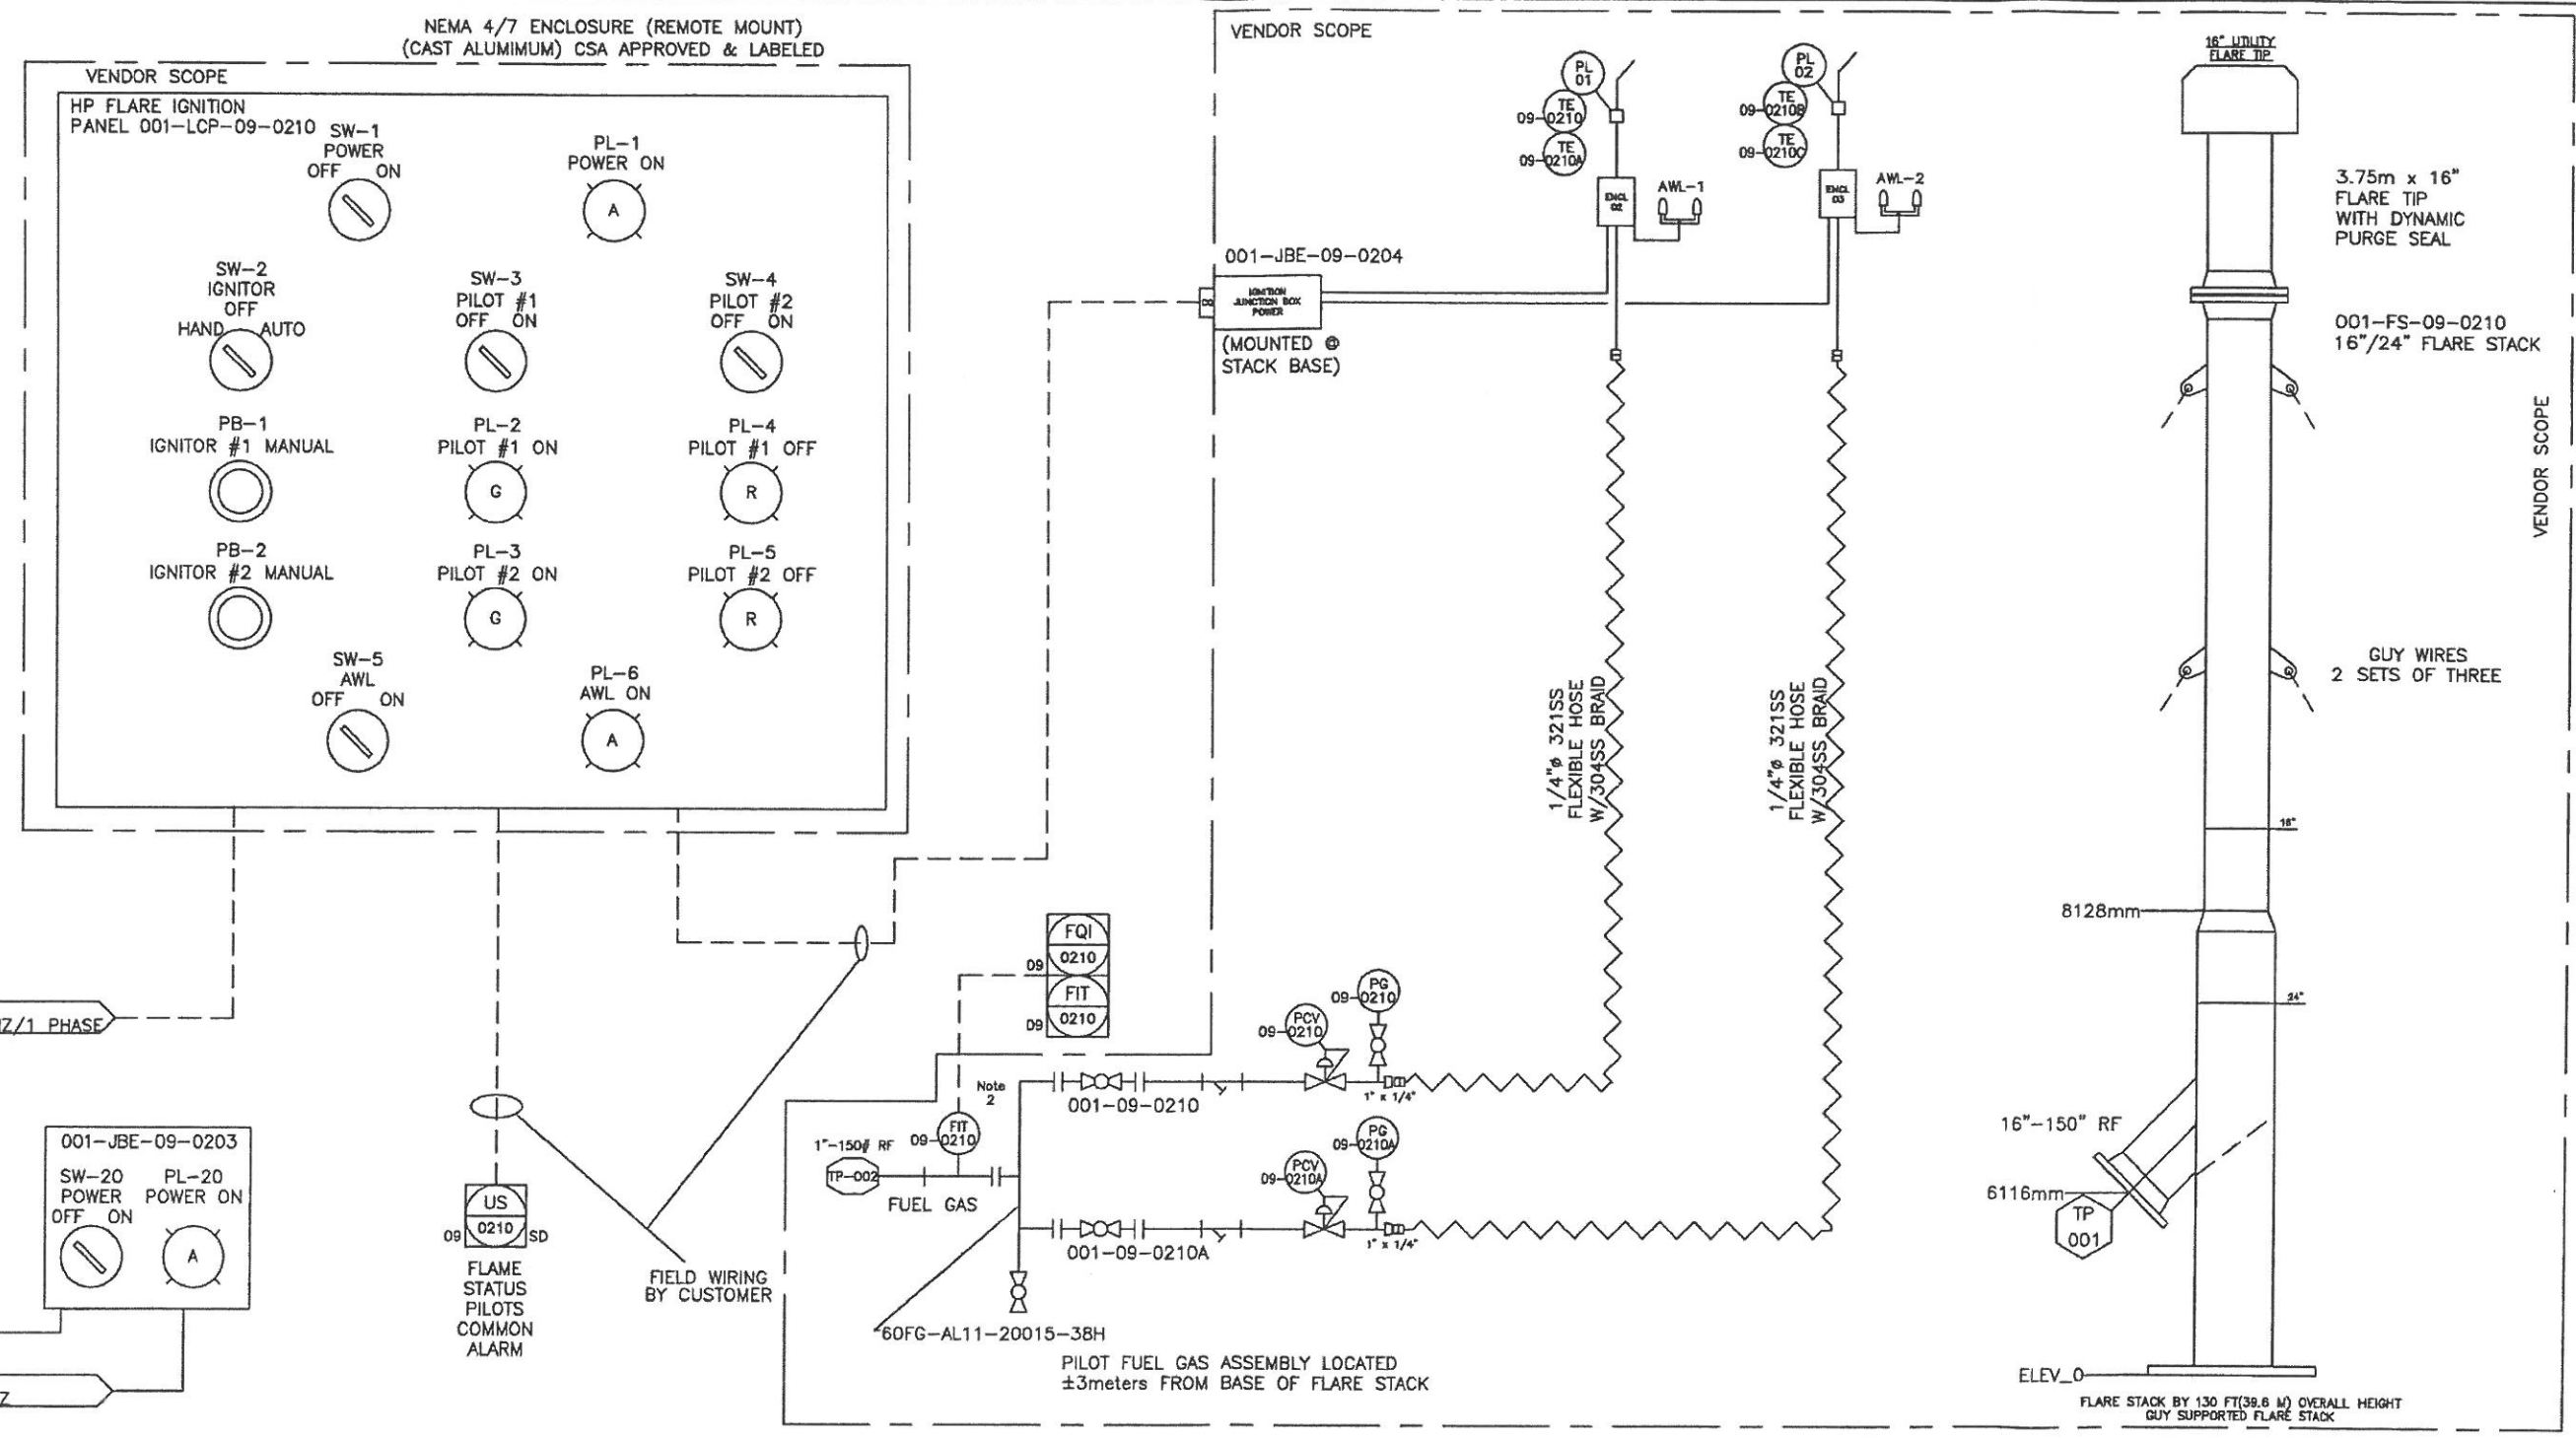

TP-001	16"-150#	FLARE STACK INLET
TP-002	1"-150#	PILOT FUEL INLET

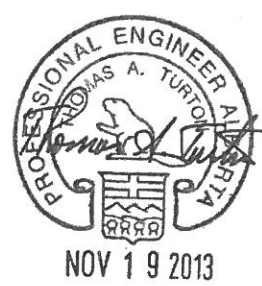

- NOTES:
- 1) ALL INSTRUMENTS TAGS SHALL BE READ AS FULL TAG NUMBERS
EG:001-PCV-01-0210
 - 2) THERMO-MASS FLOW METER

REV	DATE	DESCRIPTION	BY
0	25-JUN-13	APPROVAL	SS
1	17-AUG-13	FABRICATION	SS
2	10-SEP-13	FABRICATION	SS
3	24-SEP-13	FABRICATION	SS
4	24-OCT-13	FABRICATION	SS
5	15-NOV-13	AS-BUILT	SS

MACTRONIC A DIVISION OF FLARE INDUSTRIES			
CLIENT: DEVON			
LOCATION:	11-02-36-08 WS	P.O.:	4100001351
PROJECT:	FERRIER	TAG:	001-FS-09-0210
TITLE: PIPING, INSTRUMENTATION DIAGRAM FOR COB-HP FLARE			
DRAWN BY:	SS	CHECKED BY:	DP
APP. BY:	DP	PROJECT BY:	DP
JOB ORDER:	13-0138	SCALE:	N.T.S
DRAWING NUMBER:	13-0138-COB-HP-PID	REV:	5