


PLOT 05 Jun, 2014-4:40pm, gphl THE INFORMATION CONTAINED HEREIN IS THE CONFIDENTIAL PROPERTY OF ENERFLEX, LTD. AND IS NOT FOR PUBLICATION, AND NO PART THEREOF SHALL BE COPIED OR COMMUNICATED TO A THIRD PARTY WITHOUT AUTHORIZATION FROM ENERFLEX, LTD.

002-E-06-1014
CONDENSATE PRODUCT COOLER
MAWP: 1379 KPAG @ 149°C
(200 PSIG @ 300°F)
MDMT: -45°C @ 1379 KPAG
(-49°F @ 200 PSIG)
SURFACE: 2638
DESIGN DUTY: 614800 BTU/HR
SECTION WEIGHT: 612 KG (1350 LB)

002-E-06-1015
AC COOLER SECTION
MAWP: 1379 KPAG @ 149°C
(200 PSIG @ 300°F)
MDMT: -45°C @ 1379 KPAG
(-49°F @ 200 PSIG)
SURFACE: 485
DESIGN DUTY: 67886 BTU/HR
SECTION WEIGHT: 227 KG (500 LB)

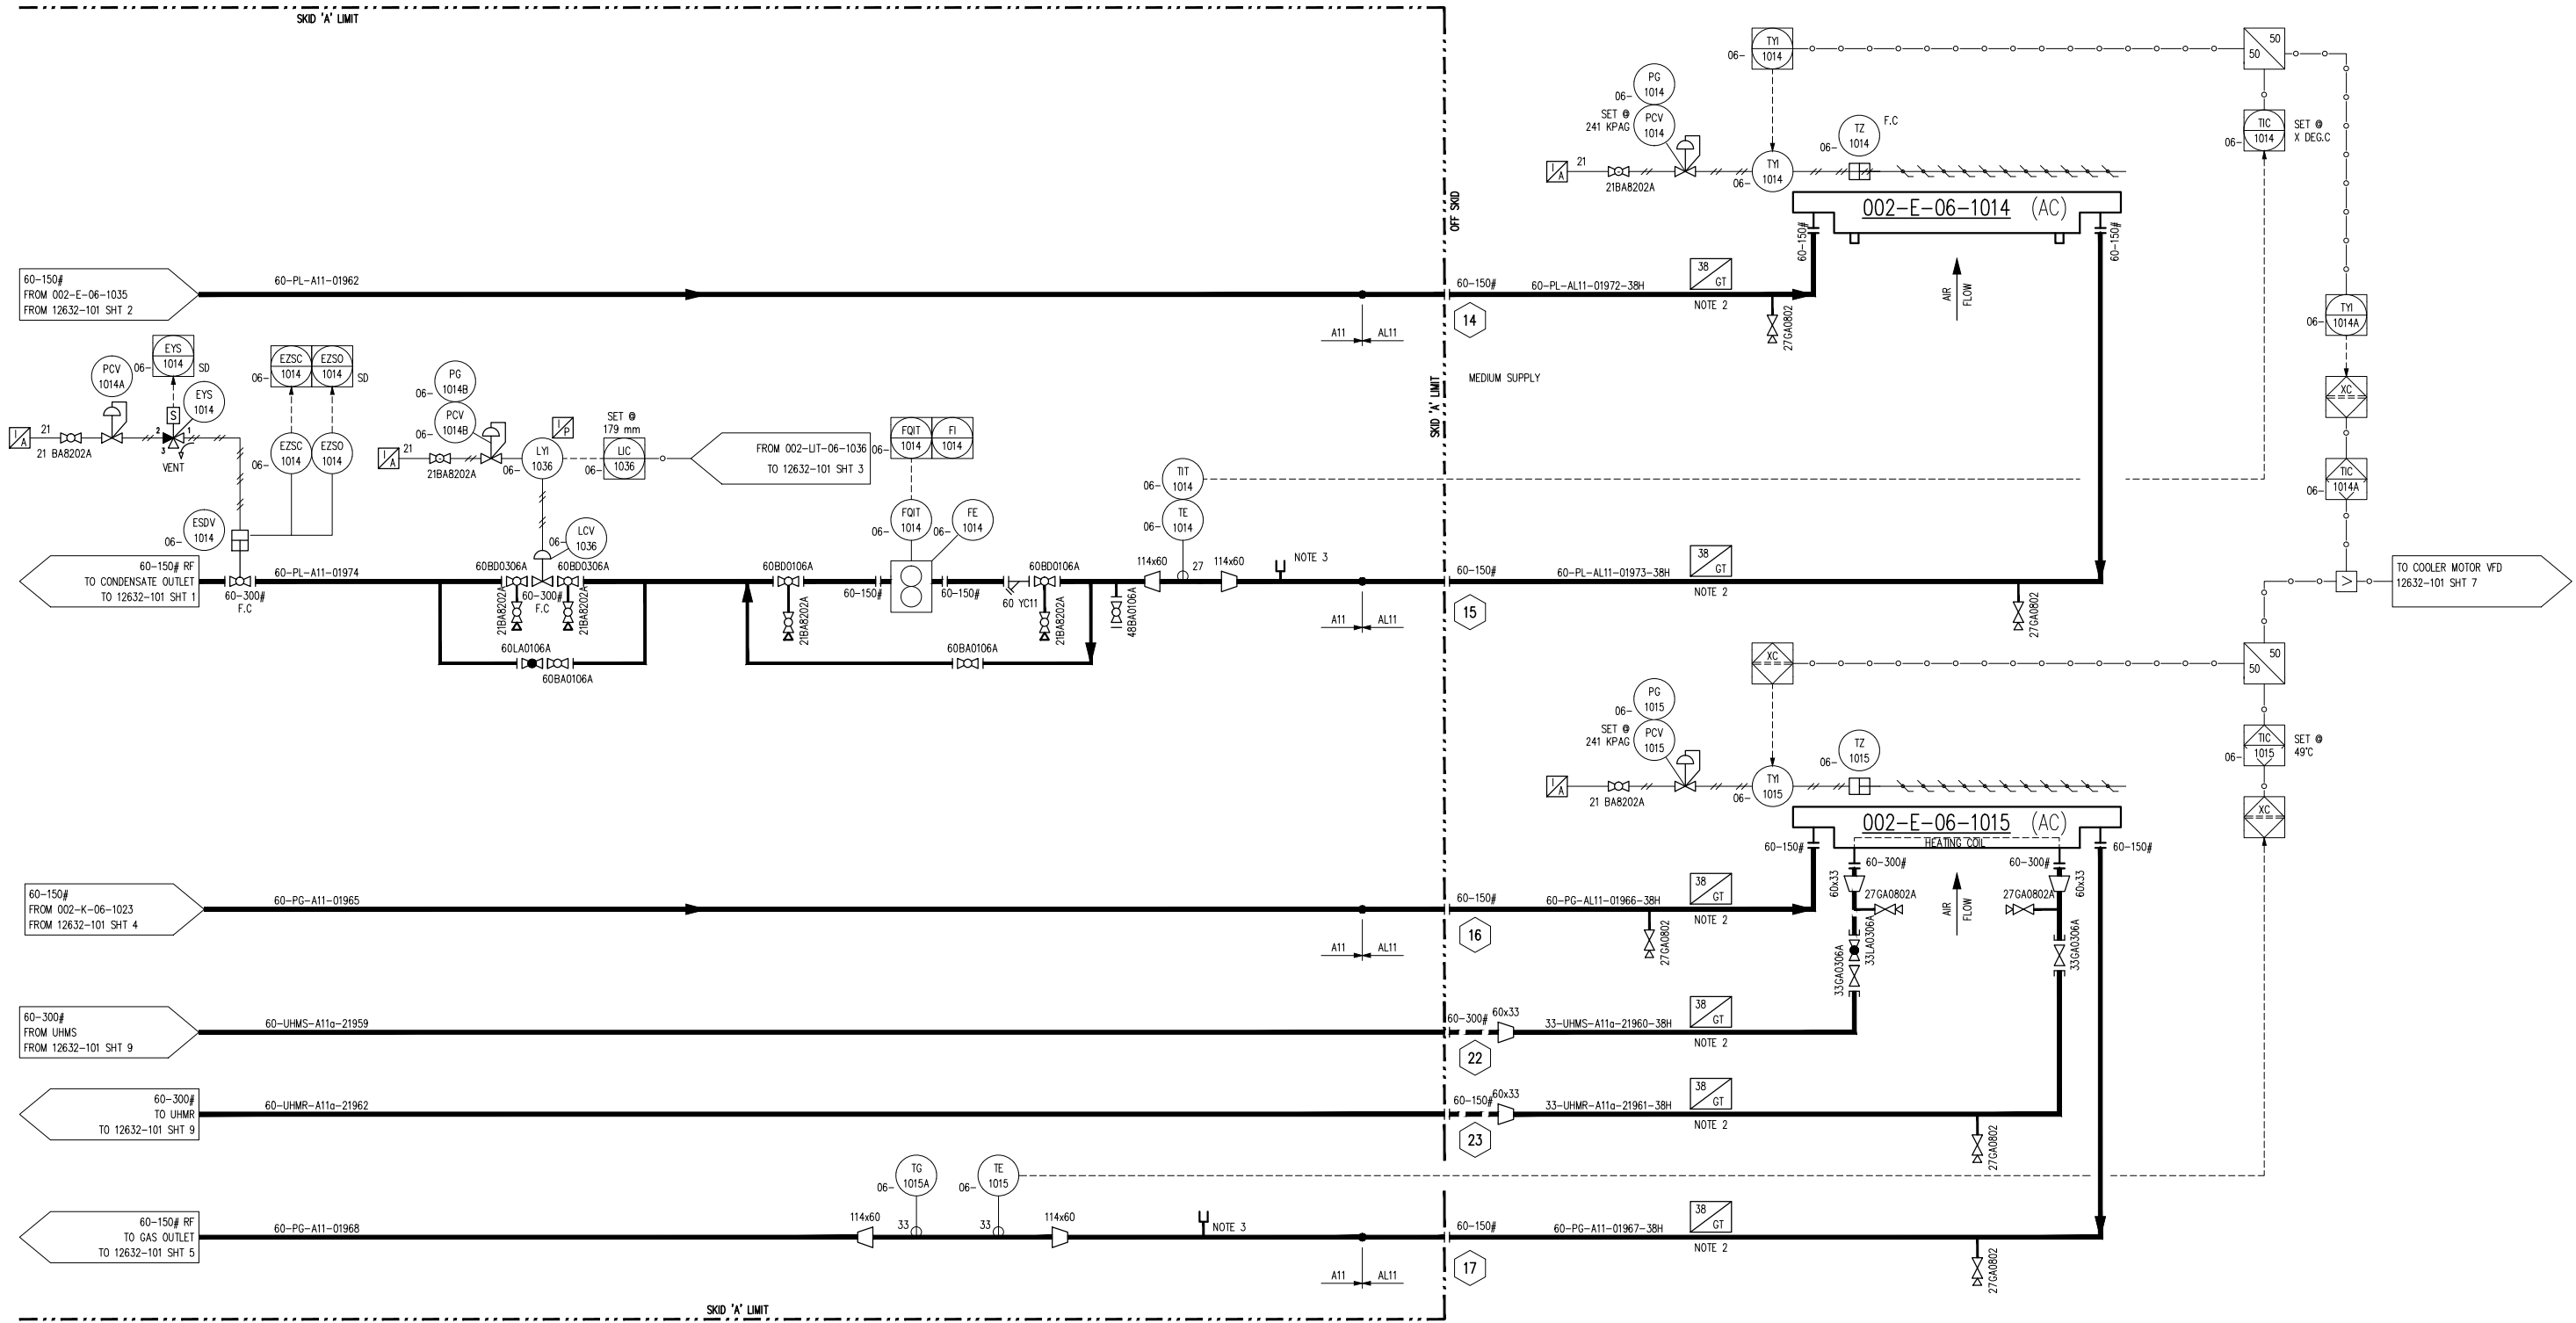

**FINAL
AS BUILT**
NAME: G.PAHL DATE: JUN 05/14

NOTES:

-
- INSULATION BY OTHERS.
- CORROSION COUPONS, BUTTWELD FLAT

4	AS BUILT - NO CHANGE	JUN 05/14	GP	SG	DATE	MAY 09/13	SCALE	NTS
3	AS BUILT	MAY 23/14	TW	SG	DRAWN BY	C.SMITH	CHECKED BY	S.GURI
2	ISSUED FOR CONSTRUCTION	FEB 02/14	GP	SG	PROJECT MANAGER	B.MINSHULL	PROJECT ENGINEER	S.GURI
1	ISSUED FOR CONSTRUCTION	OCT 25/13	CS	SG	CUST PO	4100001327		
0	ISSUED FOR CONSTRUCTION	OCT 24/13	CS	SG				
B	ISSUED FOR HAZOP	AUG 06/13	AT	SG				
REV	DESCRIPTION	DATE	BY	APR	APEGGA PERMIT No:	P8651	OPER. CODE	WORK ORDER

DEVON CANADA CORPORATION
FERRIER CENTRAL
PROCESSING FACILITY
CONDENSATE STABILIZER

ENERFLEX
Calgary, Alberta,
Canada

P & I DIAGRAM
PROCESS GAS
COOLER/DISCH. COALESCER

DWG NO 12632-101

SHT 6

REV 4