


PLOT 05 Jun, 2014-4:40pm. gphl THE INFORMATION CONTAINED HEREIN IS THE CONFIDENTIAL PROPERTY OF ENERFLEX, LTD. AND IS NOT FOR PUBLICATION, AND NO PART THEREOF SHALL BE COPIED OR COMMUNICATED TO A THIRD PARTY WITHOUT AUTHORIZATION FROM ENERFLEX, LTD.

002-V-06-1018
DISCHARGE COALESCING FILTER

MFG: ENERFLEX LTD.
SIZE: 203mm (8") x 1346mm (53") ss
MAWP: 1583 KPAG @ 149°C
(230 PSIG @ 300°F)
MDMT: -29°C @ 1583 KPAG
(-20°F @ 230 PSIG)

CA: 1.6mm (1/16")
ELEMENT: JPMG-318-CE-R
SHELL MATERIAL: SA-106-B
HEAD MATERIAL: SA-105/SA-234-WPB
VESSEL RATED FOR FULL VACUUM

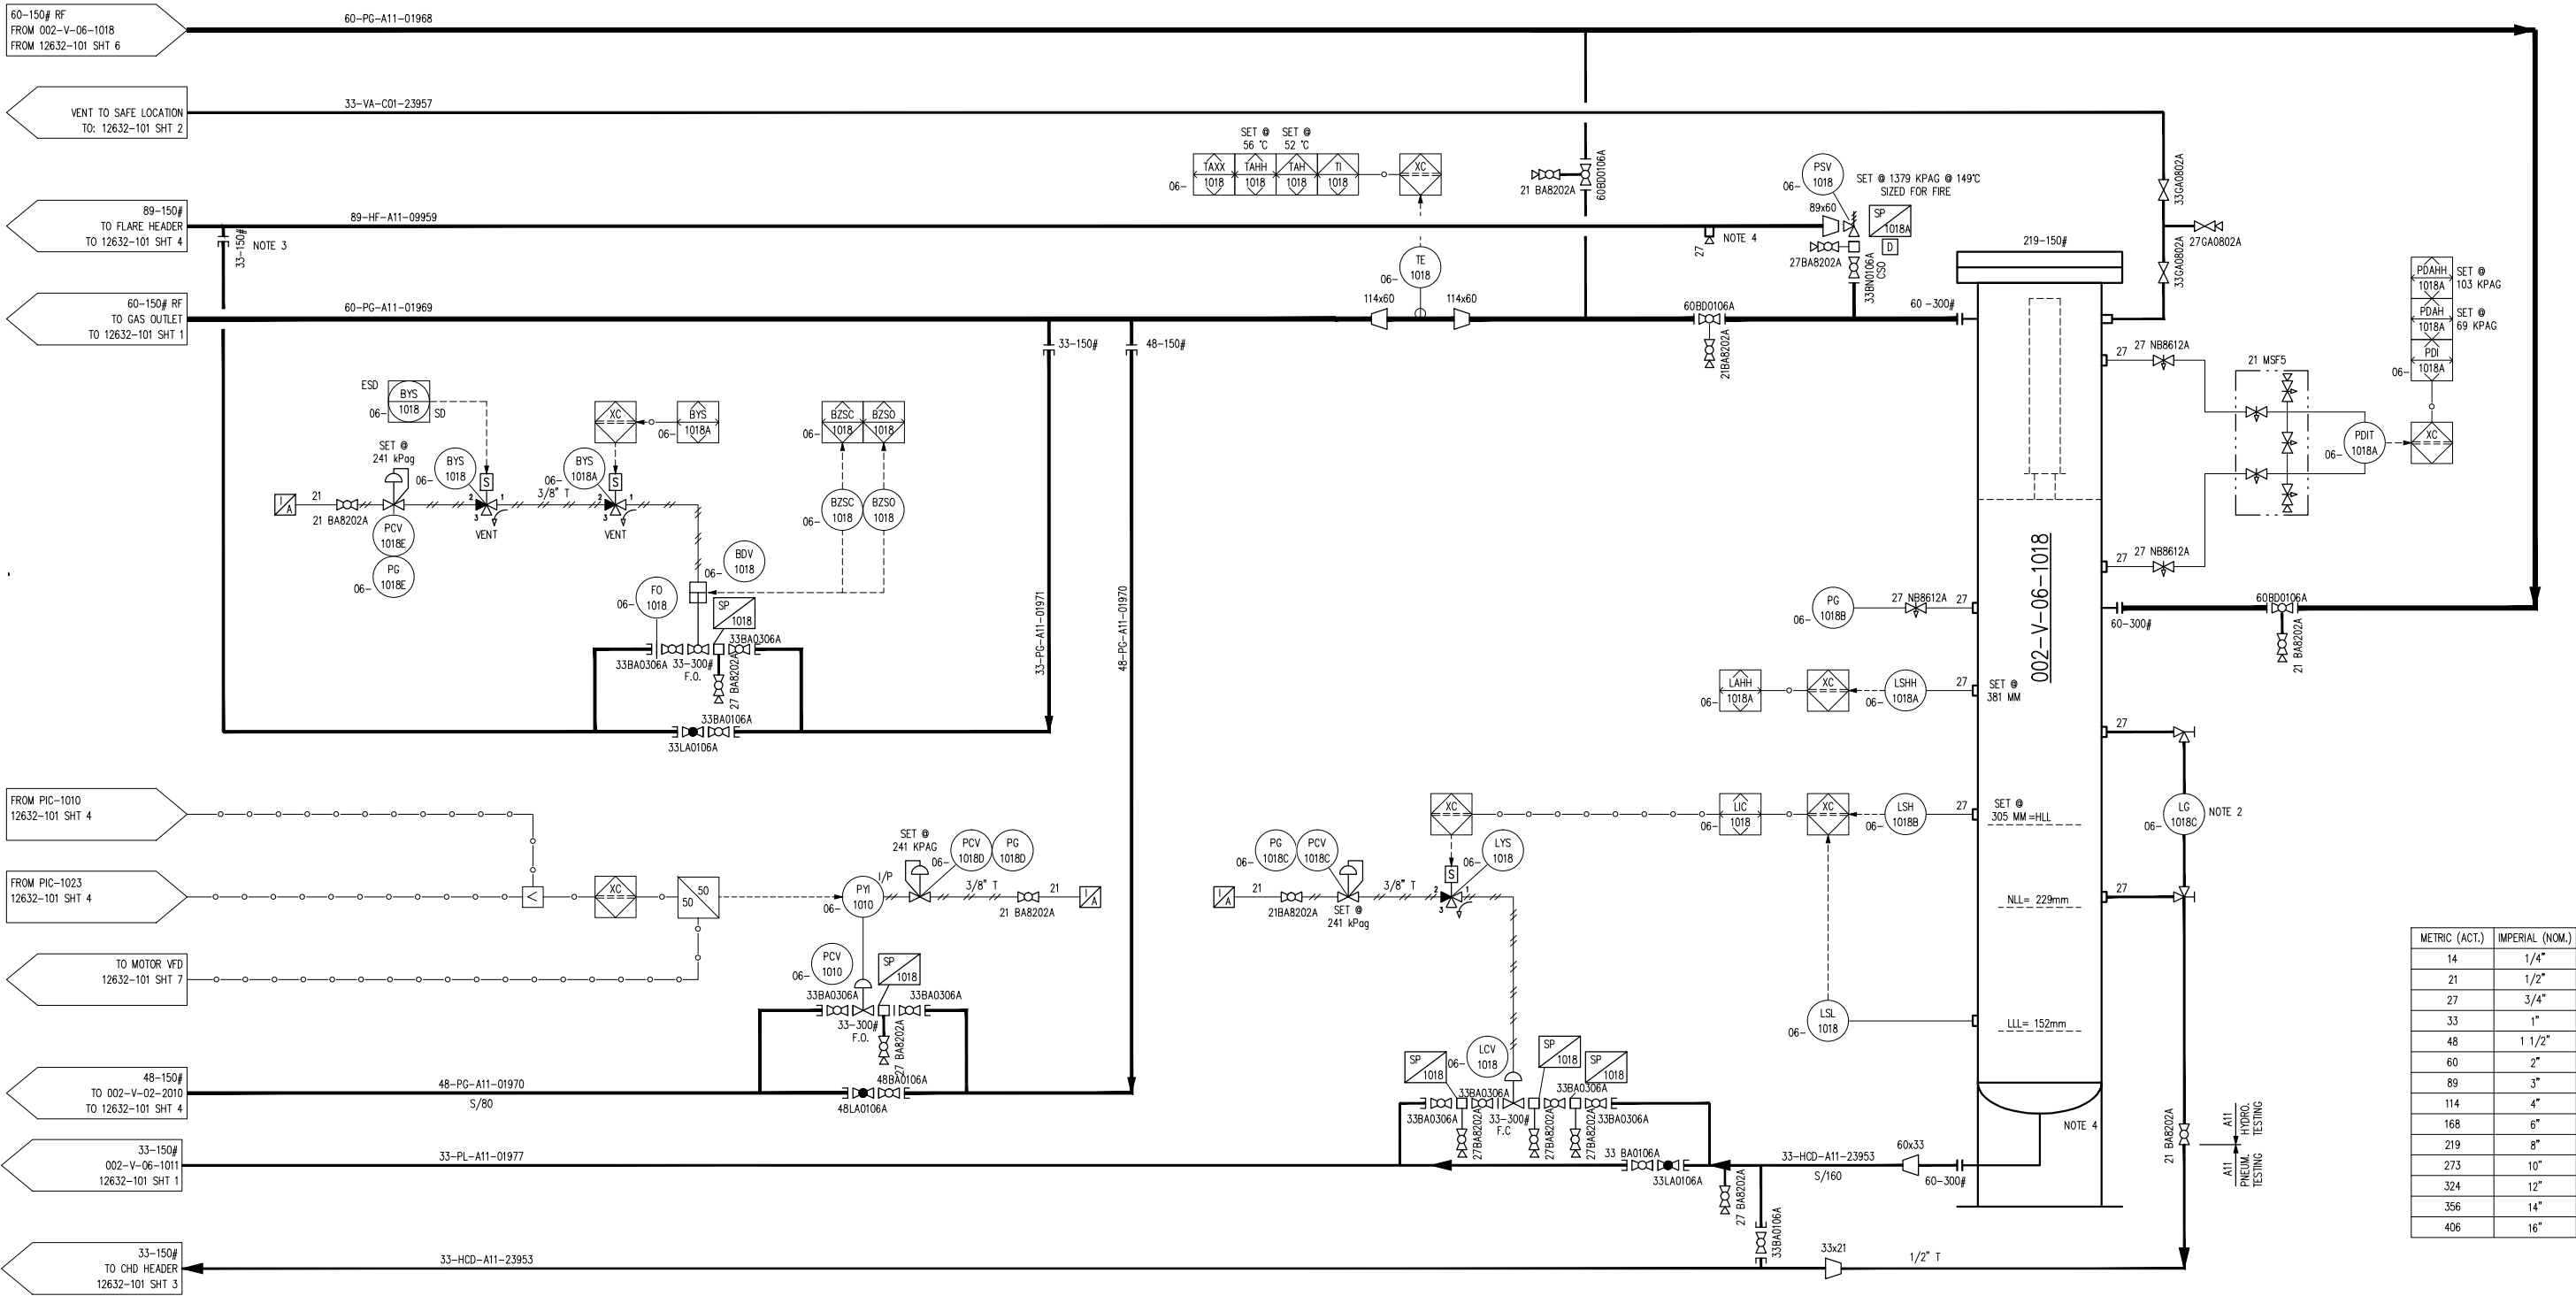

- NOTES:
1. ID OF THE DRAIN NOZZLE TO BE FLUSH WITH THE PLATE.
 2. LEVEL GAUGE TO HAVE 45° FITTING.
 3. TOP OF PIPE CONNECTION.
 4. LOW POINT DRAIN.

4	AS BUILT - REV VESSEL INFO.	JUN 05/14	GP	SG	DATE	MAY 15/13	SCALE	NTS
3	AS BUILT	MAY 23/14	TW	SG	DRAWN BY	C.SMITH	CHECKED BY	S.GURI
2	ISSUED FOR CONSTRUCTION	FEB 02/14	GP	SG	PROJECT MANAGER	B.MINSHULL	PROJECT ENGINEER	S.GURI
1	ISSUED FOR CONSTRUCTION	OCT 25/13	CS	SG	CUST PO	4100001327		
0	ISSUED FOR CONSTRUCTION	OCT 24/13	CS	SG				
B	ISSUED FOR HAZOP	AUG 06/13	AT	SG	APEGGA PERMIT No:	P8651	OPER. CODE	
REV	DESCRIPTION	DATE	BY	APR	WORK ORDER	12632		

DEVON CANADA CORPORATION
FERRIER CENTRAL
PROCESSING FACILITY
CONDENSATE STABILIZER

ENERFLEX
Calgary, Alberta,
Canada

P & I DIAGRAM
PROCESS GAS
COOLER/DISCH. COALESCER

DWG NO 12632-101 SHT 5 REV 4