

MFG: RUFFNECK
MODEL: AH-24A-A5
POWER: 0.5 HP

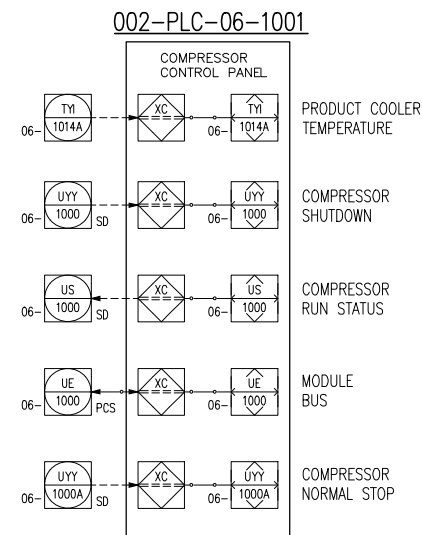
MFG: TECO
POWER: 0.5 HP
ELECTRICAL: 575VAC/3PH/60HZ

MFG: WARWIK
DIMENSIONS:
LENGTH: 12000 mm
WIDTH: 4000 mm
EAVE HEIGHT: 3658 mm

MFG: SUPERS SUPPLY
POWER: 0.5 HP
ACPH: TBD

MFG: MARATHON
POWER: 0.5 HP
ELECTRICAL: 575VAC/3PH/60HZ

MFG: SPARTAN CONTROLS
MODEL: REMVUE-500
POWER: 24 VDC

NAME G. PAHL DATE JUN 05/14

4	AS BUILT – NO CHANGE	JUN 05/14	GP	SG	DATE MAY 30/13	SCALE NTS	DEVON CANADA CORPORATION FERRIER CENTRAL PROCESSING FACILITY CONDENSATE STABILIZER	ENERFLEX Calgary, Alberta, Canada	P & I DIAGRAM PROCESS GAS			
3	AS BUILT	MAY 23/14	TW	SG	DRAWN BY C.SMITH	CHECKED BY S.GURI						APPROVED BY B.MINSHULL
2	ISSUED FOR CONSTRUCTION	FEB 02/14	GP	SG	PROJECT MANAGER B.MINSHULL							PROJECT ENGINEER S.GURI
1	ISSUED FOR CONSTRUCTION	OCT 25/13	CS	SG								
0	ISSUED FOR CONSTRUCTION	OCT 24/13	CS	SG	CUST PO 4100001327							
B	ISSUED FOR HAZOP	AUG 06/13	AT	SG								
REV	DESCRIPTION	DATE	BY	APR	APEGGA PERMIT No: P8651	OPER. CODE 490 511 591	WORK ORDER 12632	DWG NO 12632–101	SHT 9	REV 4		

Doc # C03-12632-101-009
WP SDR Code A1/F15

THE INFORMATION CONTAINED HEREIN IS THE CONFIDENTIAL PROPERTY OF ENERLEX, LTD. AND IS NOT FOR PUBLICATION, AND NO PART THEREOF SHALL BE COPIED OR COMMUNICATED TO A THIRD PARTY WITHOUT AUTHORIZATION FROM ENERLEX, LTD.