

002-EH-02-3140
ENGINE OIL/HEATER
MFG: KIM HOTSTART
HEATER: 6KW (8.05 HP)
PUMP: 1HP (0.746KW)
11GPM @ 1750 RPM
POWER: 575V/3PH/60HZ
WIRED BY OTHERS

002-P-02-3128
ENGINE LUBE OIL PUMP
MFG: CATERPILLAR
CAPACITY: 1401 LPM (370 GPM) @ 1000 RPM


002-P-02-3129
ENGINE PRE/POST LUBE OIL PUMP
MFG: CATERPILLAR (TDI)
CAPACITY: 76 LPM (20 GPM)
AIR CONSUMPTION: 239 SCFM @ 120 PSIG

002-FL-02-3150
ENG OIL FILTER
MFG: CATERPILLAR
MODEL:

002-FL-02-3149
OIL SUPP. FILTER
MFG: BALDWIN
MODEL: BT-251
27mm (3/4") NPT IN/OUT
DESIGN PRESSURE: 689 kPag

002-T-02-3134
ENGINE OIL DAY TANK
MFG: EFX (INTEGRAL WITH CRANE RAIL)
CAPACITY: 650 L (172 CIG)

002-FL-02-3151/52
ENGINE OIL SPINNERS
MFG: SPINNER 2
MODEL: 600-12HD

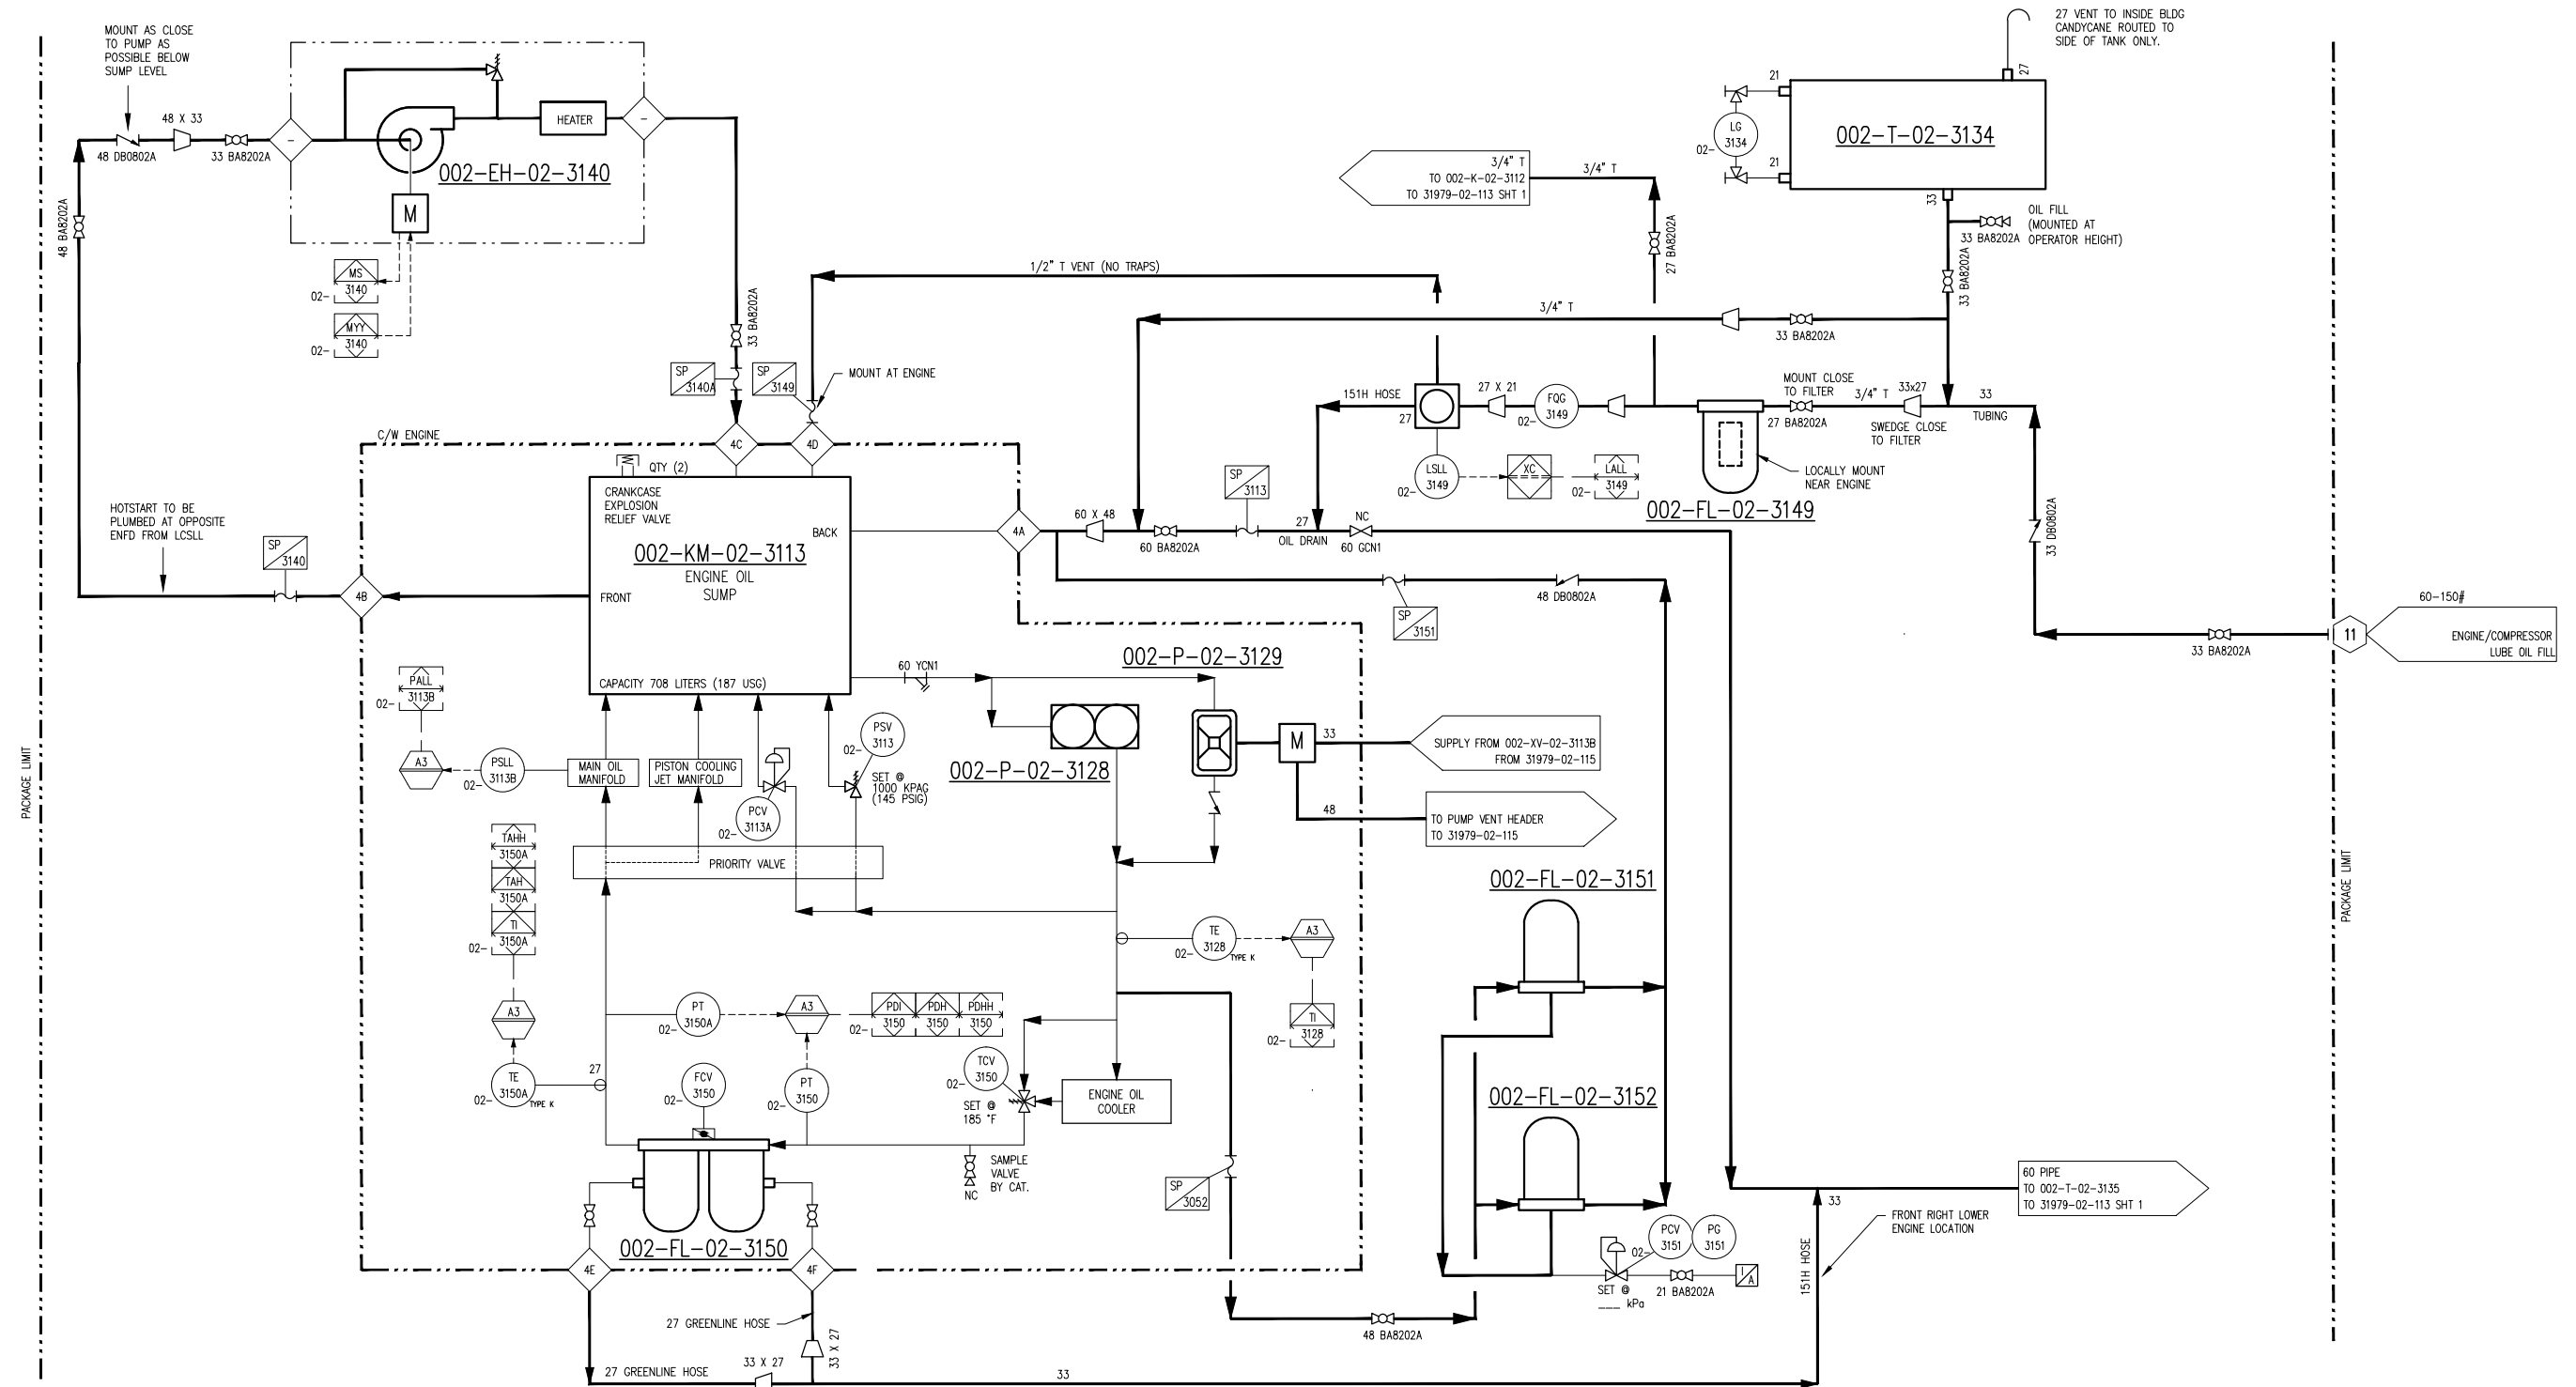

**FINAL
AS BUILT**
NAME C.SMITH DATE JAN 02/14

3	FINAL AS BUILT	JAN 02/14	CS	LD	DATE JAN 23/13	SCALE NTS
2	FINAL AS BUILT	NOV 13/13	AR	LD	DRAWN BY A.HAMMOND	CHECKED BY S.GURI
1	ISSUED FOR CONSTRUCTION	JUL 03/13	CS	SG	PROJECT MANAGER B.MINSHULL	APPROVED BY B.MINSHULL
0	ISSUED FOR CONSTRUCTION	APR 19/13	AT	SG	PROJECT ENGINEER S.GURI	
B	ISSUED FOR HAZOP	MAR 08/13	AT	SG	CUST PO 4100000964	
A	ISSUED FOR CUSTOMER APPROVAL	FEB 15/13	AT	SG		
REV	DESCRIPTION	DATE	BY	APR	APEGGA PERMIT No: P8651	OPER. CODE

DEVON CANADA FERRIER CPF
BATTERY SCREW
CATERPILLAR G3606LE
FRICK SGCB-3524

ENERFLEX
Calgary, Alberta,
Canada

P & I DIAGRAM
ENGINE LUBE
OIL SYSTEM

DWG NO	31979-02-114	SHT	1	REV	3
--------	--------------	-----	---	-----	---