


002-SL-02-3142  
AIR INTAKE SILENCER  
MFG: NOISE SOLUTION INC  
MODEL: CAEAVXX082078054  
DESIGN FLOW: 6000 SCFM  
PRESSURE DROP: 1.2 IN H2O

002-FL-02-3143  
AIR FILTER  
MFG: CATERPILLAR  
STYLE: STANDARD DUTY, DOUBLE  
ELEMENT HOUSING

002-SL-02-3144  
EXHAUST SILENCER  
MFG: NOISE SOLUTION INC  
MODEL: 2ERON 20,000 PLUS EESW2XP200018XXX  
ORIENTATION: VERTICAL  
DIMENSIONS: 1829mm (72") OD X 6096mm (240") LENGTH  
CONNECTION: 457mm (18")/457mm (18") IN/OUT  
WEIGHT: 6123 KG (13,500 LBS)  
BACK PRESSURE: 1.98 INCHES H<sub>2</sub>O

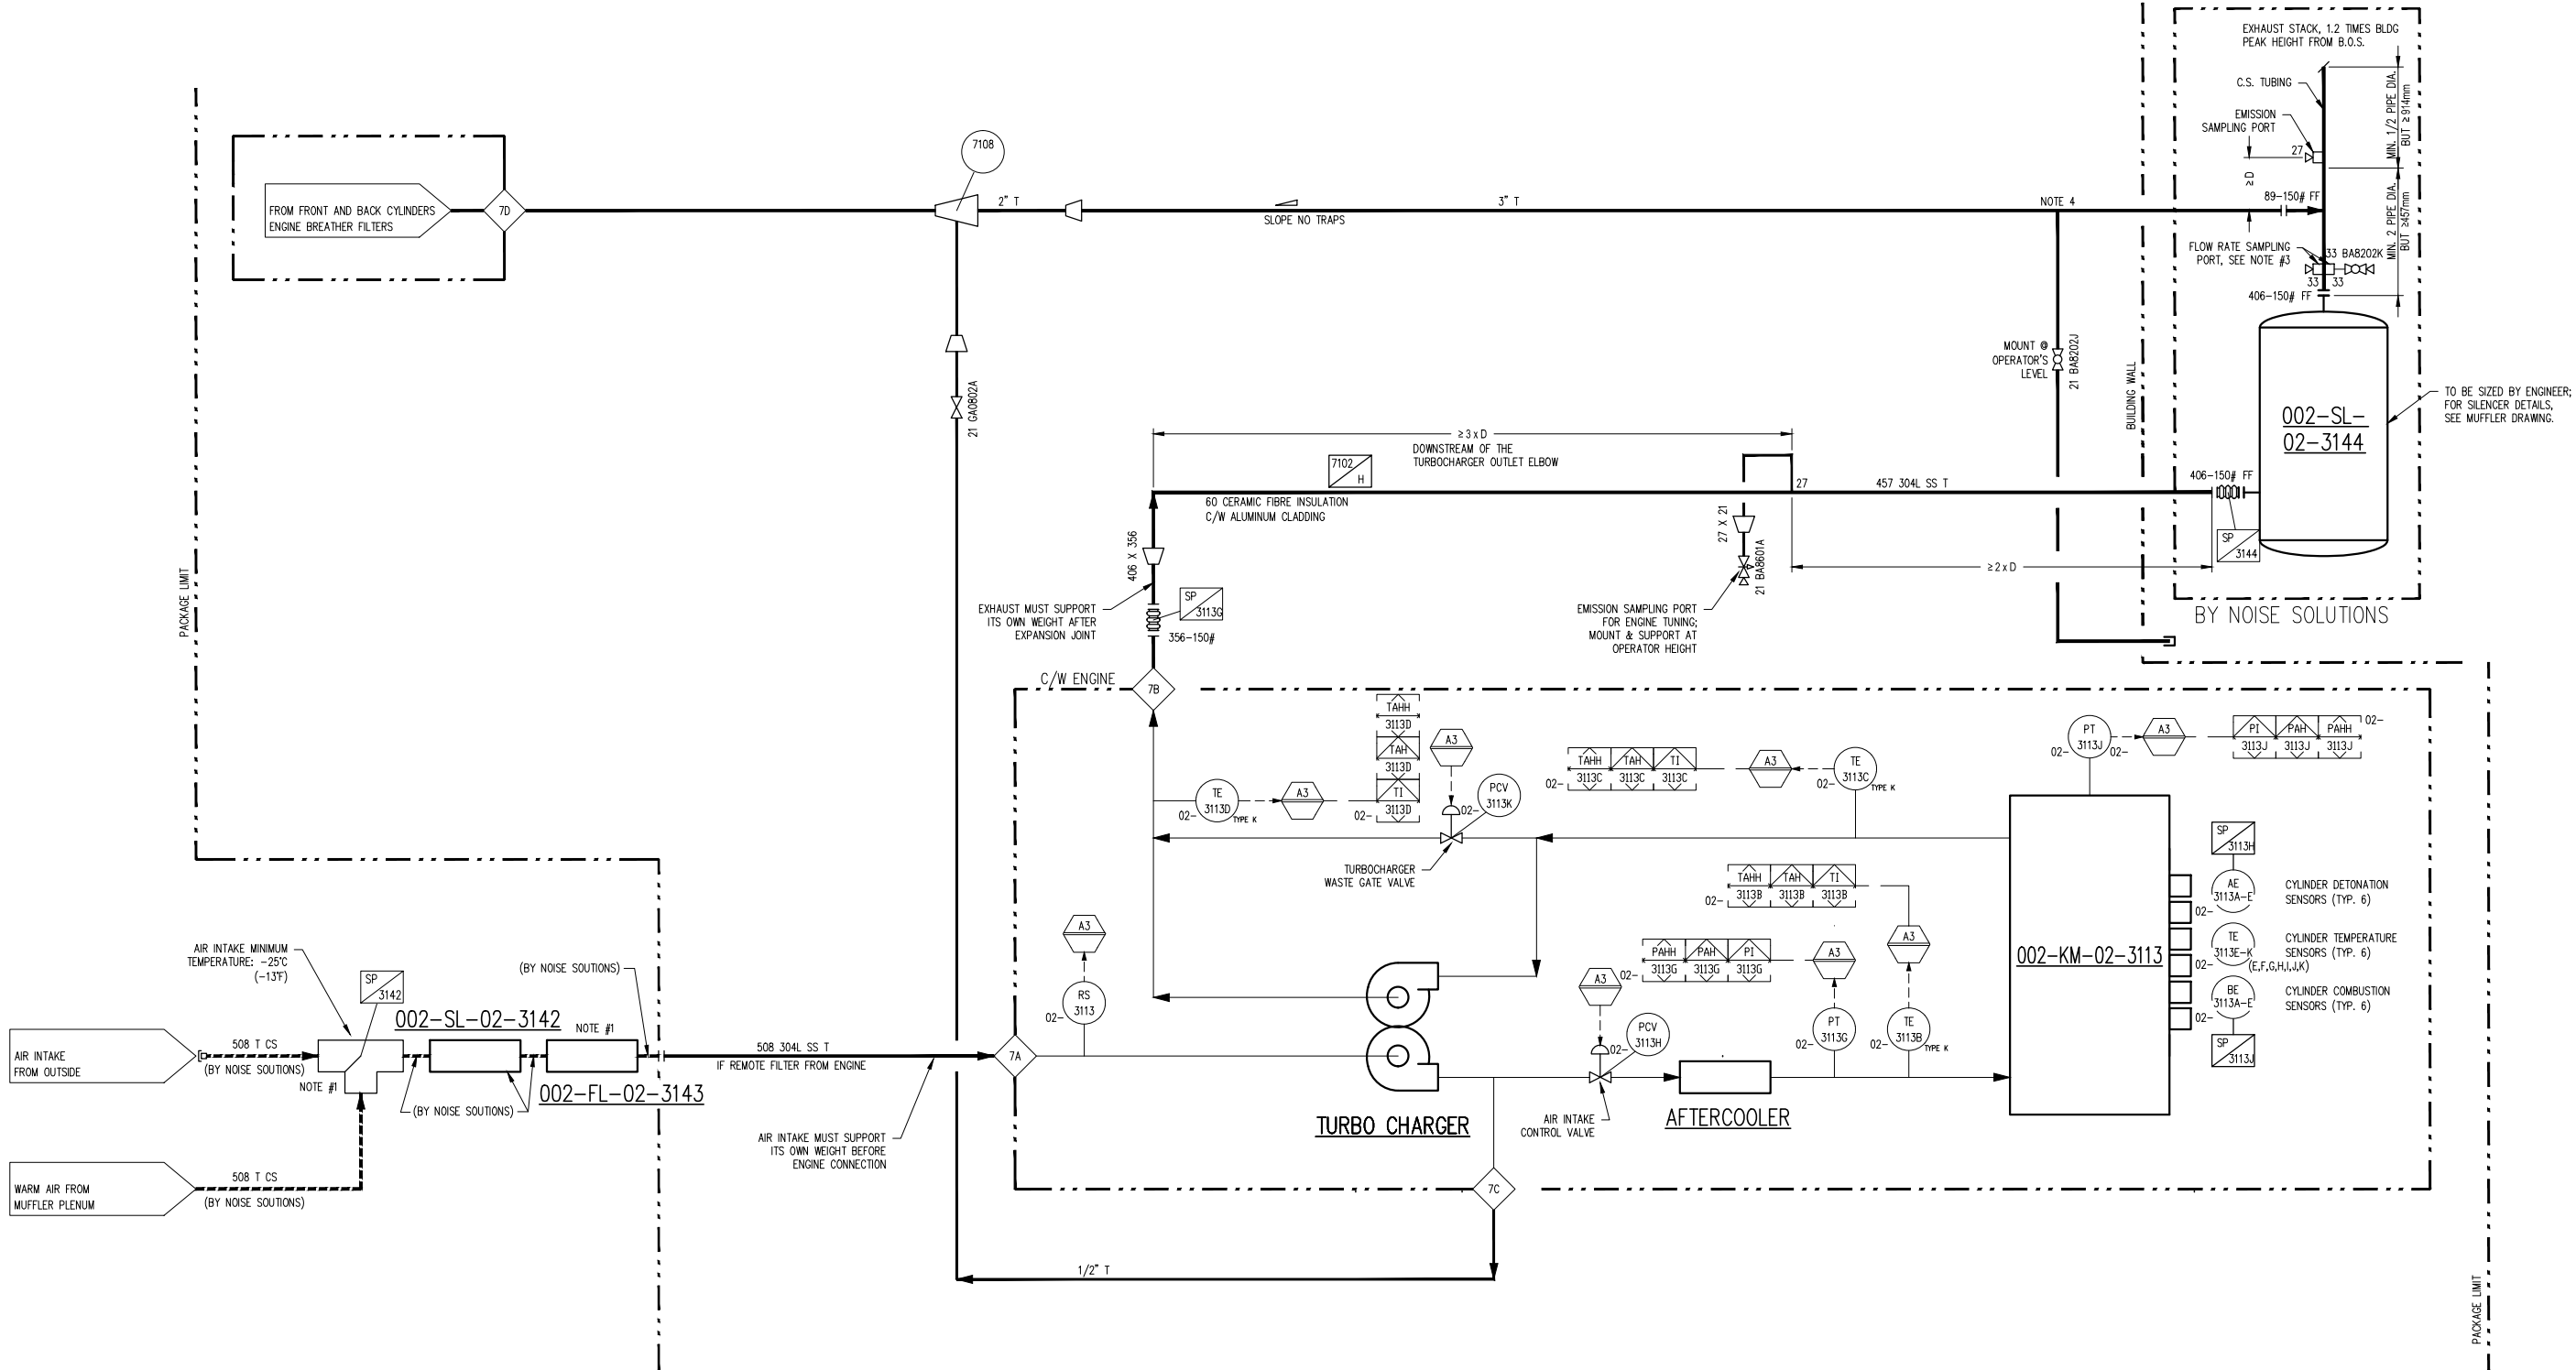

NOTE:  
1. WARM AIR MIXING BOX AND FILTER BOX PROVIDED BY EFX. INTERCONNECT PIPING BY NOISE SOLUTIONS.  
2. SAMPLING POINT TUBING AND VALVE SHALL BE POST MOUNTED.  
3. TWO FLOW RATE SAMPLING PORTS SHALL BE PERPENDICULAR.  
4. RUN CRANKCASE VENT INSIDE AS CLOSE AS POSSIBLE TO THE SILENCER.

**FINAL  
AS BUILT**  
NAME: C.SMITH DATE: JAN 02/14

3	FINAL AS BUILT	JAN 02/14	CS	SG	DATE	JAN 23/13	SCALE	NTS	DEVON CANADA FERRIER CPF DEEP CUT FEED CATERPILLAR G3606LE ARIEL JGD/4-1 SWEET	<b>ENERFLEX</b> Calgary, Alberta, Canada	P & I DIAGRAM AIR/EXHAUST SYSTEM						
2	FINAL AS BUILT	NOV 13/13	AR	SG	DRAWN BY	A.HAMMOND	CHECKED BY	S.GURI							APPROVED BY	B.MINSHULL	
1	ISSUED FOR CONSTRUCTION	JUL 03/13	CS	SG	PROJECT MANAGER	B.MINSHULL	PROJECT ENGINEER	S.GURI									
0	ISSUED FOR CONSTRUCTION	APR 19/13	AT	SG	CUST PO	4100000964											
B	ISSUED FOR HAZOP	MAR 08/13	AT	SG													
A	ISSUED FOR CUSTOMER APPROVAL	FEB 15/13	AT	SG													
REV	DESCRIPTION	DATE	BY	APR	APEGGA PERMIT No: P8651		OPER. CODE		WORK ORDER	31979-02	DWG NO	31979-02-117		SHT	1	REV	3