


SUNCOR ENERGY
BURNT LAKE
FWKO ADDITION
MECHANICAL FLOW SHEET
J. WEENIK 97.07.26
AS BUILT

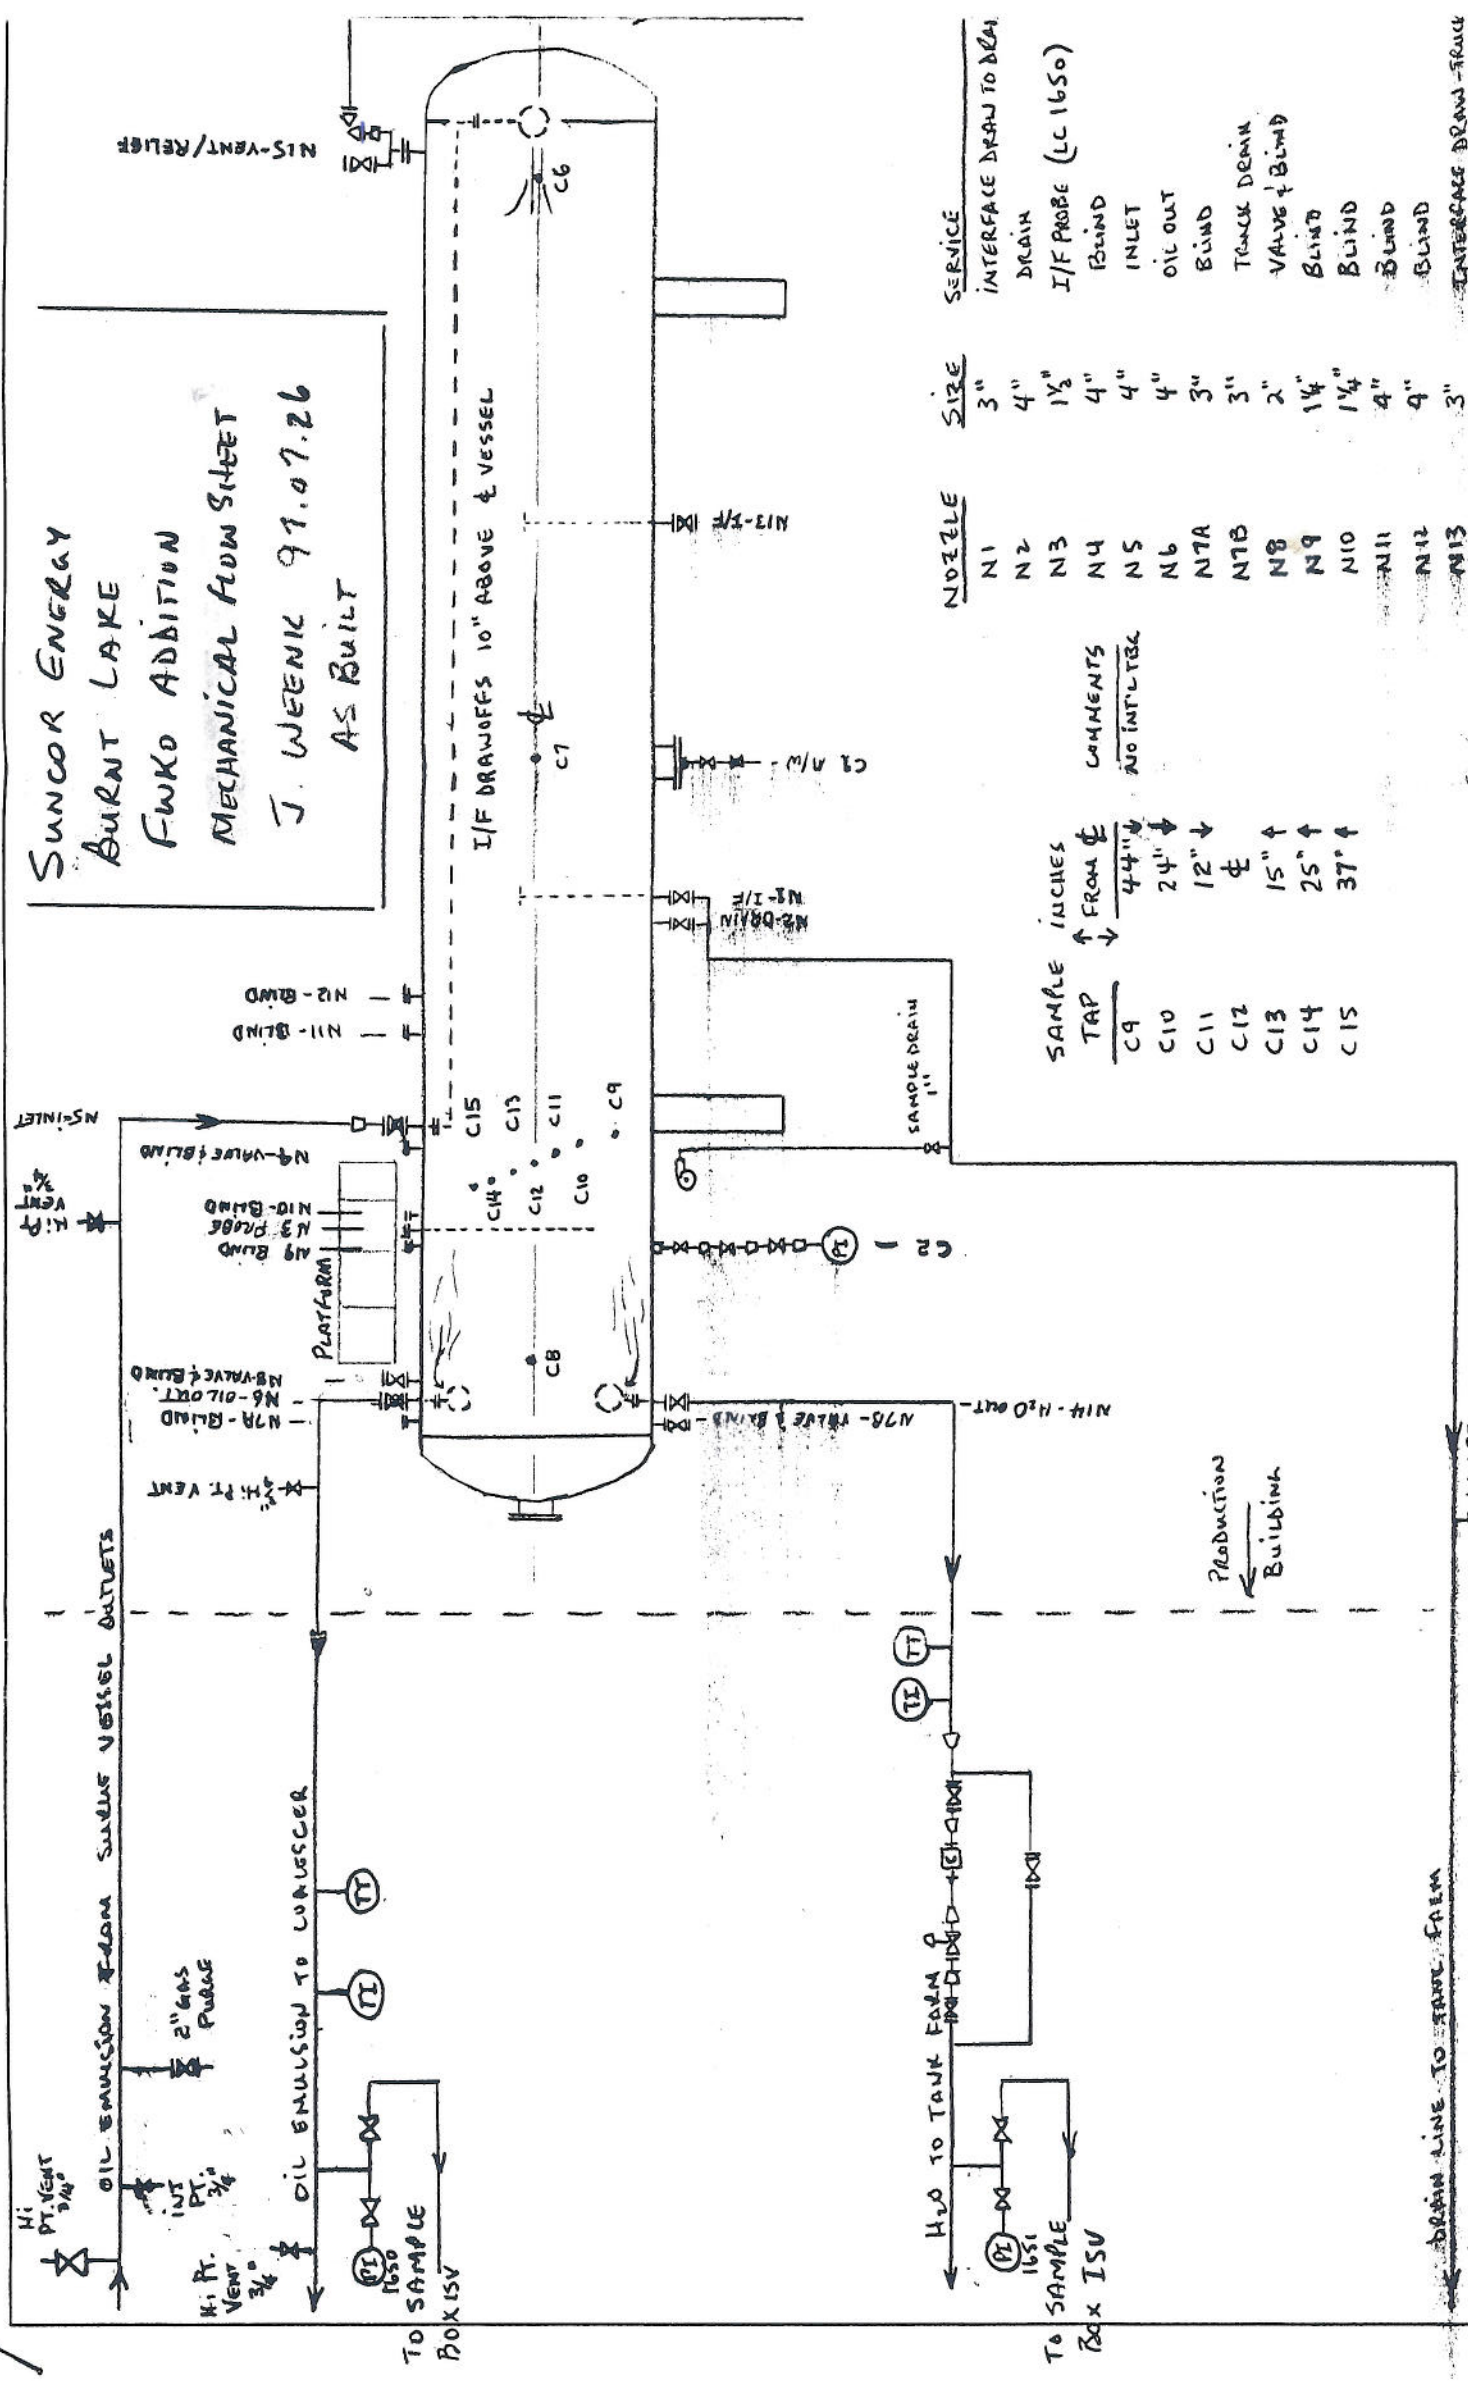

NOZZLE	SIZE	SERVICE
N1	3"	INTERFACE DRAIN TO DRAIN
N2	4"	DRAIN
N3	1 1/2"	I/F PROBE (LC 1650)
N4	4"	BLIND
N5	4"	INLET
N6	4"	OIL OUT
N7A	3"	BLIND
N7B	3"	TRACK DRAIN
N8	2"	VALVE & BLIND
N9	1 1/4"	BLIND
N10	1 1/4"	BLIND
N11	4"	BLIND
N12	4"	BLIND
N13	3"	INTERFACE DRAIN - FRAUD
N14	4"	H2O OUT
N15	4"	VENT/RELIEF
C1	1"	M/W DRAIN
C2	1"	VESSEL PI
C3	3/4"	NOT USED
C4	1"	NOT USED
C5	1"	NOT USED
C6	1"	TI 1652
C7	1"	TI 1651
C8	1"	TI 1650

SAMPLE TAP	INCHES FROM ϕ	COMMENTS
C9	44"	NO INTL. TAG
C10	24"	
C11	12"	
C12	ϕ	
C13	15"	
C14	25"	
C15	37"	

- OPERATIONAL NOTES:**
- ① THIS IS A FLOODED VESSEL LEVEL CONTROLLED WITH A 7' CAPACITANCE PROBE TO ACTIVATE THE H₂O DUMP. FLOW CONTROL SHOULD BE AS CONTINUOUS AS POSSIBLE (10. THATTLINK)
 - ② PRESSURE RELIEF IS SET TO 100PSIG TO FKO DRAIN. CHAIN LOCK ANY DOWNSTREAM VALVES IN OPEN POSITION
 - ③ DESIGN INTERFACE AT 12" (305mm) ABOVE ϕ VESSEL

Oil emulsion from surge vessel outlets
 Hi Pt. Vent 3/4"
 Hi Pt. Vent 3/4"
 2" GAS PURGE
 Oil emulsion to surge vessel
 TO SAMPLE BOX ISV
 TO SAMPLE BOX ISV
 H₂O TO TANK FARM
 TO SAMPLE BOX ISV
 DRAIN LINE TO TANK FARM
 LOW PT. DRAIN 3/4"

PRODUCTION BUILDING

N15-VENT/RELIEF

I/F DRAWAFFS 10" ABOVE ϕ VESSEL

TI 1652

TI 1651

TI 1650

TI 1650

