


NOTES:  
 1. CLOUDED AREAS INDICATE NEW PIPING AND/OR EQUIPMENT.

EEL PROJECT #119-12-14



DRAWING NO	REFERENCE DRAWINGS	REV	MOC NO.	REVISION DESCRIPTION	BY	DATE	CHKD	APPD	BP APPD	ENGINEER'S STAMP	ENGINEERING RECORD	BP Canada Energy Company CALGARY ALBERTA	
		1		FIELD AS-BUILT	JD	96-02-10	C.v.	NOT ON ORIGINAL	NOT ON ORIGINAL		DRAWN BY J. DEPAOLI	DATE 96-02-23	 AREA/PROJECT MARTEN HILLS PREPARED BY LEAL TECHNICAL DESIGN LTD. TITLE LSD 12-18-76-25 W4M MARTEN HILLS GAS PLANT SWEETENING ADSORBERS MECHANICAL FLOW DIAGRAM SCALE NTS EPCM DWG/PROJ NO. MRH401 BP DWG NO D-MRH-220-30 REV 8
		2		GENERAL REVISION	DJM	96-04-24	C.v.	NOT ON ORIGINAL	NOT ON ORIGINAL		CHKD BY KEVIN MASON	DATE 2005-04-04	
		3		GENERAL AS-BUILT	DJM	96-07-26	C.v.	NOT ON ORIGINAL	NOT ON ORIGINAL		ENGINEER NOT ON ORIGINAL	NOT ON ORIGINAL	
		4		AS-BUILT PER PLANT MARK-UPS (LEAL INTERNATIONAL LTD)	JS	99-12-03	HM	NOT ON ORIGINAL	NOT ON ORIGINAL				
		5		REVISED AS PER FIELD MARK-UPS	SDS	2002 07 29	G.S.	NOT ON ORIGINAL	NOT ON ORIGINAL				
		6		AS-BUILT MAXIMO SCE PROJECT-PER MOC NO. 2004-42	YL	2005-04-04	KLM	CWB	NOT ON ORIGINAL				
		7		MOVED TO NEW BASE AND NEW TITLE	L. GORNY	2007-07-11	ED BROWNE	BRAD FRENCH	HERB ZIEGLER				
		8		AS-BUILT AS PER FIELD MARK-UPS	L. GORNY	2007-07-11	ED BROWNE	BRAD FRENCH	HERB ZIEGLER				

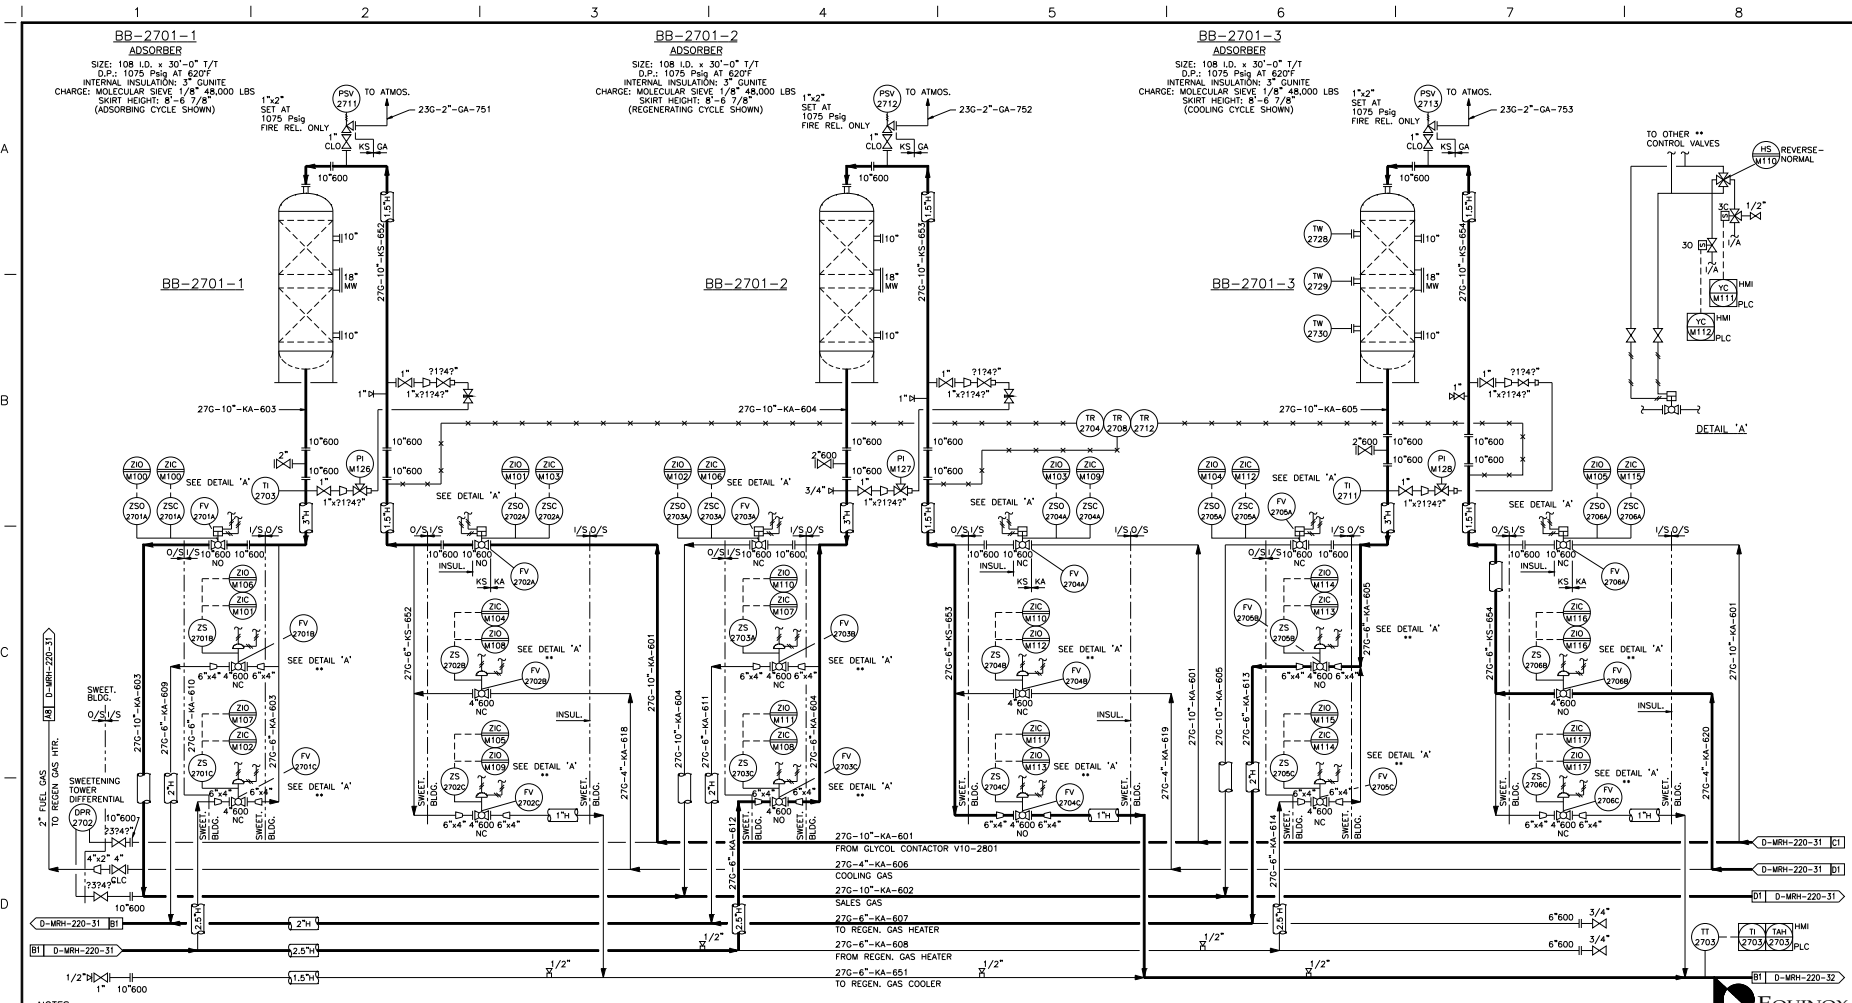

NOTES:  
1. CLOUDED AREAS INDICATE NEW PIPING AND/OR EQUIPMENT.

DRAWING NO	REFERENCE DRAWINGS	REV	MOC NO.	REVISION DESCRIPTION	BY	DATE	CHKD	APPD	BP APPD	ENGINEER'S STAMP	ENGINEERING RECORD	BP Canada Energy Company ALBERTA
		1		FIELD AS-BUILT	JD	96-02-10	C.v.	NOT ON ORIGINAL	NOT ON ORIGINAL		DRAWN BY J. DEPAOLI	DATE 96-02-23
		2		GENERAL REVISION	DJM	96-04-24	C.v.	NOT ON ORIGINAL	NOT ON ORIGINAL		CHKD BY KEVIN MASON	DATE 2005-04-04
		3		GENERAL AS-BUILT	DJM	96-07-26	C.v.	NOT ON ORIGINAL	NOT ON ORIGINAL		ENGINEER NOT ON ORIGINAL	DATE NOT ON ORIGINAL
		4		AS-BUILT PER PLANT MARK-UPS (LEAL INTERNATIONAL LTD)	JS	99-12-03	HM	NOT ON ORIGINAL	NOT ON ORIGINAL		DATE NOT ON ORIGINAL	DATE NOT ON ORIGINAL
		5		REVISED AS PER FIELD MARK-UPS	SDS	2002-07-29	G.S.	NOT ON ORIGINAL	NOT ON ORIGINAL		DATE NOT ON ORIGINAL	DATE NOT ON ORIGINAL
		6		AS-BUILT MAXIMO SCE PROJECT-PER MOC NO. 2004-42	YL	2005-04-04	KLM	CWB	NOT ON ORIGINAL		DATE NOT ON ORIGINAL	DATE NOT ON ORIGINAL
		7		MOVED TO NEW BASE AND NEW TITLE	L. GORNY	2007-07-11	ED BROWNE	BRAD FRENCH	HERB ZIEGLER		DATE NOT ON ORIGINAL	DATE NOT ON ORIGINAL
		8		AS-BUILT AS PER FIELD MARK-UPS	L. GORNY	2007-07-11	ED BROWNE	BRAD FRENCH	HERB ZIEGLER		DATE NOT ON ORIGINAL	DATE NOT ON ORIGINAL

BP Canada Energy Company  
ALBERTA

AREA/PROJECT MARTEN HILLS  
PREPARED BY LEAL TECHNICAL DESIGN LTD.

TITLE  
LSD 12-18-76-25 W4M  
MARTEN HILLS GAS PLANT  
SWEETENING ADSORBERS  
MECHANICAL FLOW DIAGRAM

SCALE  
NTS

EPCM DWG/PROJ NO. MRH401  
BP DWG NO. D-MRH-220-30

REV  
8