

BILL OF MATERIALS c/w FRAME

No.	PART No.	DESCRIPTION	QUANTITY
501	B-1982	COOLER, OIL, SHELL & TUBE	1
502	A-11154	DIVIDER BASE BLOCK	1
503	A-0861	FILTER, ELEMENT, OIL, 5 MICRON NOMINAL	1
504	-	-	-
505	A-8248	WYE STRAINER, 1.25" NPT	1
506	-	-	-
507	D-0292	PUMP, VIKING #14495, 30 GPM @ 1800 RPM	1
508	A-9478	PUMP, PLUNGER, ARIEL, 0.375" PLUNGER	1
509	A-0124	RUPTURE DISK, PURPLE, 3250 PSIG	1
510	D-02000	LUBRICATOR, 1/2 PUMP	1
511	A-11285	SWITCH, NO-FLOW, PROFLO, FITS TRABON LUBE BLOCKS, CSA CLASS 1, DIV. 2, GRP A,B,C,D	1
512	A-3689	VALVE, CHECK, BALL, PREMIER, 90024, 0.25" NPT	1
513	A-5219	VALVE, RELIEF, INTERNAL OIL	1
514	A-8272	GAUGE, PRESSURE, ASHCROFT, 0-3000 PSI	1
515	A-5551	VALVE, DIVIDER, TRABON, 12T	2
516	A-5555	VALVE, DIVIDER, TRABON, 18T	2
517	A-0261	GAUGE, PRESSURE, ARIEL, 0.25" NPT, 0-100 PSI	1
518	A-5543	VALVE, DIVIDER, TRABON, 6T	1
519	A-5547	VALVE, DIVIDER, TRABON, 9T	1
520	-	-	-

BILL OF MATERIALS SUPPLIED BY E.I.

No.	PART No.	DESCRIPTION	QUANTITY
521	LCM-12	CONTROLLER, LEVEL, KENCO, LCM-12, 0.5" FNPT, 6.5 PSIG MAMP, MAX 180°F, 0.5" POST MOUNT, ALUMINUM, CSA CLASS III TYPE 4	1
522	11A315	COUPLING, PIPE, AERQUIP, 2.0" PIPE	1
523	R106300B	VALVE, BALL, NUTRON, 1" NPT, 3000#, STD. TRIM	3
524	NPN	VALVE BALL, JAG C2R-HSR, 1" NPT, 2000#, RP TWO PIECE DESIGN, 316SS BODY AND TRIM, TEFLON SEAT, c/w HIDDEN SPRING RETURN HANDLE	1
525	NPN	PUMP, PNEUMATIC, DMPHROG, WILDEN, PH-ALL-BN-ABN, ALUMINUM BODY, PLASTIC AIR VALVE	1
526	10X113	GAUGE, PRESSURE, WIKKA, 213.33.063, 0.25" MNPT BOTTOM MNT, 0-200 PSIG, MAX 140°F, 2.5" FACE, LIQUID FILLED, DUAL SCALE, SS CASE, BRASS INTERNALS	1
527	8BE057	SIGHT GLASS, REDLINE, PEACOCK, 411001108, 0.625" OD, 330 PSIG @ 100°F, 12" LG	1
528	NPN	THERMOCOUPLE, K TYPE, AIS ALTEMP, 0.25" TUBE X 0.5" MNPT, 6" PROBE, 0.250" OD, 40 FT ARMoured LEADS	1
529	8BA186	THERMOWELL, 0.5" FNPT X 0.5" MNPT, 2.50" DEPTH, 0.260" BORE, 316 SS	2
530	NPN	THERMOWELL, 0.5" FNPT X 1" MNPT, 2.50" DEPTH, 0.260" BORE, 316 SS	2
531	NPN	TRANSMITTER, PRESSURE, ROSEMOUNT, 2088C252A1C6, 0-150 PSIG, 4-20 MA, 1/2" CONNECTIONS, XP, CSA APPROVED	1
532	NPN	VALVE, BALL, NUTRON, R075308, 0.75" NPT, 3000#, STD. TRIM	3
533	R075308	VALVE, PISTON CHECK, BONNEYFORGE, 0.75" NPT, FORGED STEEL	1
534	NPN	VALVE, PISTON CHECK, BONNEYFORGE, 1.5" NPT, FORGED STEEL	1
535	NPN	VALVE, GATE, NEWCO, 2.0" NPT, CLASS 800, FS	1
536	NPN	VALVE, GAUGE, DANIEL, 209-01-049C 1TC, 0.5" FNPT X 0.625" TUBE, 3600 PSIG @ 250°F 1" SET, CARBON STEEL	1
537	1TC	VALVE, NEEDLE, CENTURY, CM23-3-W271-B-V, 0.25" MNPT X 0.25" FNPT, 6000 PSIG @ 100°F, 316SS	2
538	NPN	FILTER, HOUSING, OIL, BALDWIN, 0.75" FNPT	1
560	405-047	FILTER, ELEMENT, OIL, BALDWIN, SPIN ON	1
561	405-046	FILTER, ELEMENT, OIL, BALDWIN, SPIN ON	1

NOT BE RE-PRODUCED OR DISTRIBUTED WITHOUT THE PRIOR WRITTEN CONSENT OF ENERGY INDUSTRIES INC.

NOTES:
 1. FOR ALL OTHER NOTES & GENERAL INFORMATION SEE DWG. #FFLOW.
 2. MOUNT ABOVE GRATING AND WITHIN SIGHT OF OIL LEVEL.


No.	REVISION	DATE	BY
3	AS BUILT	03/04/04	CD
2	ADDED PANEL CHANNEL NUMBERS	12/18/03	CD
1	ISSUED FOR CONSTRUCTION	12/08/03	CD
0	ISSUED FOR APPROVAL	11/25/03	CD

STEP # 550 UNIT # 1105 DRAWING NO: 1105-CO-FLOW REV.3

ENERGY INDUSTRIES INC.
 4303 - 11TH STREET N.E. CALGARY ALBERTA CANADA

CUSTOMER:
 DEVON CANADA CORPORATION
 GREEN COMPRESSOR STATION
 LSD: b-94-1/94-G-7
 ARIEL JCK/2

SCALE: NONE DATE: 11/25/03 BY: CD DATE RELEASED: 03/04/04 RELEASED BY: [Signature]
 UNIT # 1105 DRAWING NO: 1105-CO-FLOW REV.3

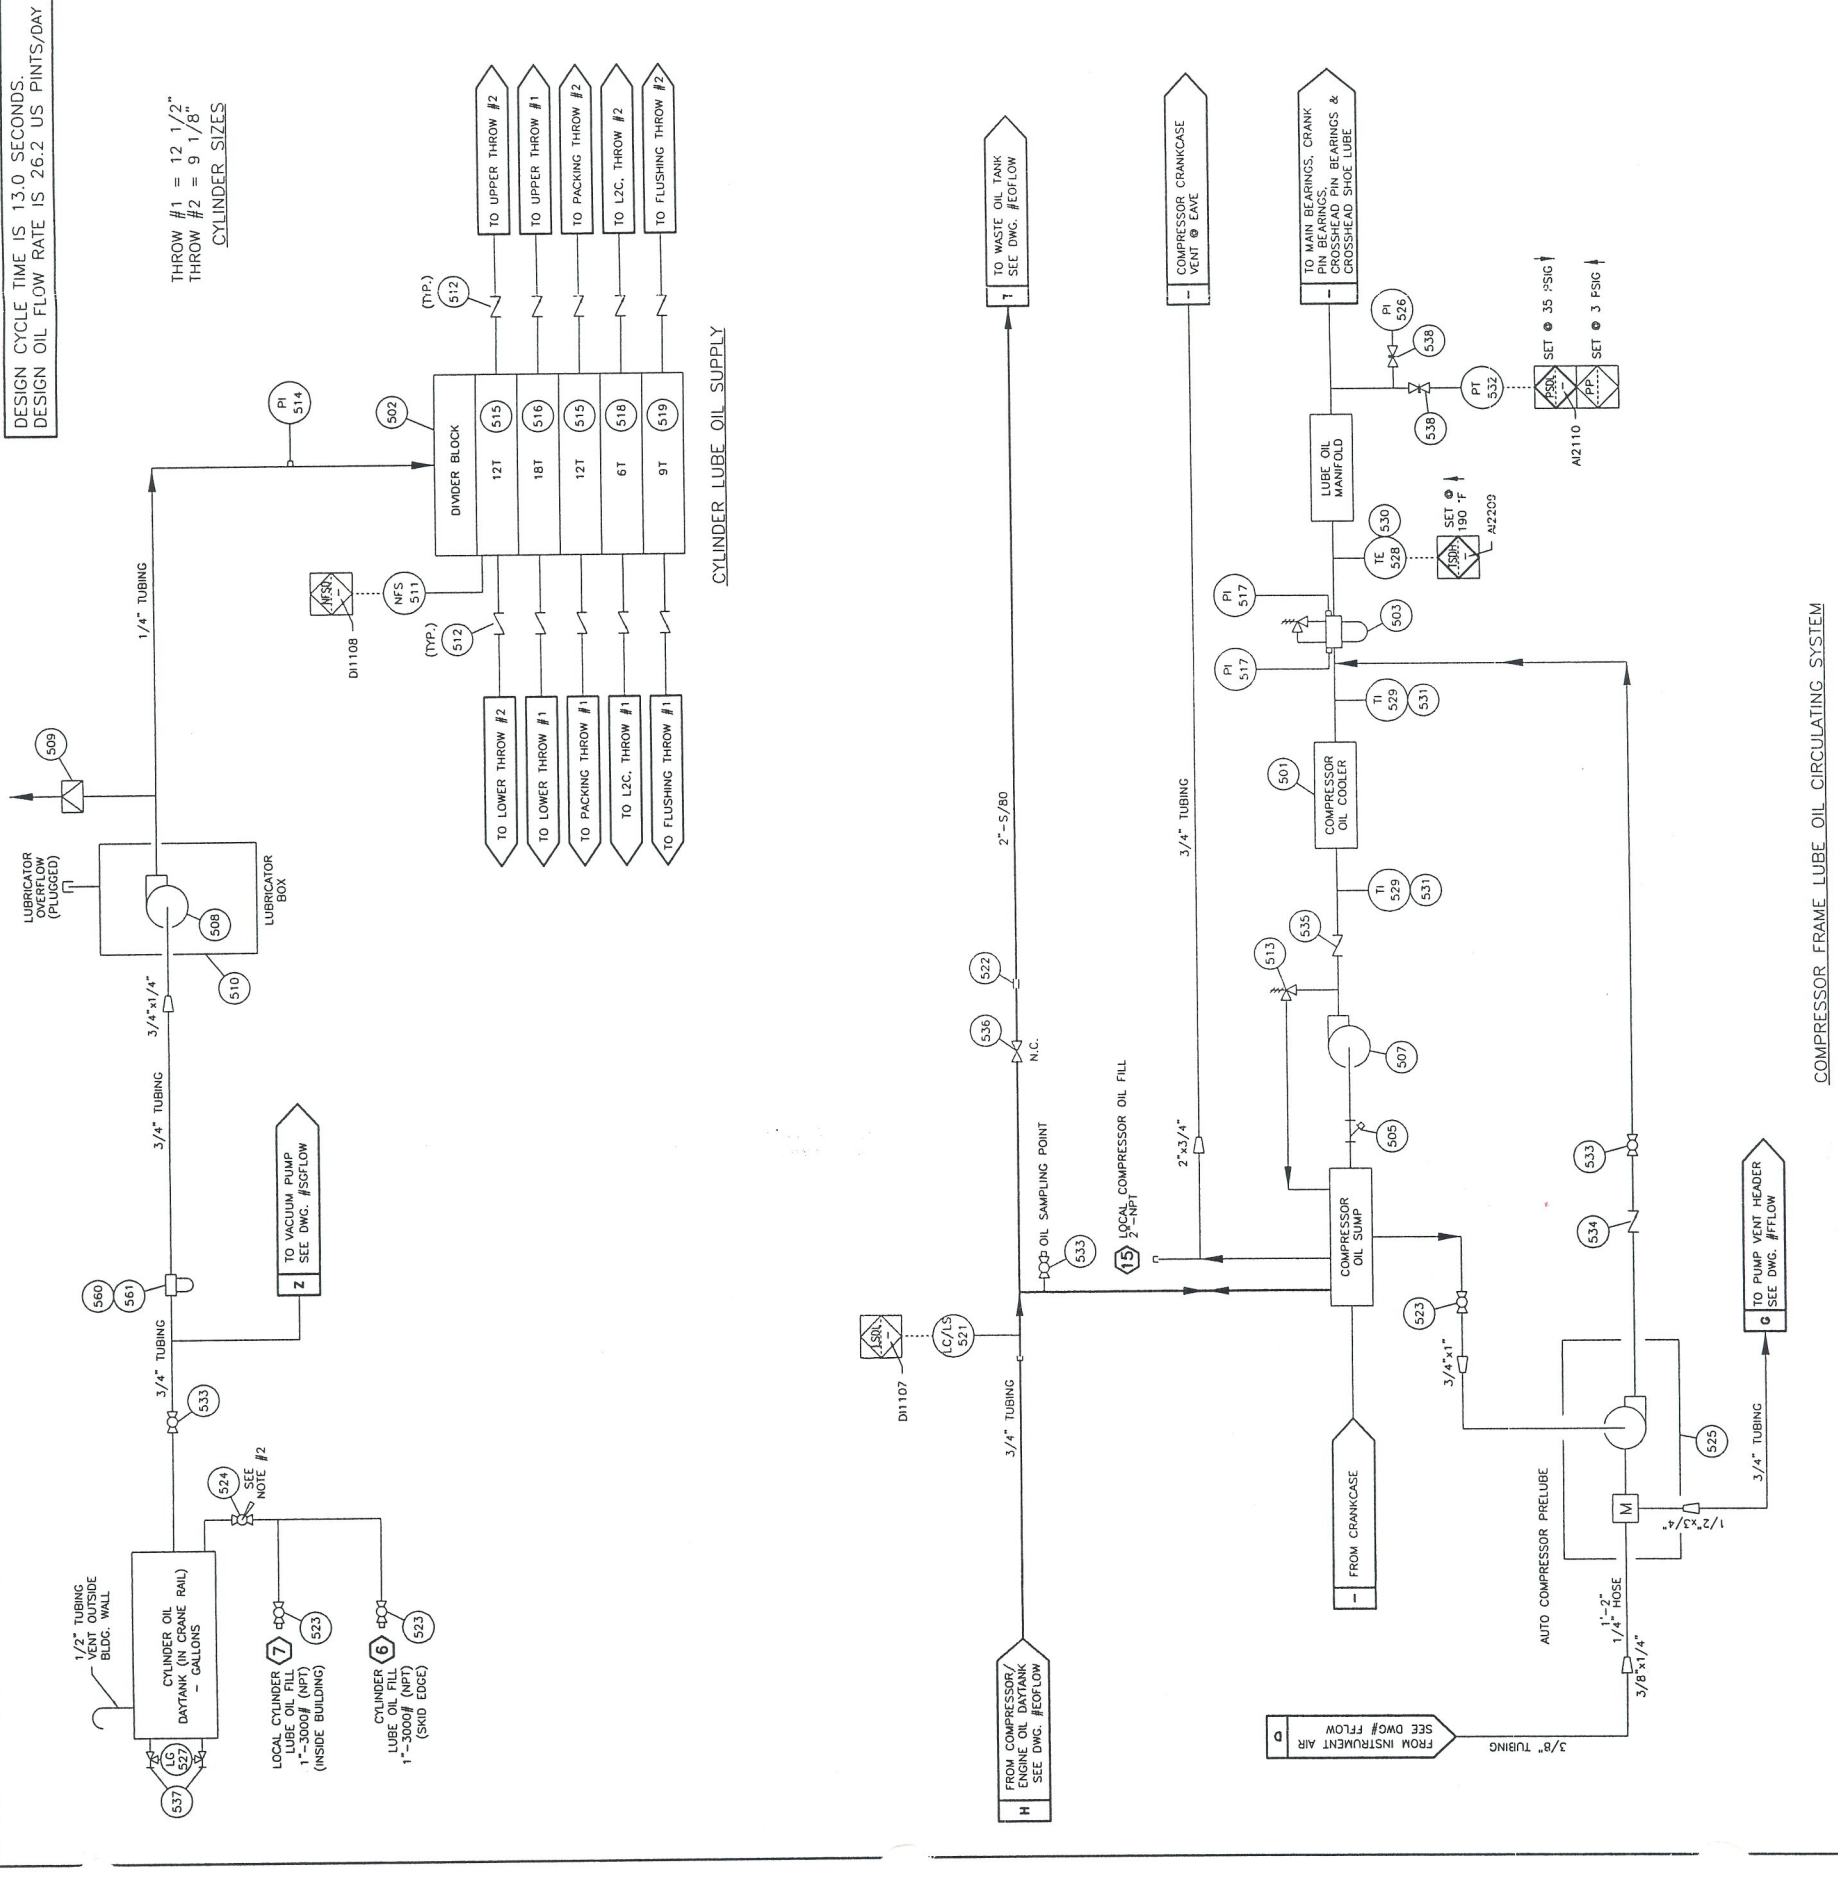

COMPRESSOR FRAME LUBE OIL CIRCULATING SYSTEM