


PLOT DATE Feb 10, 2014, gmaclean C:\Users\gmaclean\AppData\Local\Temp\AcPublish_4420\31980-01-MODEL-AS-BUILT.dwg

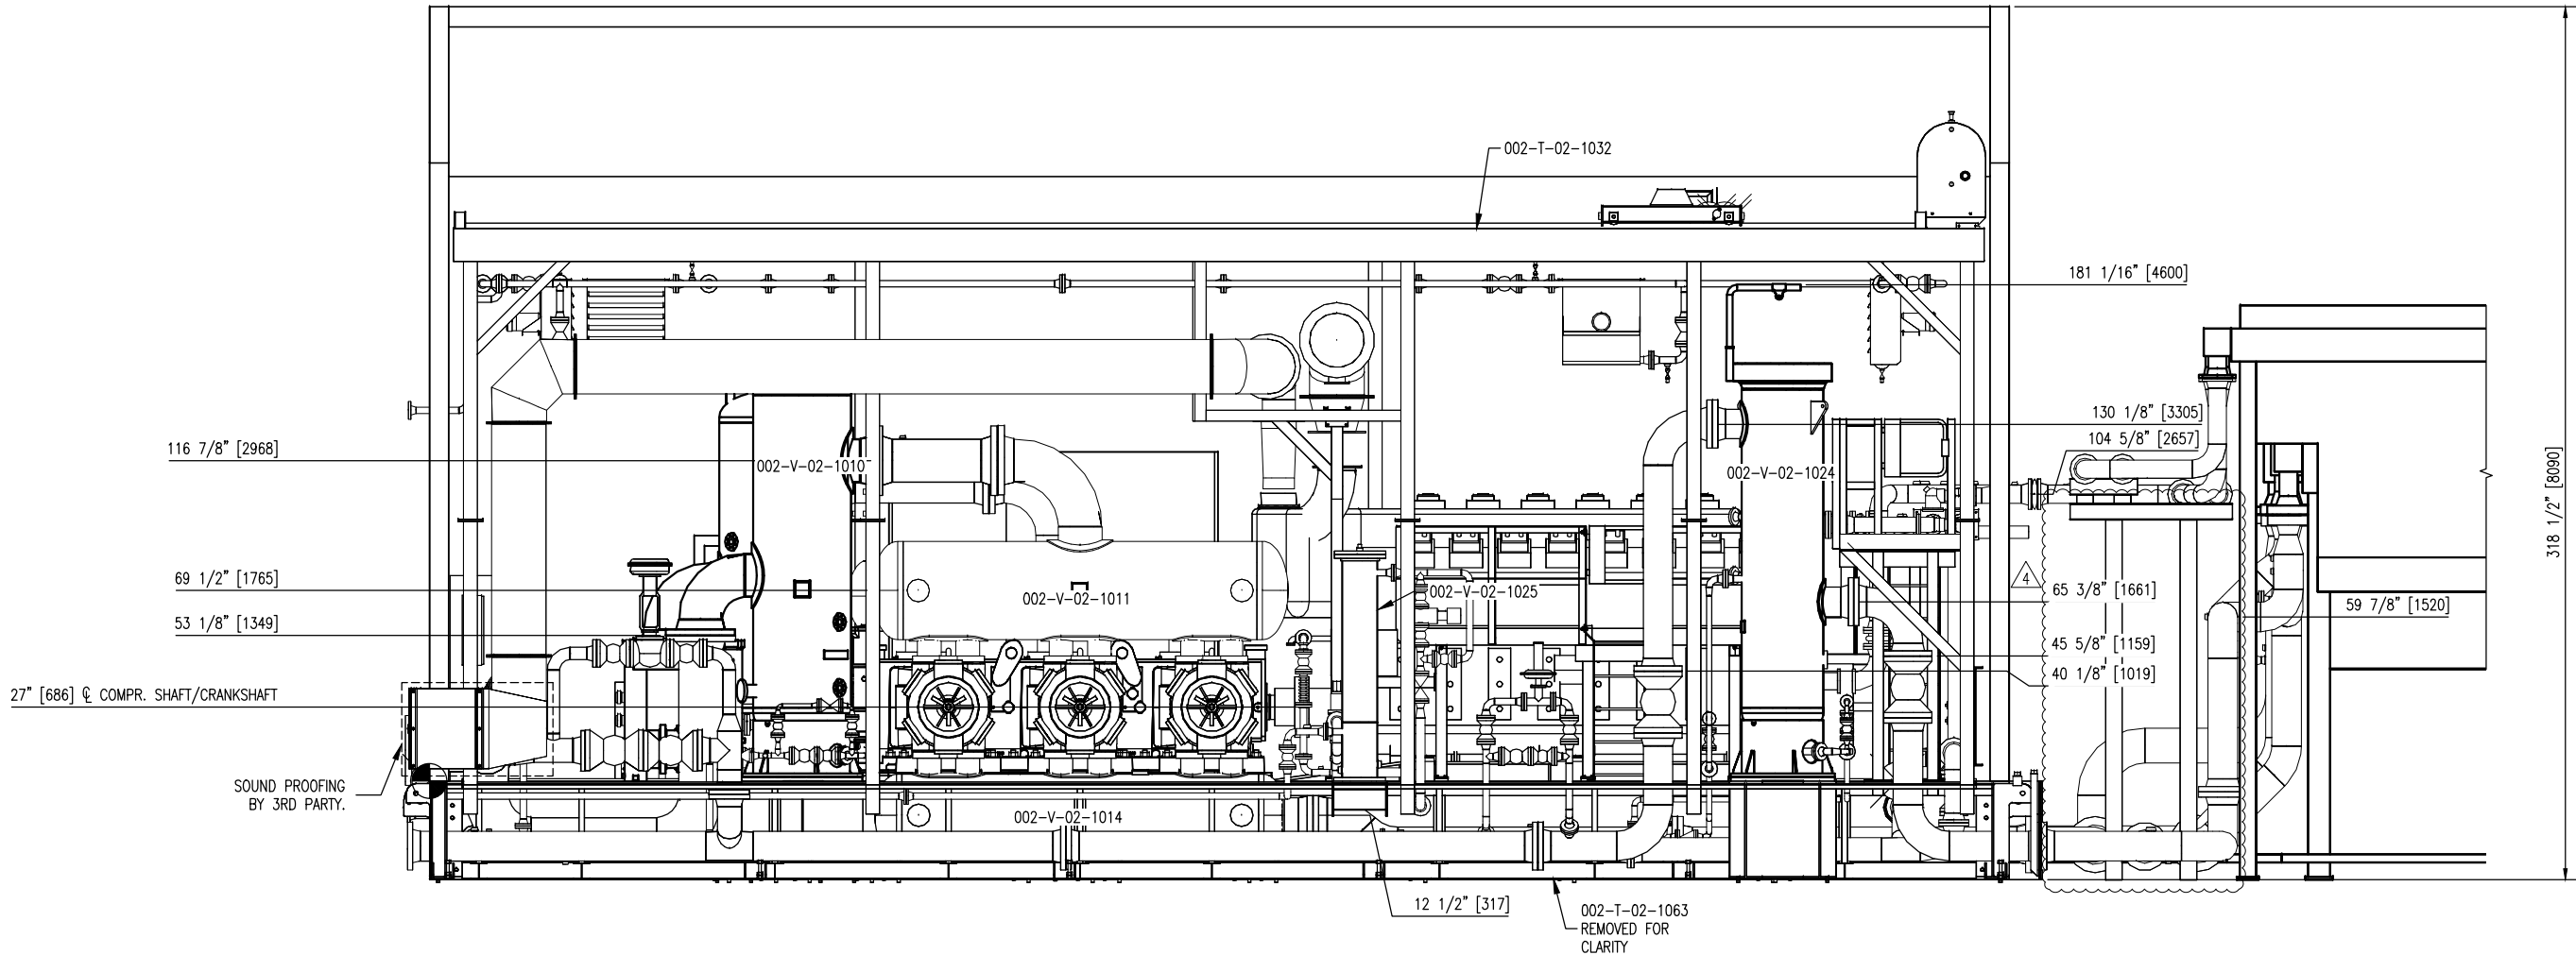

ELEVATION VIEW B-B

**FINAL
AS BUILT**
NAME: G.MACLEAN DATE: FEB 07/14

NOTE:
ALL TAIL DIMENSIONS ARE
TAKEN FROM REFERENCE
POINT \bullet AT TOP OF SKID

	5	AS-BUILT, ADDED CABLE TRAY	FEB 07/14	GM	LD	DATE	FEB 04/13	SCALE	3/8"=1'-0"	DEVON CANADA PROJECT NAME: FERRIER CPF AREA: FERRIER LSD: 11-02-039-08-W5M WBS: 01-00348.01 CAT G3616/ARIEL KBZ 6/2	ENERFLEX Calgary, Alberta, Canada	GENERAL ARRANGEMENT SECTION 'B-B'	DWG NO	31980-01-201	SHT	3	REV	5									
	4	AS-BUILT, ADDED JB BOX & JW SUPPORT	JAN 20/14	GM	LD	DRAWN BY	G.MACLEAN	CHECKED BY	G.TIWANA										APPROVED BY	L.DIOQUINO							
	3	AS-BUILT, ADDED OFF-SKID CLAMP LOCATIONS	OCT 04/13	GM	LD	PROJECT MANAGER	B.MINSHULL	PROJECT ENGINEER	L.DIOQUINO																		
	2	AS-BUILT	SEP 03/13	GM	LD	CUST PO	N/A																				
	1	RELOCATED NOZ 9/10/11, AIR INTAKE, REM NOZ 19	JUN 12/13	GM	LD																						
	0	ISSUED FOR CONSTRUCTION	MAY 28/13	GM	LD																						
REV	DESCRIPTION		DATE	BY	APR	APEGGA PERMIT No:	P8651	OPER. CODE	198/298/490/511/591	WORK ORDER	31980-01																