


PLOT DATE Feb 10, 2014, gmaclean C:\Users\gmaclean\AppData\Local\Temp\VerPublish\_4420\31980-01-MODEL-AS-BUILT.dwg

NOTE:  
ALL TAIL DIMENSIONS ARE  
TAKEN FROM REFERENCE  
POINT  AT TOP OF SKID

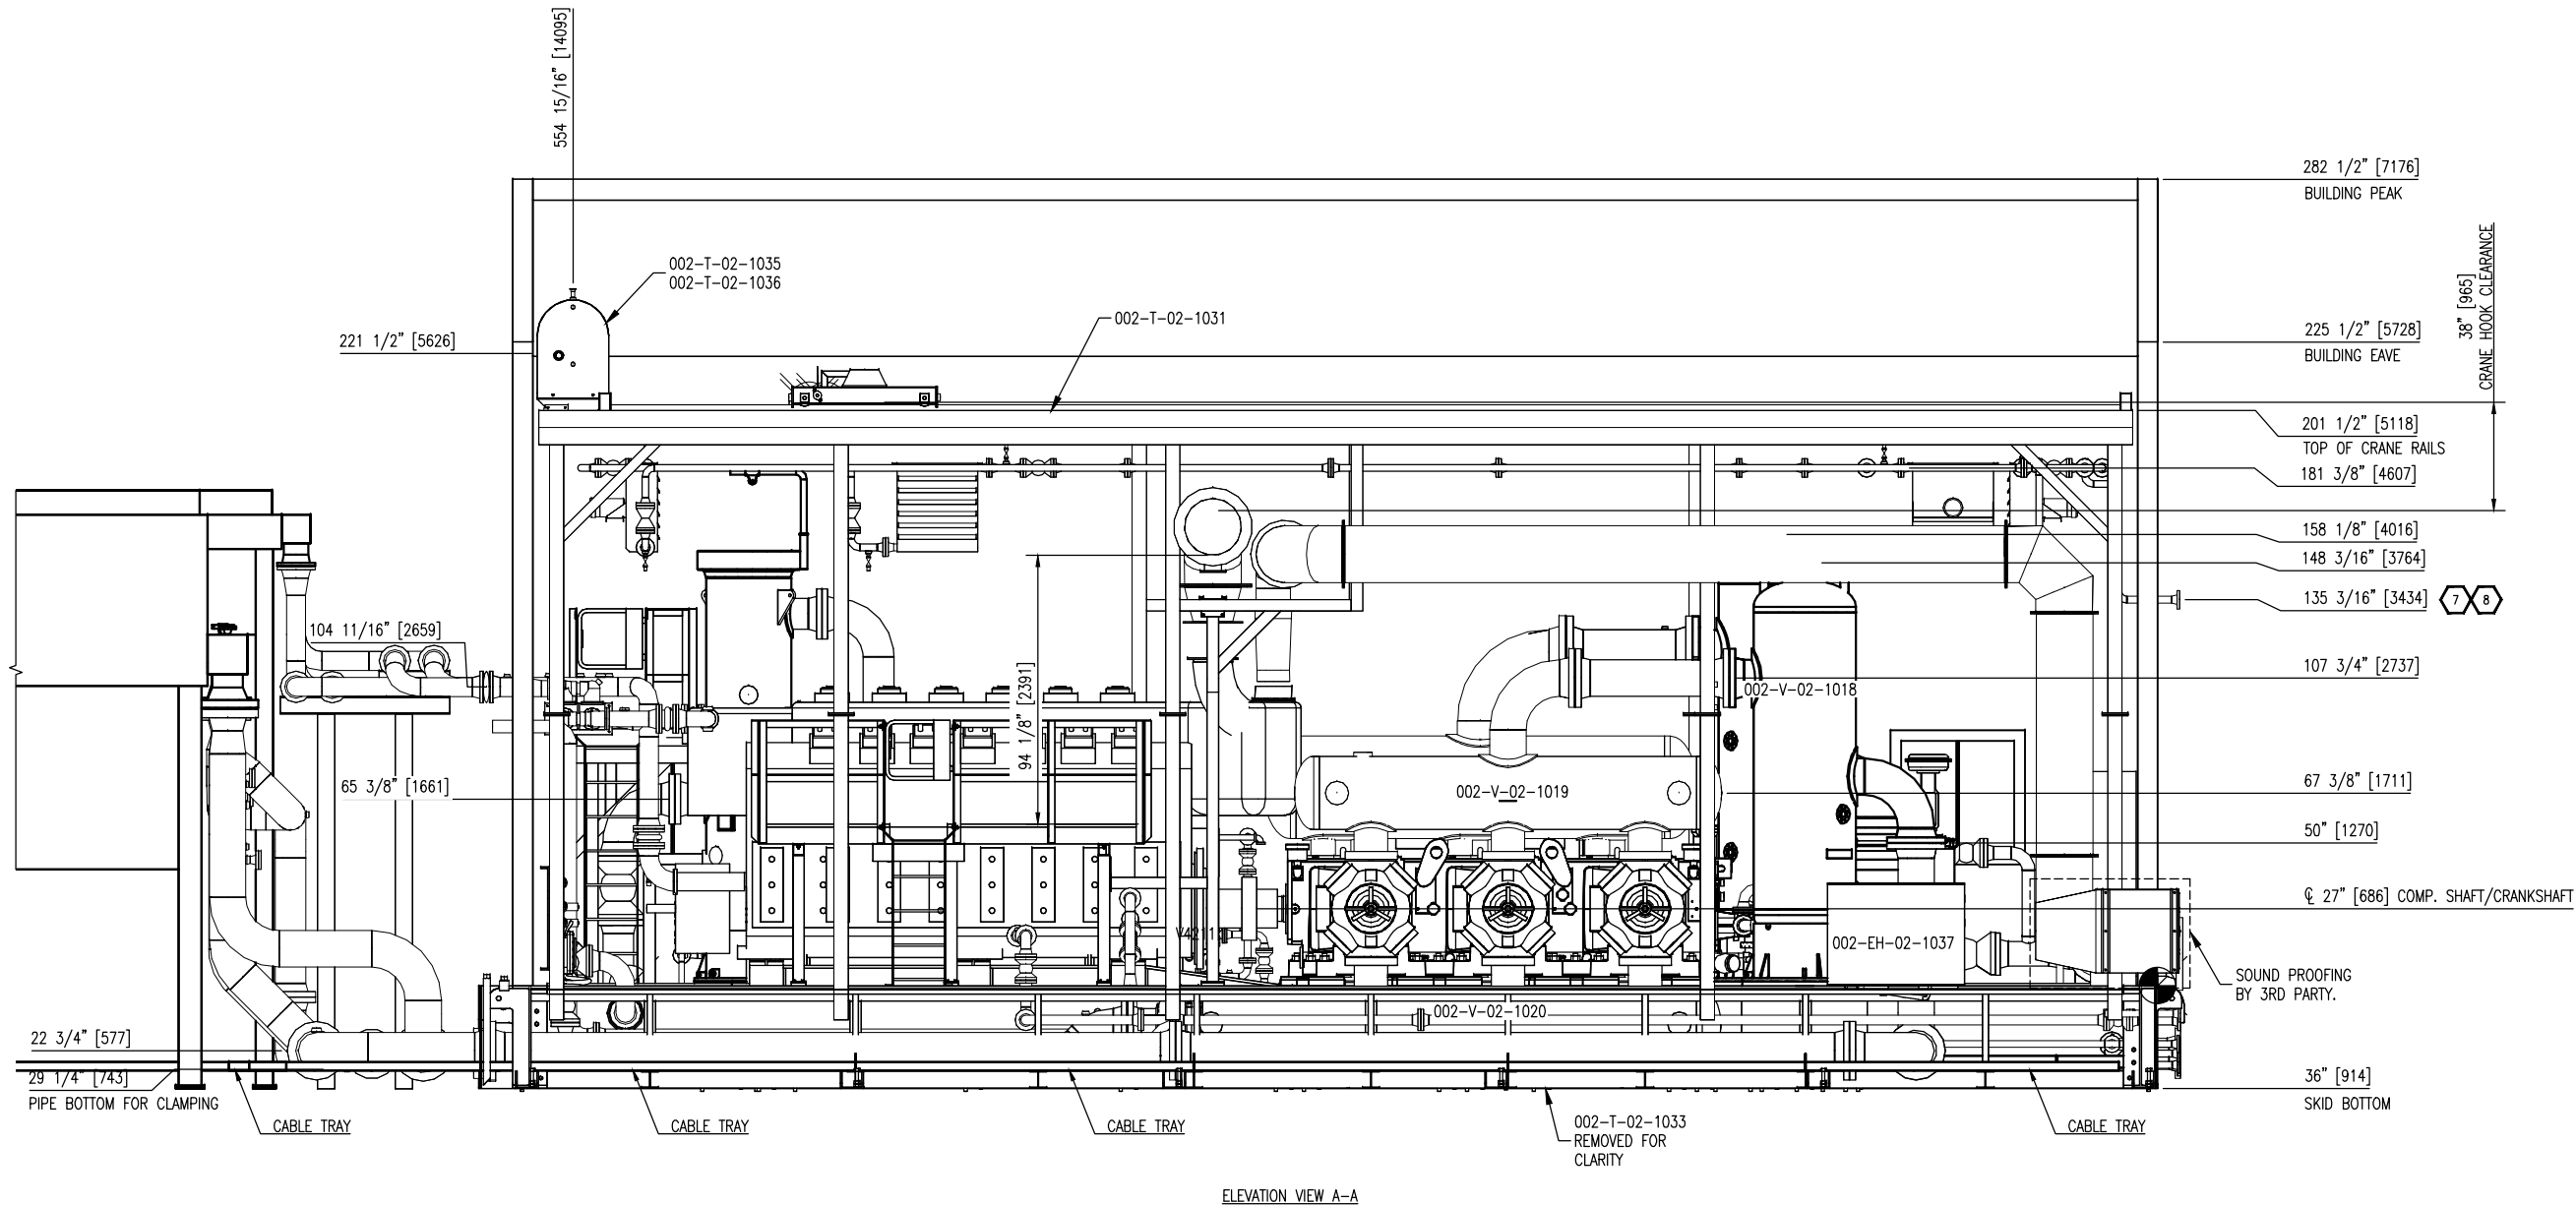

**FINAL  
AS BUILT**  
NAME G.MACLEAN DATE FEB 07/14

	5	AS-BUILT, ADDED CABLE TRAY	FEB 07/14	GM	LD	DATE	FEB 04/13	SCALE	3/8"=1'-0"	DEVON CANADA PROJECT NAME: FERRIER CPF AREA: FERRIER LSD: 11-02-039-08-W5M WBS: 01-00348.01 CAT G3616/ARIEL KBZ 6/2	<b>ENERFLEX</b> Calgary, Alberta, Canada	<u>GENERAL ARRANGEMENT</u> SECTION 'A-A'						
	4	AS-BUILT, ADDED JB BOX & JW SUPPORT	JAN 20/14	GM	LD	DRAWN BY	G.MACLEAN	CHECKED BY	G.TIWANA				APPROVED BY	L.DIOQUINO				
	3	AS-BUILT, ADDED OFF-SKID CLAMP LOCATIONS	OCT 04/13	GM	LD	PROJECT MANAGER	B.MINSHULL	PROJECT ENGINEER	L.DIOQUINO									
	2	AS-BUILT	SEP 03/13	GM	LD													
	1	RELOCATED NOZ 9/10/11, AIR INTAKE, REM NOZ 19	JUN 12/13	GM	LD													
	0	ISSUED FOR CONSTRUCTION	MAY 28/13	GM	LD													
REV	DESCRIPTION		DATE	BY	APR	APEGGA PERMIT No: P8651		OPER. CODE 198/298/490/511/591		WORK ORDER 31980-01		DWG NO	31980-01-201		SHT	2	REV	5