
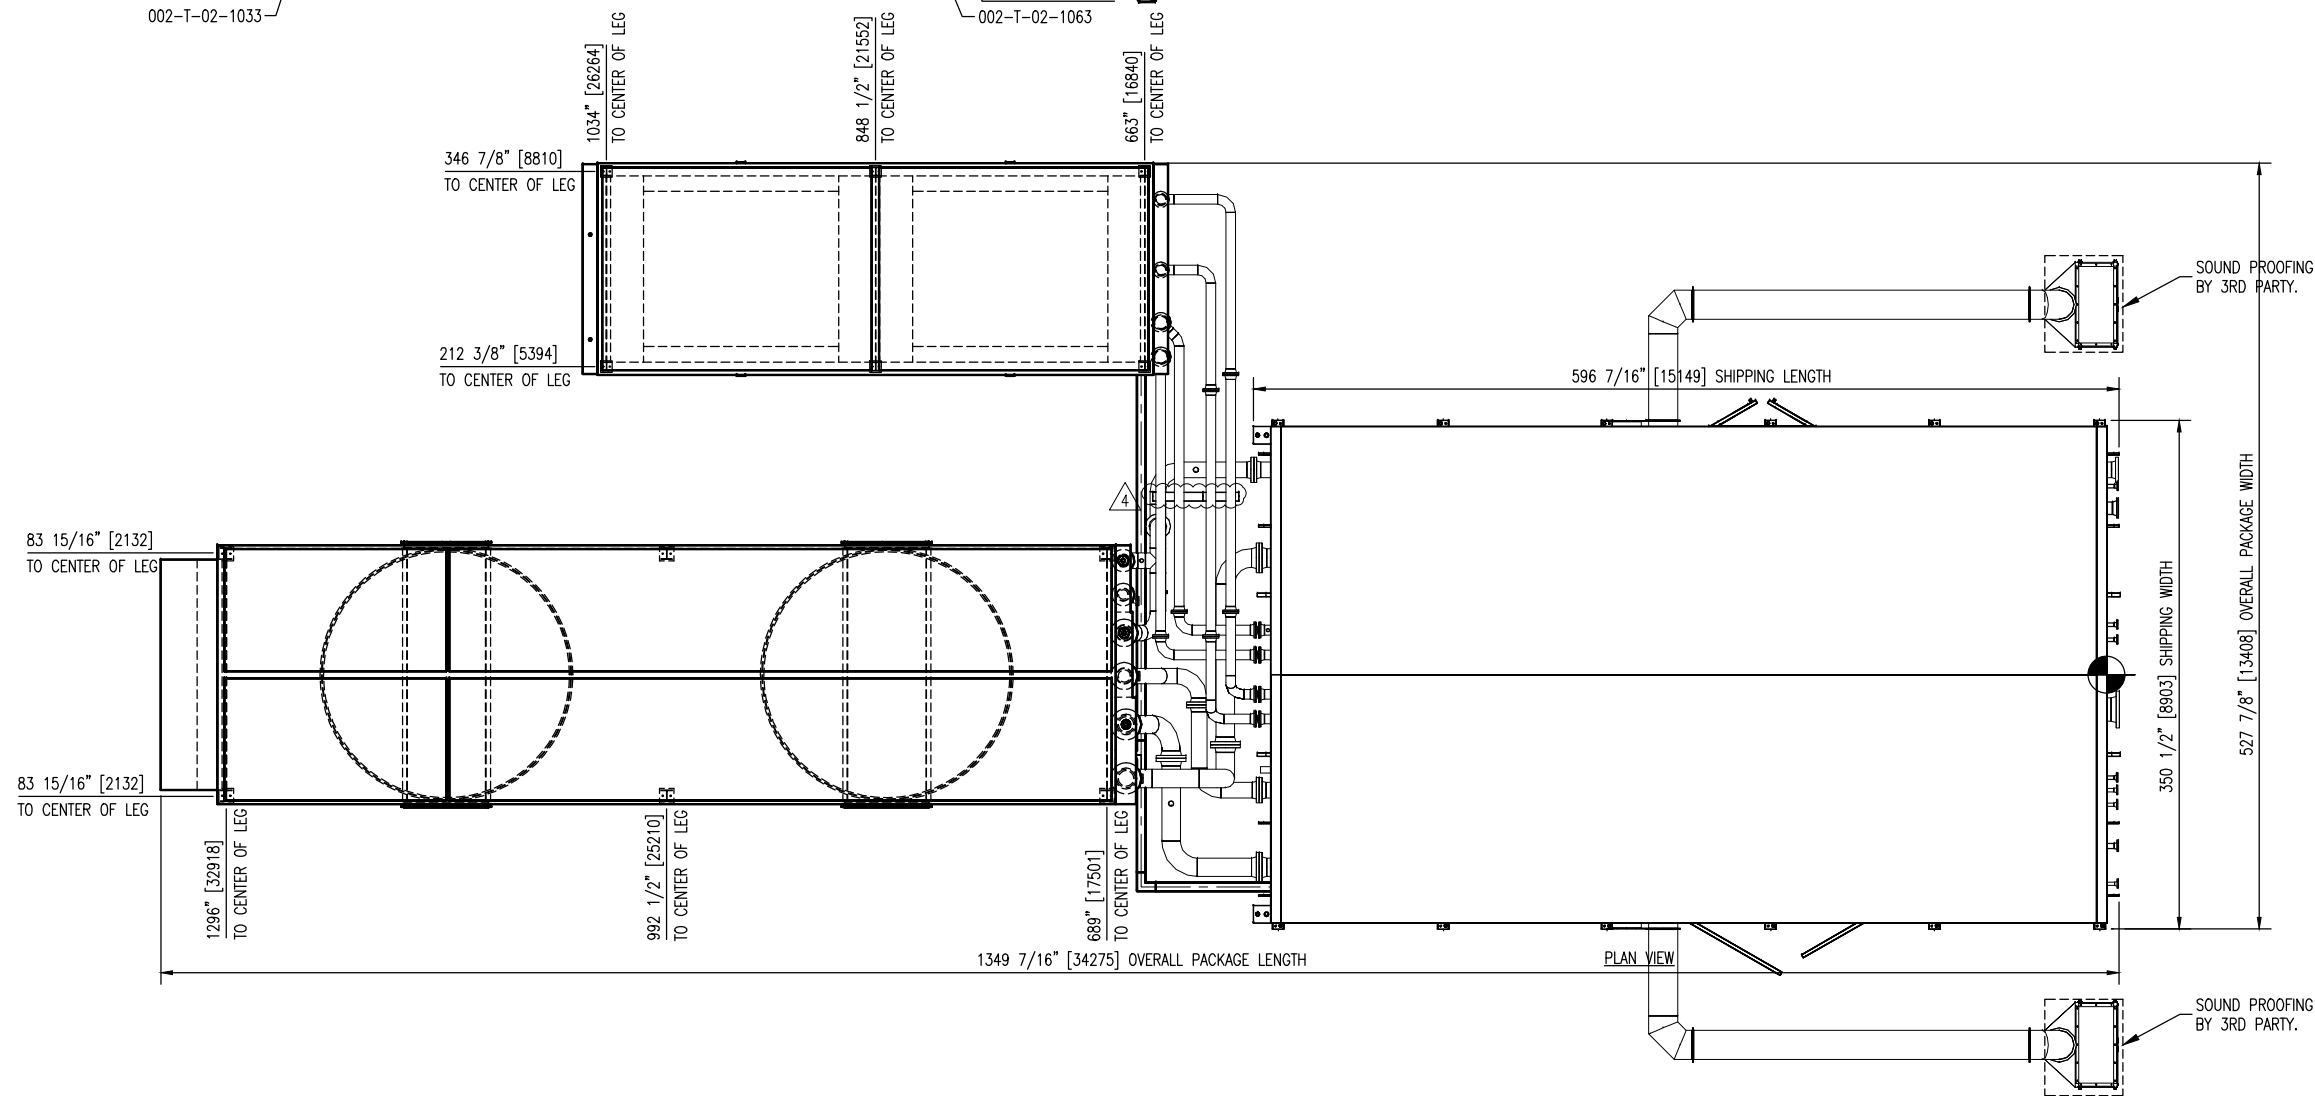
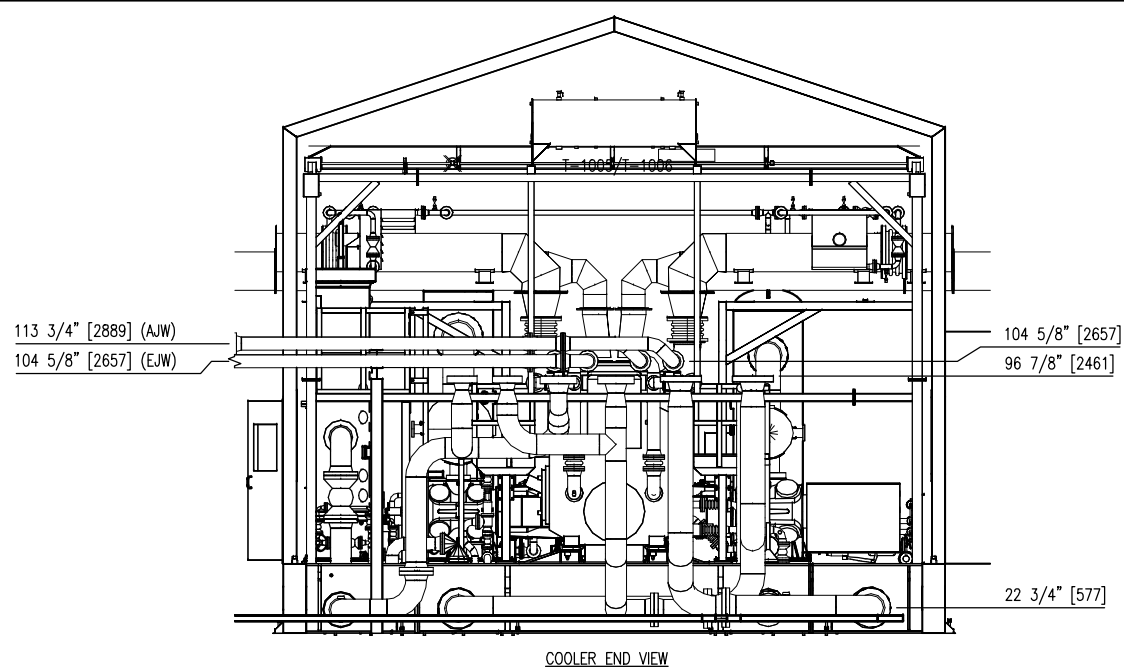


PLOT DATE Feb 10, 2014, gmaclean C:\Users\gmaclean\AppData\Local\Temp\AcPublish\_4420\31980-01-MODEL-AS-BUILT.dwg

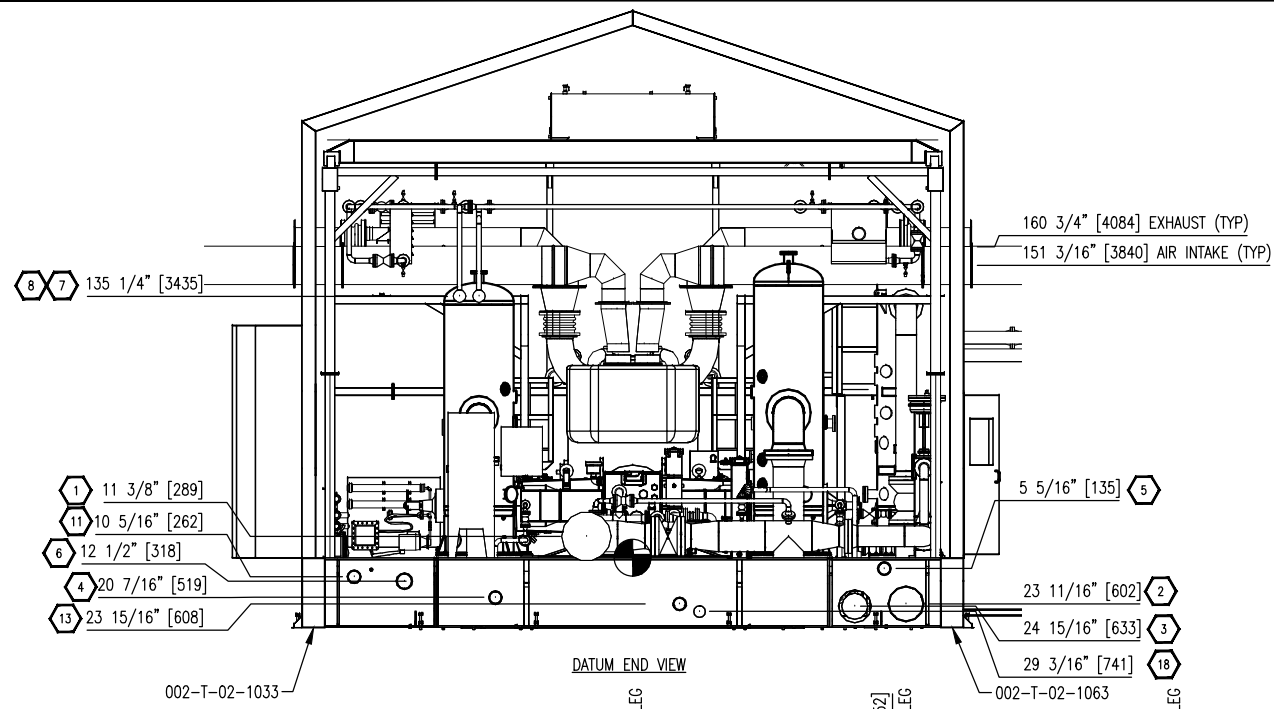

**FINAL  
AS BUILT**  
NAME G.MACLEAN DATE FEB 07/14

REV	DESCRIPTION	DATE	BY	APR	APEGGA PERMIT No: P8651	OPER. CODE 198/298/490/511/591	WORK ORDER 31980-01	DWG NO 31980-01-201	SHT 4	REV 5
5	AS-BUILT, ADDED CABLE TRAY	FEB 07/14	GM	LD	DATE FEB 04/13	SCALE 1/4"=1'-0"	DEVON CANADA PROJECT NAME: FERRIER CPF AREA: FERRIER LSD: 11-02-039-08-W5M WBS: 01-00348.01 CAT G3616/ARIEL KBZ 6/2	<b>ENERFLEX</b> Calgary, Alberta, Canada	GENERAL ARRANGEMENT OVERALL PLAN & END VIEWS	
4	AS-BUILT, ADDED JB BOX & JW SUPPORT	JAN 20/14	GM	LD	DRAWN BY G.MACLEAN	CHECKED BY G.TIWANA				
3	AS-BUILT, ADDED OFF-SKID CLAMP LOCATIONS	OCT 04/13	GM	LD	PROJECT MANAGER B.MINSHULL	PROJECT ENGINEER L.DIOQUINO				
2	AS-BUILT	SEP 03/13	GM	LD	CUST PO N/A					
1	RELOCATED NOZ 9/10/11, AIR INTAKE, REM NOZ 19	JUN 12/13	GM	LD						
0	ISSUED FOR CONSTRUCTION	MAY 28/13	GM	LD						