


PLOT DATE Feb 10, 2014, gmaclean C:\Users\gmaclean\AppData\Local\Temp\gmaclean_4420\31980-01-MODEL-AS-BUILT.dwg

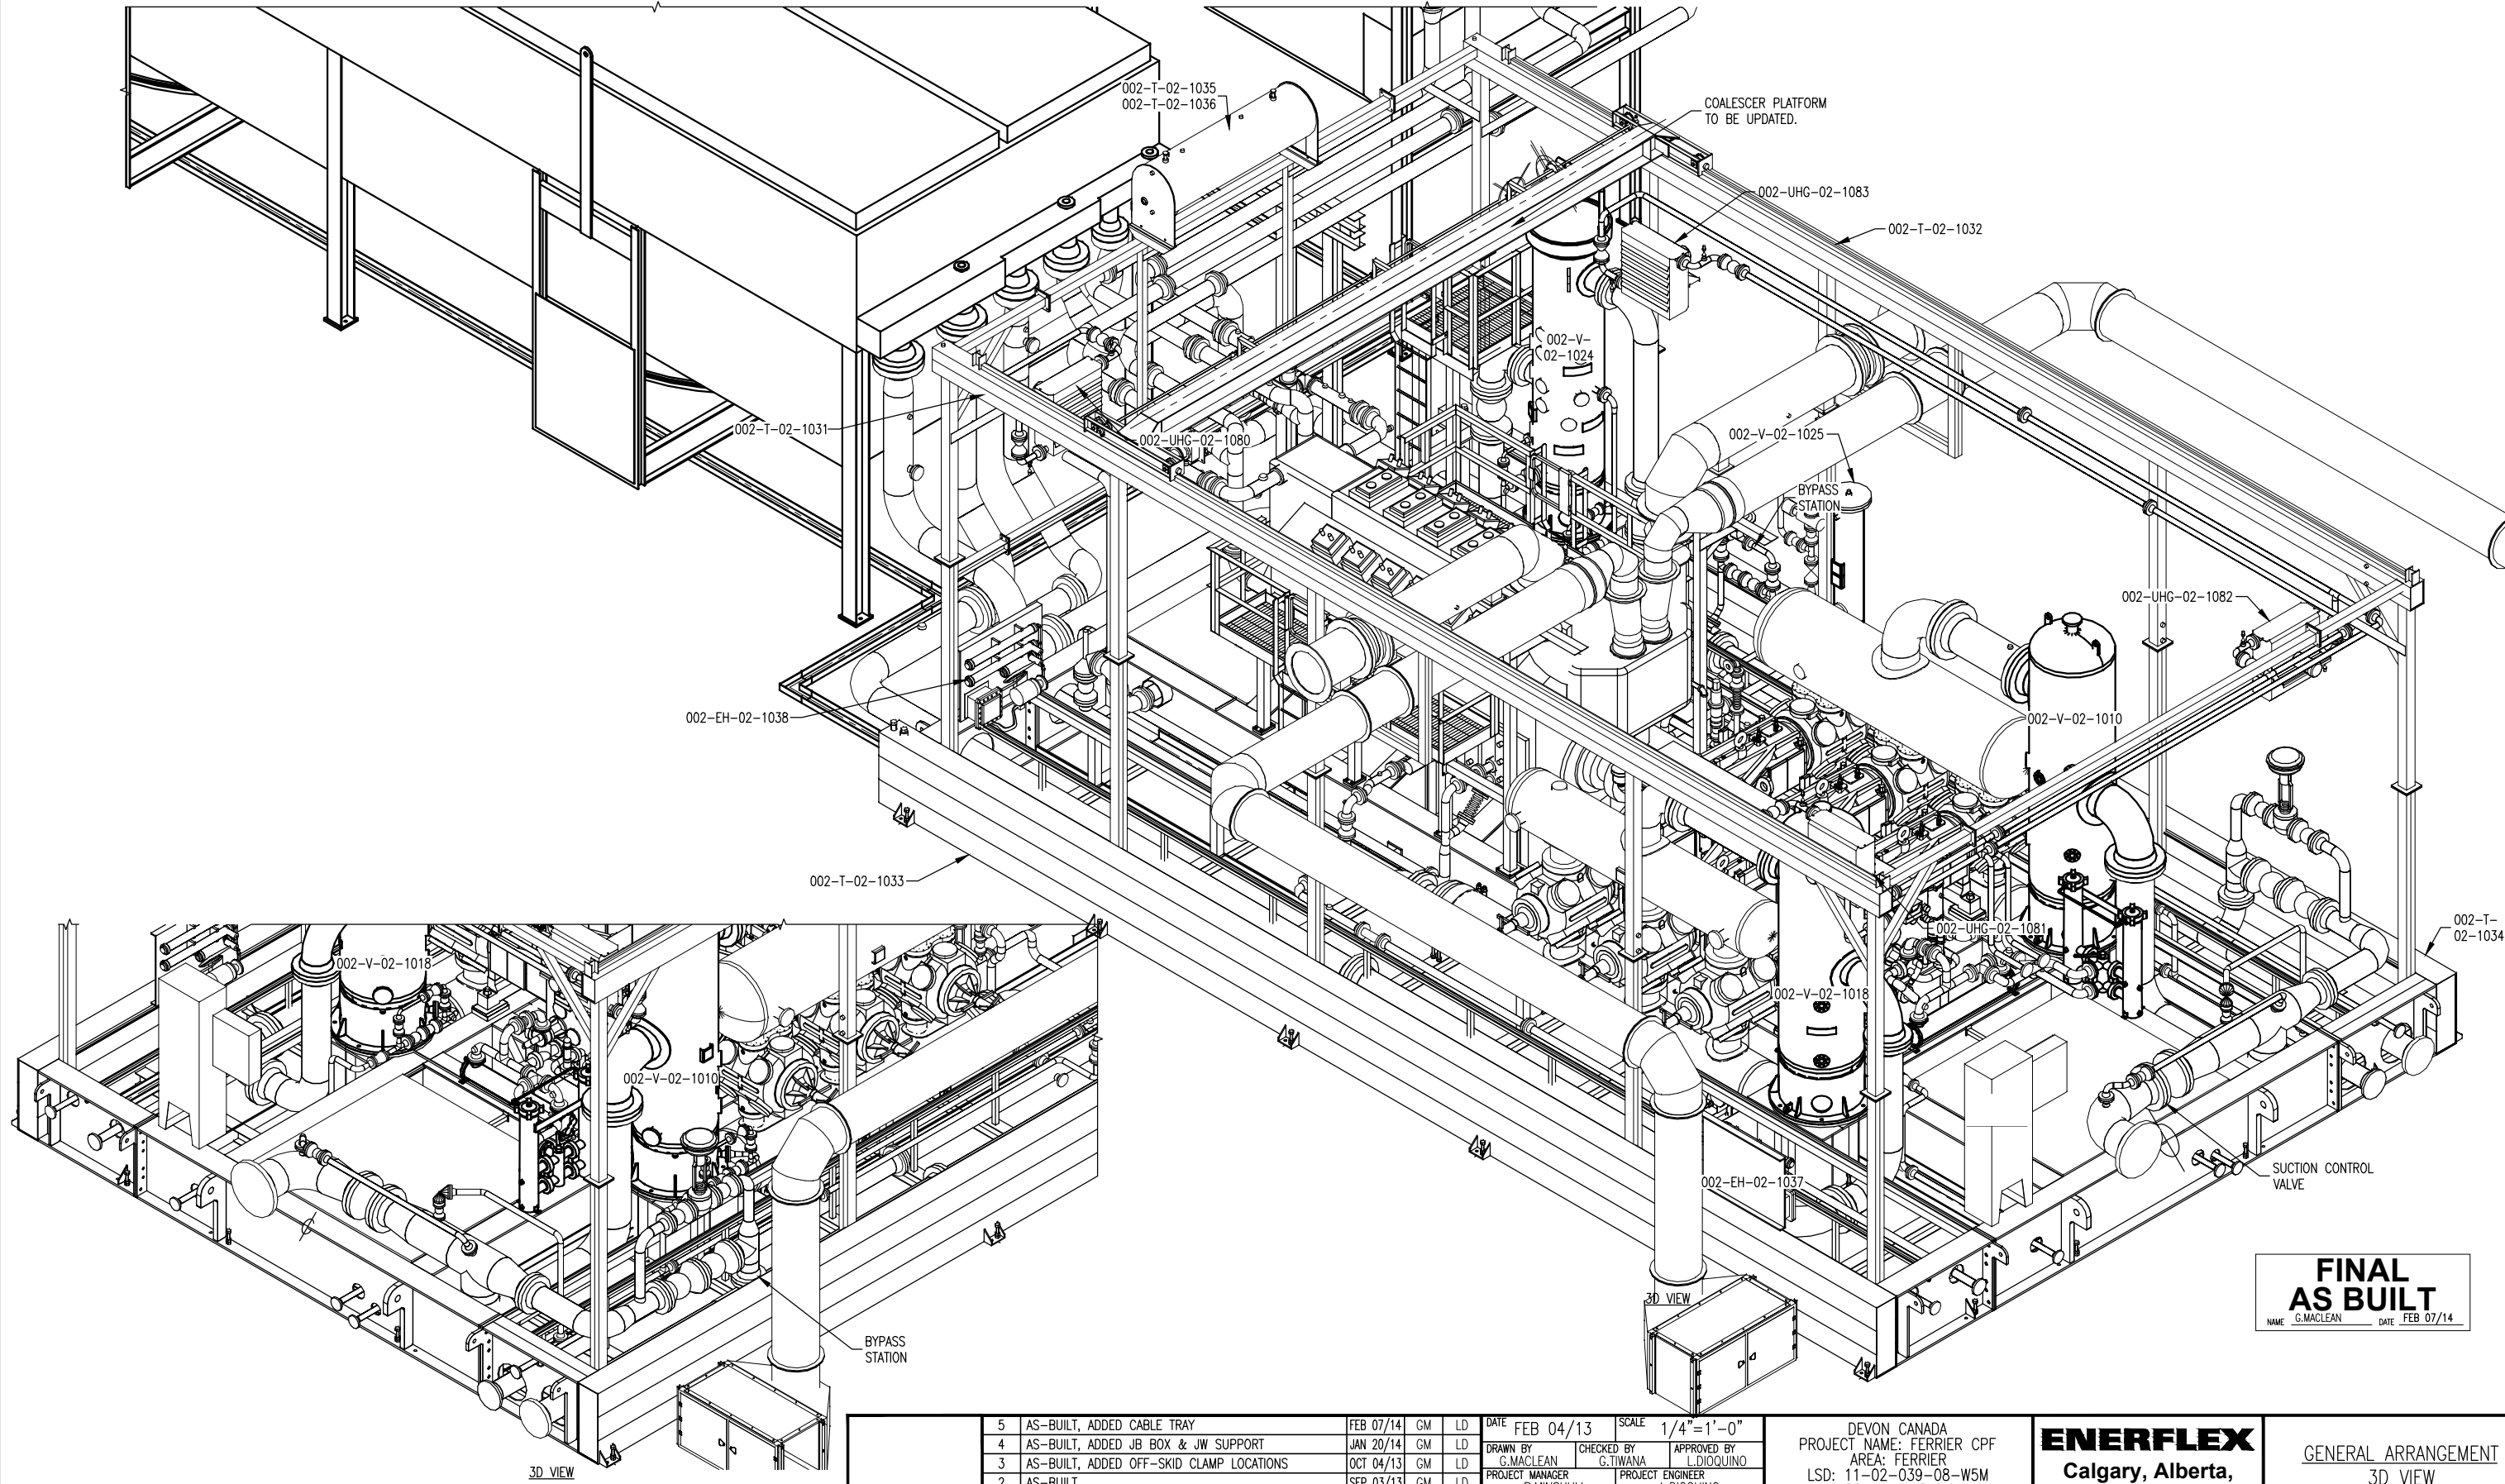

**FINAL
AS BUILT**
NAME: G.MACLEAN DATE: FEB 07/14

	5	AS-BUILT, ADDED CABLE TRAY	FEB 07/14	GM	LD	DATE	FEB 04/13	SCALE	1/4"=1'-0"	DEVON CANADA PROJECT NAME: FERRIER CPF AREA: FERRIER LSD: 11-02-039-08-W5M WBS: 01-00348.01 CAT G3616/ARIEL KBZ 6/2	ENERFLEX Calgary, Alberta, Canada	GENERAL ARRANGEMENT 3D VIEW					
	4	AS-BUILT, ADDED JB BOX & JW SUPPORT	JAN 20/14	GM	LD												
	3	AS-BUILT, ADDED OFF-SKID CLAMP LOCATIONS	OCT 04/13	GM	LD	DRAWN BY	CHECKED BY	APPROVED BY									
	2	AS-BUILT	SEP 03/13	GM	LD	G.MACLEAN	G.TIWANA	L.DIOQUINO									
	1	RELOCATED NOZ 9/10/11, AIR INTAKE, REM NOZ 19	JUN 12/13	GM	LD	PROJECT MANAGER	PROJECT ENGINEER										
	0	ISSUED FOR CONSTRUCTION	MAY 28/13	GM	LD	B.MINSHULL	L.DIOQUINO										
						CUST PO	N/A										
REV		DESCRIPTION	DATE	BY	APR	APEGA PERMIT No:	P8651	OPER. CODE	198/298/490/511/591	WORK ORDER	31980-01	DWG NO	31980-01-201	SHT	5	REV	5