


PLOT DATE Feb 10, 2014, gmaclean C:\Users\gmaclean\AppData\Local\Temp\AcPublish_4420\31980-02-MODEL-AS-BUILT.dwg

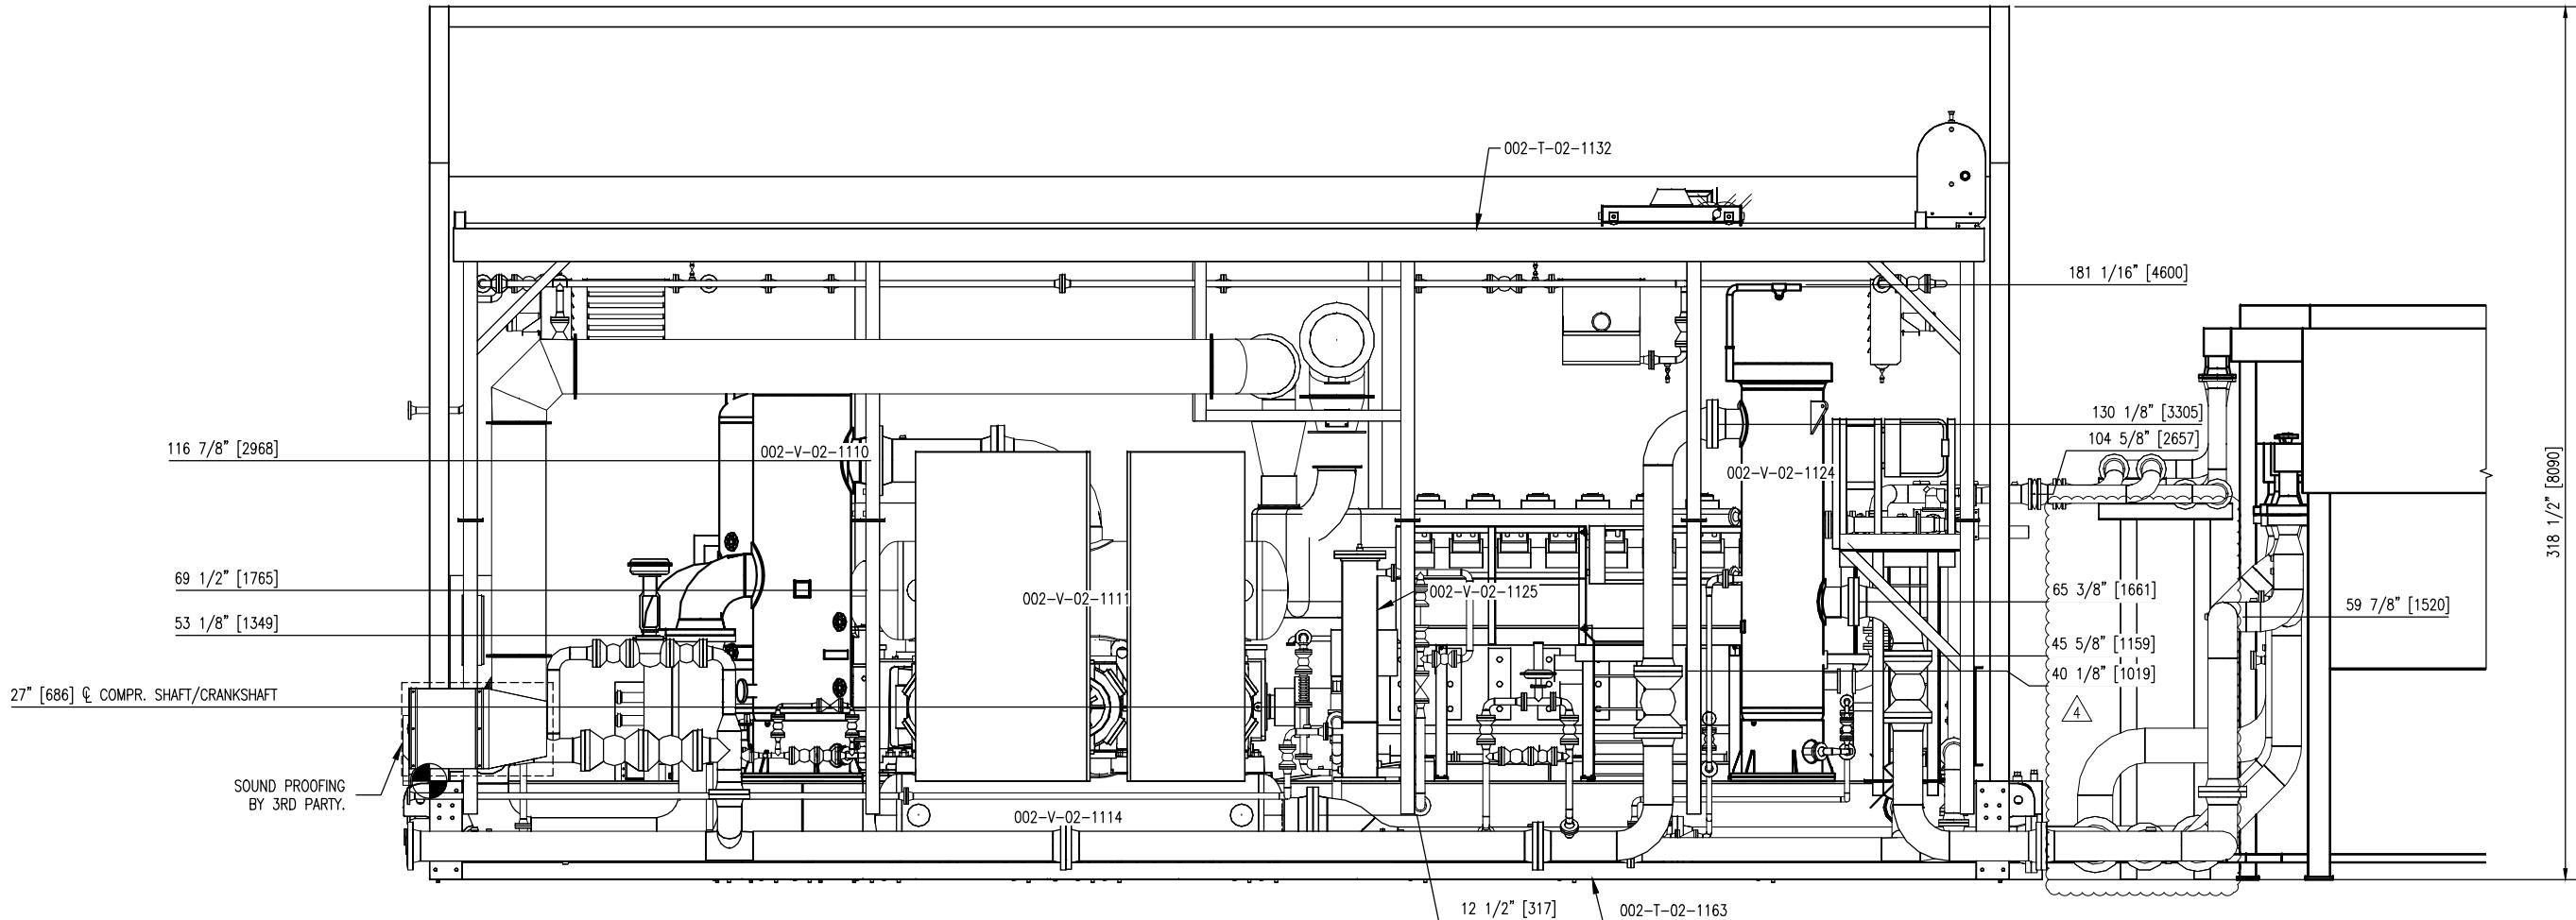

ELEVATION VIEW B-B

**FINAL
AS BUILT**
NAME G.MACLEAN DATE FEB 07/14

NOTE:
ALL TAIL DIMENSIONS ARE
TAKEN FROM REFERENCE
POINT ⬤ AT TOP OF SKID

REV	5	AS-BUILT, ADDED CABLE TRAY	FEB 07/14	GM	LD	DATE	FEB 04/13	SCALE	3/8"=1'-0"	DEVON CANADA PROJECT NAME: FERRIER CPF AREA: FERRIER LSD: 11-02-039-08-W5M WBS: 01-00348.01 CAT G3616/ARIEL KBZ 6/2	ENERFLEX Calgary, Alberta, Canada	GENERAL ARRANGEMENT SECTION 'B-B'	DWG NO	31980-02-201	SHT	3	REV	5		
	4	AS-BUILT, CUST. REF. AS PER CUST. MARKUPS	JAN 21/14	GM	LD	DRAWN BY	G.MACLEAN	CHECKED BY	G.TIWANA										APPROVED BY	L.DIOQUINO
	3	AS-BUILT, ADDED OFF-SKID CLAMP LOCATIONS	OCT 04/13	GM	LD	PROJECT MANAGER	B.MINSHULL	PROJECT ENGINEER	L.DIOQUINO											
	2	AS-BUILT	SEP 03/13	GM	LD	CUST PO	N/A													
	1	RELOCATED NOZ 9/10/11, AIR INTAKE, REM NOZ 19	JUN 14/13	GM	LD	APEGGA PERMIT No:	P8651	OPER. CODE	198/298/490/511/591										WORK ORDER	31980-02
	0	ISSUED FOR CONSTRUCTION	MAY 28/13	GM	LD															
		DESCRIPTION	DATE	BY	APR															

THE INFORMATION CONTAINED HEREIN IS THE CONFIDENTIAL PROPERTY OF ENERFLEX, LTD., AND IS NOT FOR PUBLICATION, AND NO PART THEREOF SHALL BE COPIED OR COMMUNICATED TO A THIRD PARTY WITHOUT AUTHORIZATION FROM ENERFLEX, LTD.