
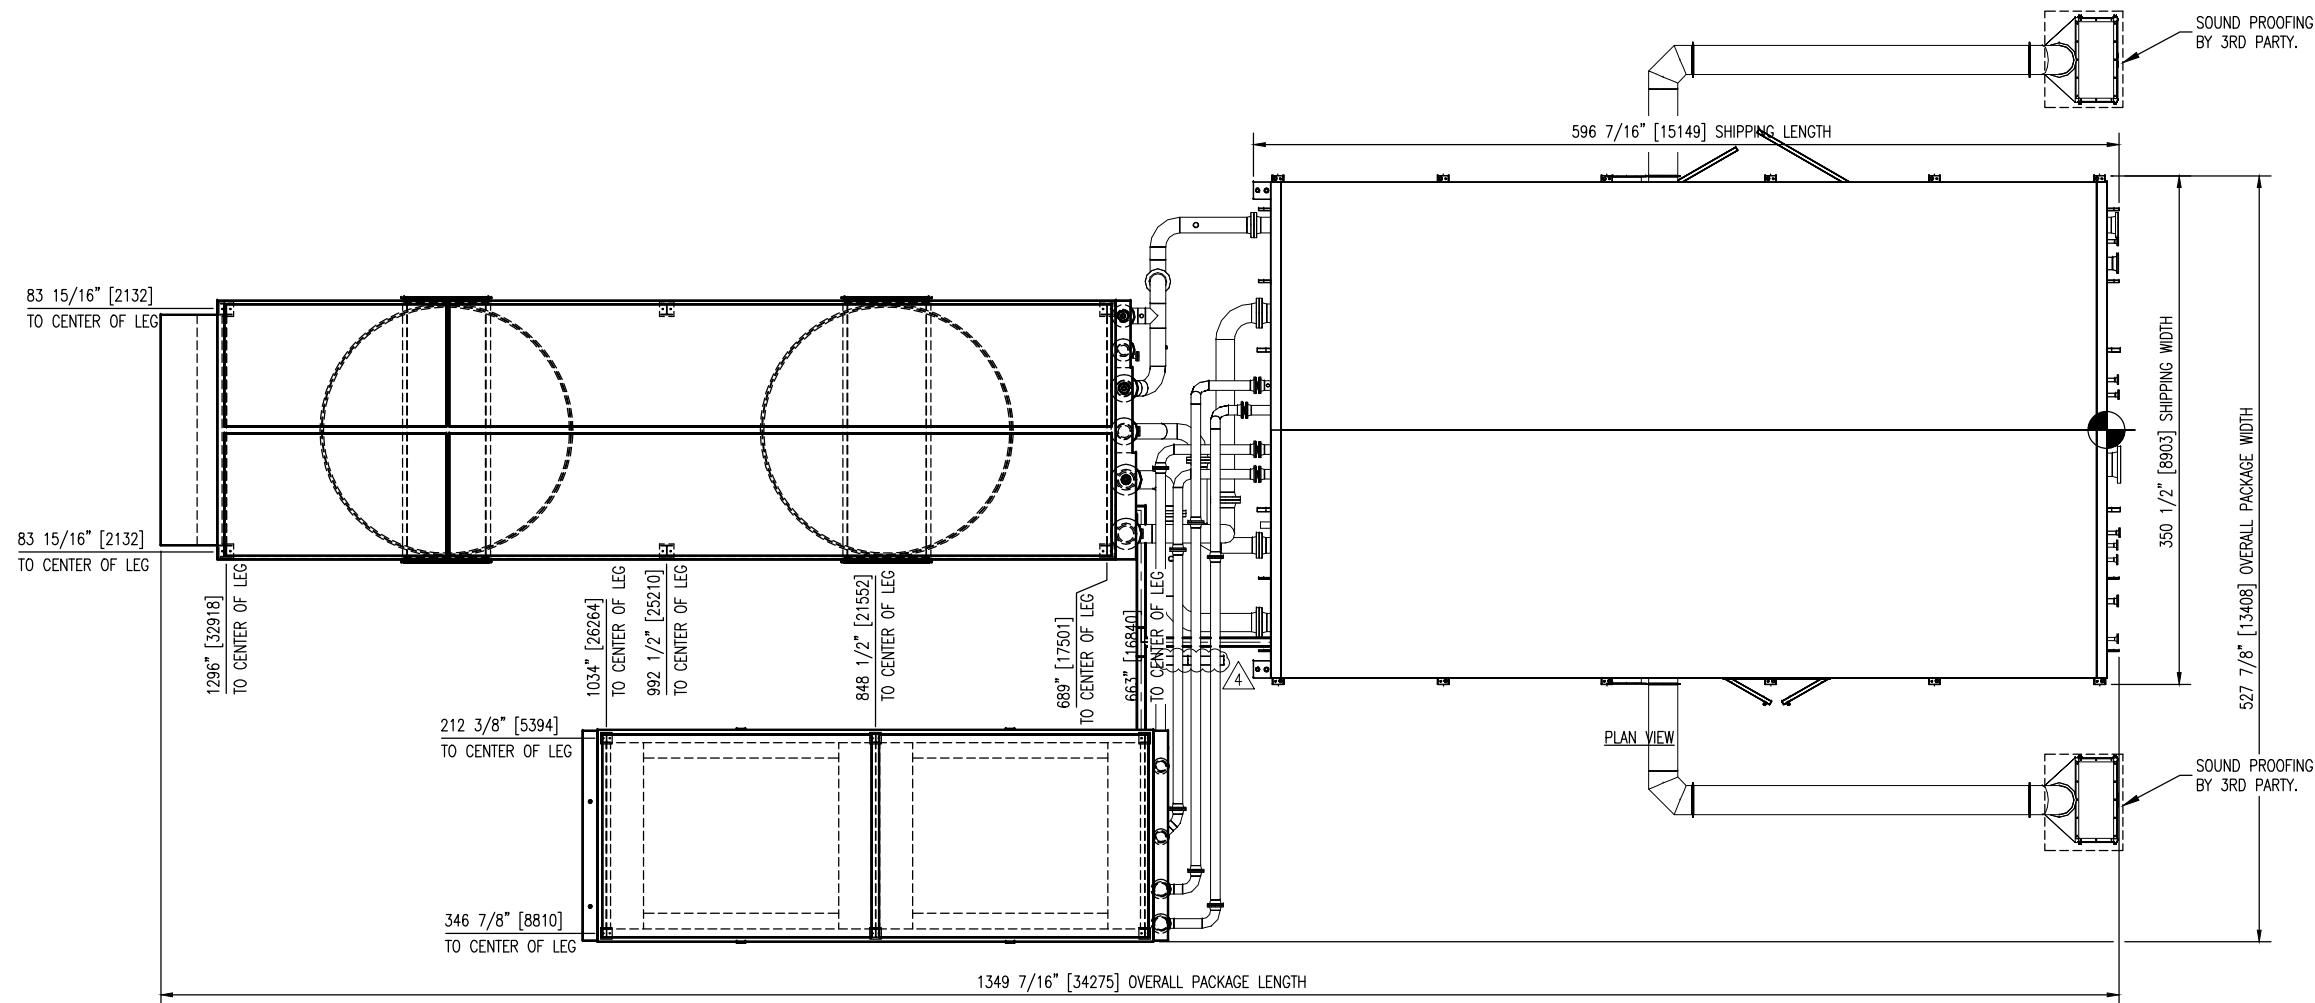
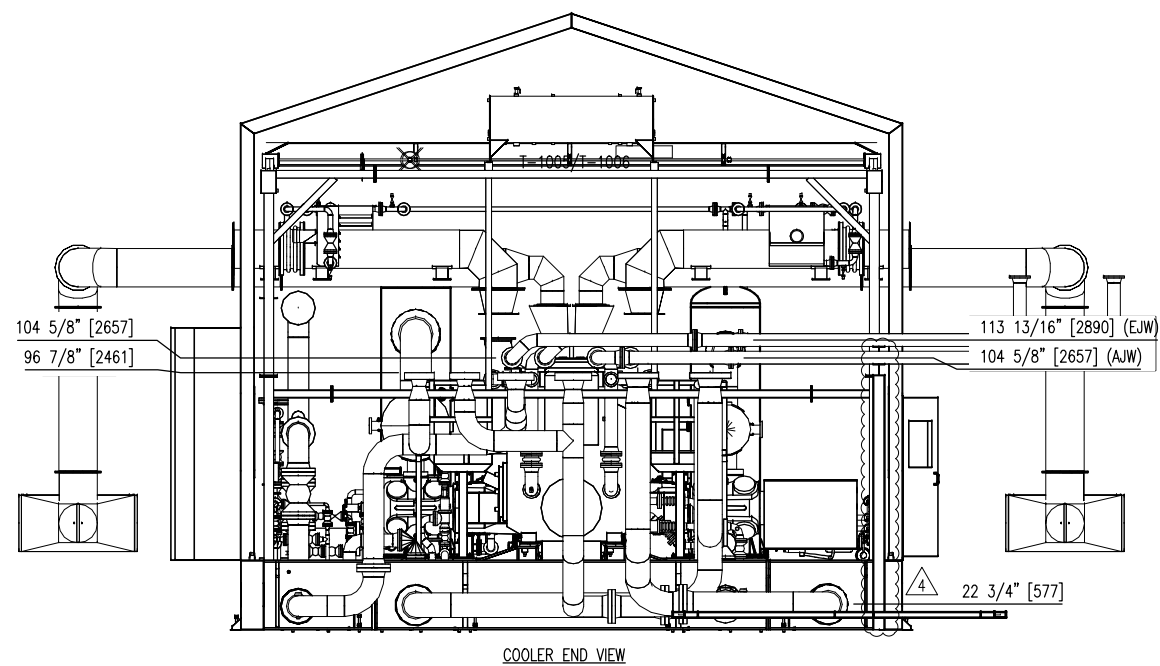


PLOT DATE Feb 10, 2014, gmaclean C:\Users\gmaclean\AppData\Local\Temp\Veripush\_4420\31980-02-MODEL-AS-BUILT.dwg

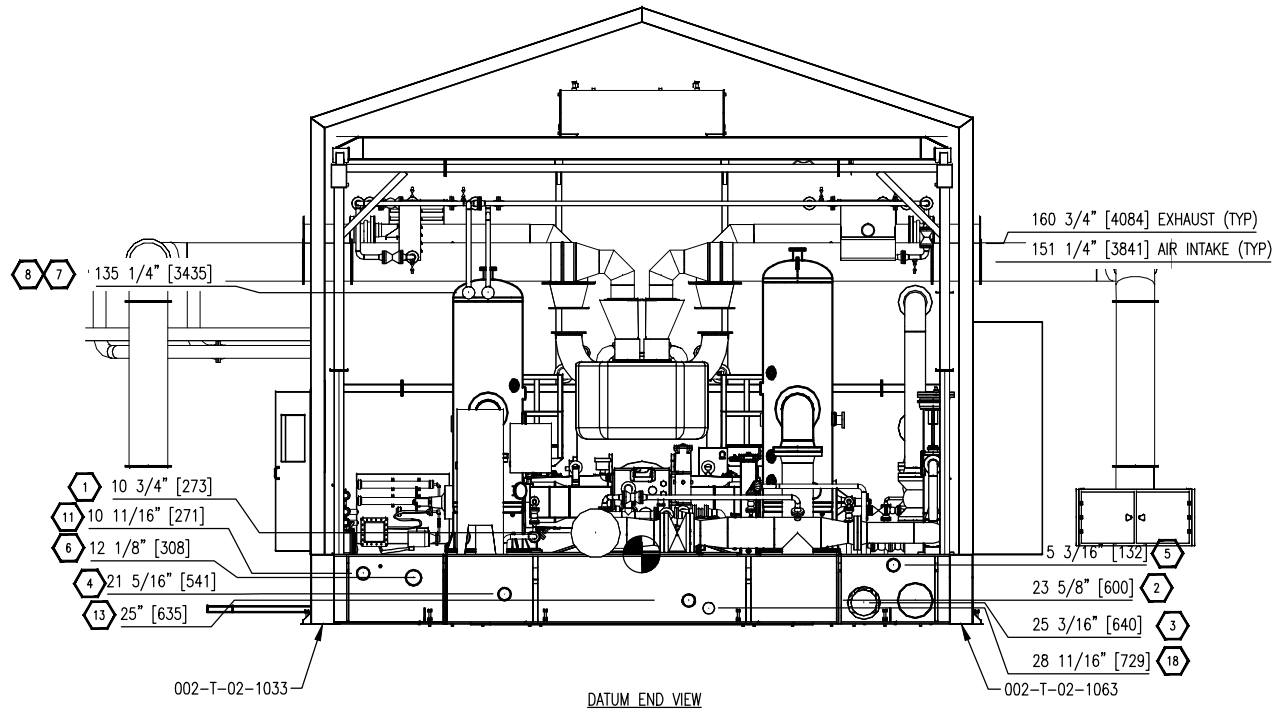

**FINAL  
AS BUILT**  
NAME G.MACLEAN DATE FEB 07/14

5	AS-BUILT, ADDED CABLE TRAY	FEB 07/14	GM	LD	DATE	FEB 04/13	SCALE	1/4"=1'-0"
4	AS-BUILT, CUST. REF. AS PER CUST. MARKUPS	JAN 21/14	GM	LD	DRAWN BY	G.MACLEAN	CHECKED BY	G.TIWANA
3	AS-BUILT, ADDED OFF-SKID CLAMP LOCATIONS	OCT 04/13	GM	LD	APPROVED BY	L.DIOQUINO	PROJECT ENGINEER	L.DIOQUINO
2	AS-BUILT	SEP 03/13	GM	LD	PROJECT MANAGER	B.MINSHULL	CUST PO	N/A
1	RELOCATED NOZ 9/10/11, AIR INTAKE, REM NOZ 19	JUN 14/13	GM	LD	APEGGA PERMIT No:	P8651	OPER. CODE	198/298/490/511/591
0	ISSUED FOR CONSTRUCTION	MAY 30/13	GM	LD	WORK ORDER	31980-02		
REV	DESCRIPTION	DATE	BY	APR				

DEVON CANADA  
PROJECT NAME: FERRIER CPF  
AREA: FERRIER  
LSD: 11-02-039-08-W5M  
WBS: 01-00348.01  
CAT G3616/ARIEL KBZ 6/2

**ENERFLEX**  
Calgary, Alberta,  
Canada

GENERAL ARRANGEMENT  
OVERALL PLAN & END VIEWS

DWG NO	31980-02-201	SHT	4	REV	5
--------	--------------	-----	---	-----	---