


P:\30000 Projects\31979-02 Devon Canada - Ferrier - C3606LE.dwg - C3606LE.dwg - Sales Gas V, Drafting\31979-02-MODEL (AS BUILT).dwg
PLOT DATE Feb 07, 2014, hsun

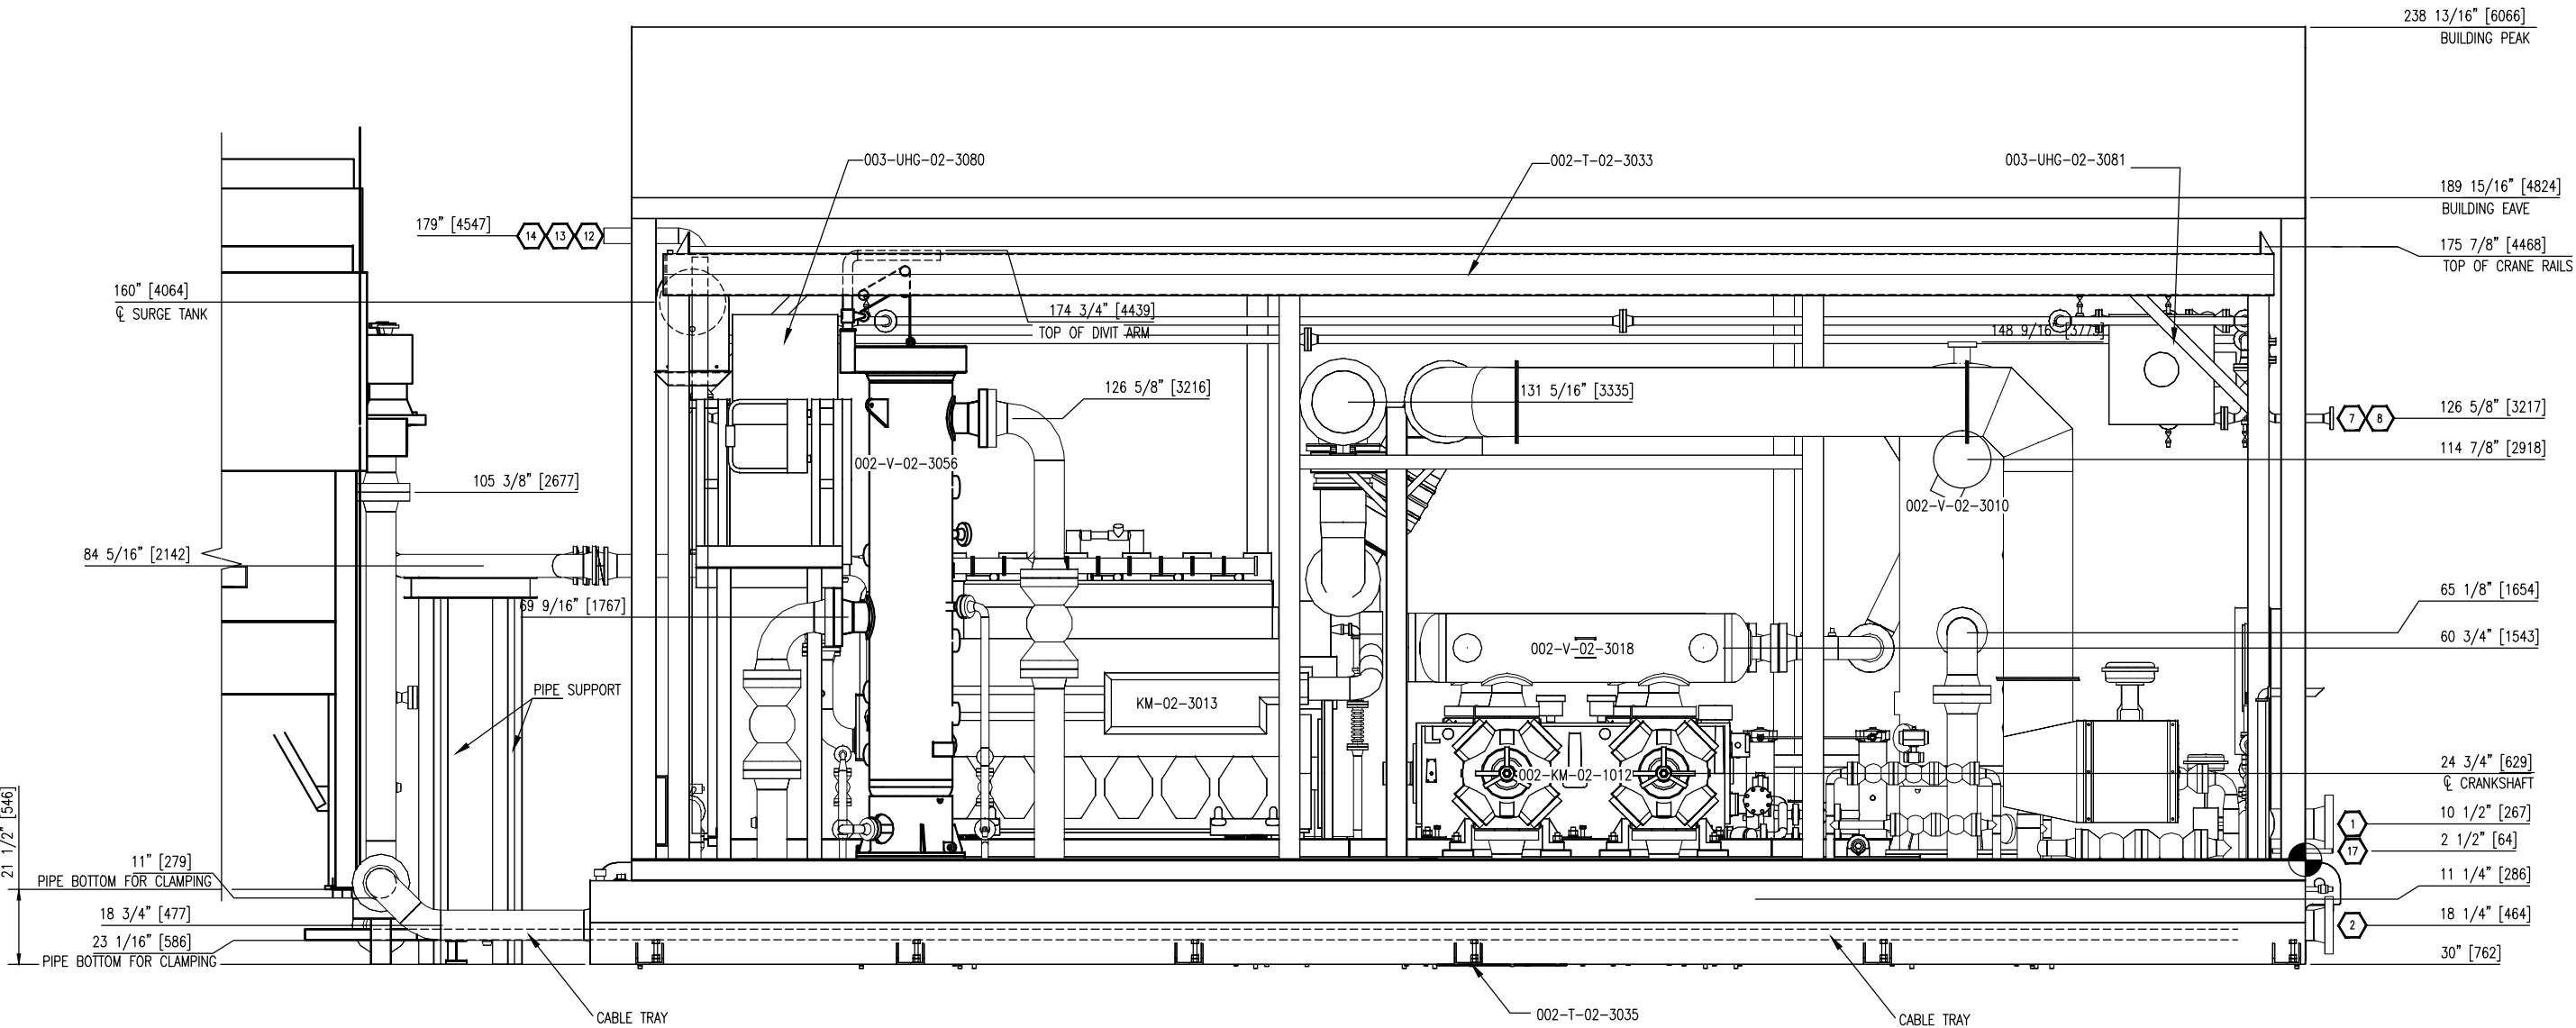

ELEVATION VIEW A-A

**FINAL
AS BUILT**
NAME H.SUN DATE FEB 06/14

NOTE:
ALL TAIL DIMENSIONS ARE
TAKEN FROM REFERENCE
POINT @ AT TOP OF SKID

						DATE	FEB 1/13		SCALE	1/2"=1'-0"		DEVON CANADA FERRIER CPF DEEP CUT FEED CATERPILLAR G3606LE ARIEL JGD/4-1 SWEET	ENERFLEX Calgary, Alberta, Canada	<u>GENERAL ARRANGEMENT</u> <u>SOUTH ELEV. VIEW</u>								
	4	REVISED & AS BUILT	FEB/06/14	HS	SG	DRAWN BY	C.EASTHOPE	CHECKED BY	G.TIWANA	APPROVED BY	S.GURI											
	3	AS BUILT	SEP/03/13	HS	SG	PROJECT MANAGER		PROJECT ENGINEER		S.GURI												
	2	REV'D WEIGHTS & NOZZLE SCHEDULE	MAY/23/13	CE	SG	B.MINSHULL		S.GURI														
	1	ADDED ONE MORE BUILDING HEATER	05/10/13	HS	SG	CUST PO		N/A														
	0	ISSUED FOR CONSTRUCTION	05/07/13	HS	SG																	
	REV	DESCRIPTION			DATE	BY	APR	APEGA PERMIT No: P8651		OPER. CODE	198/298/490/511/591		WORK ORDER	31979-02		DWG NO	31979-02-201		SHT	2	REV	4