


P:\30000 Projects\31979-02 Devon Canada - Ferrier - C3606LE JGD4- Sales Gas V. Drafting\31979-02-MODEL (AS BUILT).dwg
PLOT DATE: Feb 07, 2014, Hsun

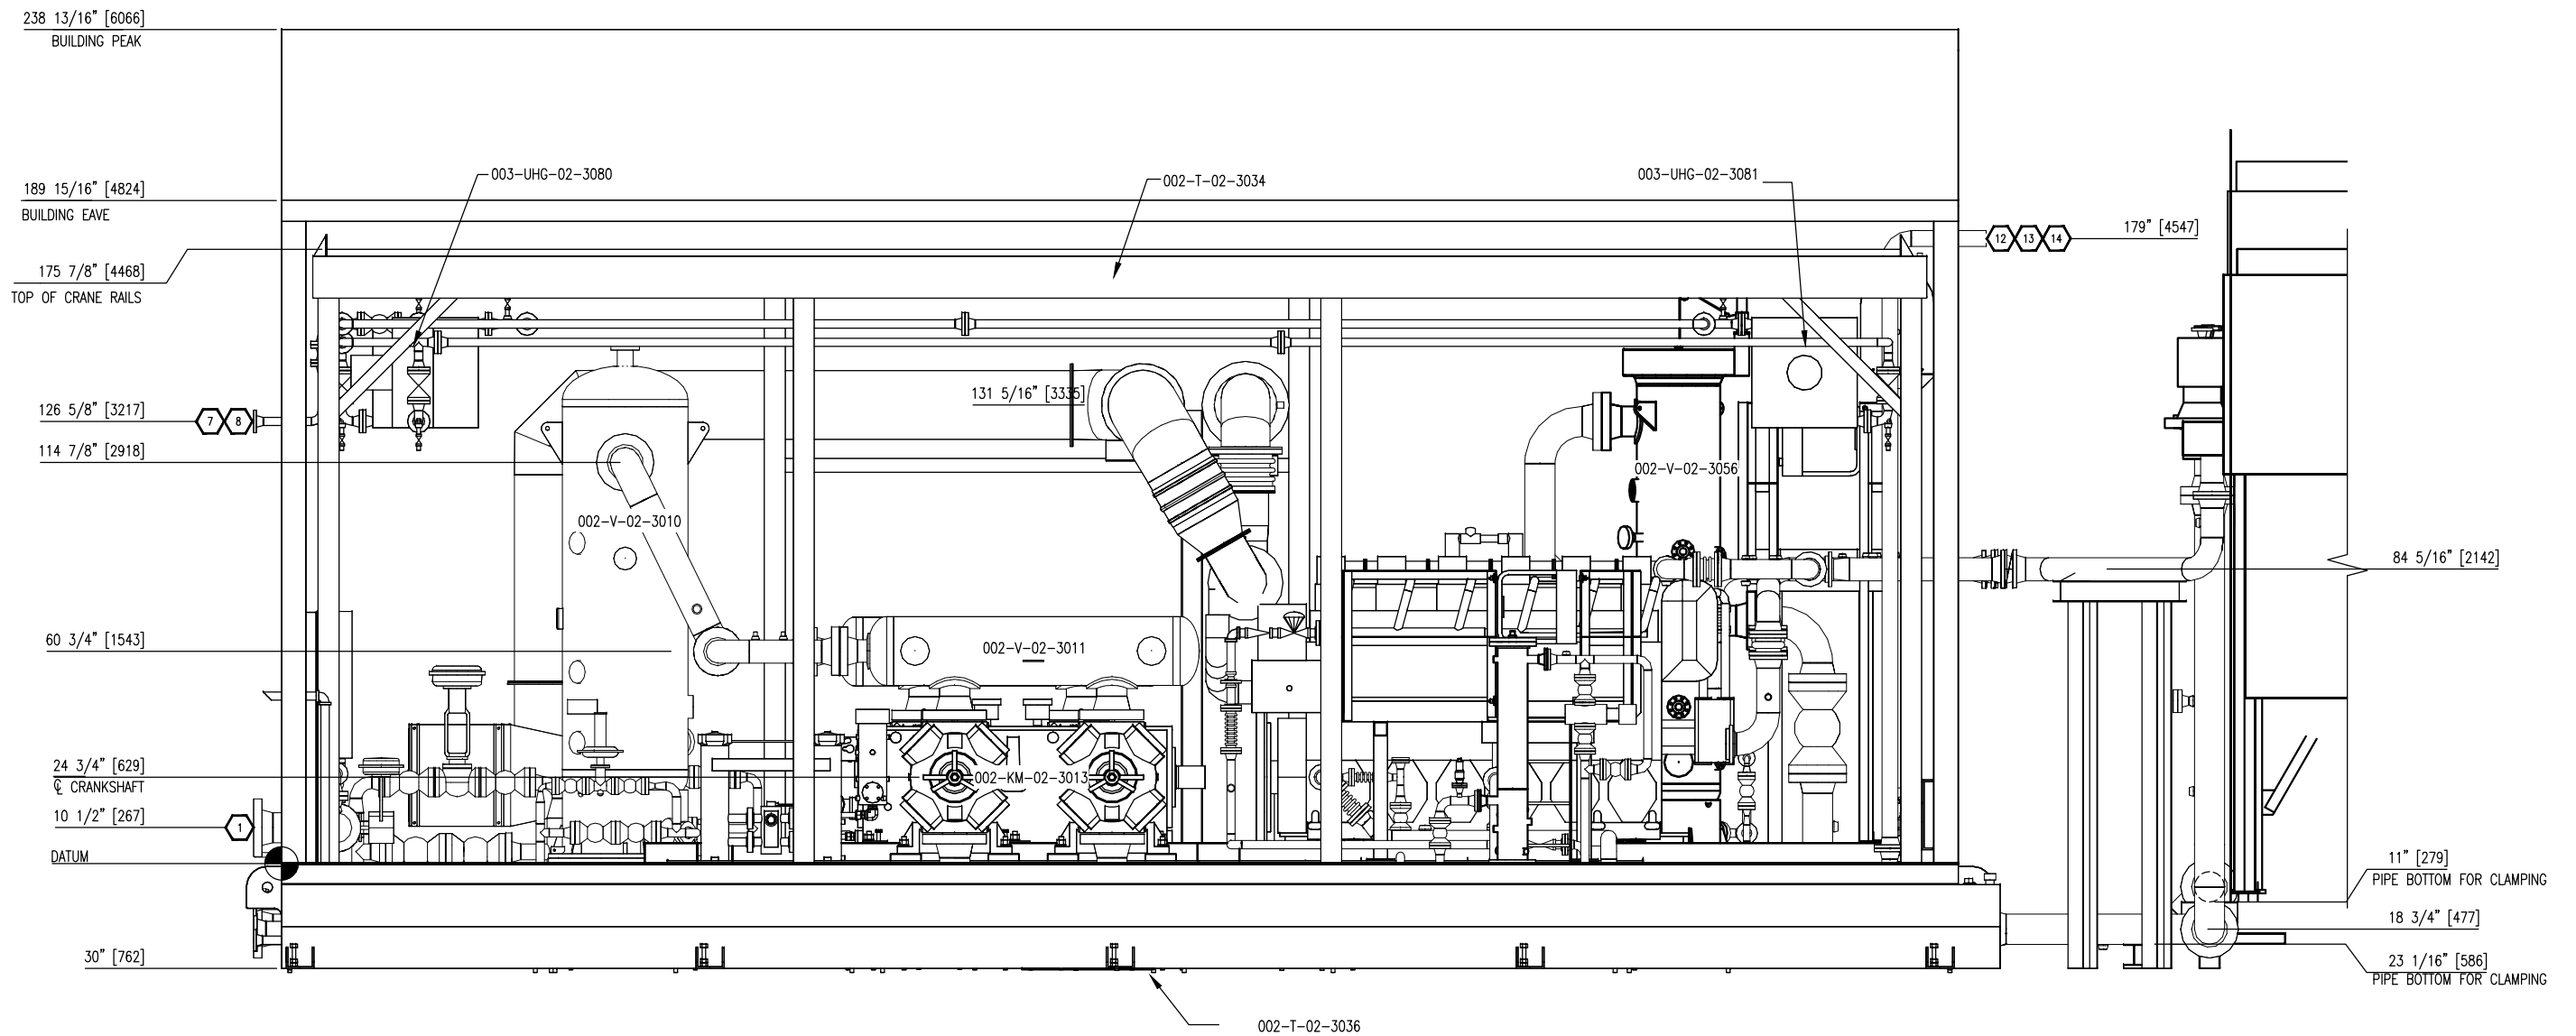

ELEVATION VIEW B-B

**FINAL
AS BUILT**
NAME: H.SUN DATE: FEB 06/14

NOTE:
ALL TAIL DIMENSIONS ARE
TAKEN FROM REFERENCE
POINT ⬤ AT TOP OF SKID

				DATE FEB 1/13		SCALE 1/2"=1'-0"		DEVON CANADA FERRIER CPF DEEP CUT FEED CATERPILLAR G3606LE ARIEL JGD/4-1 SWEET		ENERFLEX Calgary, Alberta, Canada		<u>GENERAL ARRANGEMENT</u> <u>NORTH ELEV. VIEW</u>		
4	REVISED & AS BUILT	FEB/06/14	HS	SG	DRAWN BY C.EASTHOPE	CHECKED BY G.TIWANA	APPROVED BY S.GURI							
3	AS BUILT	SEP/03/13	HS	SG	PROJECT MANAGER B.MINSHULL									PROJECT ENGINEER S.GURI
2	REV'D WEIGHTS & NOZZLE SCHEDULE	MAY/23/13	CE	SG	CUST PO N/A									
1	ADDED ONE MORE BUILDING HEATER	05/10/13	HS	SG										
0	ISSUED FOR CONSTRUCTION	05/07/13	HS	SG	APEGGA PERMIT No: P8651		OPER. CODE 198/298/490/511/591	WORK ORDER 31979-02	DWG No 31979-02-201	SHT 3	REV 4			
REV	DESCRIPTION			DATE	BY	APR								