

V-100
 3-PHASE INLET SEPARATOR
 VERTICAL 36" O.D. x 10'-0" S/S
 MAWP: 1440 PSIG @ 130°F
 CORROSION ALLOW: 1/16"

V-110
 FUEL GAS SCRUBBER
 8" O.D. x 2'-0" S/S
 MAWP: 350 PSIG @ 130°F
 CORROSION ALLOW: 1/8"
 C/W HLSD-110

REGISTERED PROFESSIONAL ENGINEER STAMP:


REV	DESCRIPTION	DRAWN BY	CHK'D BY	APPR'D BY	DATE
2	AS BUILT	KT			02.02.21
1	UPDATED AS NOTED	KT			12.07.20
0	ISSUED FOR CONSTRUCTION	KT			08.13.20
A	ISSUED FOR APPROVAL	JWC			07.07.20
REV	DESCRIPTION	DRAWN BY	CHK'D BY	APPR'D BY	DATE
	REVISION				




TOLERANCES:
 ARGO
 GOOD INDUSTRY PRACTICE

DO NOT SCALE DRAWING

CLIENT:			
DESCRIPTION: 36" O.D. x 10'-0" S/S x 1440 PSI SEPARATOR PACKAGE			
DRAWING TITLE: P&ID			
QUOTE NO: Q20200283	TAG NO: -	LOCATION: -	
P.O. NO: -	WORK ORDER: W202536	DWG NO: 202536-001	REV. 2

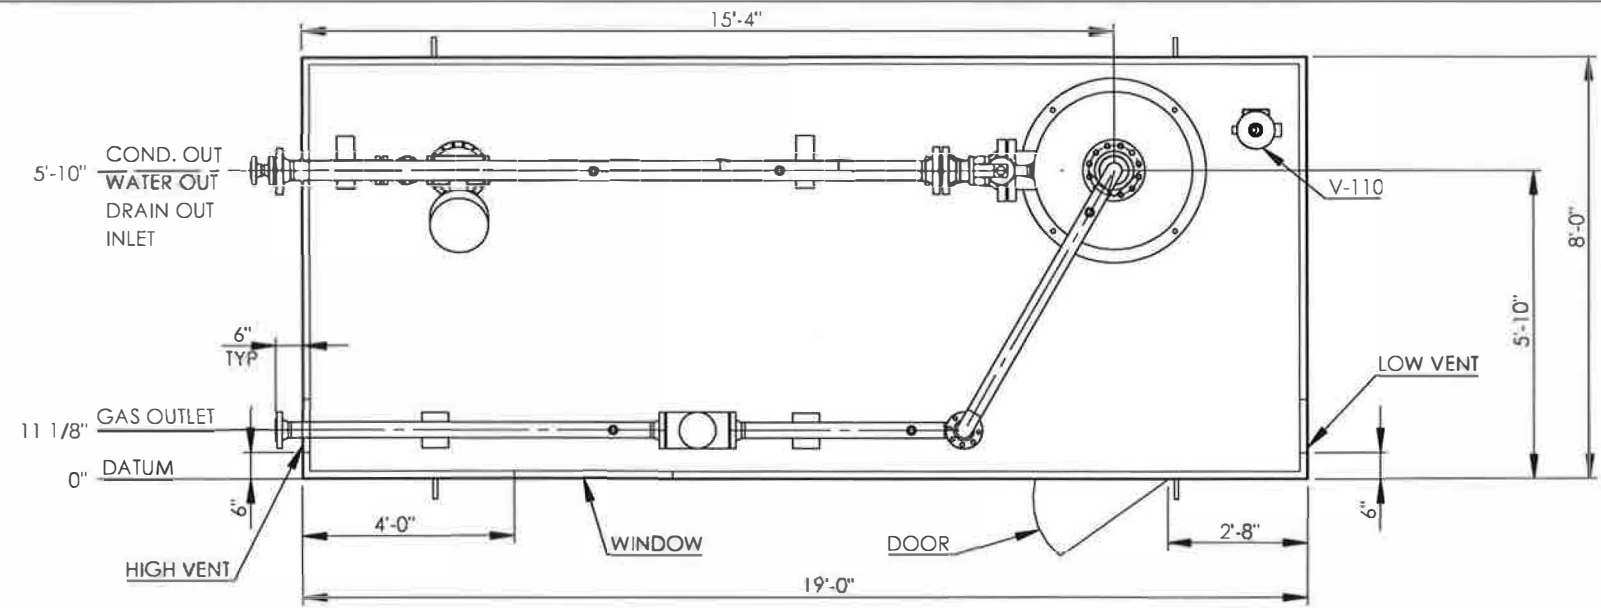


TOP VIEW

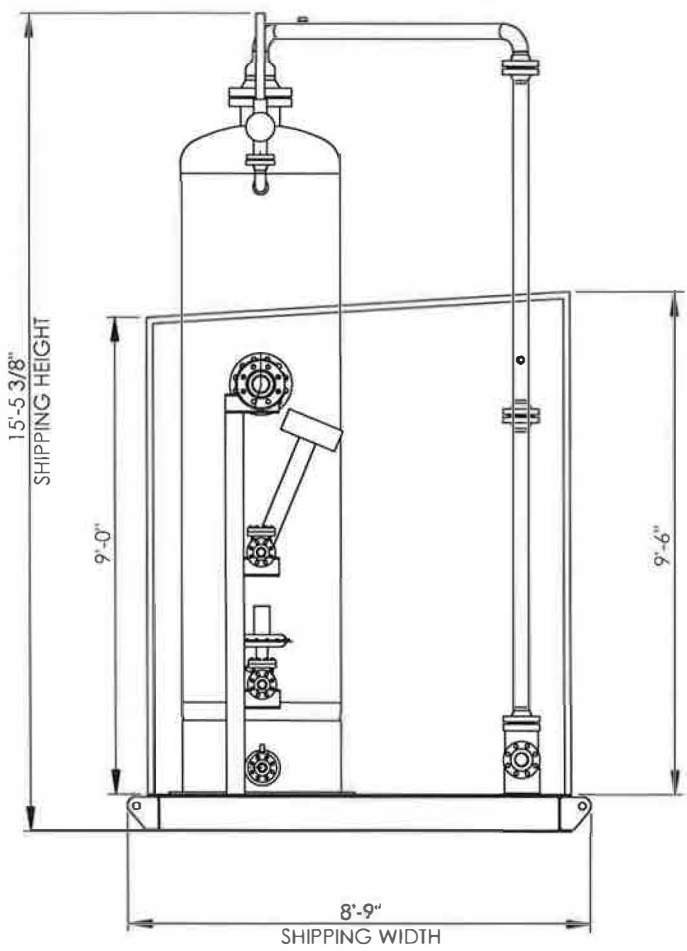

SIDE VIEW

SHIPPING WEIGHT: 19,000 LB

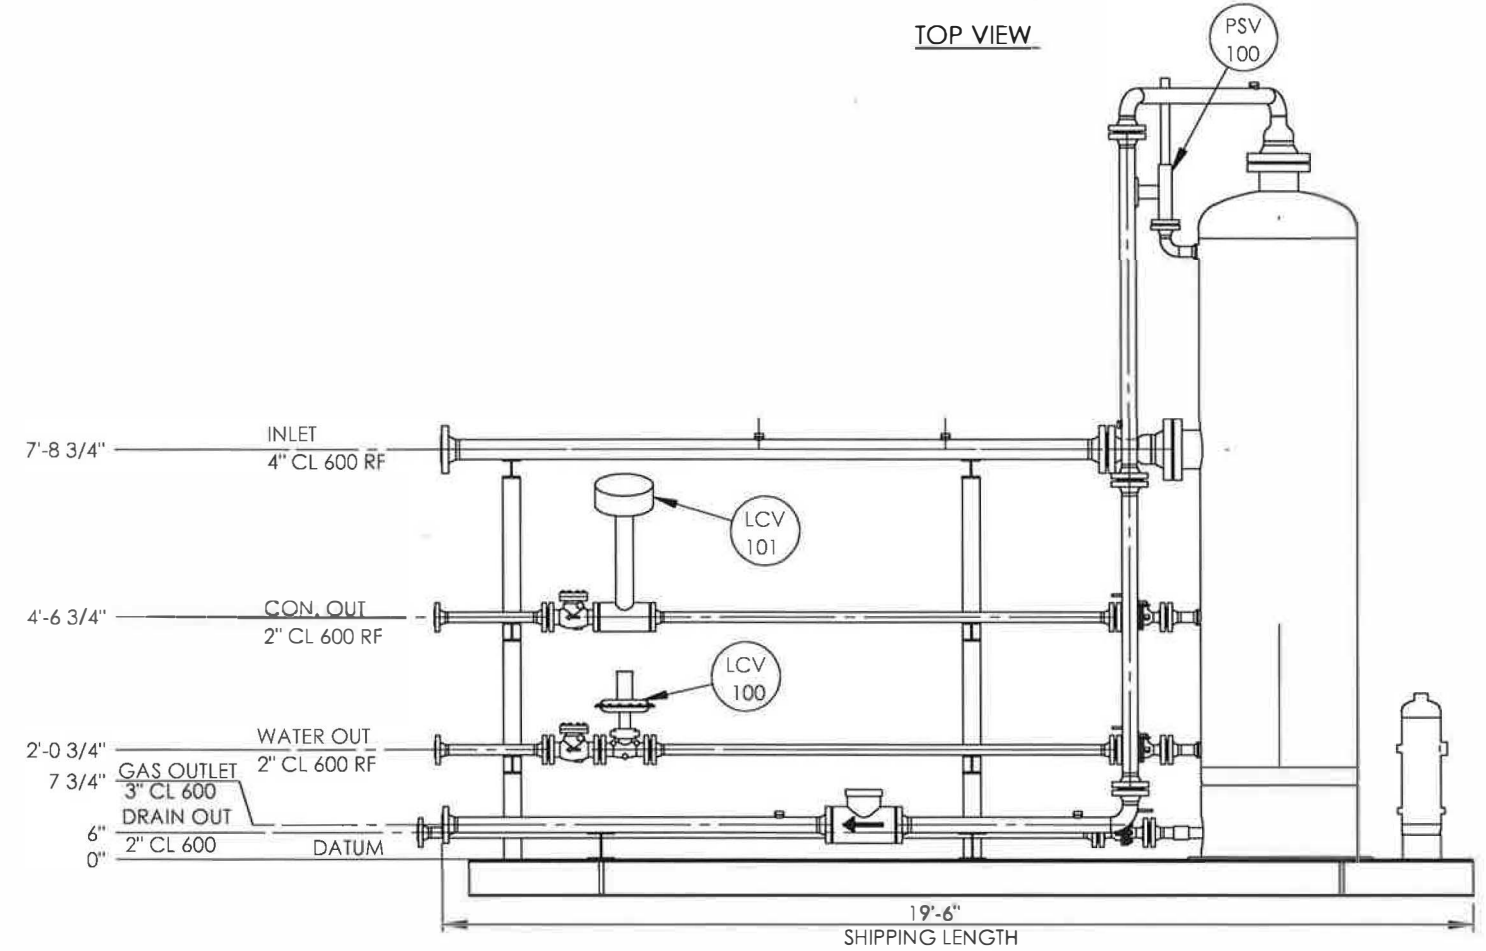

FRONT VIEW


REGISTERED PROFESSIONAL ENGINEER STAMP:

REV	DESCRIPTION	DRAWN BY	CHK'D BY	APPR'D BY	DATE
2	AS BUILT				02.02.21
1	UPDATED LOCATIONS TO LINE UP WITH NEW VESSEL				11.12.20
0	ISSUED FOR CONSTRUCTION				08.13.20




TOLERANCES:
ARGO
GOOD INDUSTRY PRACTICE
DO NOT SCALE DRAWING

CLIENT:			
DESCRIPTION: 36" SEPARATOR PACKAGE			
DRAWING TITLE: GENERAL ARRANGEMENT			
QUOTE NO: Q20200283	TAG NO:	LOCATION:	
P.O. NO:	WORK ORDER: W202536	DWG NO: 202536-101	REV. 2

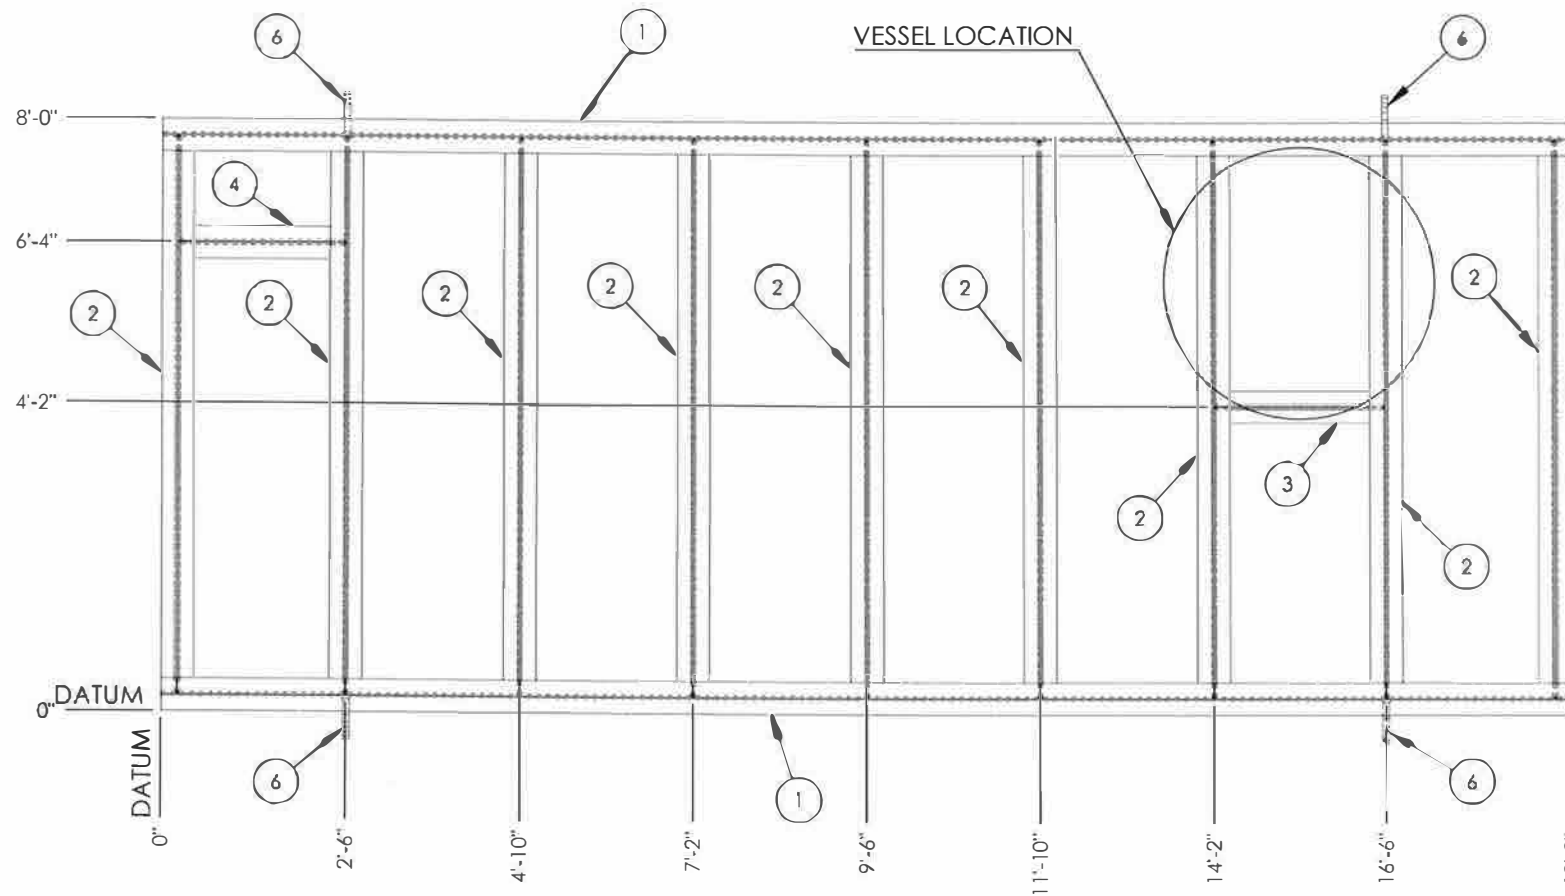

TOP VIEW

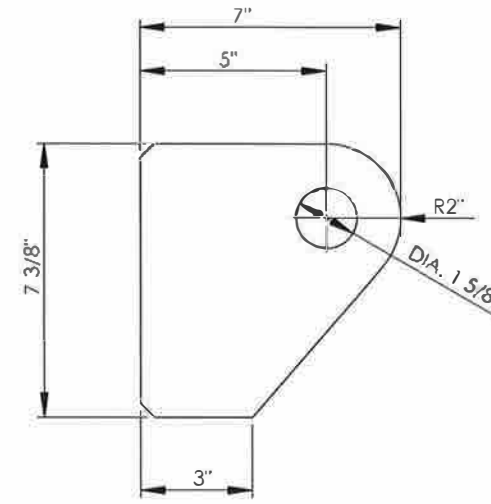

ITEM #6 DETAIL

ITEM NO.	QTY.	DESCRIPTION	LENGTH
1	2	W8x18, 350/50W	19'-0"
2	9	W8x18, 350/50W	7'-6 1/2"
3	1	W8x18, 350/50W	2'-3 3/4"
4	1	W8x18, 350/50W	2'-3 1/8"
5	1	CHECKER PLATE 1/4" THK. x 8'-0", 44W	19'-0"
6	4	PLATE 1" THK x 7" LG, SA-516-70N	7 3/8"

GENERAL NOTES:


1. ALL DIMENSIONS SHOWN IN INCHES.
2. ALL WELDING TO BE DONE TO THE LATEST REVISION OF CWB WPDS
3. CWB SHOP SUPERVISORS TO SPECIFY WELDING PROCESS
4. SEE ARGO INTERNAL DRAWING ASL-SKID-FAB SKID WELDING FOR FURTHER WELDING AND COPING DTAILS
5. ALL SHARP EDGES TO BE REMOVED AND GROUND SMOOTH
6. LENGTHS INDICATED ARE FACE TO FACE, NO ALLOWANCE INCLUDED FOR WELD GAPS
7. FULLY WELD FLOOR PLATE TO BEAM UNDER PIPE SUPPORTS & VESSEL
8. UNDERSIDE OF FLOOR PLATE TO BE FULLY WELDED AT CORNERS AND STITCH WELDED 2" EVERY 24" ELSEWHERE, PERIMETER TO BE STITCH WELDED 2" EVERY 12"
9. 100% MPI ON LIFT LUGS

TESTING NOTES:


1. 100% VISUAL INSPECTION
2. 100% MPI ON LIFT LUGS

FINISHING NOTES:

1. SSPC-SP3 MECHANICAL CLEAN
2. ONE (1) COAT SHOP PRIMER
3. ONE (1) COAT WARM GREY

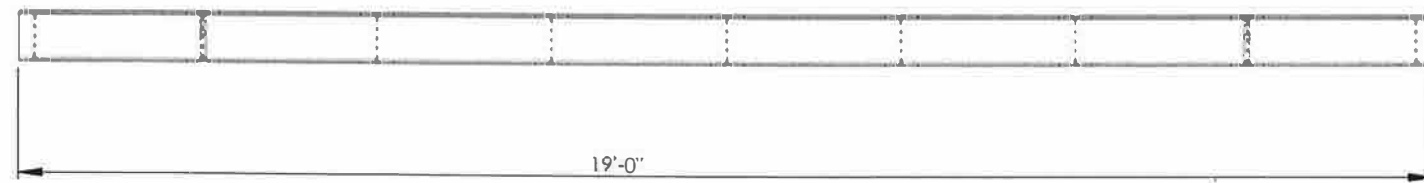

FRONT VIEW

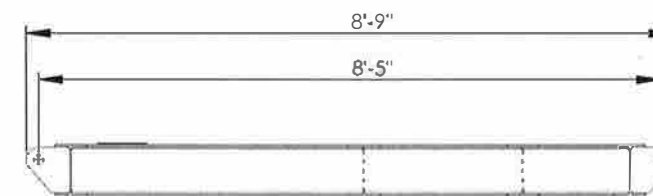

SIDE VIEW

REGISTERED PROFESSIONAL ENGINEER STAMP:

REV	DESCRIPTION	DRAWN BY	CHEK'D BY	APPR'D BY	DATE
1	AS BUILT	KT			02.02.21
0	ISSUED FOR CONSTRUCTION	KT			08.13.20

ARGO SALES LP

CLIENT:		
DESCRIPTION: 36" SEPARATOR PACKAGE		
DRAWING TITLE: SKID DETAILS		
QUOTE NO: Q20200283	TAG NO:	LOCATION:
P.O. NO:	WORK ORDER: W202536	DWG NO: 202536-300
		REV. 1

TOLERANCES:
ARGO
GOOD INDUSTRY PRACTICE

DO NOT SCALE DRAWING