

001-E-02-1125
COMPRESSOR OIL COOLER #2

MFG: GEA
MODEL: FPA 10X20-130/9156-UM
PLATE MATERIAL: 316 STAINLESS STEEL
MAWP: 2758 KPA@ (400 PSIG)
MWT: 177°C (350°F)
LOAD: 1.124096 BTU/HR
CONNECTIONS: 60mm (2")-300 IN/OUT
WEIGHT: 70.7 KG (156 LBS)

001-E-02-1121
COMPRESSOR OIL COOLER #1

MFG: GEA
MODEL: FPA 10X20-130/9156-UM
PLATE MATERIAL: 316 STAINLESS STEEL
MAWP: 2758 KPA@ (400 PSIG)
MWT: 177°C (350°F)
LOAD: 1.124096 BTU/HR
CONNECTIONS: 60mm (2")-300 IN/OUT
WEIGHT: 70.7 KG (156 LBS)

001-V-02-1123
SEAL POT


MFG: EFX
MODEL: API-PLAN 52
SIZE: 219mm(8 5/8") OD X 958mm(38") OAL
MAWP: 1723 KPA@ 93°C
SHELL MTL: 316 SS
HEAD MTL: 316 SS
S/N: 12618024259
CRN: V9745.2

001-FL-02-1124
LUBE OIL FILTER

MFG: EFX
SIZE: 219mm(8 5/8") OD X 660mm(26") S/F
MAWP: 3103 KPA@ 121°C
MWT: -29°C @ 3103 KPA@
CA: 1.6mm(1/16")
ELEMENT: (1) MODEL 1833C10 10 MICRON
MTR'L: CARBON STEEL
S/N: 1261802424
CRN: T4404.213

001-FL-02-1146
LUBE OIL FILTER

MFG: EFX
SIZE: 219mm(8 5/8") OD X 660mm(26") S/F
MAWP: 3103 KPA@ 121°C
MWT: -29°C @ 3103 KPA@
CA: 1.6mm(1/16")
ELEMENT: (1) MODEL 1833C10 10 MICRON
MTR'L: CARBON STEEL
S/N: 1261802424
CRN: T4404.213

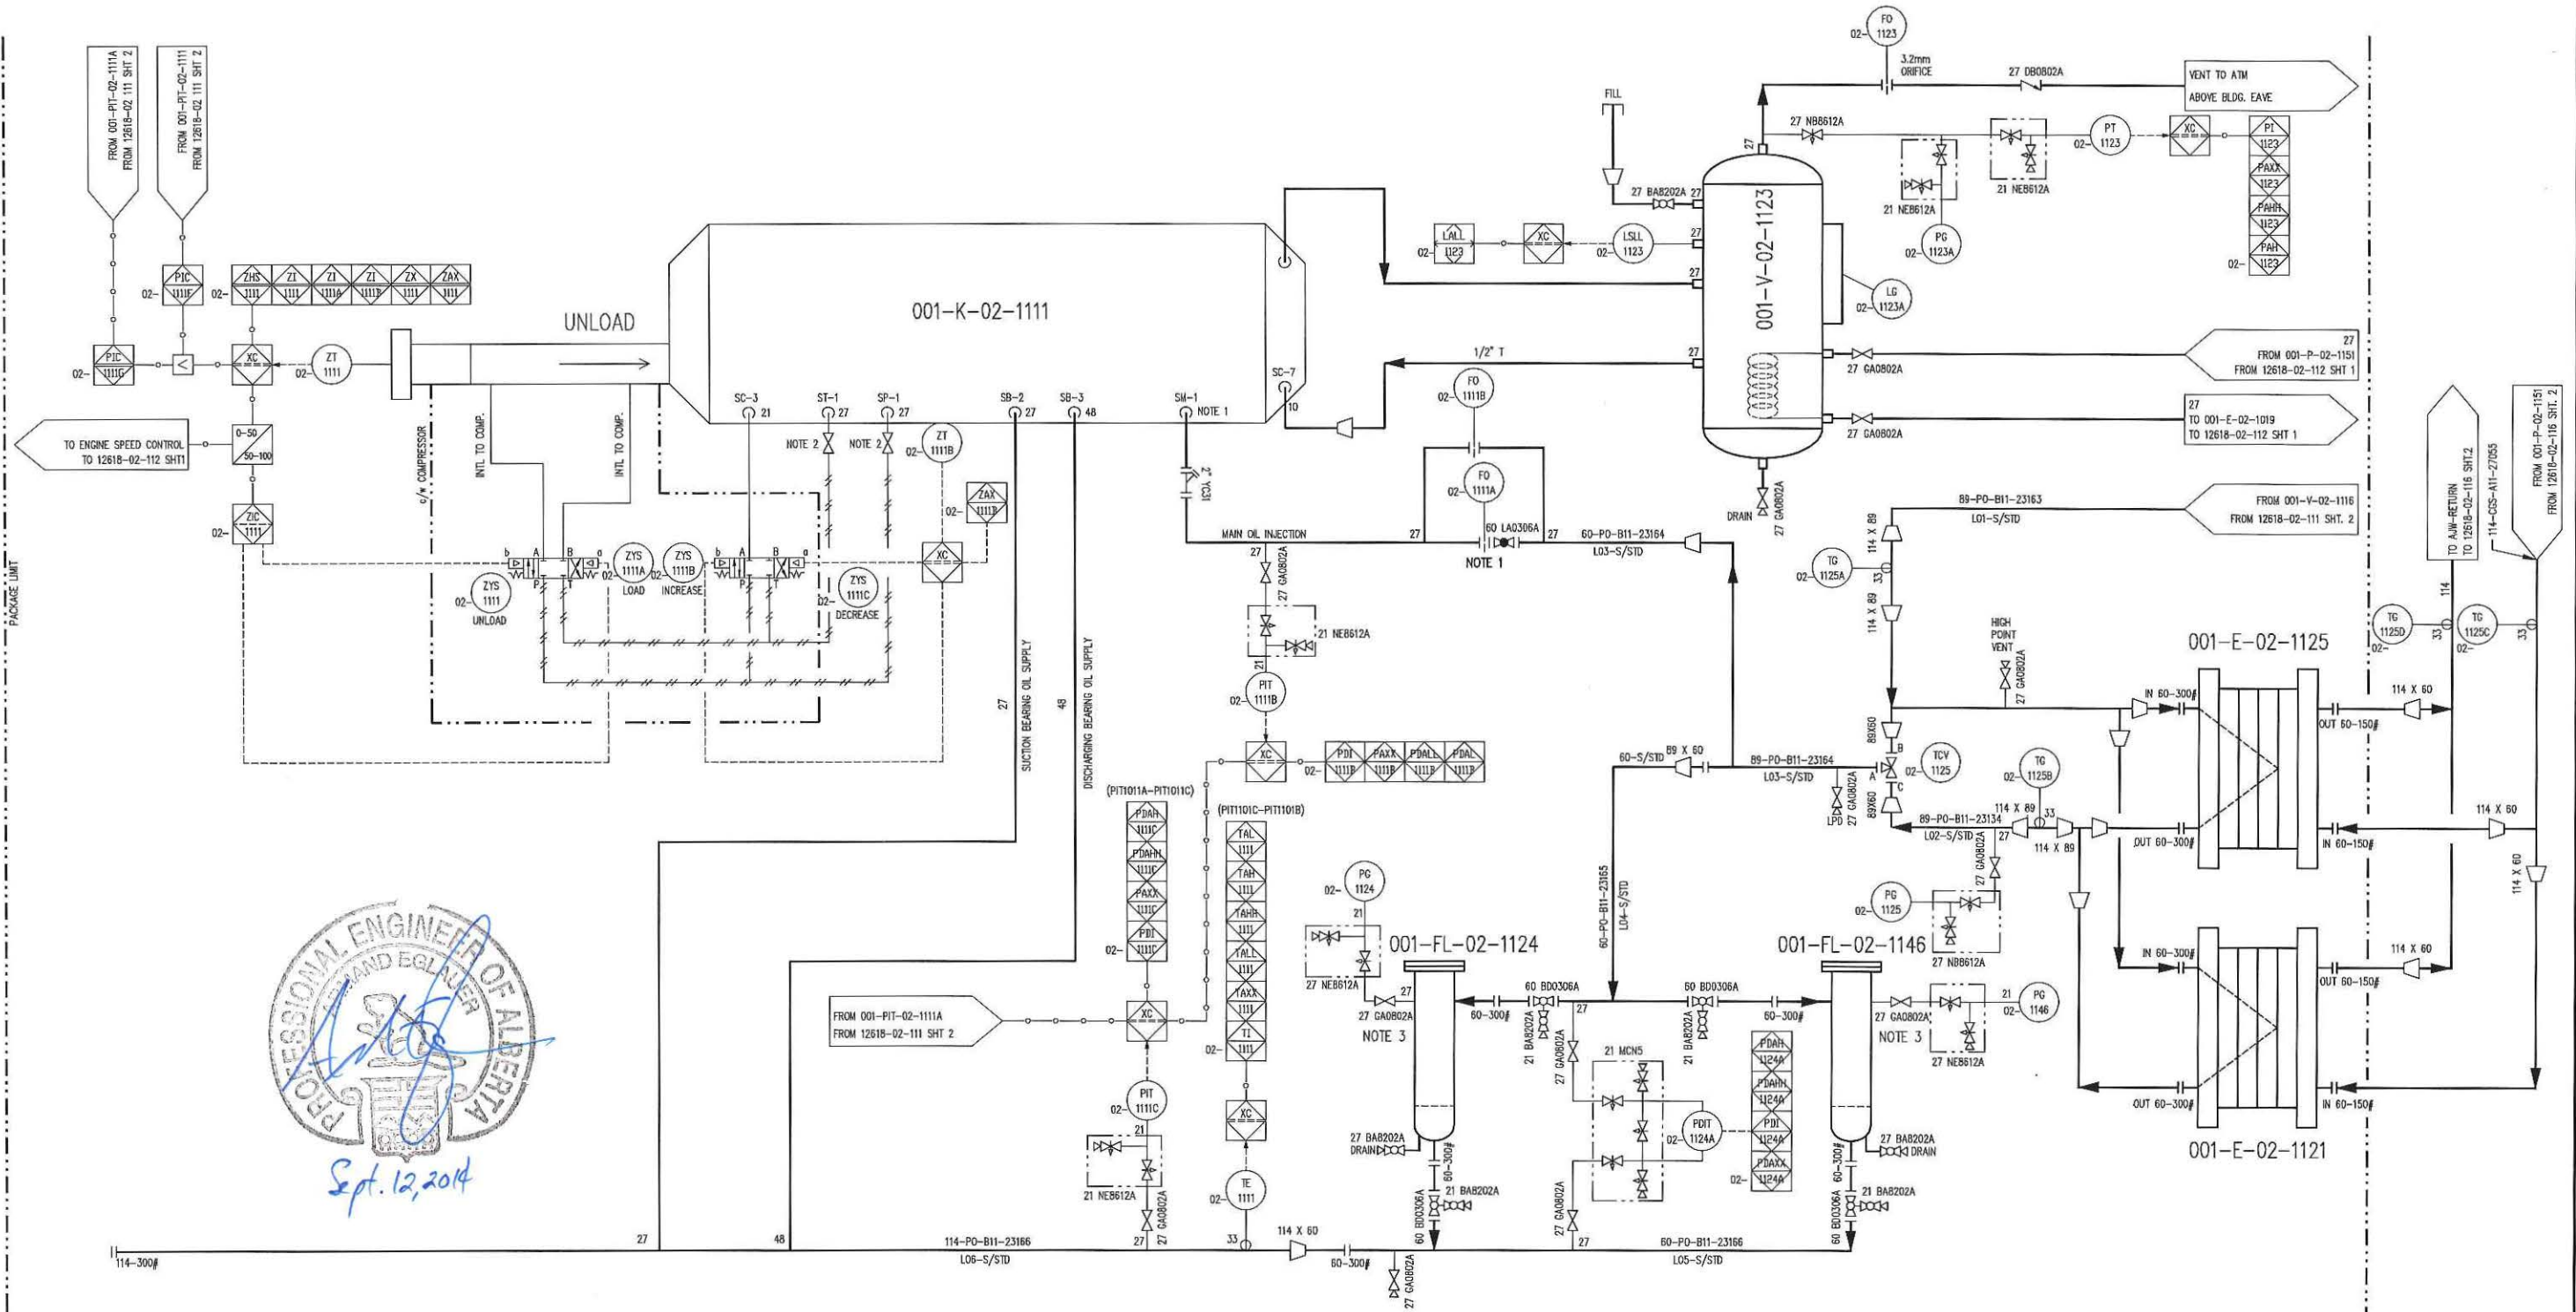

- NOTES:
- ORIFICE SUPPLIED WITH COMPRESSOR.
 - VALVES SUPPLIED WITH COMPRESSOR.
 - LOCATE AS HIGH AS POSSIBLE.

ISSUED FOR REGISTRATION
NAME T. WELSH DATE SEP 12/14

5	ISSUED FOR REGISTRATION	SEP 12/14	TW	ATE	DATE	DEC 10/12	SCALE	NTS
4	FINAL AS BUILT	JAN 02/14	CS	SG	DRAWN BY	A. HAMMOND	CHECKED BY	S. GURI
3	FINAL AS BUILT	NOV 21/13	AR	SG	PROJECT MANAGER	B. MINSHULL	PROJECT ENGINEER	S. GURI
2	REV. LINE NUMBERS & LINE SIZE	SEP 27/13	GP	SG	CUST PO	4100000964		
1	ISSUED FOR CONSTRUCTION	JUN 21/13	CS	SG	APEGA PERMIT No:	P8651	OPER. CODE	
0	ISSUED FOR CONSTRUCTION	APR 09/13	AH	SG	WORK ORDER	12618-02		

DEVON CANADA FERRIER CPF
BATTERY SCREW
CATERPILLAR G3606LE
FRICK SGCB-3524

ENERFLEX
Calgary, Alberta,
Canada

P & I DIAGRAM
COMPR. LUBE OIL & UTILITIES

DWG NO 12618-02-113 SHT 1 REV 5

PLOT 12 Sep 2014 12:44pm gprali