


PLOT TO Sep. 2020--8:35am. MEDowns THE INFORMATION CONTAINED HEREIN IS THE CONFIDENTIAL PROPERTY OF ENERFLEX ENERGY SYSTEMS, AND IS NOT FOR PUBLICATION, AND NO PART THEREOF SHALL BE COPIED OR COMMUNICATED TO A THIRD PARTY WITHOUT AUTHORIZATION FROM ENERFLEX ENERGY SYSTEMS.

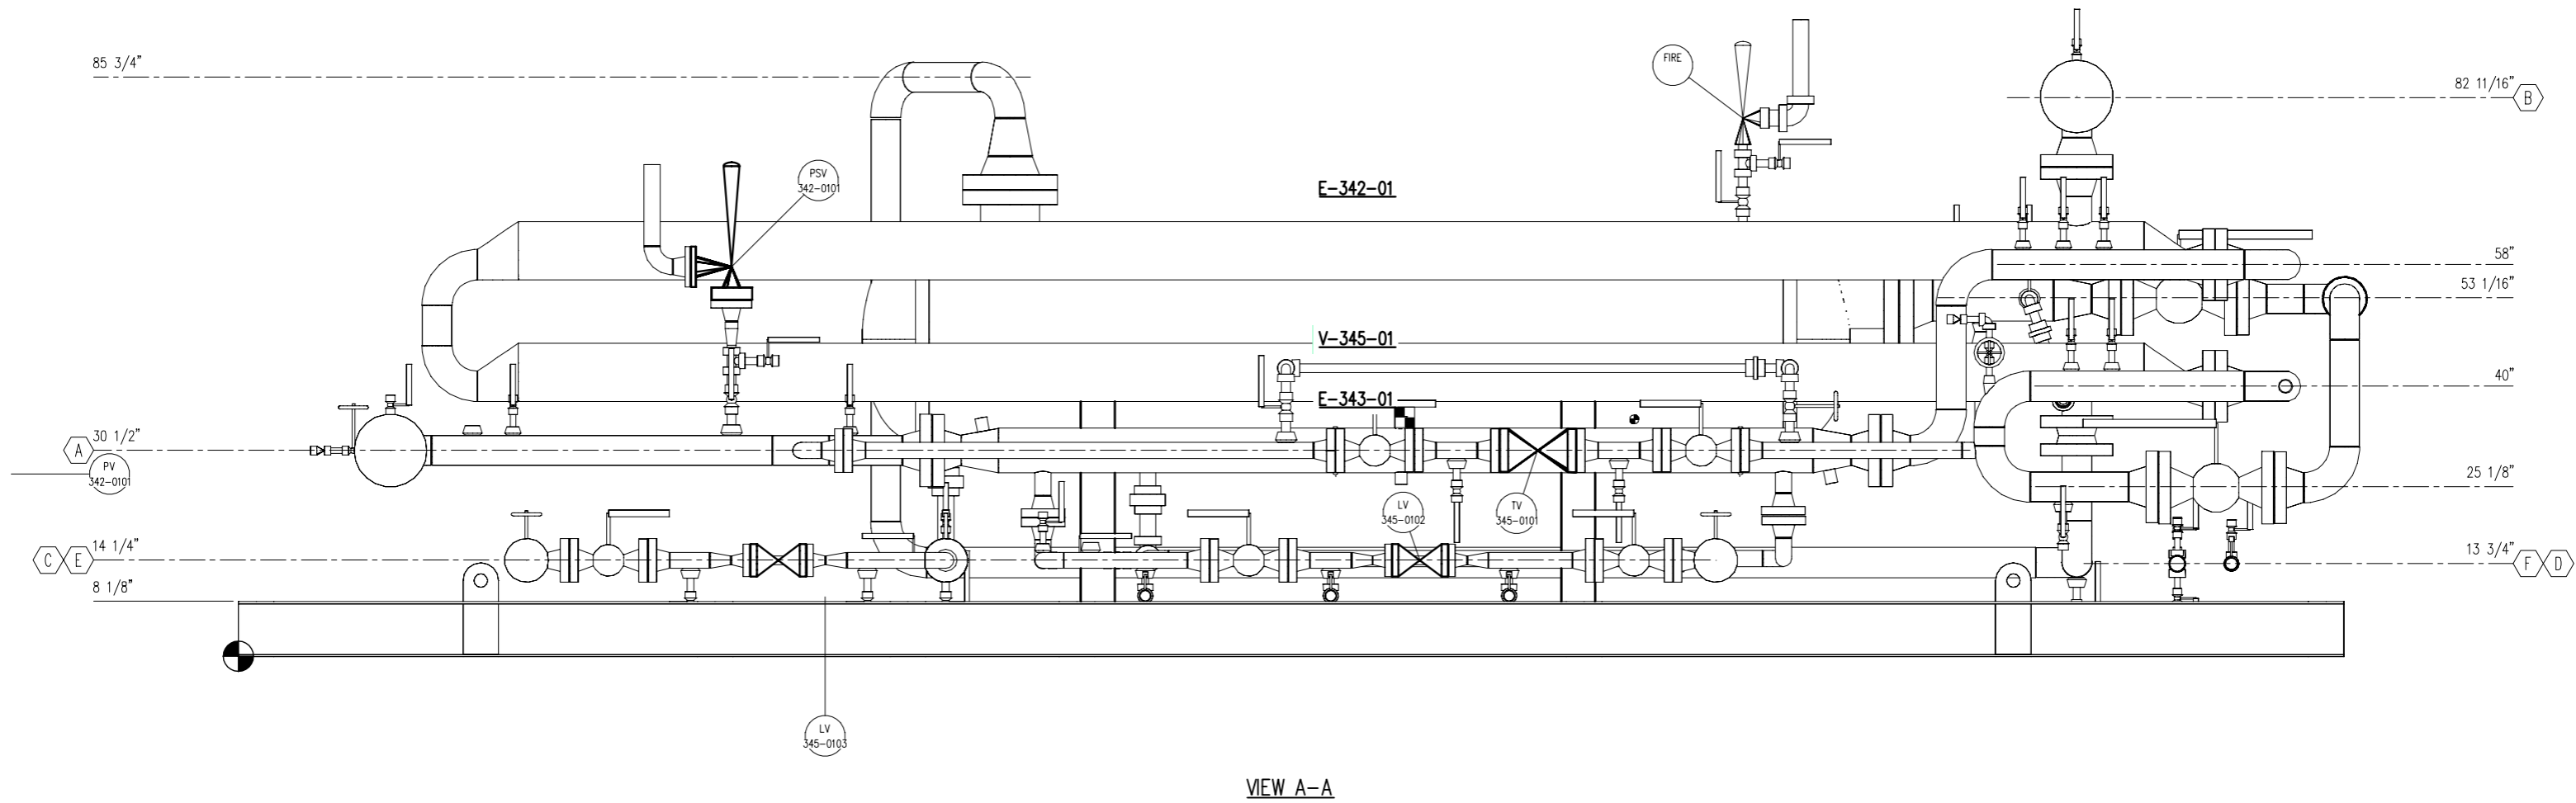

VIEW A-A

FINAL
AS BUILT

NAME _____ DATE _____


PROJECTS			
TOTAL PACKAGES REQ'D =			

NOTES:
1. SEE SHT 1 FOR GENERAL NOTES AND CUSTOMER CONNECTION SCHEDULE.

4	AS-BUILT	9-1-20	MED	RG	DATE 11/19/19	SCALE 1/2"=1'-0"
3	ELEV. ERROR OF HT. EXCHANGER	04/24/20	FN	JH	DRAWN BY FN	CHECKED BY JH
2	REV'D SKID BEAM HEIGHT TO MATCH EXISTING SKID	02/25/20	FN	JH	PROJECT MANAGER PROJECT ENGINEER	
1	REVISE OVERALL DIMENSIONS PER SKID CHANGES	02/04/20	FN	JH	CUST PO	
0	ISSUED FOR CONSTRUCTION	01/20/20	FN	JH		
REV	DESCRIPTION	DATE	BY	APR	STEP CODE	WORK ORDER

<p style="font-weight: bold; margin: 0;">ENERFLEX</p> <p style="margin: 0;">Houston, Texas, USA</p>	<p>PACKAGE LAYOUT JT10 SKID VIEW "A-A"</p>
<p>DWG NO E003319-01-201</p>	<p>SHT 2 of 5 REV 4</p>

PLOT TO Sep. 2020--8:35am. MEDowns THE INFORMATION CONTAINED HEREIN IS THE CONFIDENTIAL PROPERTY OF ENERFLEX ENERGY SYSTEMS, AND IS NOT FOR PUBLICATION, AND NO PART THEREOF SHALL BE COPIED OR COMMUNICATED TO A THIRD PARTY WITHOUT AUTHORIZATION FROM ENERFLEX ENERGY SYSTEMS.

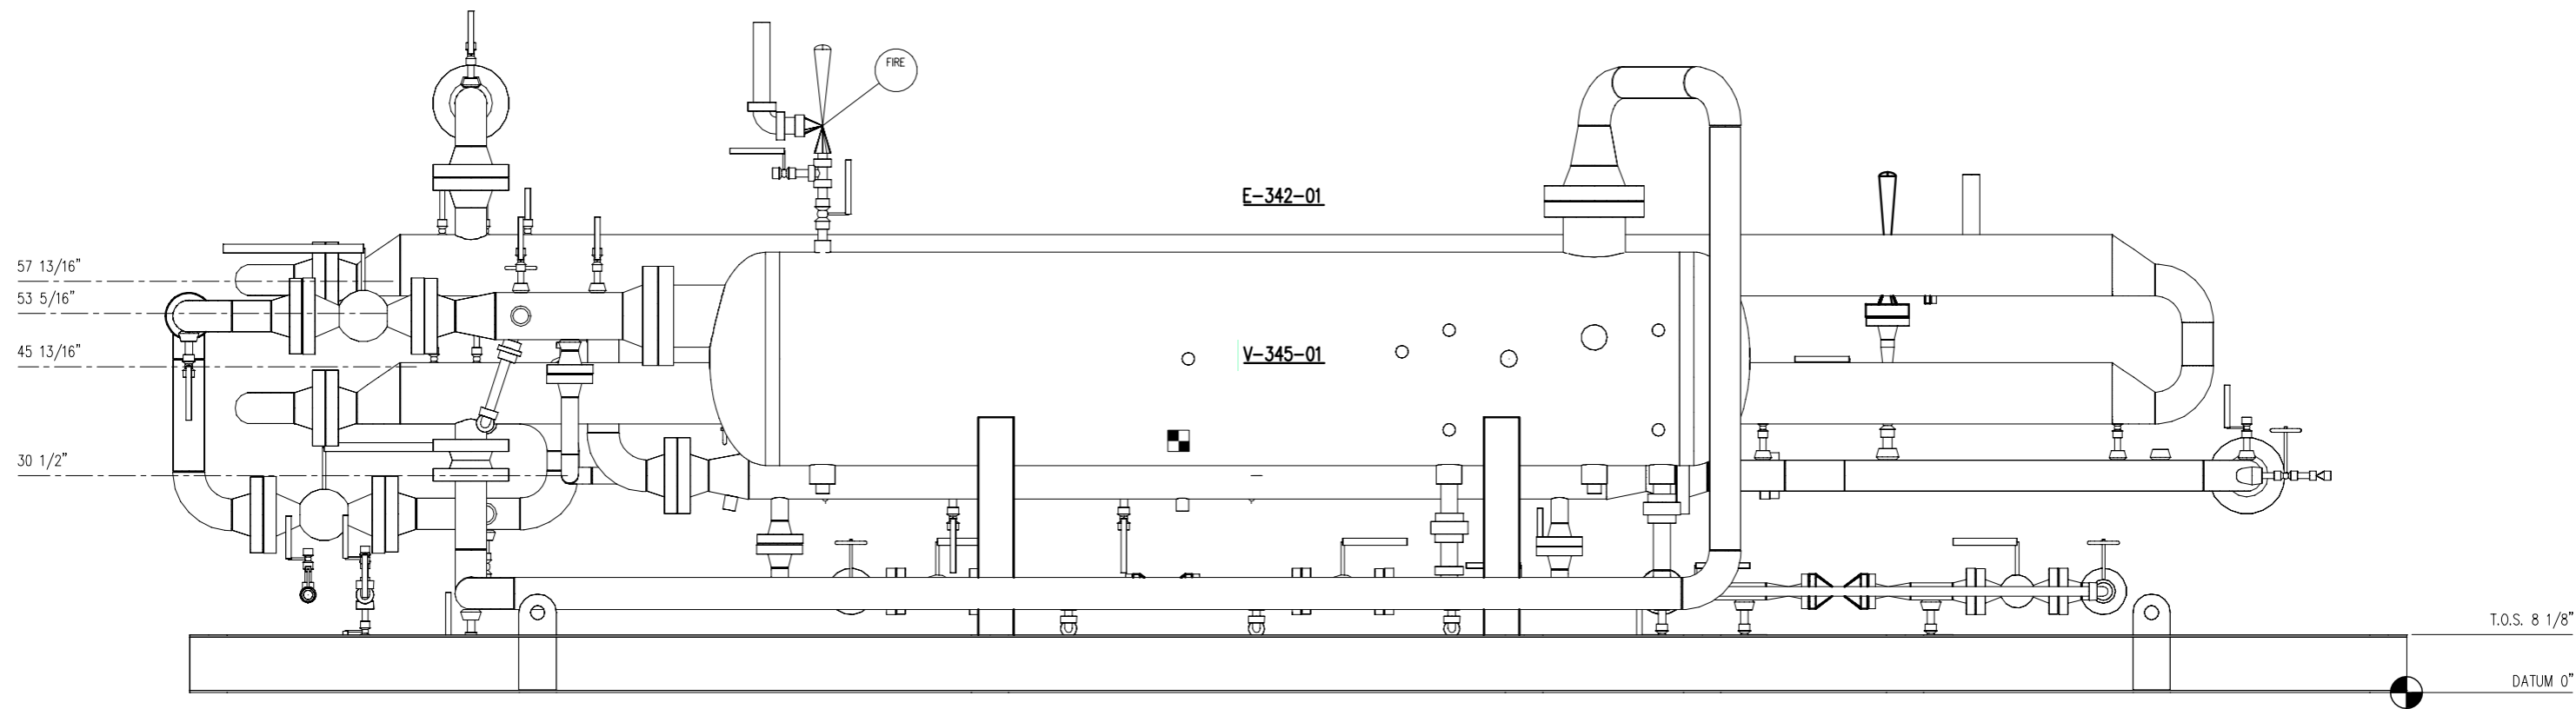

VIEW B-B

**FINAL
AS BUILT**
 NAME _____ DATE _____

PROJECTS			
TOTAL PACKAGES REQD =			

NOTES:
 1. SEE SHT 1 FOR GENERAL NOTES AND CUSTOMER CONNECTION SCHEDULE.

REV	DESCRIPTION	DATE	BY	APR
4	AS-BUILT	9-1-20	MED	RG
3	ELEV. ERROR OF HT. EXCHANGER	04/24/20	FN	JH
2	REV'D SKID BEAM HEIGHT TO MATCH EXISTING SKID	02/25/20	FN	JH
1	REVISE OVERALL DIMENSIONS PER SKID CHANGES	02/04/20	FN	JH
0	ISSUED FOR CONSTRUCTION	01/20/20	FN	JH


DATE	11/19/19	SCALE	1/2"=1'-0"
DRAWN BY	FN	CHECKED BY	JH
APPROVED BY			
PROJECT MANAGER	PROJECT ENGINEER		
CUST PO			

STEP CODE	WORK ORDER
-----------	------------


ENERFLEX
 Houston, Texas,
 USA

PACKAGE LAYOUT
 JT10 SKID
 VIEW "B-B"

PLOT TO Sep. 2020--8:35am. MEDowns THE INFORMATION CONTAINED HEREIN IS THE CONFIDENTIAL PROPERTY OF ENERFLEX ENERGY SYSTEMS, AND IS NOT FOR PUBLICATION, AND NO PART THEREOF SHALL BE COPIED OR COMMUNICATED TO A THIRD PARTY WITHOUT AUTHORIZATION FROM ENERFLEX ENERGY SYSTEMS.

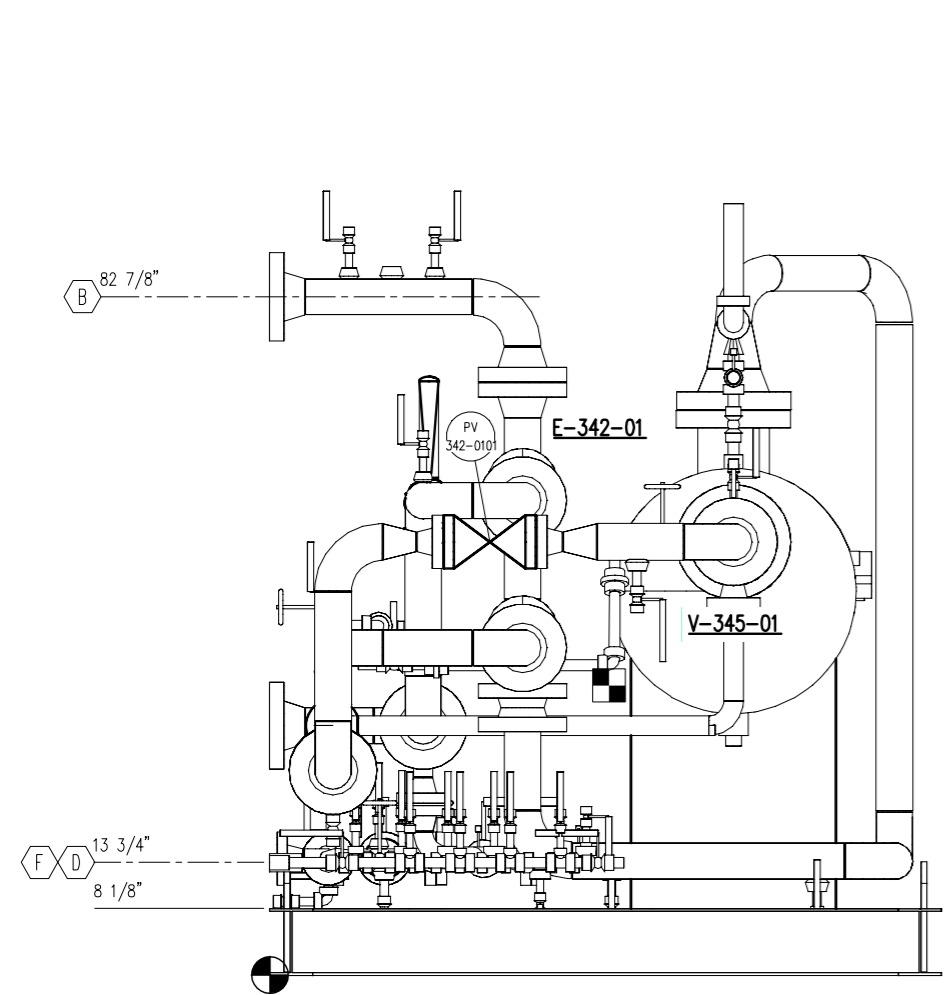

VIEW D-D

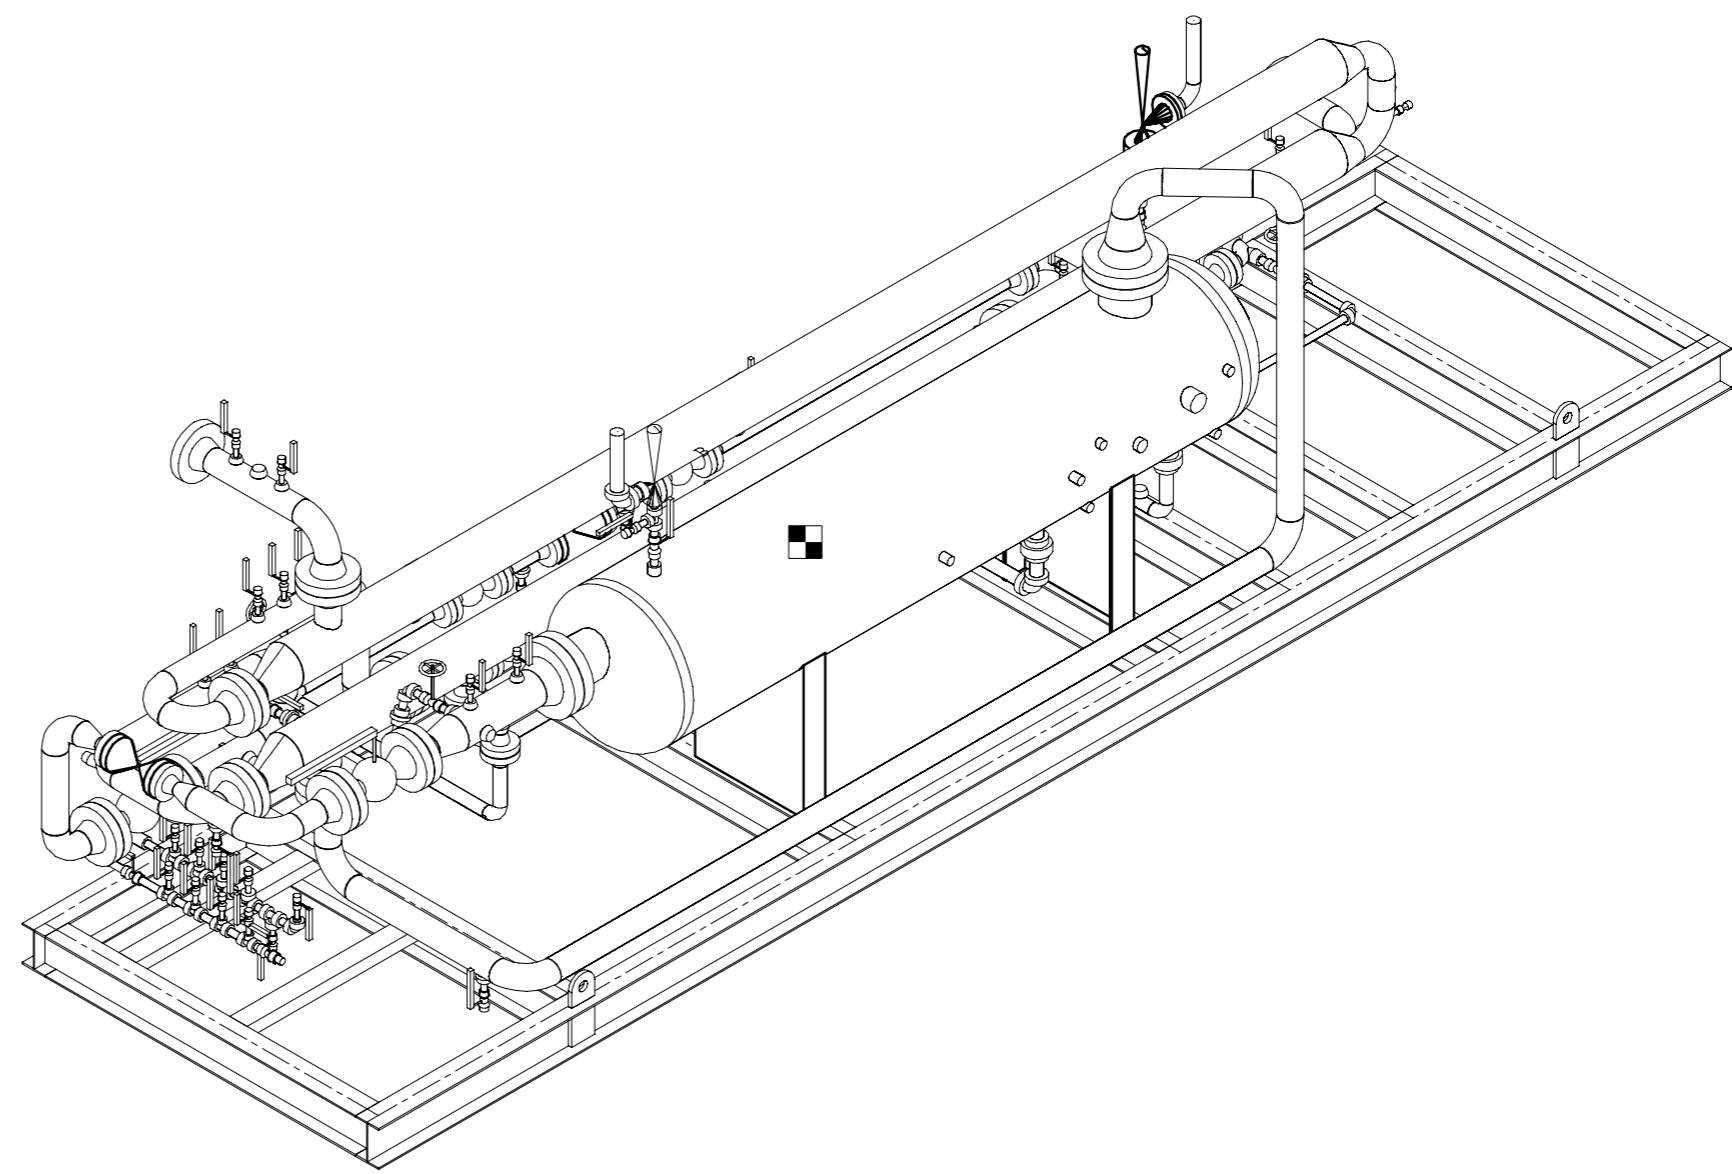

FINAL
AS BUILT
NAME _____ DATE _____

PROJECTS			
TOTAL PACKAGES REQD =			

NOTES:

- SEE SHT 1 FOR GENERAL NOTES AND CUSTOMER CONNECTION SCHEDULE.

REV	DESCRIPTION	DATE	BY	APR
4	AS-BUILT	9-1-20	MED	RG
3	ELEV. ERROR OF HT. EXCHANGER	04/24/20	FN	JH
2	REV'D SKID BEAM HEIGHT TO MATCH EXISTING SKID	02/25/20	FN	JH
1	REVISE OVERALL DIMENSIONS PER SKID CHANGES	02/04/20	FN	JH
0	ISSUED FOR CONSTRUCTION	01/20/20	FN	JH

DATE	11/19/19	SCALE	1/2"=1'-0"
DRAWN BY	FN	CHECKED BY	JH
PROJECT MANAGER	PROJECT ENGINEER		
CUST PO			

STEP CODE	WORK ORDER
-----------	------------

ENERFLEX
 Houston, Texas,
 USA

DWG NO E003319-01-201

PACKAGE LAYOUT
 JT10 SKID
 VIEW "D-D"

SHT 5 of 5 REV 4