


1 2 3 4 5 6 7 8

EOG-3920  
 42,00 USMG (1,59m3)  
 1728 INPS @ 76°C  
 SN: 28716A  
 74 247674

TO L.P. SEPARATOR  
 GP-04-18-PID-08  
 (NOT IN SERVICE)

TO TREATER  
 GP-04-18-PID-21.1  
 FLARE SYSTEM

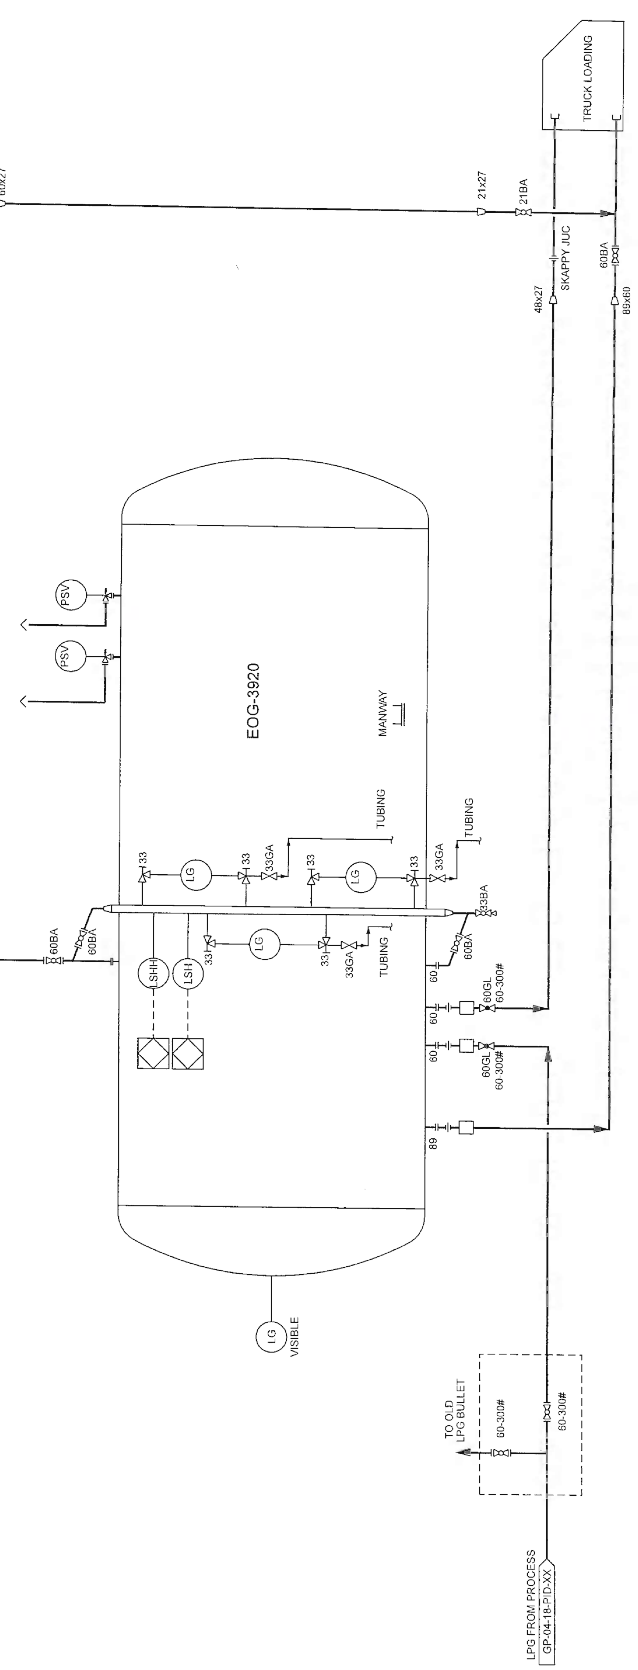

SKYSTONE  
 LCO 04-18-32-22 (WAW)  
 LPG BULLET / TRUCK LOADING  
 SHEET NO: 1 of 1  
 SCALE: NONE  
 DRAWING NO: GP-04-18-PID-20  
 REV: A

DATE	13/11/02	4
DRAWN BY:	SKR	
DESIGNED BY:		
CHECKED BY:		
APPROVED BY:		
DATE <td>13/11/03 <td></td> </td>	13/11/03 <td></td>	
CLIENT BY:		
DATE <td></td> <td></td>		
REV <td>A</td> <td>AS BUILT FIELD MARKUPS.</td>	A	AS BUILT FIELD MARKUPS.
REV <td></td> <td></td>		