


TRANSFER PUMP
 MFG: EAGLE
 MDL: 5-300 145
 CAP: N/A
 DRIVER: 3 HP @ 3600 RPM

V-020
 LOW PRESSURE FLARE KNOCKOUT DRUM
 SIZE: 1829 mm Ø x 3048 mm S/S
 MWP: 97 kPa @ 66°C
 SN: 04-94-M051-2
 CAP: 50 BBL'S

V-025
 HIGH PRESSURE FLARE KNOCKOUT DRUM
 SIZE: 1829 mm Ø x 6096 mm S/S
 MWP: 97 kPa @ 66°C
 SN: 04-94-M051-1
 CAP: 100 BBL'S

FS-630
 HIGH AND LOW PRESSURE FLARE STACK
 SIZE: 324 mm Ø x 30480 mm TALL (HP)
 219 mm Ø x 30480 mm TALL (LP)
 CONTINUOUS ELECTRIC TIGHT
 REMAINS ELECTRIC TIGHT
 COYED

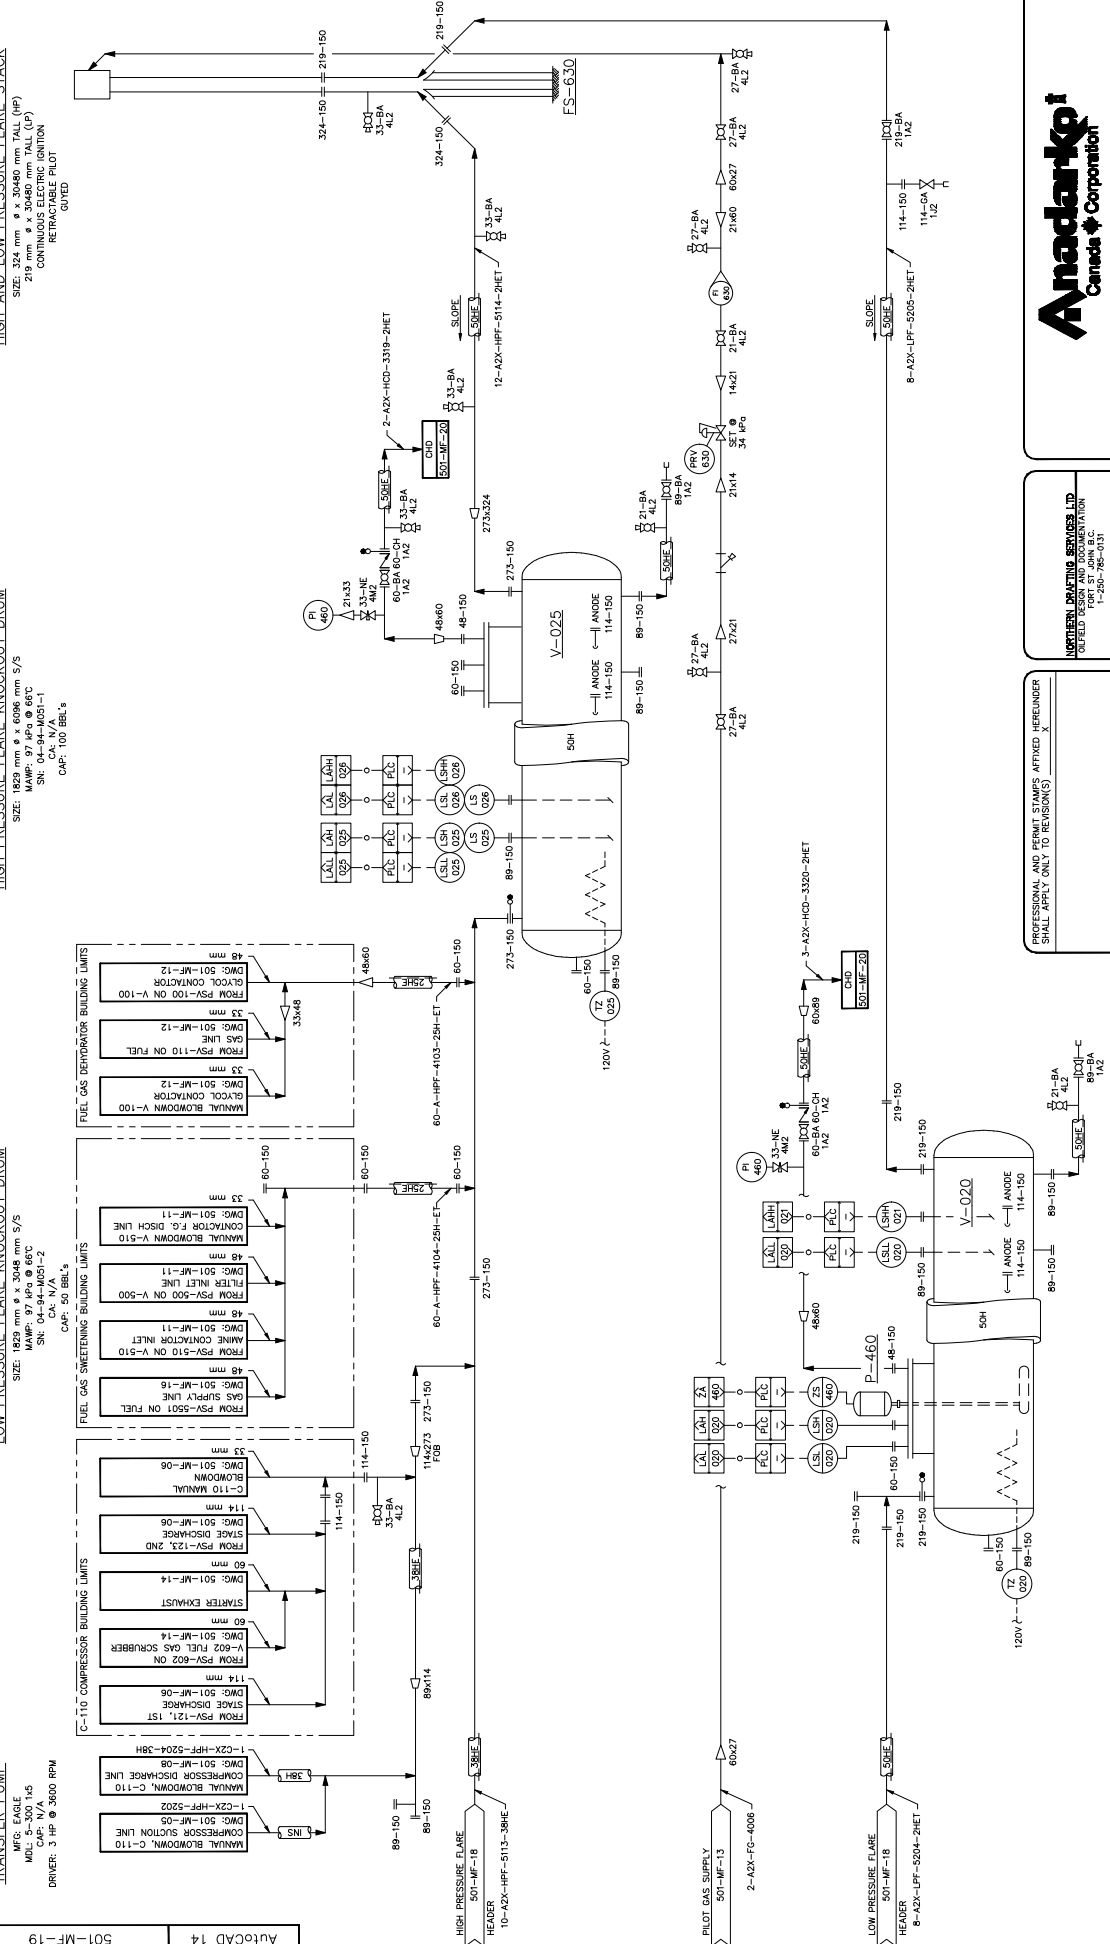

NO.	DATE	REVISIONS	TITLE
5	15 09 02	AS-IS, REDRAWN	MECHANICAL PLOT PLAN
4	13 03 02	AS-BUILT	MECHANICAL PLOT PLAN
3	08 03 02	DRAWING NUMBER/CONTINUATION ARROWS REVISED	MECHANICAL PLOT PLAN
2	04 02 02	AS-BUILT AS PER LEADER MARK-UPS	MECHANICAL PLOT PLAN
1	24 02 01	RE-ISSUED FOR CONSTRUCTION	MECHANICAL PLOT PLAN
0	07 02 01	ISSUED FOR CONSTRUCTION (TUNDRA #1016)	MECHANICAL PLOT PLAN

c-76-K, 94-B-8 GRAHAM COMPRESSOR STATION
HIGH AND LOW PRESSURE FLARE STACKS AND KNOCKOUTS
MECHANICAL FLOW DIAGRAM

CLIENT FILE NO.	SCALE	NORTHERN DRAWING NUMBER	REV.
501-MF-01	1:1	501-MF-19	5
CLIENT DWG NUMBER	NTS		

PROFESSIONAL AND PERMIT STAMPS AFFIXED HEREINAFTER SHALL APPLY ONLY TO REVISIONS(S) X

APPROVED FOR CONSTRUCTION
 BY: _____ DATE: YY MM DD
 BY: _____ DATE: YY MM DD

PROFESSIONAL AND PERMIT STAMPS