


**TRANSFER PUMP**  
 MFG: EAGLE  
 MDL: 5-300 145  
 CAP: N/A  
 DRIVER: 3 HP @ 3600 RPM

**V-020**  
 LOW PRESSURE FLARE KNOCKOUT DRUM  
 SIZE: 1829 mm Ø x 3048 mm S/S  
 MWP: 97 kPa @ 66°C  
 SN: 04-94-MOSI-2  
 CAP: 50 BBL'S

**V-025**  
 HIGH PRESSURE FLARE KNOCKOUT DRUM  
 SIZE: 1829 mm Ø x 6096 mm S/S  
 MWP: 97 kPa @ 66°C  
 SN: 04-94-MOSI-1  
 CAP: 100 BBL'S

**FS-630**  
 HIGH AND LOW PRESSURE FLARE STACK  
 SIZE: 324 mm Ø x 30480 mm TALL (HP)  
 219 mm Ø x 30480 mm TALL (LP)  
 CONTINUOUS ELECTRIC TIGHT  
 REMAINS ELECTRIC TIGHT  
 WIND

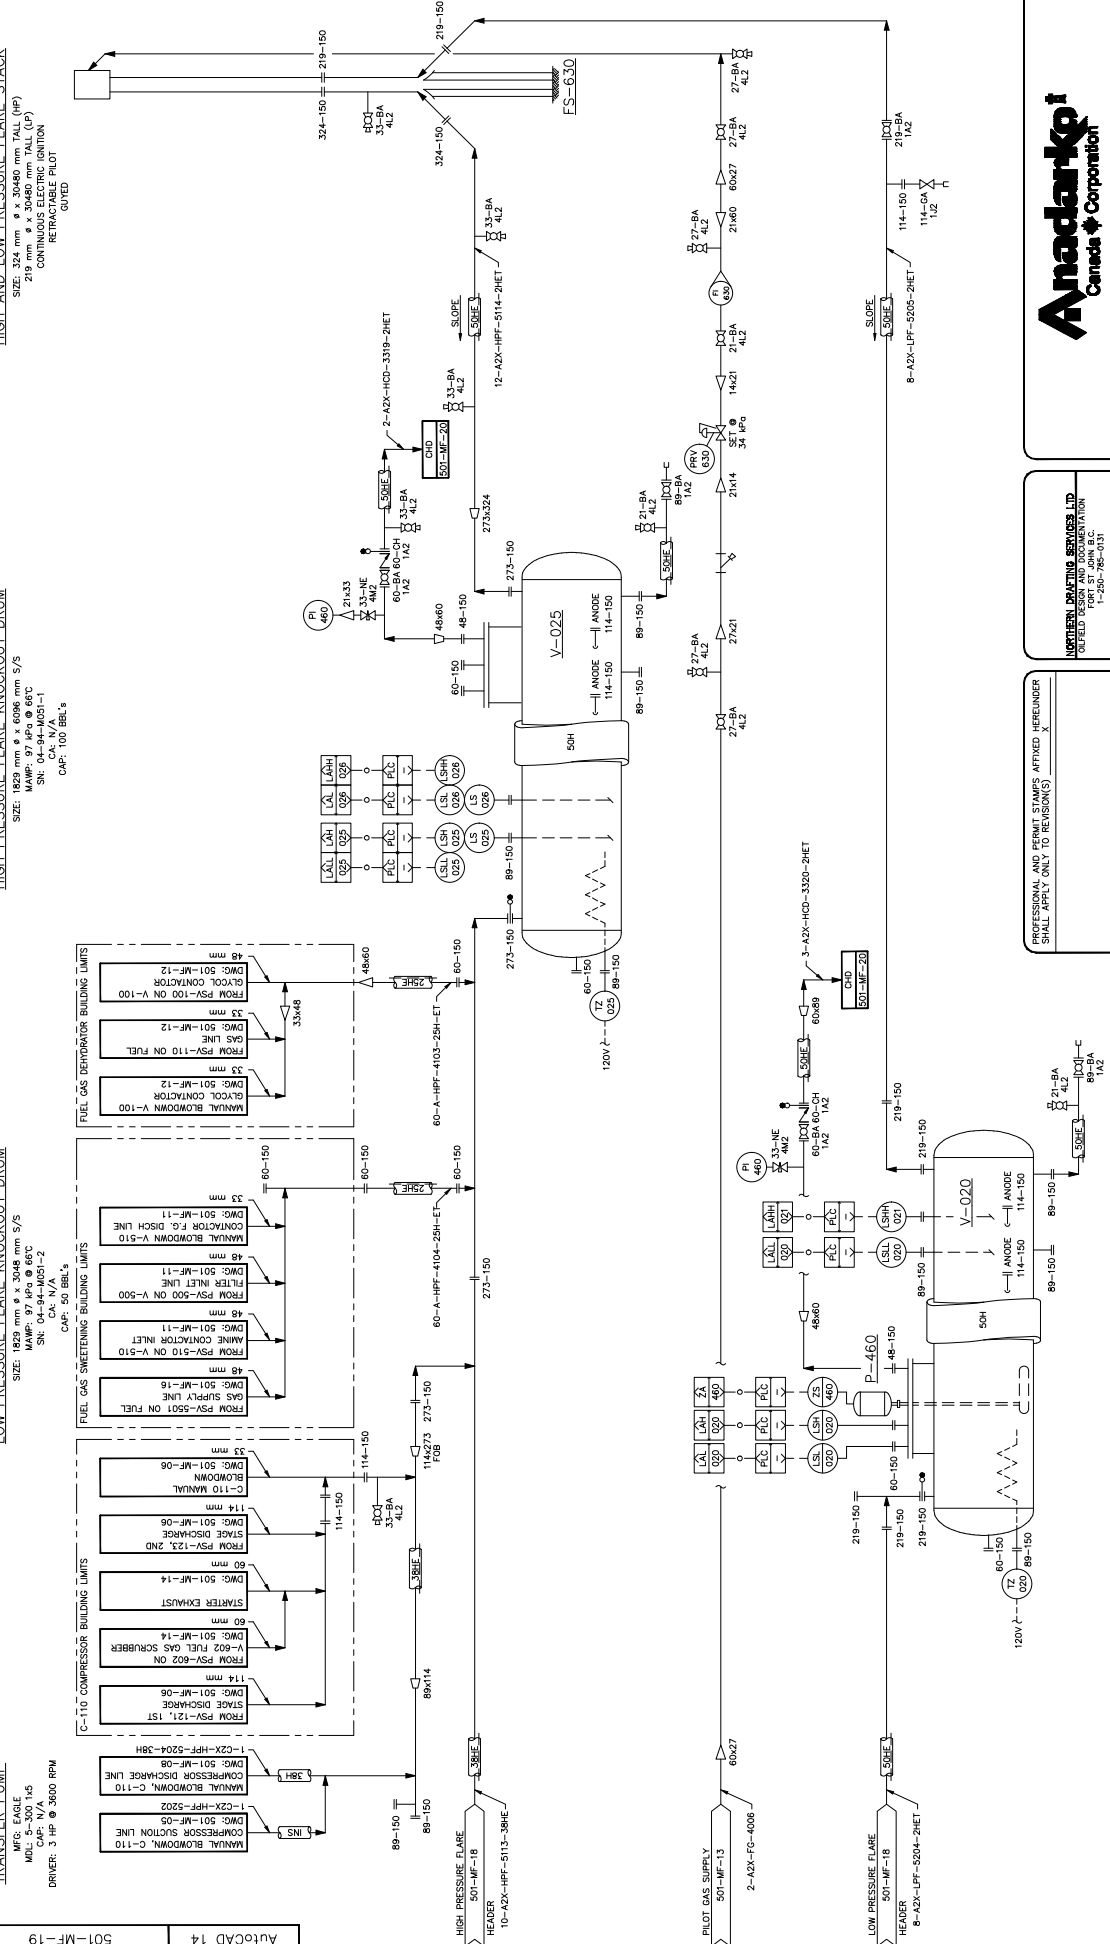

NO.	DATE	REVISIONS	TITLE
5	15 09 02	AS-IS, REDRAWN	MECHANICAL PLOT PLAN
4	13 03 02	AS-BUILT	MECHANICAL PLOT PLAN
3	08 03 02	DRAWING NUMBER/CONTINUATION ARROWS REVISED	MECHANICAL PLOT PLAN
2	04 02 02	AS-BUILT AS PER LEADER MARK-UPS	MECHANICAL PLOT PLAN
1	24 02 01	RE-ISSUED FOR CONSTRUCTION	MECHANICAL PLOT PLAN
0	07 02 01	ISSUED FOR CONSTRUCTION (TUNING #1016)	MECHANICAL PLOT PLAN

c-76-K, 94-B-8 GRAHAM COMPRESSOR STATION  
 HIGH AND LOW PRESSURE FLARE STACKS AND KNOCKOUTS  
 MECHANICAL FLOW DIAGRAM

CLIENT FILE NO. \_\_\_\_\_ SCALE: NORTHERN DRAWING NUMBER  
 CLIENT DWG NUMBER \_\_\_\_\_ NTS 501-MF-19

APPROVED FOR CONSTRUCTION  
 BY: \_\_\_\_\_ DATE: YY MM DD  
 BY: \_\_\_\_\_ DATE: YY MM DD

PROFESSIONAL AND PERMIT STAMPS AFFIXED HEREINAFTER SHALL APPLY ONLY TO REVISIONS(S) X

PROFESSIONAL AND PERMIT STAMPS