


THE INFORMATION AND DATA CONTAINED IN THIS DRAWING IS CONFIDENTIAL, PROPRIETARY IN NATURE AND SUBJECT TO COPYRIGHT, AND MAY NOT BE REPRODUCED, COPIED, MIRACED, REPRODUCED, ALTERED, CHANGED, MOVED, FILED, DISTRIBUTED, OR UTILIZED IN ANY FORM WITHOUT THE EXPRESS PERMISSION OF CONOCO-PHILLIPS COMPANY.

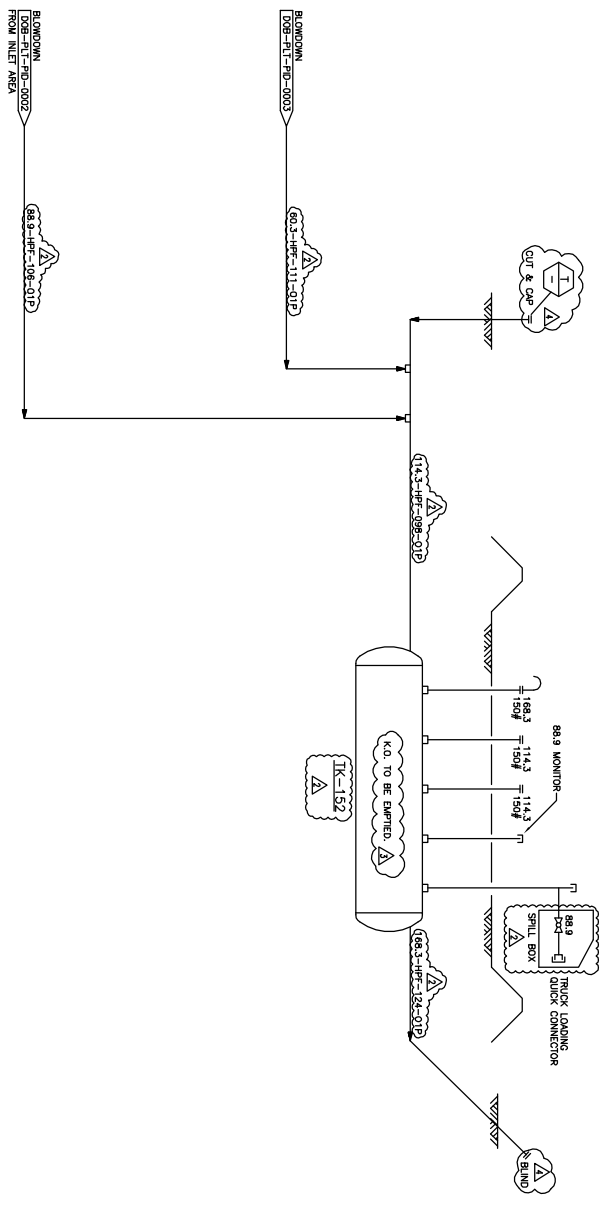

REFERENCE DRAWINGS	
DOC. NO.	TITLE

NOV.	DATE	BY	CHECKED	REVISION		REVISION ISSUE
				NO.	DATE	
1	04/04/08	DMG	DMG	1		AS BUILT PER FIELD MARKING
2	07/02/15	JAM	AM	2		ISSUED FOR NOZE (NET #103558) (BY CPD)
3	08/09/20	MCC	MP	3		ISSUED FOR CONSTRUCTION (NET #103558) (BY CPD)
4	09/10/20	MCC	MP	4		ISSUED FOR CONSTRUCTION (NET #103558) (BY CPD)

ENGINEERING SEAL	

PRINT	

PREPARED BY: **CRIMECH**

DATE: 03/10/23

BY: (Y/M/D)

REVISION: 050

PROCESS OR: (Y/M/D)

DESIGN OR: (Y/M/D)

CHECK OR: (Y/M/D)

CLIENT: (Y/M/D)

ConocoPhillips
Central Refineries Corp.

DOBSON 08-21 PLANT

U/G FLARE KNOCKOUT TANK AND FLARE STACK PIPING AND INSTRUMENTATION DIAGRAM

LEGAL DESK. TO: (IF APPLICABLE):

LEGAL DESK. FROM: (IF APPLICABLE):

DATE OF APPROVAL: 10/19/23

SCALE: 1"=10'-0"

DATE OF APPROVAL: 10/19/23

DESIGN: 10/19/23

TRACING: 10/19/23

DOB-PLT-PID-001.3

REV: 4

NOTES

1. UNDERGROUND PIPE COULD NOT BE VIEWED.