



1 2 3 4 5 6 7 8

V-201
FWKO #2

MANP / ADUNIT: 750000 / 1000 FT
 SIZE: 8'00" X 20'5" / S
 SERIAL: 18770
 A / CRNF: A3181441/6-8805.2
 DESCRIPTION: VAC. BUILT 1980
 TEST PRESS: 750000

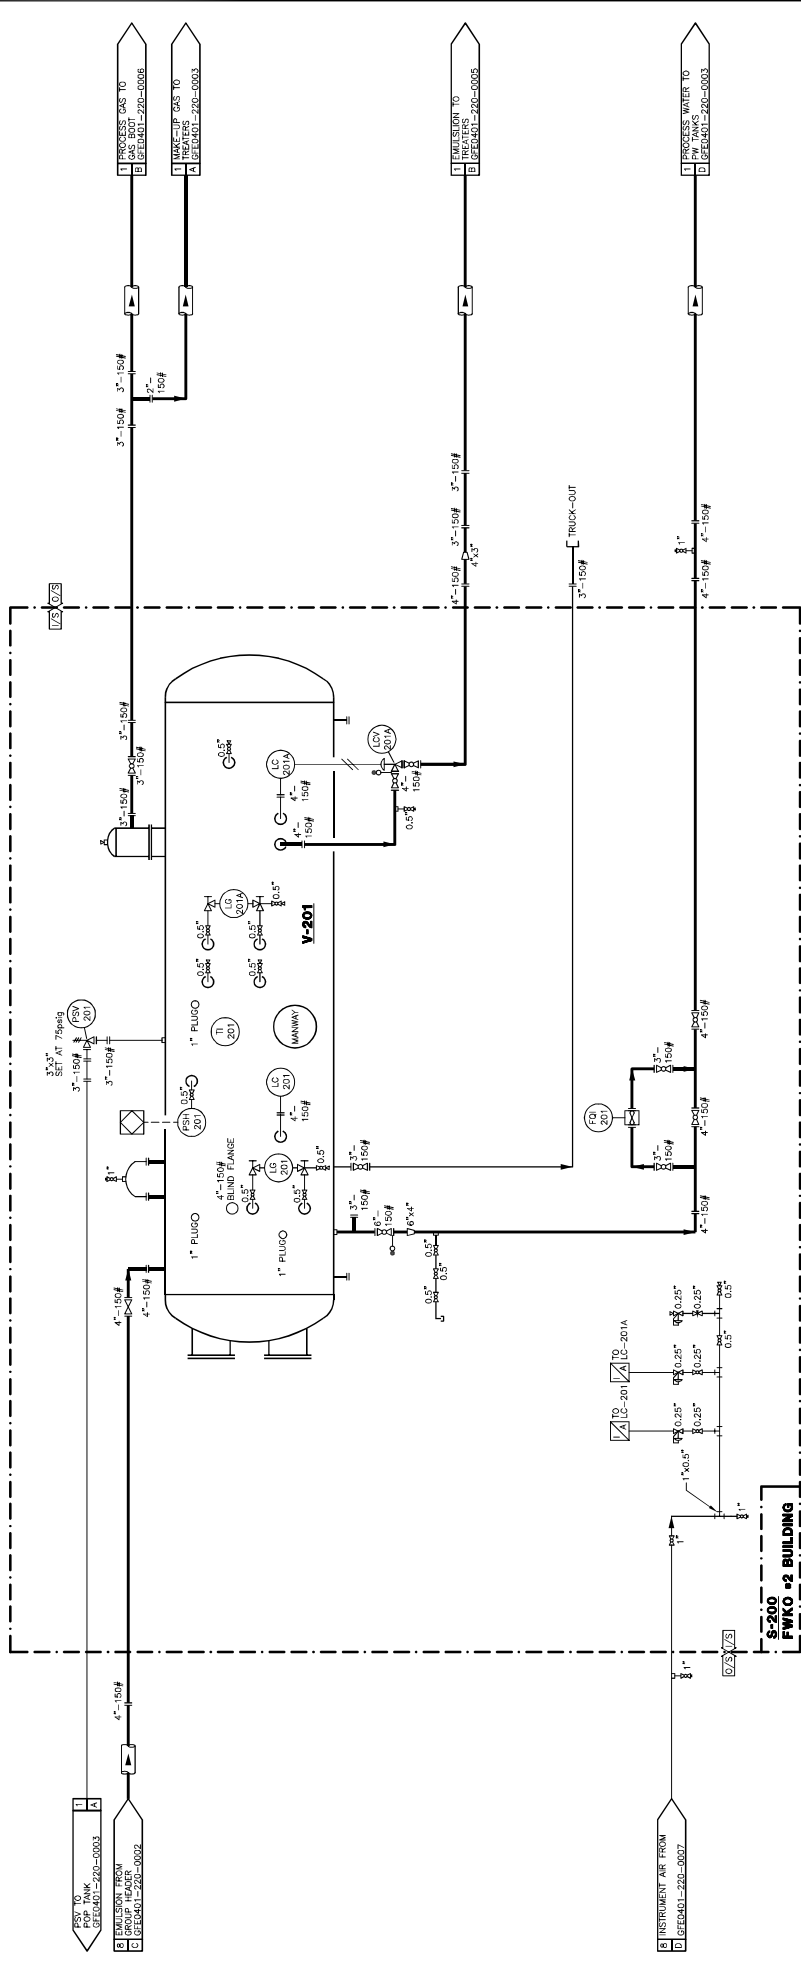

DRAWING NO.	REFERENCE DRAWINGS		LANMARK ENGINEERING 3362		REV.
DRAWING NO.	SCALE		TITLE		REV.
		NTS	GRAND FORKS EAST, AB FWKO #2		
DRAWING NO.	JOB NO.		DATE		REV.
		3362	2012-08-10		
DRAWING NO.	CLIENT		DATE		REV.
		LANMARK	2012-09-31		
DRAWING NO.	APP. / CLIENT		DATE		REV.
			2012-07-27		
DRAWING NO.	NO.		DATE		REV.
			2012-08-10		
DRAWING NO.	DATE		DATE		REV.

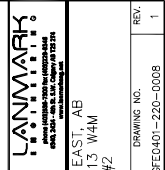

LANMARK
 Grand Forks East, AB
 FWKO #2

SCALE: NTS
 JOB NO.: 3362
 DRAWING NO.: GFC0401-220-0008

DATE: 2012-08-10
 DESIGNED BY: S.ZIADEH
 CHECKED BY: LD
 APPROVED BY: GA

DATE: 2012-09-31
 DATE: 2012-07-27
 DATE: 2012-08-10

NO. 1
 AS BUILT
 0
 AS BUILT

DESCRIPTION

LANMARK ENGINEERING 3362

REV. 1

DRAWING NO. GFC0401-220-0008