


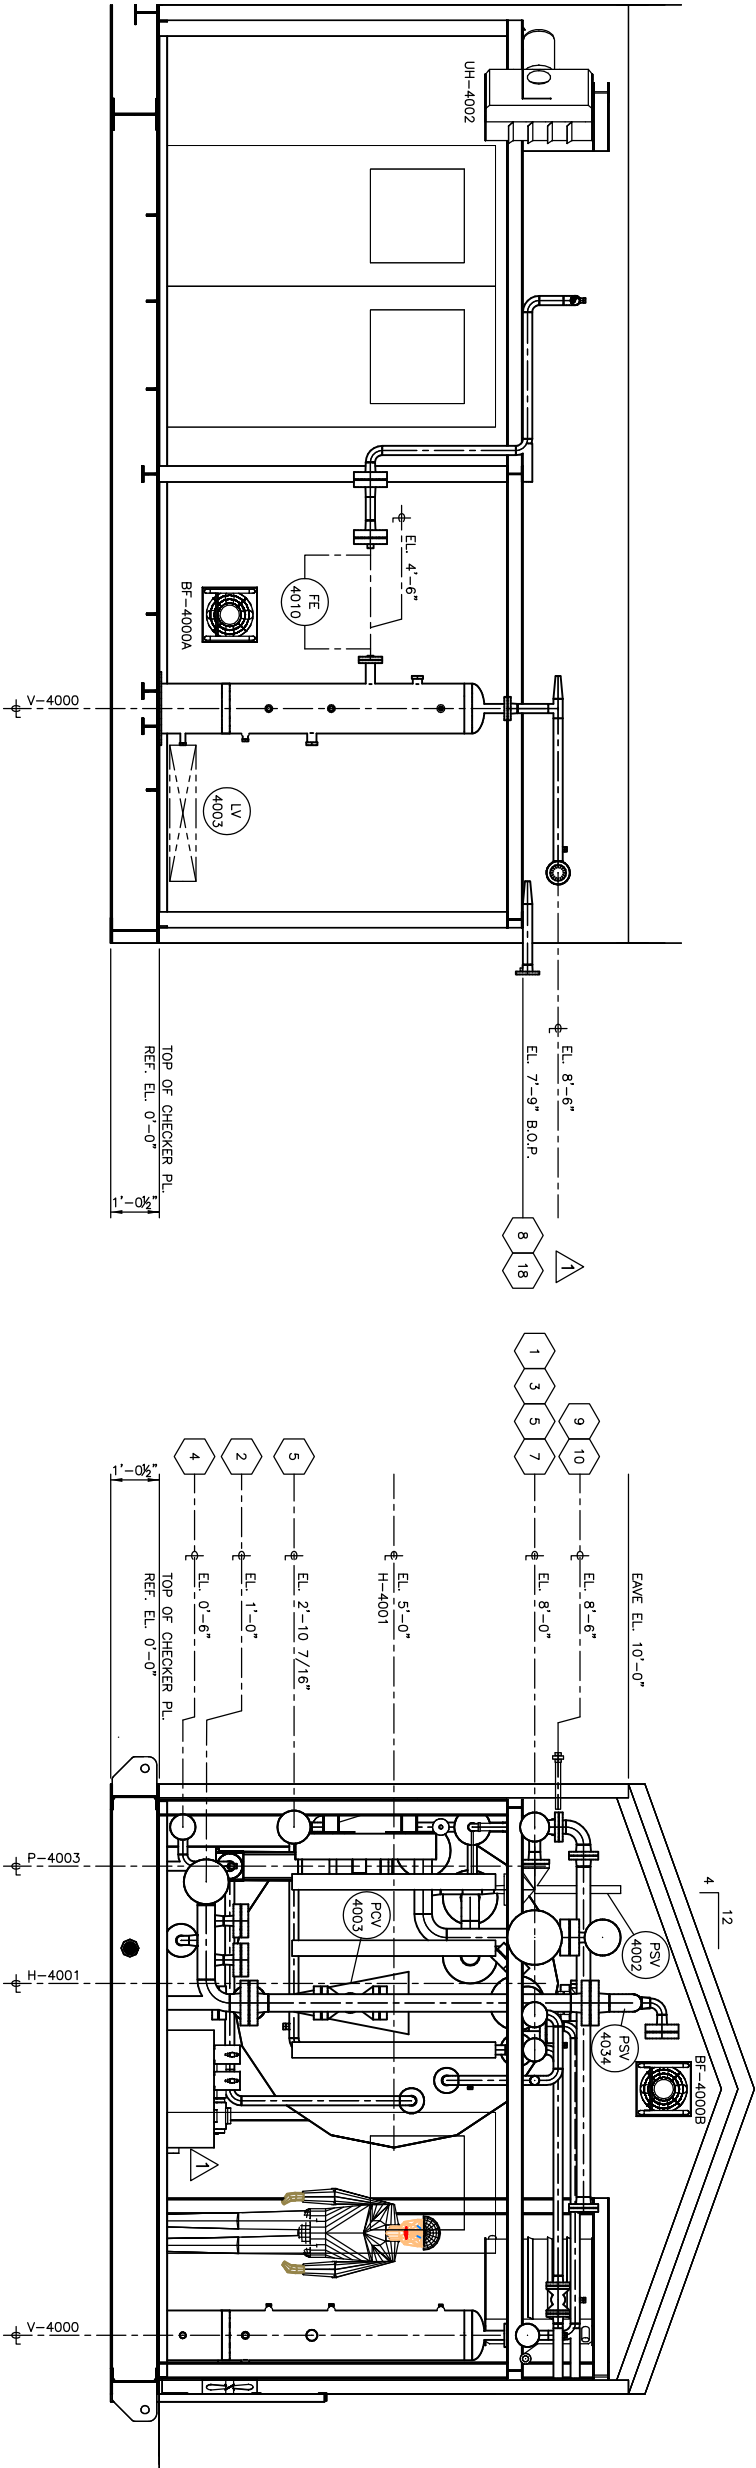

SECTION "B-B"

SECTION "C-C"

TIE-IN SCHEDULE

1	4" CL. 2500 RTJ GAS INLET EL. 8'-0" ±	10	1" CL. 3000 SW HOT GAS RETURN EL. 8'-6" ±	18	2" CL. 150 RF DRAIN HEADER EL. 7'-9" B.O.P.
2	4" CL. 900 RF GAS OUTLET EL. 1'-0" ±	11	1/2" CL. 3000 NPT INHIBITOR FROM STORAGE TANK EL. SHOP TO LOCATE	19	2" CL. 3000 NPT FLOOR DRAIN EL. -0'-7" 1/2" ±
3	3" CL. 150 RF TO FLARE KNOCK OUT EL. 8'-0" ±	12A	1/2" CL. 6000 NPT INHIBITOR TO PIPELINE EL. SHOP TO LOCATE	20	1/2" CL. 3000 NPT PURGE GAS EL. 7'-0" ±
4	2" CL. 300 RF HEAT STRING INLET EL. 0'-6" ±	12B	3/8" CL. 6000 NPT INHIBITOR TO WELLHEAD EL. SHOP TO LOCATE	21	1/2" CL. 3000 NPT SULPHUR DISP. FROM STORAGE TANK EL. SHOP TO LOCATE
5	2" CL. 300 RF HEAT STRING OUTLET EL. 8'-0" ±	13	1/2" CL. 3000 NPT EQUALIZE TO TANK EL. SHOP TO LOCATE	22	1/2" CL. 3000 NPT EQUALIZE TO LOCATE
6	2" CL. 900 RTJ SWEET DRY FUEL GAS EL. 2'-10" 7/16" ±	14	1/2" CL. 3000 NPT METH. FROM STORAGE TANK EL. SHOP TO LOCATE	23	1/2" CL. 6000 NPT SULPHUR DISP. TO DEHY. EL. SHOP TO LOCATE
7	2" CL. 150 RF FUEL GAS OUTLET EL. 8'-0" ±	15	3/8" CL. 6000 NPT METH. O. SQUIR. WELLHEAD EL. SHOP TO LOCATE	24	1" CL. 3000 NPT PUMP SEAL RESERVOIR VENT EL. SHOP TO LOCATE
8	1" CL. 3000 NPT INST. GAS SUPPLY EL. 7'-9" B.O.P.	16	1/2" CL. 3000 NPT EL. SHOP TO LOCATE	25	2" CL. 3000 NPT EL. SHOP TO LOCATE
9	1" CL. 3000 SW HOT GASOL SUPPLY EL. 8'-6" ±	17	1 1/2" CL. 3000 NPT L.P. VENT HEADER EL. SHOP TO LOCATE		



NO.	REASON	BY	CHKD.	DATE
2	AS BUILT	BB		08/03/25
1	ELEV. CHANGE TIE-IN #18/STAND ON HOLD	KMS		07/02/15
0	ISSUED FOR CONSTRUCTION	KMS		06/11/20
B	RE-ISSUED FOR APPROVAL	KMS		06/10/19
A	ISSUED FOR APPROVAL	KMS		06/09/18

CUSTOMER REFERENCE

119-22-00

CUSTOMER

BP CANADA

JOB NO.

B7330-01

TITLE

LINE HEATER PACKAGE
SECTION "B-B" & "C-C"

DRAWN

KMS

CHECKED

APPROVED

SCALE

1/2"=1'-0"

DATE

06/09/18

DRAWING NUMBER

B7330-310 SHT. 3 OF 3