


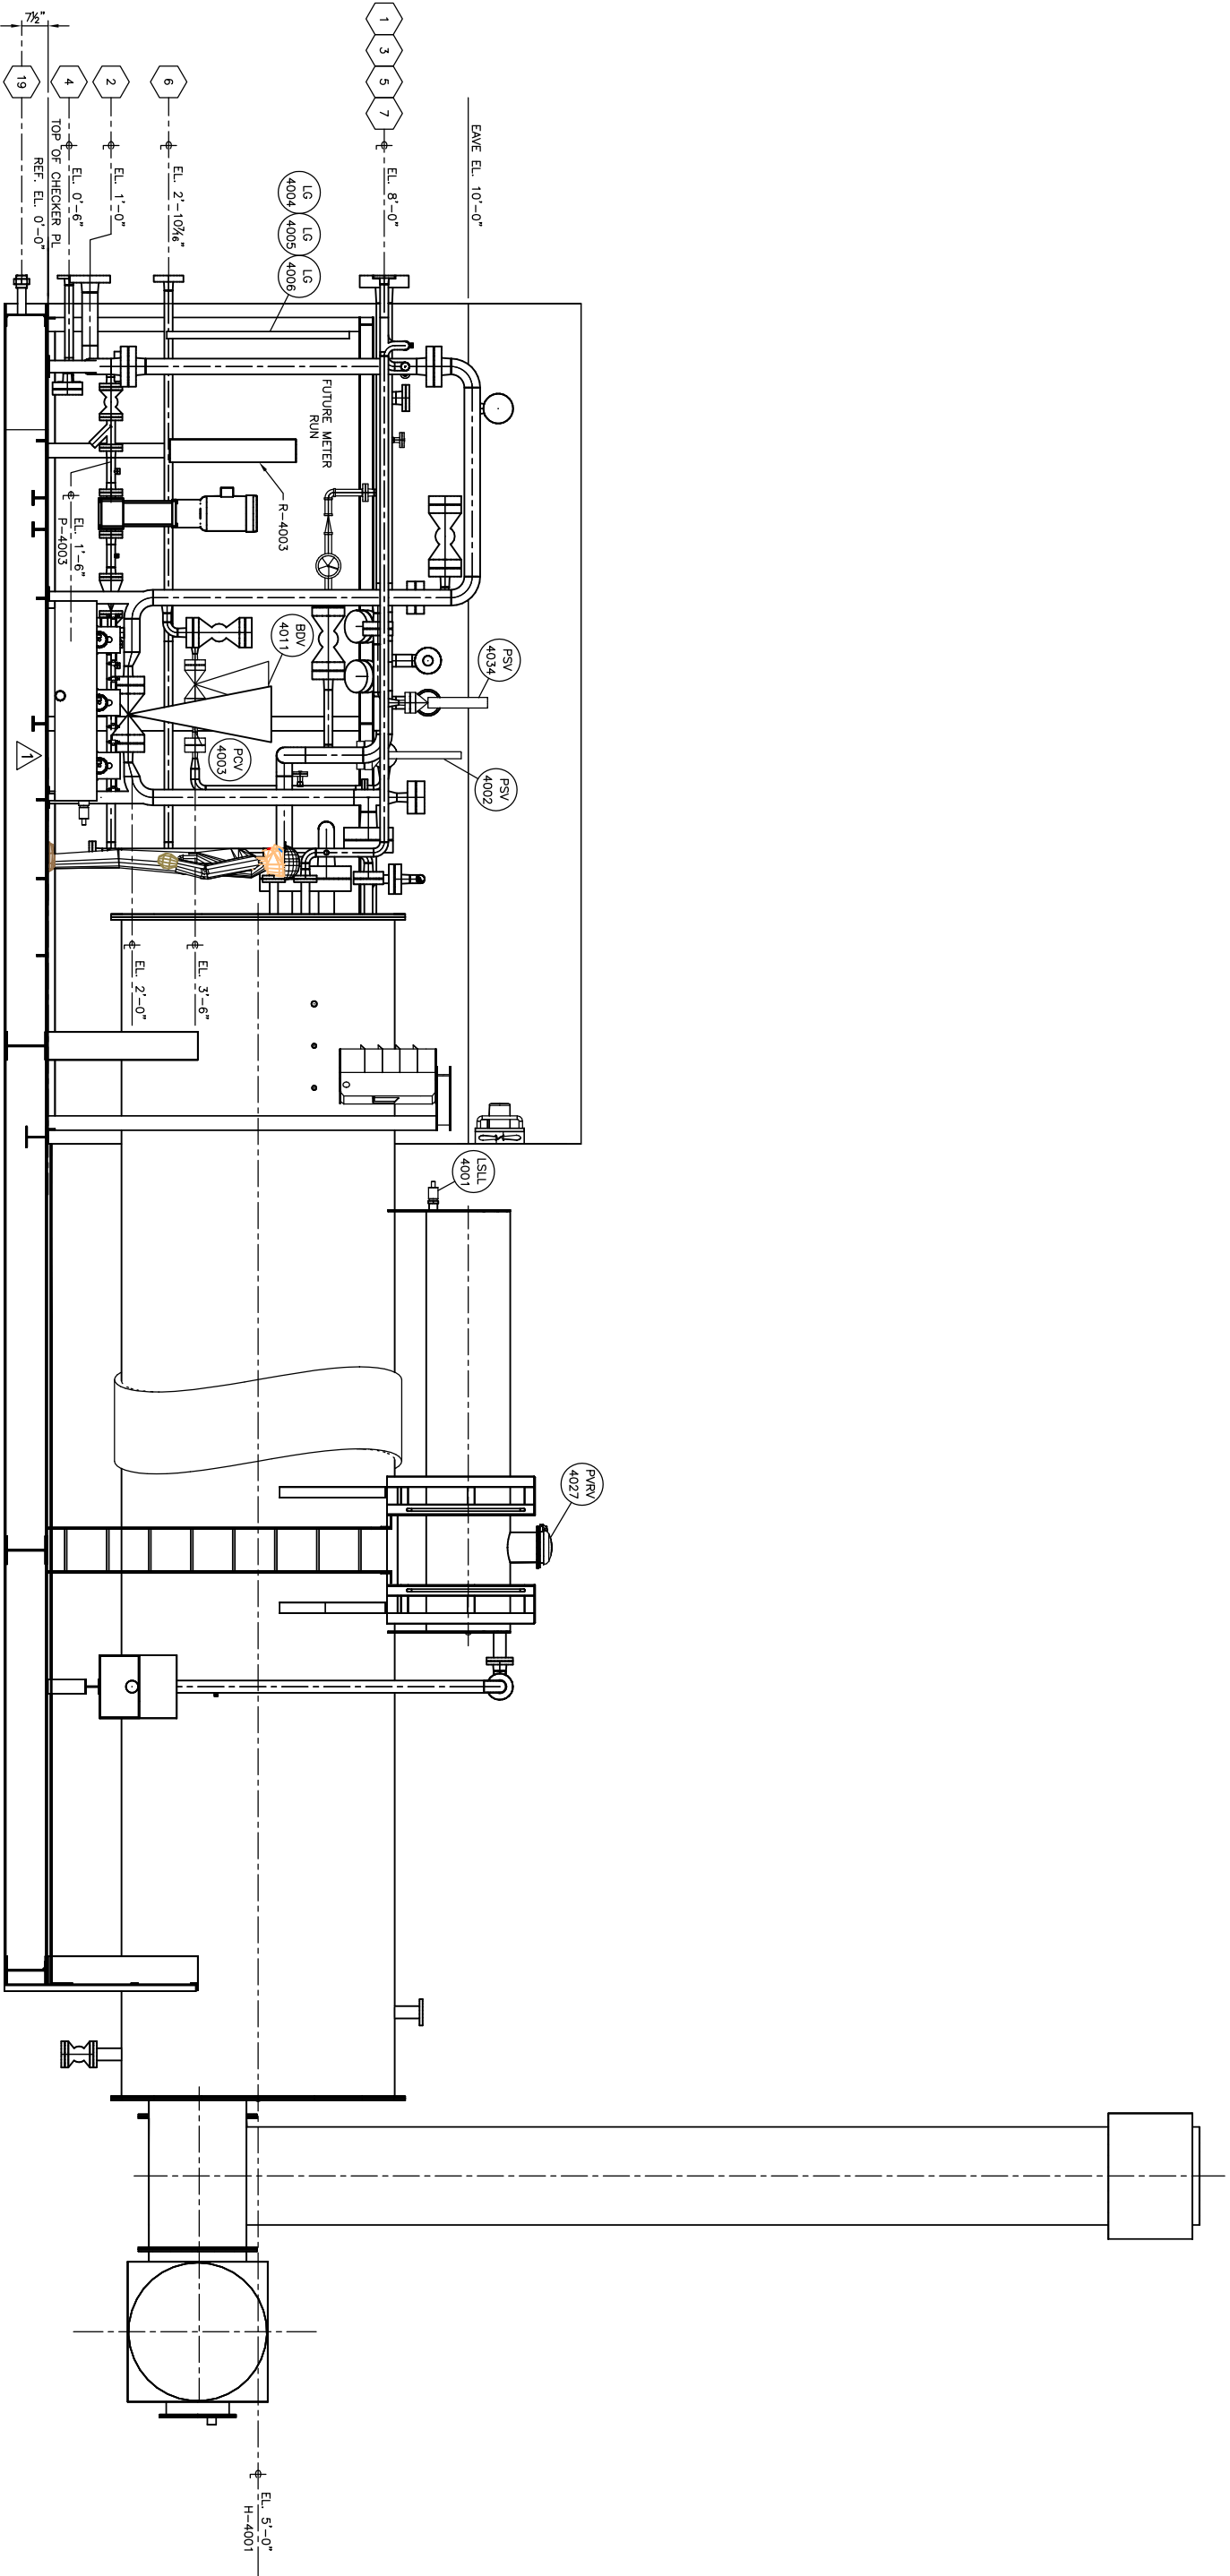

TIE-IN SCHEDULE

1	4" CL 2500 RTU GAS INLET EL. 8'-0" ⚡	10	1" CL 3000 SW HOT GLYCOL RETURN EL. 8'-6" ⚡	18	2" CL 150 RF DRAIN HEADER EL. 7'-9" B.O.P.
2	4" CL 900 RF GAS OUTLET EL. 1'-0" ⚡	11	1/2" CL 3000 NPT INHIBITOR FROM STORAGE TANK EL. SHOP TO LOCATE	19	2" CL 3000 NPT FLOOR DRAIN EL. -0'-7 1/2" ⚡
3	3" CL 150 RF TO FLARE KNOCK OUT EL. 8'-0" ⚡	12A	1/2" CL 6000 NPT INHIBITOR TO PIPELINE EL. SHOP TO LOCATE	20	1/2" CL 3000 NPT PURGE GAS EL. 7'-0" ⚡
4	2" CL 300 RF HEAT STRING INLET EL. 0'-6" ⚡	12B	3/8" CL 6000 NPT INHIBITOR TO WELHEAD EL. SHOP TO LOCATE	21	1/2" CL 3000 NPT SULPHUR DISP. FROM STORAGE TANK EL. SHOP TO LOCATE
5	2" CL 300 RF HEAT STRING OUTLET EL. 8'-0" ⚡	13	1/2" CL 3000 NPT EQUALIZE TO TANK EL. SHOP TO LOCATE	22	1/2" CL 3000 NPT EQUALIZE TO TANK EL. SHOP TO LOCATE
6	2" CL 900 RTU SWEET DRY FUEL GAS EL. 2'-10 7/16" ⚡	14	1/2" CL 3000 NPT MESH FROM STORAGE TANK EL. SHOP TO LOCATE	23	1/2" CL 6000 NPT SULPHUR DISP. TO DEHY. EL. SHOP TO LOCATE
7	2" CL 150 RF ZONE GAS OUTLET EL. 8'-0" ⚡	15	3/8" CL 6000 NPT MESH FROM WELHEAD EL. SHOP TO LOCATE	24	1" CL 3000 NPT PLUMBING VENT EL. SHOP TO LOCATE
8	1" CL 3000 NPT INSTRUMENT AIR SUPPLY EL. 7'-9" B.O.P.	16	1" CL 3000 NPT EQUALIZE TO TANK EL. SHOP TO LOCATE	25	1" CL 3000 NPT ESQ. BY-PASS EL. SHOP TO LOCATE
9	1" CL 3000 SW HOT GLYCOL SUPPLY EL. 8'-6" ⚡	17	1 1/2" CL 3000 NPT L.P. VENT HEADER EL. SHOP TO LOCATE		

SECTION "A-A"
SHT. 2

- NOTES:
- 1) ALL ELEVATIONS ARE TAKEN FROM TOP OF CHECKER PLATE REFERENCE ELEVATION 0'-0".
 - 2) FOR PIPING SURFACE PREPARATION AND PAINT NOTES SEE INSTRUMENT LIST.
 - 3) SHOP SUPPORT ALL PIPING AS REQUIRED.
 - 4) ALL PIPING UNDER 2" NPS IS SHOWN FOR REFERENCE ONLY.

NO.	REVISION	BY	CHKD.	DATE
2	AS BUILT	BB		08/03/25
1	ELEV. CHANGE TIE-IN #18/STAND ON HOLD	KMS		07/02/15
0	ISSUED FOR CONSTRUCTION	KMS		06/11/20
B	RE-ISSUED FOR APPROVAL	KMS		06/10/19
A	ISSUED FOR APPROVAL	KMS		06/09/18

CUSTOMER

119-22-00

CUSTOMER

BP CANADA

CUSTOMER REFERENCE

119-22-00

PROJECT

TWO LAKES, 3-3
LSD 03-03-63-13 W6M

TITLE

LINE HEATER PACKAGE
SECTION "A-A"

DRAWN

KMS

CHECKED

APPROVED

SCALE

1/2"=1'-0"

DATE

06/09/18

DRAWING NUMBER

B7330-310 SHT. 2 OF 3