


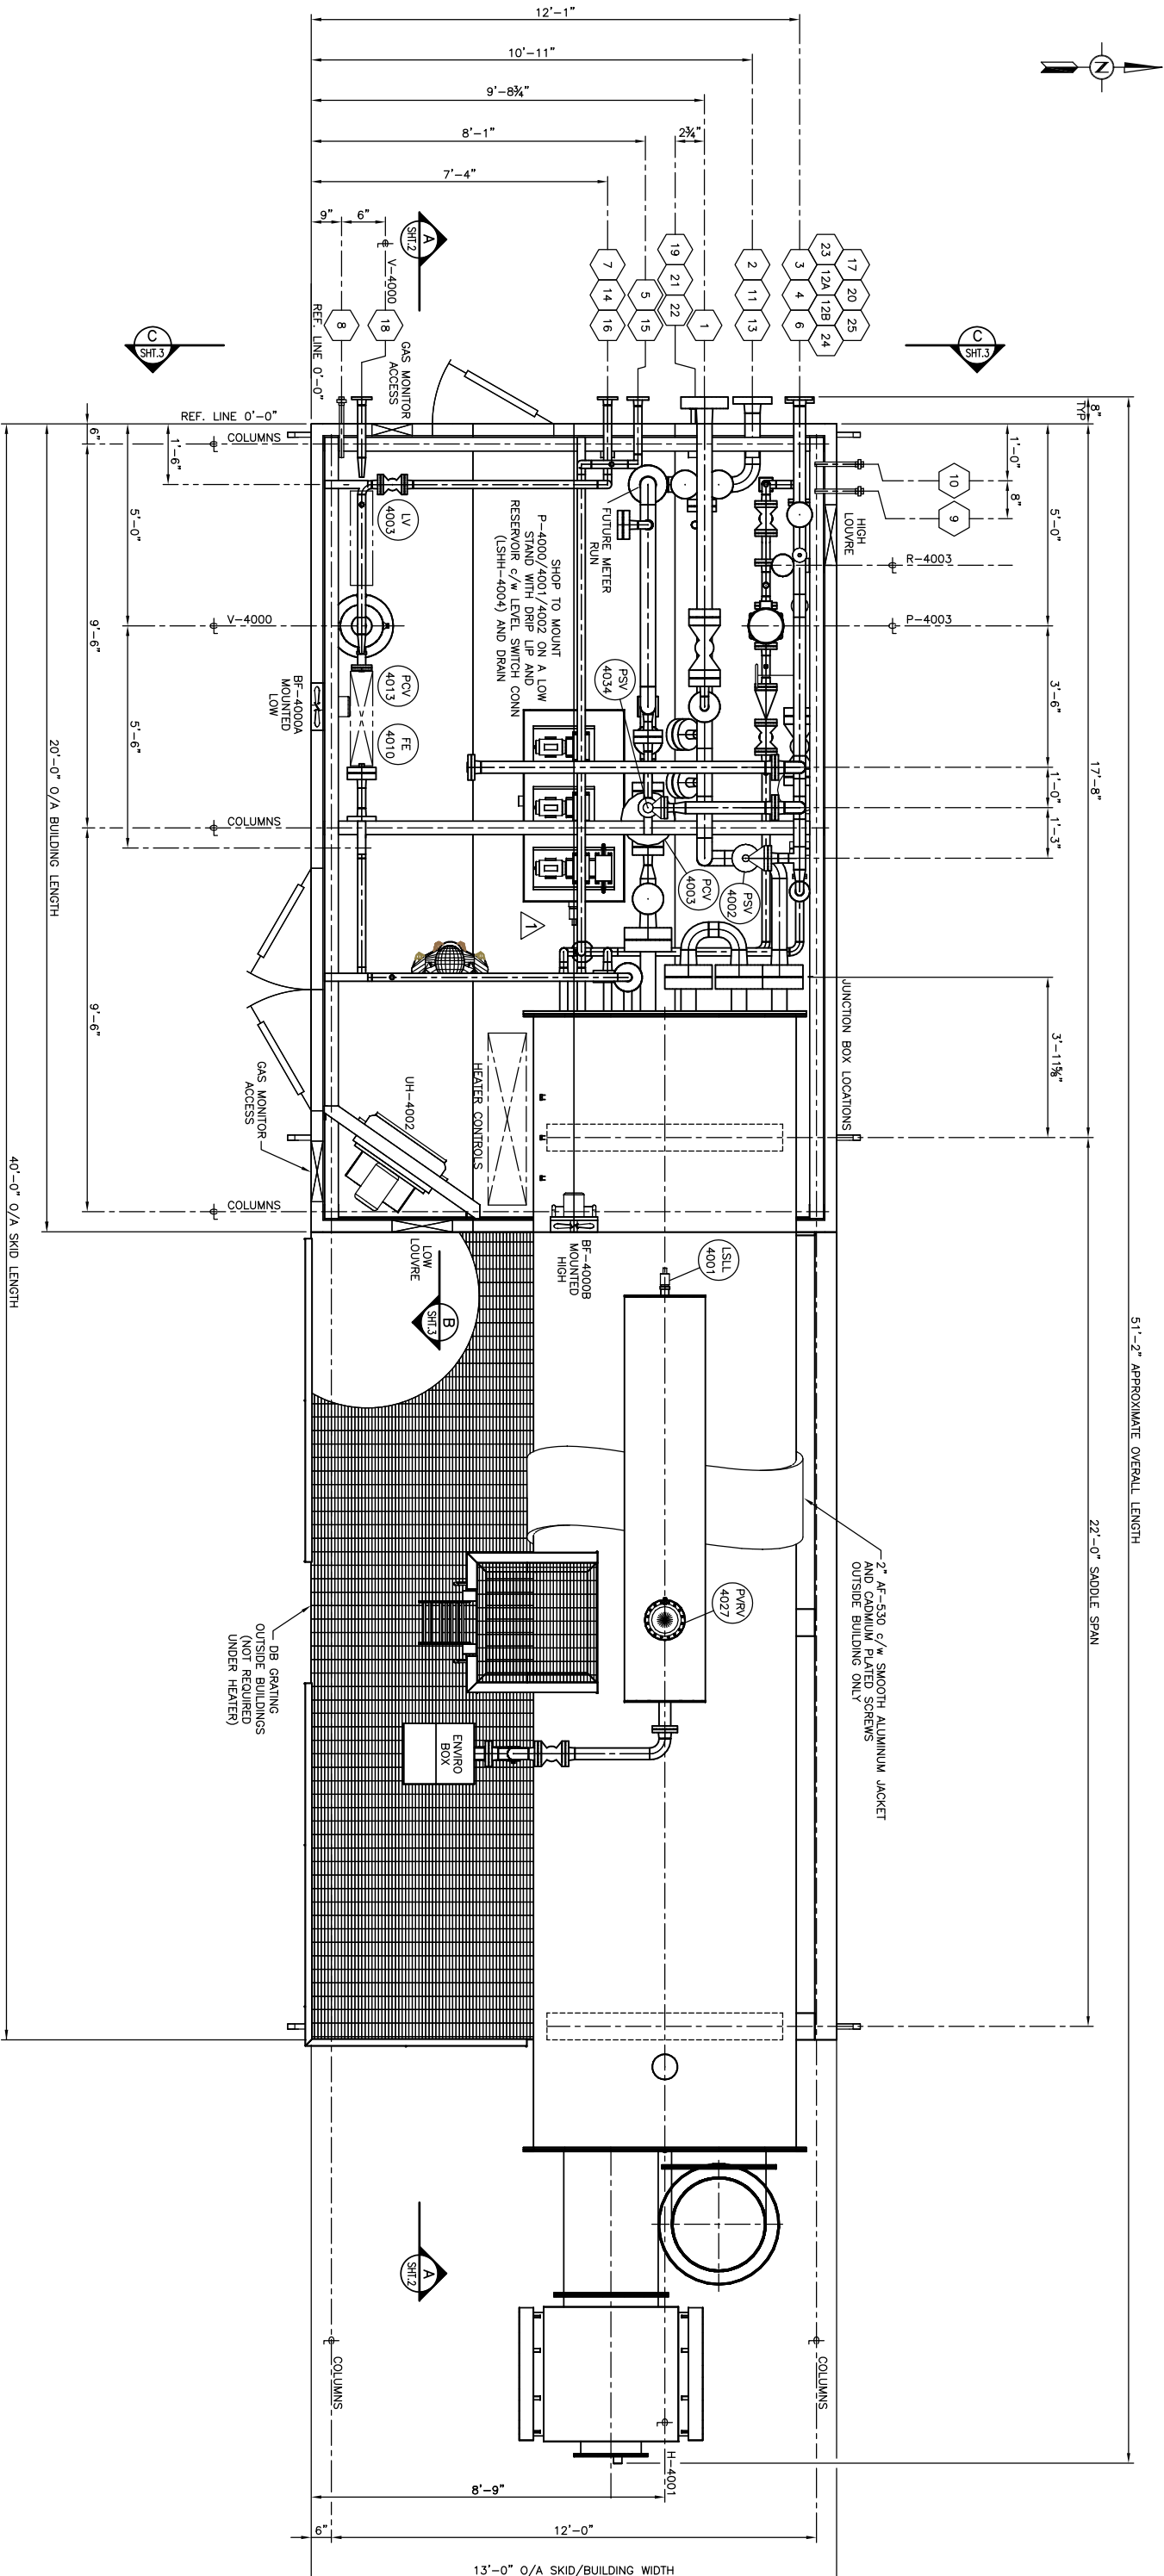

TIE-IN SCHEDULE

1	4" CL. 2500 RTU GAS INLET EL. 8'-0" ±	10	1" CL. 3000 SW HOT GLYCOL RETURN EL. 8'-6" ±
2	4" CL. 900 RF GAS OUTLET EL. 1'-0" ±	11	1/2" CL. 3000 NPT INHIBITOR FROM STORAGE TANK EL. SHOP TO LOCATE
3	3" CL. 150 RF TO FLARE KNOCK OUT EL. 8'-0" ±	12A	1/2" CL. 6000 NPT INHIBITOR TO PIPELINE EL. SHOP TO LOCATE
4	2" CL. 300 RF HEAT STRING INLET EL. 0'-6" ±	12B	3/8" CL. 6000 NPT INHIBITOR TO WELLHEAD EL. SHOP TO LOCATE
5	2" CL. 300 RF HEAT STRING OUTLET EL. 8'-0" ±	13	1/2" CL. 3000 NPT EQUALIZE TO TANK EL. SHOP TO LOCATE
6	2" CL. 900 RTU GAS INLET 7/16" ±	14	1/2" CL. 3000 NPT EQUALIZE TO LOCATE EL. SHOP TO LOCATE
7	2" CL. 150 RF FUEL GAS OUTLET EL. 8'-0" ±	15	3/8" CL. 6000 NPT PUMP SEAT RESERVOIR VENT EL. SHOP TO LOCATE
8	1" CL. 3000 NPT INSTRUMENT AIR SUPPLY EL. 7'-9" B.O.P.	16	1/2" CL. 3000 NPT EQUALIZE TO TANK EL. SHOP TO LOCATE
9	1" CL. 3000 SW HOT GLYCOL SUPPLY EL. 8'-6" ±	17	1 1/2" CL. 3000 NPT L.P. VENT HEADER EL. SHOP TO LOCATE



NO.	REVISION	BY	CHKD.	DATE
2	AS-BUILT	BB		08/03/26
1	ELEV. CHANGE TIE-IN #18/STAND ON HOLD	KMS		07/02/15
0	ISSUED FOR CONSTRUCTION	KMS		06/11/20
B	RE-ISSUED FOR APPROVAL	KMS		06/10/19
A	ISSUED FOR APPROVAL	KMS		06/09/18

CUSTOMER REFERENCE 119-22-00

Presson
ENERFLEX

CUSTOMER	BP CANADA	JOB NO.	B7330-01
PROJECT	TWO LAKES, 3-3 LSD 03-03-63-13 W6M		

TITLE	LINE HEATER PACKAGE GENERAL ARRANGEMENT		
DRAWN	KMS	CHECKED	APPROVED
SCALE	1/2"=1'-0"	DATE	06/09/18
ISSUING NUMBER	B7330-310	SHT.	1 OF 3

- NOTES:
- 1) ALL ELEVATIONS ARE TAKEN FROM TOP OF CHECKER PLATE REF ELEV 0'-0".
 - 2) FOR PIPING SURFACE PREPARATION AND PAINT NOTES SEE INSTRUMENT LIST.
 - 3) SHOP SUPPORT ALL PIPING AS REQUIRED.
 - 4) ALL PIPING UNDER 2" NPS IS SHOWN FOR REFERENCE ONLY.
 - 5) TOTAL APPROXIMATE PACKAGE WEIGHT 92000 lbs (41818 kgs).