


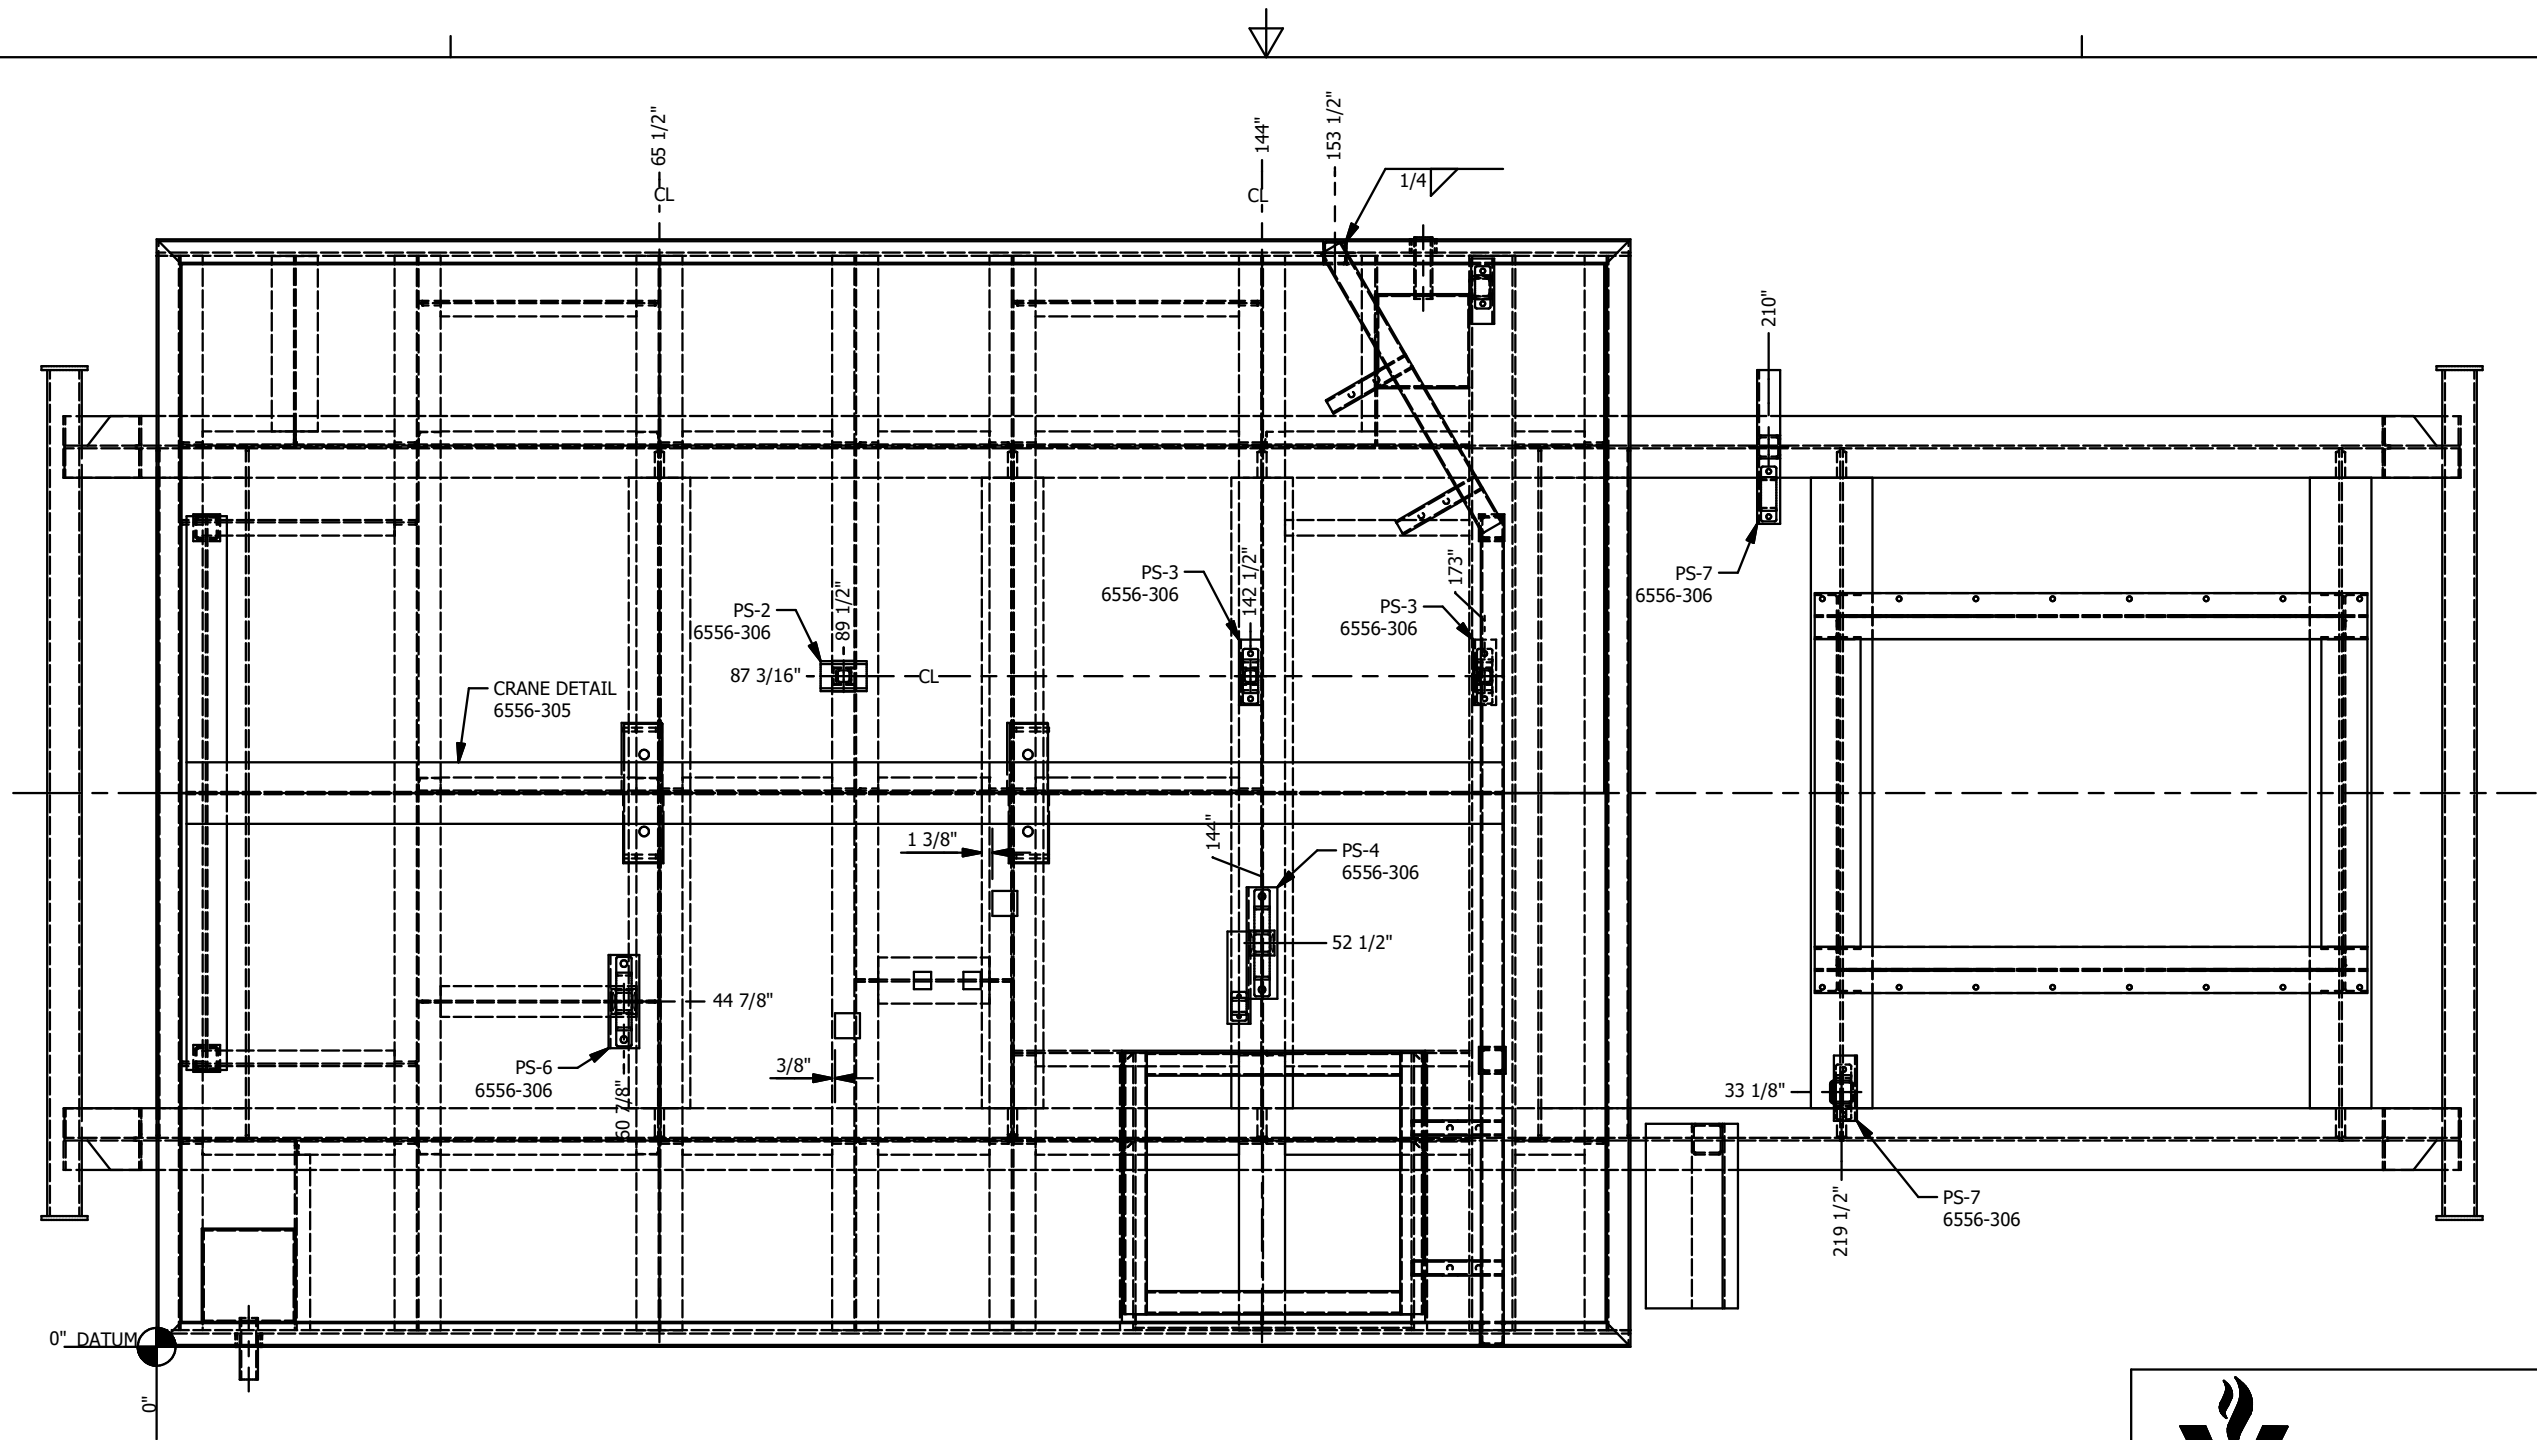

						SIGN	DATE
DRAWING APPROVAL			DATE	MATERIAL RELEASE	PURCHASING (COMPLETE)		
	ENGINEERING MANAGER				QC (MATERIALS CONFORMANCE)		
	PRODUCTION MANAGER				QC (PARTIAL RELEASE)		
	QC (DRAWING CONFORMANCE)				QC (FINAL SIGN OFF)		



CANADIAN NATURAL RESOURCES LTD.

SMITH OIL GAS CONSERVATION
VAPOR RECOVERY PACKAGE

SKID LAYOUT - PIPE & CRANE SUPPORTS

DRAWN BY	MM/DD/YY	DRAWN NO.	REV
EB	03/23/23	6556-304	2

GENERAL NOTES

NOTE:
1. PIPE SUPPORT AND CRANE BILL OF MATERIAL ON 6556-305.

UNITS C - F ONLY

TYPICAL MARKS
■ POST LOCATION
CL CENTER LINE

TYPICAL DIMENSION
1'-7.56" FEET / INCHES
[497] MILIMETERS (IF SHOWN)

TYPICAL DETAIL / SECTION MARKING
1
302
DETAIL /SECTION
DWG. REF.

THIS DRAWING AND ANY DESIGNS SHOWN ARE THE CONFIDENTIAL PROPERTY OF VAPORTECH ENERGY SERVICES INC. AND MUST NOT BE USED, COPIED OR COMMUNICATED IN ANY FORM WITHOUT THE EXPRESS WRITTEN CONSENT OF VAPORTECH.
2018 VAPORTECH ENERGY SERVICES.

REVISIONS

REV	DESCRIPTION	MM/DD/YY	BY	CHK'D
2	AS BUILT	03/20/24	EB	JC
1	ISSUED FOR CONSTRUCTION	04/19/23	EB	JC
0	ISSUED FOR REVIEW	03/27/23	EB	JC
REV	DESCRIPTION	MM/DD/YY	BY	CHK'D