



# **BUILDING DETAILS**


1. ROOF:  
EXTERIOR: 22 Gs. PREPARED (BLUE)  
INTERIOR: 24 Gs WHITE FLUTED ALUMINUM  
INSULATION: R-20 FIBREGLASS  
VAPOUR: 6 MIL POLY
2. WALLS:  
EXTERIOR: 22 Gs. PREPARED (BLUE)  
INTERIOR: 24 Gs WHITE FLUTED ALUMINUM  
INSULATION: R-12 FIBREGLASS  
VAPOUR: 6 MIL POLY
3. TRIM & FLASHING: 22 Gs. PREPARED (GOLD)
4. (1) 6'-0" x 7'-0" INSULATED MAN DOOR c/w  
-PANE HARDWARE  
-2) SINGLE GLAZED FIXED L.W.G. WINDOW  
-WEATHERSTRIPPING, CANOPY, THRESHOLD & CHECK CHAIN  
-DOOR RAISED 1" TO ACCOMMODATE DRIP UP
5. (1) 3'-0" x 7'-0" INSULATED MAN DOOR c/w  
-PANE HARDWARE  
-2) SINGLE GLAZED FIXED L.W.G. WINDOW  
-WEATHERSTRIPPING, CANOPY, THRESHOLD & CHECK CHAIN  
-DOOR RAISED 1" TO ACCOMMODATE DRIP UP
6. (2) 34" x 34" DOUBLE GLAZED SLIDING WINDOW c/w SCREEN
7. (2) 18" x 18" ADJUSTABLE LOUVERS c/w SCREEN & WEATHERHOOD
8. (1) ET18-1 EXPLOSION PROOF EXHAUST FAN w/ HOOD
9. (2) 34" EXHAUSTS WITH DOWNSPOUTS
10. (1) 34" ICE DRAIN
11. TOTAL PACKAGE SHIPPING WEIGHT: 24,000 LBS
12. SHIPPING DIMENSIONS: 21'-2" W x 13'-0" H x 34'-8" LG

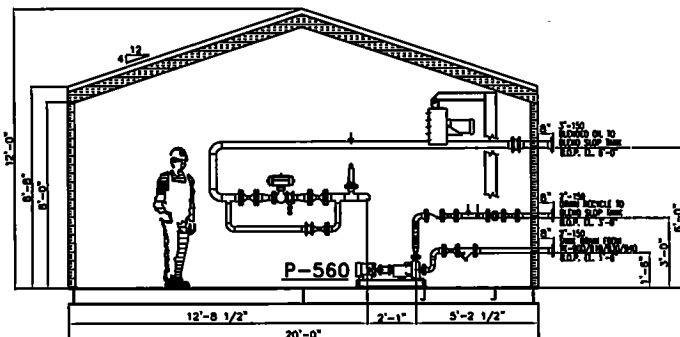


VIEW A-A

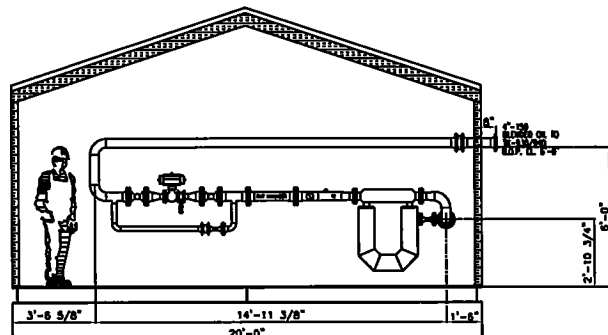


VIEW B-B

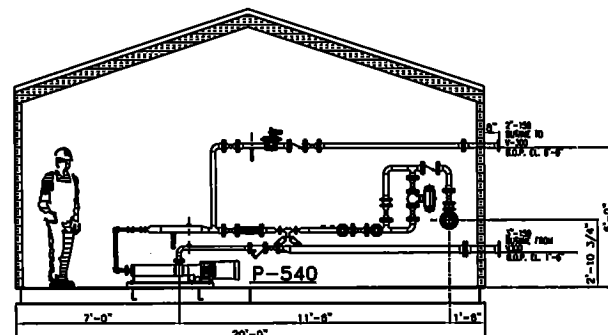


VIEW C-C

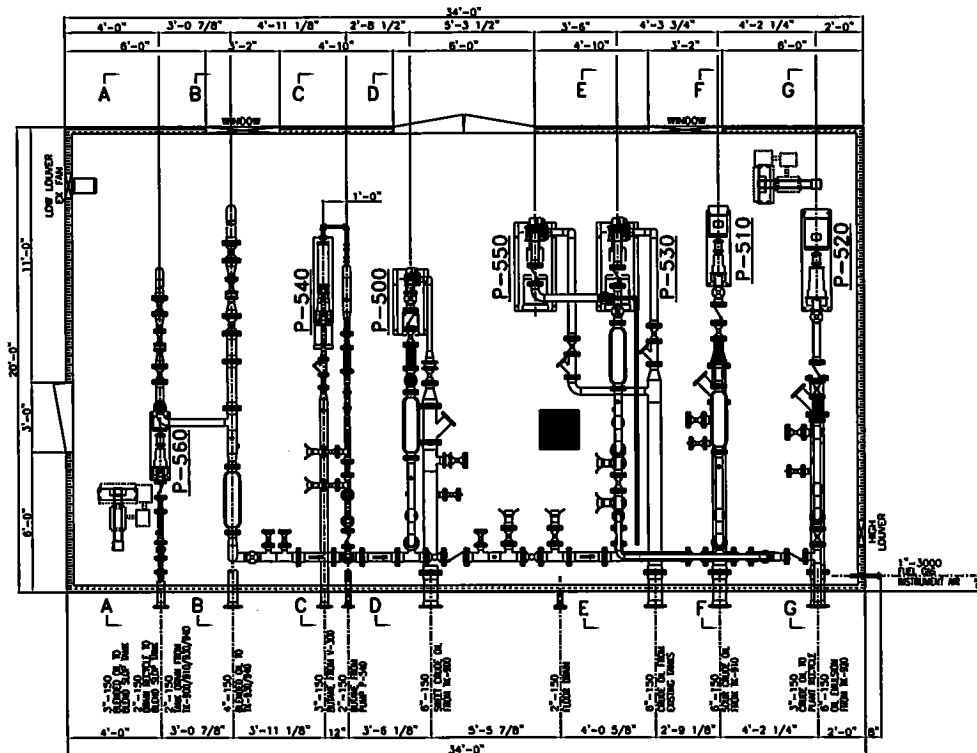


PLAN VIEW

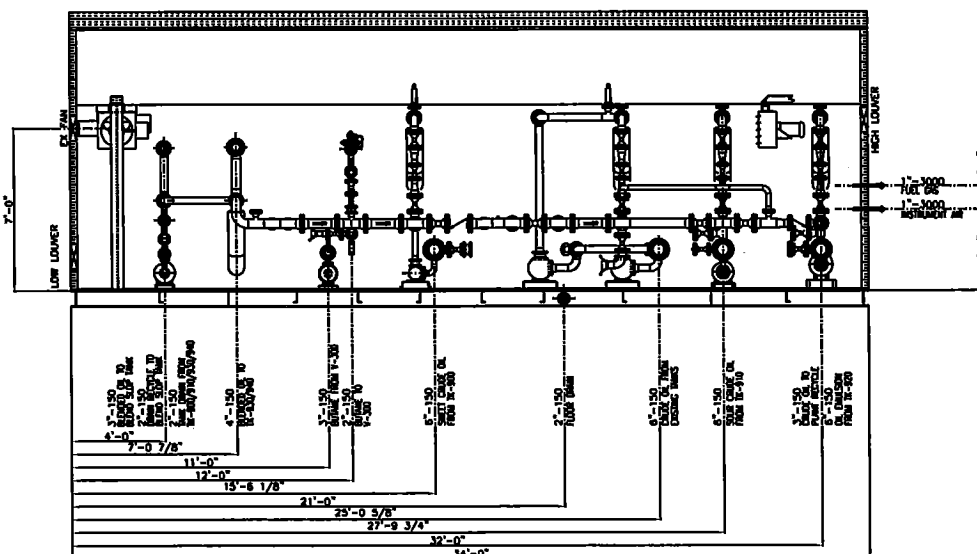


ELEVATION VIEW

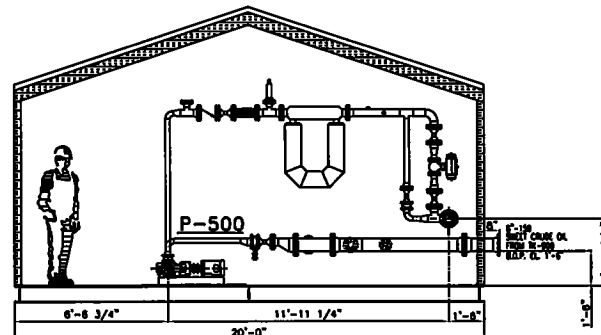


VIEW D-D

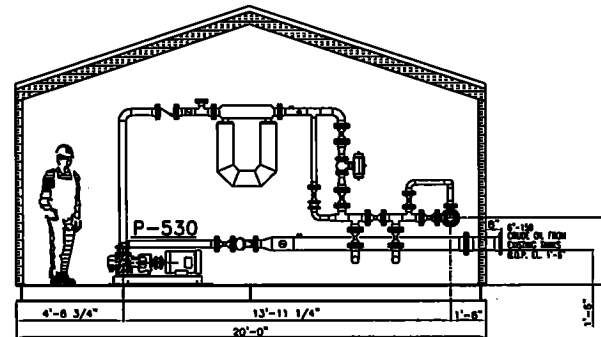

VIEW E-E

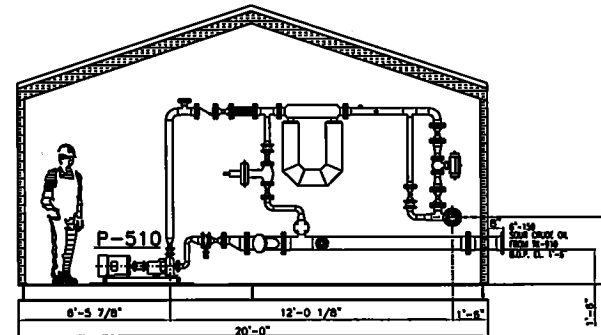

VIEW F-F

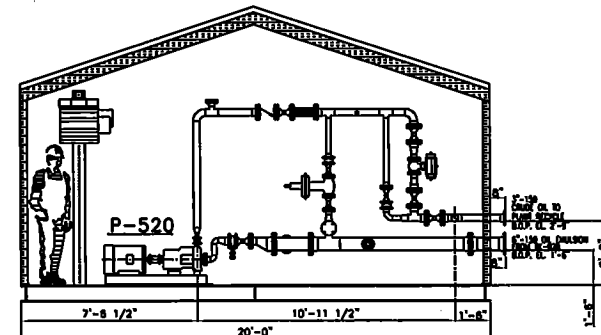

VIEW G-G

| REV. NO. | DATE     | REVISION                       | BY  | CHK'D | APP'D |
|----------|----------|--------------------------------|-----|-------|-------|
| A        | 12/10/09 | ISSUED FOR APPROVAL            | JAH |       |       |
| B        | 12/21/09 | REVISED AS PER CLIENT MARK-UPS | JAH |       |       |
| C        | 12/29/09 | REVISED AS PER CLIENT MARK-UPS | JAH |       |       |
| D        | 01/14/10 | ISSUED FOR FABRICATION         | JAH |       | JAM   |
| 1        | 02/03/10 | ADDED SPACER RINGS             | JAH |       | JAM   |
| 2        | 02/12/10 | REVISED P-520 SUCTION PIPING   | JAH |       | JAM   |
| 3        | 03/23/10 | AS BUILT                       | JAH |       | JAM   |

**BILTON**  
Welding & Manufacturing Ltd.  
BOX 6106  
5815 37 Street  
DUNSMITH, AB  
CANADA  
403-227-7799  
1-888-227-4923  
FAX 403-227-7796

**BARRICK ENERGY INC.**  
PUMP AND BLENDING SKID - TAG SK-500  
GENERAL ARRANGEMENT  
DATE: 12/07/09  
SHEET: 1 OF 5  
JOB ORDER: D1216  
DRAWING NO.: C969-1  
REV. 2

CERTIFIED  
AS BUILT


CERTIFIED  
AS BUILT

## BILL OF MATERIALS


| ITEM | QTY | REF.        | PART No. | DESCRIPTION                                                              | MATERIAL   | WEIGHT |
|------|-----|-------------|----------|--------------------------------------------------------------------------|------------|--------|
| 1    | 2   | MAIN        | 1-003664 | W8@18 x 34'-0" LG                                                        | G40.21-SOW | 1224#  |
| 2    | 2   | MAIN        | 1-003664 | W8@18 x 6'-5 3/4" LG (SEE COPE DETAIL #1)                                | G40.21-SOW | 234#   |
| 3    | 1   | MAIN        | 1-003664 | W8@18 x 20'-6 1/2" LG (SEE COPE DETAIL #1)                               | G40.21-SOW | 370#   |
| 4    | 4   | MAIN        | 1-003664 | W8@18 x 19'-6 1/2" LG (SEE COPE DETAIL #1)                               | G40.21-SOW | 1407#  |
| 5    | 18  | CROSSBRACE  | 1-000399 | C6@8.2 x 9'-9 1/8" LG (SEE COPE DETAIL #2)                               | G40.21-SOW | 1440#  |
| 6    | 3   | CROSSBRACE  | 1-000399 | C6@8.2 x 3'-6 1/4" LG (SEE COPE DETAIL #2)                               | G40.21-SOW | 88#    |
| 7    | 3   | CROSSBRACE  | 1-000399 | C6@8.2 x 2'-7" LG                                                        | G40.21-SOW | 66#    |
| 8    | 2   | CROSSBRACE  | 1-000399 | C6@8.2 x 3'-4" LG                                                        | G40.21-SOW | 55#    |
| 9    | 1   | CROSSBRACE  | 1-000399 | C6@8.2 x 1'-8" LG                                                        | G40.21-SOW | 14#    |
| 10   | 2   | CROSSBRACE  | 1-000399 | C6@8.2 x 3'-2 1/2" LG (SEE COPE DETAIL #2)                               | G40.21-SOW | 52#    |
| 11   | 3   | CROSSBRACE  | 1-000399 | C6@8.2 x 3'-3" LG (SEE COPE DETAIL #2&3)                                 | G40.21-SOW | 80#    |
| 12   | 4   | LIFT LUG    | 2-000378 | 1/2" THK x 6" W x 12" LONG (SEE DETAIL)                                  | SA-36      | 20#    |
| 13   | 4   | FLOOR       | 1-009866 | 3/16" THK CHECKERPLATE 5'-0" W x 16'-8 1/2" LG (SEE BREAK DETAIL #1)     | SA-36      | 2560#  |
| 14A  | 2   | FLOOR       | 1-009867 | 3/16" THK CHECKERPLATE 4'-8 1/2" W x 16'-8 1/2" LG (SEE BREAK DETAIL #2) | SA-36      | 1205#  |
| 14B  | 2   | FLOOR       | 1-009868 | 3/16" THK CHECKERPLATE 4'-8 1/2" W x 16'-8 1/2" LG (SEE BREAK DETAIL #2) | SA-36      | 1205#  |
| 15   | 3   | TRIP LIP    | 2-000536 | 1/4" CHECKER PLATE 1" H x 3'-0" LG TRIP LIP                              | SA-36      | 45#    |
| 16   | 2   | FLOOR DRAIN | 1-000016 | 1/4" THK x 1 1/4" ANGLE x 1'-8" LG                                       | SA-36      | 3#     |
| 17   | 1   | FLOOR DRAIN | 2-000659 | SUMP BOTTOM 3/16" THK x 22" W x 22" LG                                   | SA-36      | 12#    |
| 18   | 1   | FLOOR DRAIN | 1-000096 | 1 1/4" x 3/16" SERRATED BARGRATE x 1'-7" W x 1'-7 1/2" LG                | SA-36      | 20#    |
| 19   | 1   | FLOOR DRAIN | 1-000877 | 2" x CLASS 150 RFWN FLG SCH XH                                           | SA-105-N   | 6#     |
| 20   | 1   | FLOOR DRAIN | 1-003358 | 2" PIPE SCH XH x 6'-8" LG (BOE,ROE)                                      | SA-106-B   | 34#    |
| 21   | 2   | HEATER      | 1-002525 | 5" x 0.188" HSS x 8'-4 3/8" LG                                           | G40.21-SOW | 188#   |
| 22   | 2   | HEATER      | 1-002524 | 4" x 0.375" HSS x 2'-3 1/4" LG (SEE DETAIL)                              | SA-36      | 76#    |
| 23   | 2   | HEATER      | 1-000041 | 4" x 4" x 3/8" ANGLE x 8" LG (SEE DETAIL)                                | SA-36      | 8#     |
| 24   | 2   | HEATER      | 1-000052 | 6" x 4" x 3/8" ANGLE x 1'-8" LG (SEE DETAIL)                             | SA-36      | 36#    |
| 25   | 2   | BOLT        | 1-000220 | 3/4" DIA x 2" LG BOLT                                                    | GR.5       | -      |
| 26   | 8   | BOLT        | 1-000207 | 5/8" DIA x 2" LG BOLT                                                    | GR.5       | -      |
| 27   | 2   | BOLT        | 1-001800 | 3/4" DIA NUT                                                             | GR.5       | -      |
| 28   | 8   | BOLT        | 1-001898 | 5/8" DIA NUT                                                             | GR.5       | -      |
| 29   | 1   | PUMP BASE   | 2-001452 | P-500 PUMP BASE 1/2" THK x 19 1/2" W x 35 1/2" LG                        | SA-36      | 92#    |
| 30   | 1   | PUMP BASE   | 2-001453 | P-510 PUMP BASE 1/2" THK x 14" W x 41" LG                                | SA-36      | 82#    |
| 31   | 1   | PUMP BASE   | 2-001454 | P-520 PUMP BASE 1/2" THK x 17" W x 54" LG                                | SA-36      | 130#   |
| 32   | 2   | PUMP BASE   | 2-001455 | P-530/550 PUMP BASE 1/2" THK x 23" W x 47 1/2" LG                        | SA-36      | 310#   |
| 33   | 1   | PUMP BASE   | 2-001456 | P-560 PUMP BASE 1/2" THK x 12" W x 37" LG                                | SA-36      | 62#    |
| 34   | 1   | PUMP BASE   | 2-001457 | P-540 PUMP BASE 1/2" THK x 11" W x 45" LG                                | SA-36      | 70#    |
| 35   | 1   | PUMP BASE   | 1-000404 | P-540 PUMP BASE C10@15.3 x 44" LG                                        | G40.21-SOW | 56#    |
| 36   | 1   | CROSSBRACE  | 1-000398 | C5@6.7 x 2'-3" LG (SEE COPE DETAIL #2,4)                                 | G40.21-SOW | 15#    |
| 37   | 1   | CROSSBRACE  | 1-000398 | C5@6.7 x 1'-4" LG                                                        | G40.21-SOW | 9#     |
| 38   | 1   | CROSSBRACE  | 1-000398 | C5@6.7 x 3'-1 3/4" LG (SEE COPE DETAIL #4)                               | G40.21-SOW | 21#    |
| 39   | 1   | CROSSBRACE  | 1-000398 | C5@6.7 x 1'-7 1/4" LG (SEE COPE DETAIL #2)                               | G40.21-SOW | 11#    |

## GENERAL NOTES


- WELD PROCEDURE: GM-1/MC-1
- SANDBLAST: SSPC-SP6 (COMMERCIAL)
- PRIME: ONE (1) COAT PRIMER
- PAINT: ONE (1) COAT INDUSTRIAL ENAMEL (WARM GREY)
- 1 1/2" SPRAY FOAM INSULATION U/S OF CHECKERPLATE
- APPROXIMATE WEIGHT: 12,000 LBS

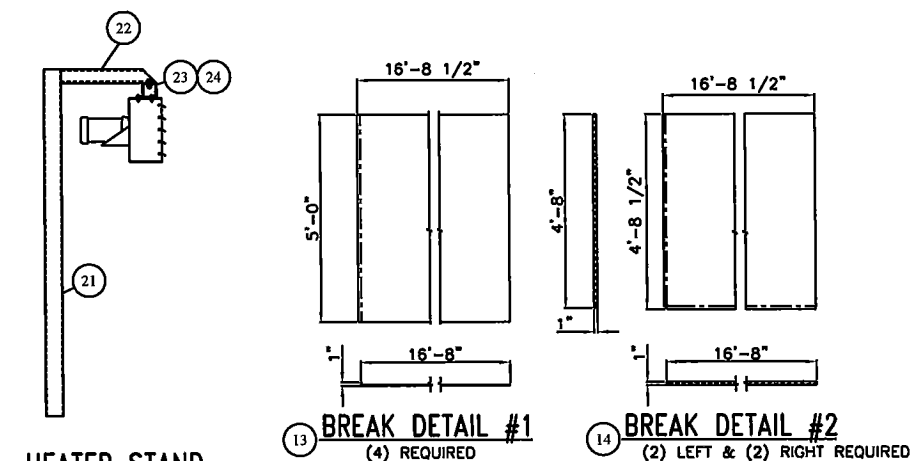


## PLAN VIEW

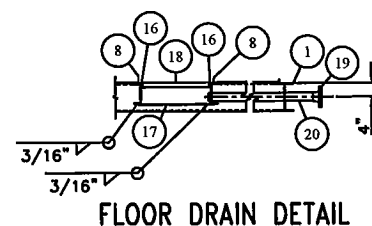


FLOOR DRAIN DETAIL

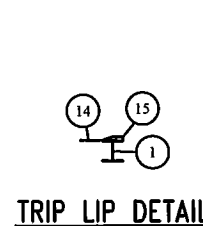


TRIP LIP DETAIL

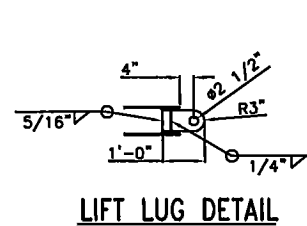


LIFT LUG DETAIL

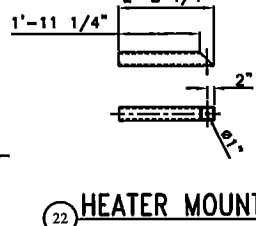


HEATER MOUNT

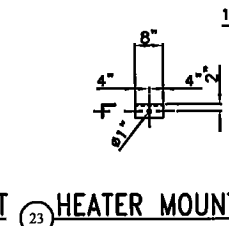


HEATER MOUNT

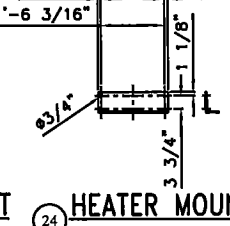


HEATER MOUNT

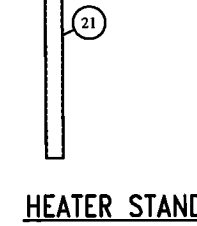


HEATER STAND

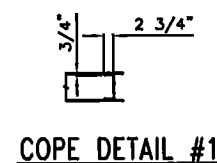


COPE DETAIL #1

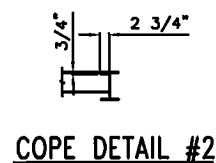

COPE DETAIL #2

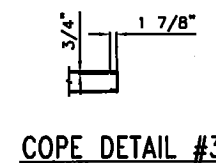

COPE DETAIL #3

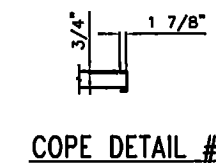

COPE DETAIL #4

| REV. NO. | DATE     | REVISION                       | BY  | APP'D |
|----------|----------|--------------------------------|-----|-------|
| A        | 12/10/09 | ISSUED FOR APPROVAL            | JAH |       |
| B        | 12/29/09 | REVISED AS PER CLIENT MARK-UPS | JAH |       |
| O        | 01/14/10 | ISSUED FOR FABRICATION         | JAH | JAM   |
| 1        | 03/22/10 | AS BUILT                       | JAH |       |

**BILTON**  
Welding & Manufacturing Ltd.  
BOX 6106  
5815 37 Street  
INNISFAIR, AB  
CANADA  
403-227-7799  
1-888-227-4923  
FAX 227-7796






This drawing is property of BILTON WELDING & MANUFACTURING LTD and is loaned to the recipient for their confidential use only. In consideration of the loan of this drawing, the recipient promises and agrees that it shall not be used in any way detrimental to the interests of BILTON WELDING & MANUFACTURING LTD, that it shall be returned upon request, and shall not be reproduced, copied, lent, or otherwise disposed of, directly or indirectly, without the written consent of BILTON WELDING & MANUFACTURING LTD.

| BARRICK ENERGY INC.                 |                    |      |
|-------------------------------------|--------------------|------|
| PUMP AND BLENDING SKID - TAG SK-500 |                    |      |
| SKID DETAIL                         |                    |      |
| DATE: 12/10/09                      | SALE ORDER: 001723 |      |
| SHEET: 2 OF 5                       | JOB ORDER:         | SIZE |
| DRAWN BY: JAH                       | D1216              | D    |
| PURCHASE ORDER: 71049P-028          | DRAWING NO.:       | REV. |
| LOCATION: 02-02-069-22 W5M          | C969-2             | 1    |
| APP'D BY: JAM                       |                    |      |



## GENERAL NOTES

- QUALITY CONTROL PROGRAM NUMBER: AQP-1317(S)
- WELDING PROCEDURE REGISTRATION NUMBER: WP1970.2
- WELD PROCEDURE:  
A1S SPOOLS (REG TEMP) = BWM-1 (GMAW)  
A2S SPOOLS (LOW TEMP) = BWM-15 (GMAW)
- PIPING SPECIFICATIONS:  
SPOOLS 1 (LOW TEMP)  
DESIGN & FABRICATED TO: B31.3 - 2008 ED. NFS &  
S.A.W. ENGINEERING LTD. PIPING SPECIFICATION A2S  
DESIGN PRESSURE: 285 PSI @ 100°F/-49°F  
C.A.: 1/8"  
RADIOGRAPHY: 100% BUTT WELDS  
10% SW FOR FIT UP  
MPI: 100% OF ALL FILLET WELDS  
PWHT: NIL  
IMPACT: EXEMPT AS PER TABLE 323.2.2  
HYDRO TEST: 428 PSIG  
SPOOLS 2-30  
DESIGN & FABRICATED TO: B31.3 - 2008 ED. NFS &  
S.A.W. ENGINEERING LTD. PIPING SPECIFICATION A1S  
DESIGN PRESSURE: 285 PSI @ 100°F/-20°F  
C.A.: 1/8"  
RADIOGRAPHY: 100% BUTT WELDS  
10% SW FOR FIT UP  
MPI: 100% OF ALL FILLET WELDS  
PWHT: NIL  
IMPACT: EXEMPT AS PER TABLE 323.2.2  
HYDRO TEST: 428 PSIG
- EXTERNAL FINISH  
SANDBLAST: SSPC-SP6 (COMMERCIAL)  
PRIME: ONE (1) COAT PRIMER  
FINISH: ONE (1) COAT INDUSTRIAL ENAMEL (WARM GREY)

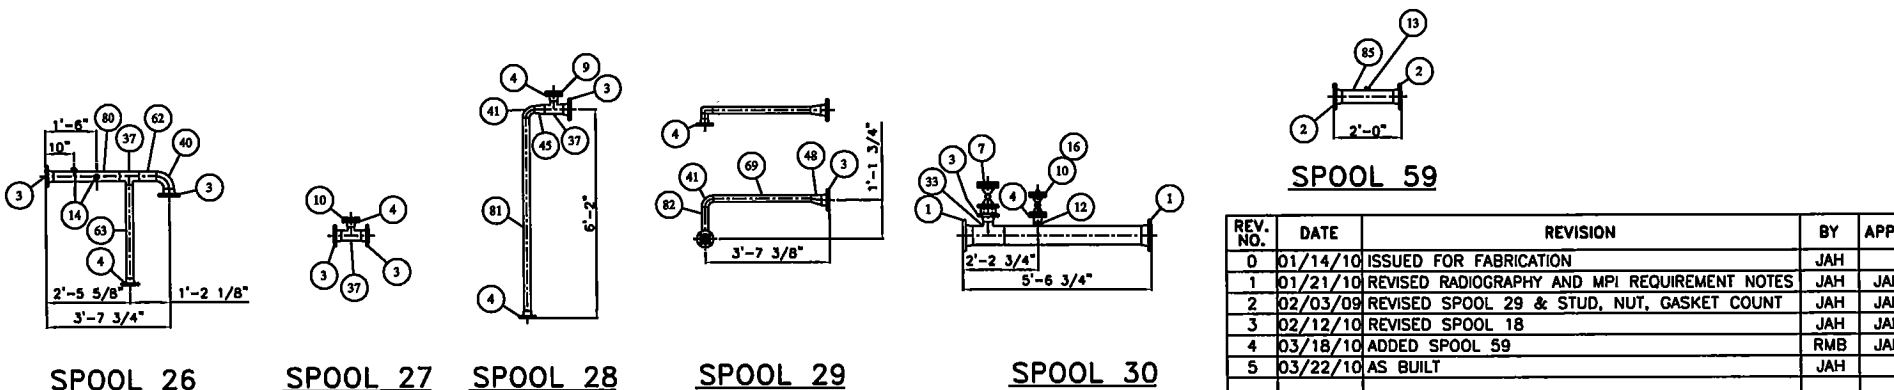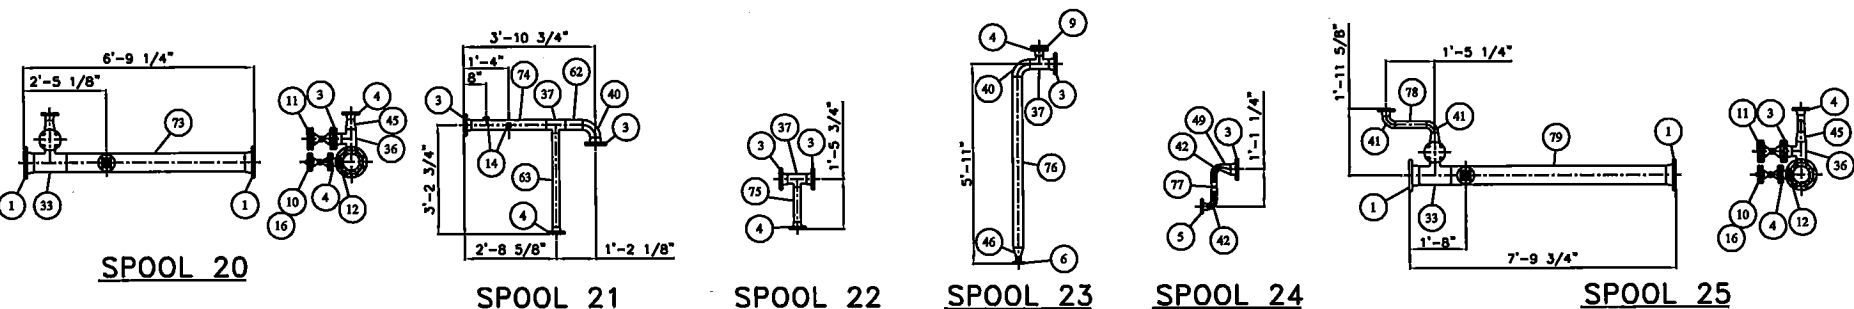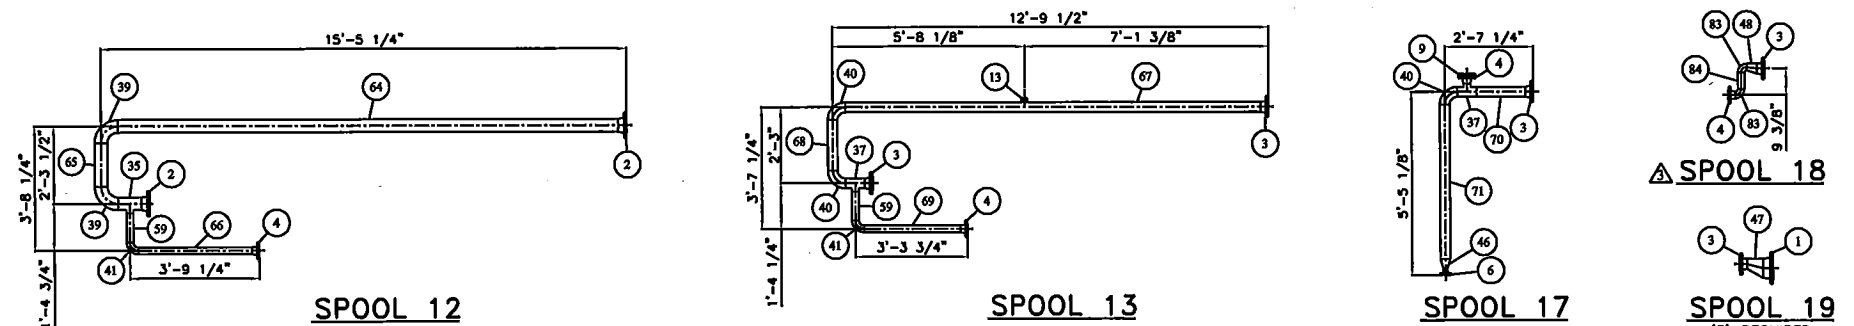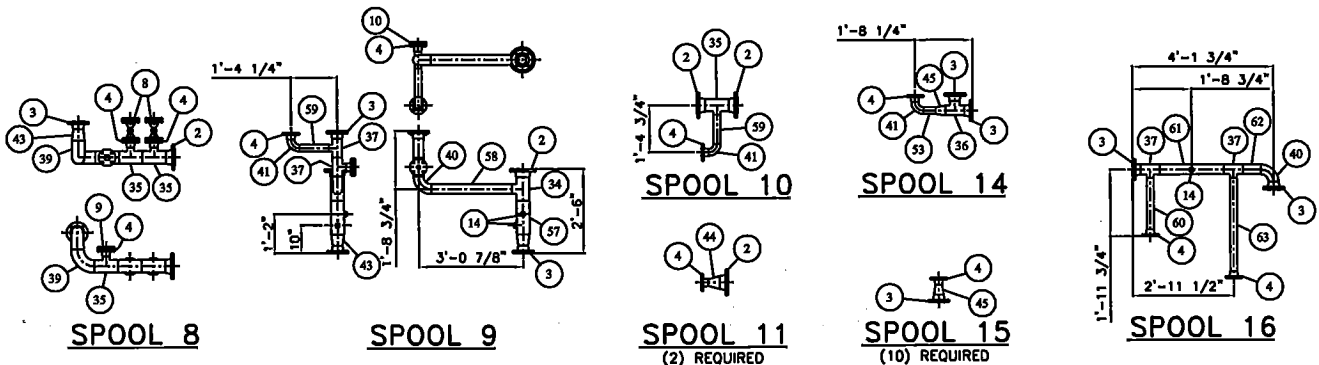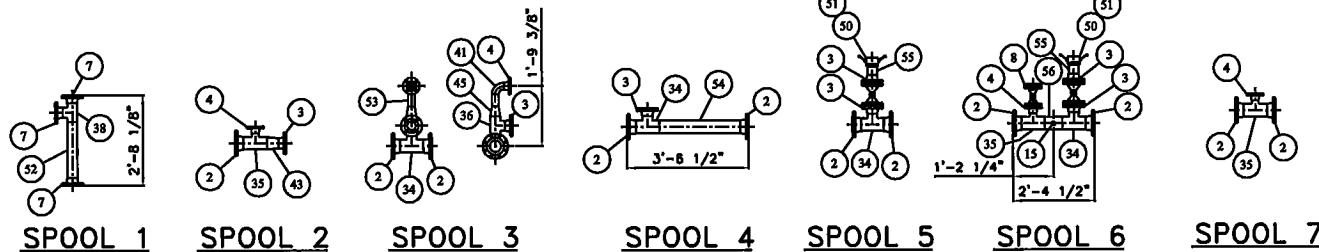

| REV. NO. | DATE     | REVISION                                      | BY  | APP'D |
|----------|----------|-----------------------------------------------|-----|-------|
| 0        | 01/14/10 | ISSUED FOR FABRICATION                        | JAH | JAM   |
| 1        | 01/21/10 | REVISED RADIOGRAPHY AND MPI REQUIREMENT NOTES | JAH | JAM   |
| 2        | 02/03/09 | REVISED SPOOL 29 & STUD, NUT, GASKET COUNT    | JAH | JAM   |
| 3        | 02/12/10 | REVISED SPOOL 18                              | JAH | JAM   |
| 4        | 03/18/10 | ADDED SPOOL 59                                | RMB | JAM   |
| 5        | 03/22/10 | AS BUILT                                      | JAH | JAM   |

**BILTON**  
Welding & Manufacturing Ltd.  
BOX 6106  
5815 37 Street  
INNISFAIR, AB  
CANADA  
403-227-7799  
1-888-227-4923  
FAX 227-7796






**BARRICK ENERGY INC.**  
PUMP AND BLENDING SKID - TAG SK-500  
SPOOLING DETAILS 1 of 2  
DATE: 01/11/09  
SHEET: 4 OF 5  
DRAWN BY: JAH  
PURCHASE ORDER: 71049P-028  
LOCATION: 02-02-069-22 W5M  
APP'D BY: JAM

SALE ORDER: 001723  
JOB ORDER:  
D1216  
DRAWING NO.:  
C969-4  
REV. 5

CERTIFIED  
AS BUILT

# GENERAL NOTES

1. QUALITY CONTROL PROGRAM NUMBER: AQP-1317(S)
2. WELDING PROCEDURE REGISTRATION NUMBER: WP1970.2
3. WELD PROCEDURE:  
A1S SPOOLS (REG TEMP) = BWM-1 (GMAW)  
A2S SPOOLS (LOW TEMP) = BWM-15 (GMAW)
4. PIPING SPECIFICATIONS:  
SPOOLS 51,55,56,57,58 (LOW TEMP)  
DESIGN & FABRICATED TO: B31.3 - 2008 ED. NFS &  
S.A.W. ENGINEERING LTD. PIPING SPECIFICATION A2S  
DESIGN PRESSURE: 285 PSI @ 100°F/-49°F  
C.A.: 1/8"  
RADIOGRAPHY: 100% BUTT WELDS  
10% SW FOR FIT UP  
MPI: 100% OF ALL FILLET WELDS  
PWHT: NIL  
IMPACT: EXEMPT AS PER TABLE 323.2.2  
HYDRO TEST: 428 PSIG  
SPOOLS 31-50,52,53,54  
DESIGN & FABRICATED TO: B31.3 - 2008 ED. NFS &  
S.A.W. ENGINEERING LTD. PIPING SPECIFICATION A1S  
DESIGN PRESSURE: 285 PSI @ 100°F/-20°F  
C.A.: 1/8"  
RADIOGRAPHY: 100% BUTT WELDS  
10% SW FOR FIT UP  
MPI: 100% OF ALL FILLET WELDS  
PWHT: NIL  
IMPACT: EXEMPT AS PER TABLE 323.2.2  
HYDRO TEST: 428 PSIG
5. EXTERNAL FINISH  
SANDBLAST: SSPC-SP6 (COMMERCIAL)  
PRIME: ONE (1) COAT PRIMER  
FINISH: ONE (1) COAT INDUSTRIAL ENAMEL (WARM GREY)

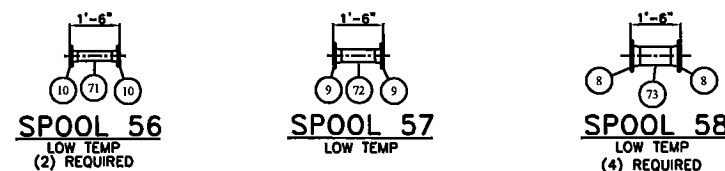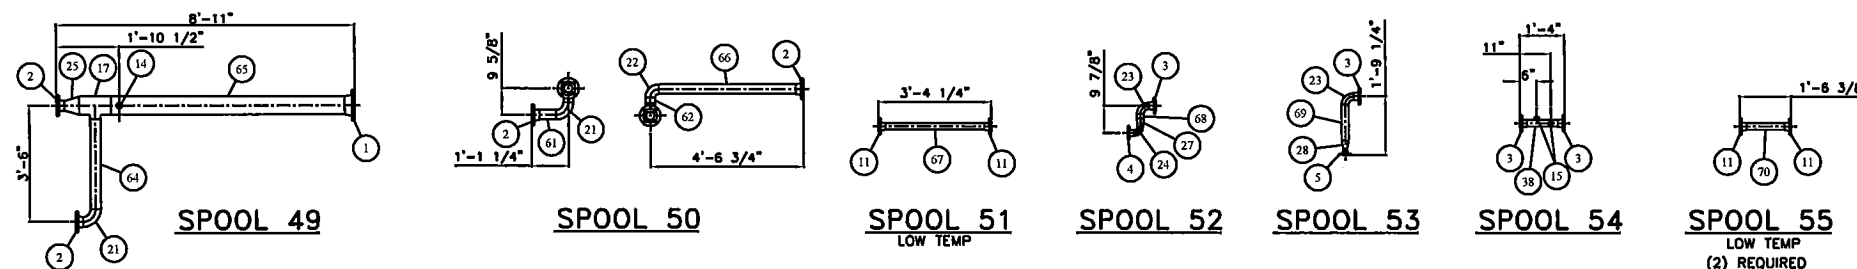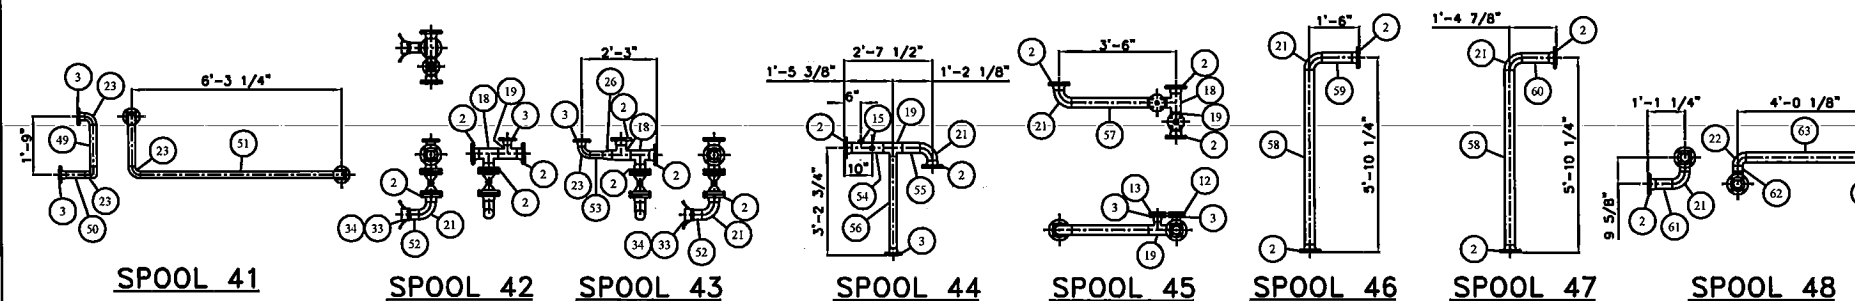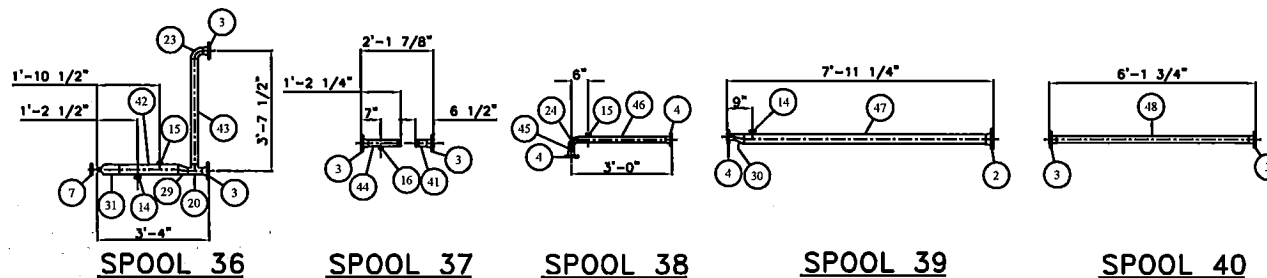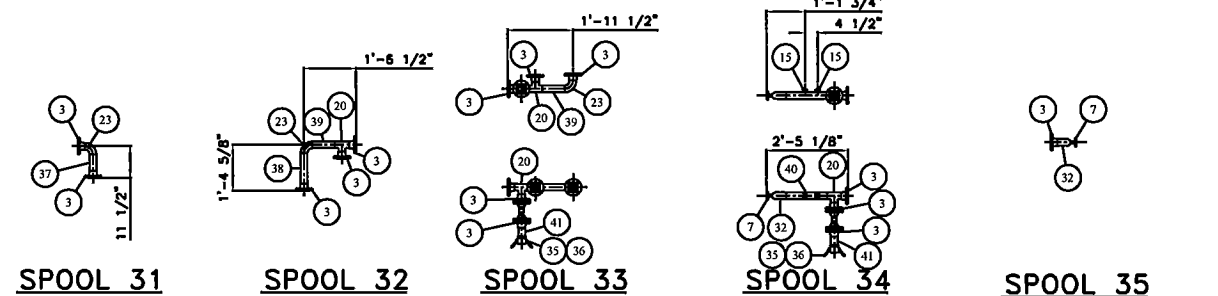

# BILL OF MATERIALS

| ITEM | QTY | REF. | PART No. | DESCRIPTION                                               | MATERIAL   | WEIGHT |
|------|-----|------|----------|-----------------------------------------------------------|------------|--------|
| 1    | 1   | -    | 1-000927 | 6" x CLASS 150 RFWN FLG SCH STD                           | SA-105-N   | 24#    |
| 2    | 24  | -    | 1-000896 | 3" x CLASS 150 RFWN FLG SCH STD                           | SA-105-N   | 240#   |
| 3    | 32  | -    | 1-000877 | 2" x CLASS 150 RFWN FLG SCH XH                            | SA-105-N   | 192#   |
| 4    | 4   | -    | 1-003970 | 1 1/2" x CLASS 150 RFWN FLG SCH XH                        | SA-105-N   | 16#    |
| 5    | 1   | -    | 1-000859 | 1" x CLASS 150 RFWN FLG SCH XH                            | SA-105-N   | 3#     |
| 6    | 1   | -    | 1-000857 | 1" x CLASS 150 RFTO FLG                                   | SA-105-N   | 2#     |
| 7    | 2   | -    | 1-009008 | 1/2" x CLASS 150 RFTO FLG                                 | SA-105-N   | 4#     |
| 8    | 8   | -    | 1-000989 | 6" x CLASS 150 RFWN FLG SCH STD                           | SA-350-LF2 | 192#   |
| 9    | 2   | -    | 1-000984 | 4" x CLASS 150 RFWN FLG SCH STD                           | SA-350-LF2 | 30#    |
| 10   | 4   | -    | 1-001257 | 3" x CLASS 150 RFWN FLG SCH STD                           | SA-350-LF2 | 40#    |
| 11   | 6   | -    | 1-000975 | 2" x CLASS 150 RFWN FLG SCH XH                            | SA-350-LF2 | 36#    |
| 12   | 1   | -    | 1-004736 | 2" x CLASS 150 RF HUB BLIND, TAPPED TO 1 1/2" NPT         | SA-105-N   | 4#     |
| 13   | 1   | -    | 1-000623 | 2" x CLASS 150 RF HUB BLIND, TAPPED TO 1" NPT             | SA-105-N   | 4#     |
| 14   | 3   | -    | 1-003322 | 1" on 3"-36" x CLASS 3000 THREAD-O-LET                    | SA-105-N   | 6#     |
| 15   | 8   | -    | 1-007396 | 3/4" on 1 1/2"-36" x CLASS 3000 THREAD-O-LET              | SA-105-N   | 8#     |
| 16   | 1   | -    | 1-003318 | 1/2" on 2" x CLASS 3000 THREAD-O-LET                      | SA-105-N   | 1#     |
| 17   | 1   | -    | 1-008676 | 6" x 3" RED TEE SCH STD                                   | SA-234-WPB | 20#    |
| 18   | 4   | -    | 1-002978 | 3" TEE SCH STD                                            | SA-234-WPB | 19#    |
| 19   | 4   | -    | 1-002976 | 3" x 2" RED TEE SCH XH (SCARF 3" TO SCH STD)              | SA-234-WPB | 31#    |
| 20   | 5   | -    | 1-002974 | 2" TEE SCH XH                                             | SA-234-WPB | 10#    |
| 21   | 9   | -    | 1-000684 | 3" x 90° LR BW ELBOW SCH STD                              | SA-234-WPB | 34#    |
| 22   | 2   | -    | 1-000685 | 3" x 90° SR BW ELBOW SCH STD                              | SA-234-WPB | 9#     |
| 23   | 10  | -    | 1-000676 | 2" x 90° LR BW ELBOW SCH XH                               | SA-234-WPB | 33#    |
| 24   | 2   | -    | 1-006167 | 1 1/2" x 90° LR BW ELBOW SCH XH                           | SA-234-WPB | 4#     |
| 25   | 1   | -    | 1-000456 | 6" x 3" RED CONC SCH STD                                  | SA-234-WPB | 15#    |
| 26   | 1   | -    | 1-000448 | 3" x 2" RED CONC SCH XH (SCARF 3" TO SCH STD)             | SA-234-WPB | 6#     |
| 27   | 1   | -    | 1-003988 | 2" x 1 1/2" RED CONC SCH XH                               | SA-234-WPB | 3#     |
| 28   | 1   | -    | 1-004781 | 2" x 1" RED CONC SCH XH                                   | SA-234-WPB | 3#     |
| 29   | 1   | -    | 1-008310 | 3" x 2" ECC RED SCH XH (SCARF 3" TO SCH STD)              | SA-234-WPB | 3#     |
| 30   | 1   | -    | 1-009865 | 3" x 1 1/2" ECC RED SCH XH (SCARF 3" TO SCH STD)          | SA-234-WPB | 2#     |
| 31   | 1   | -    | 1-009863 | 3" x 1" SWAGE NIPPLE SCH 160 (BXT) (SCARF 3" TO SCH STD)  | SA-234-WPB | 3#     |
| 32   | 2   | -    | 1-009861 | 2" x 1/2" SWAGE NIPPLE SCH XXH (BXT) (SCARF 2" TO SCH XH) | SA-234-WPB | 3#     |
| 33   | 2   | -    | 1-000312 | 3" MALE x FNPT CAMLOCK                                    | ALUMINUM   | 3#     |
| 34   | 2   | -    | 1-000304 | 3" CAMLOCK CAP                                            | ALUMINUM   | 3#     |
| 35   | 2   | -    | 1-000310 | 2" MALE x FNPT CAMLOCK                                    | ALUMINUM   | 3#     |
| 36   | 2   | -    | 1-000303 | 2" CAMLOCK CAP                                            | ALUMINUM   | 3#     |
| 37   | 1   | -    | 1-003358 | 2" PIPE SCH XH x 5 3/4" LG (BBE)                          | SA-106-B   | 1#     |
| 38   | 2   | -    | 1-003358 | 2" PIPE SCH XH x 10 7/8" LG (BBE)                         | SA-106-B   | 4#     |
| 39   | 2   | -    | 1-003358 | 2" PIPE SCH XH x 7 7/8" LG (BBE)                          | SA-106-B   | 4#     |
| 40   | 1   | -    | 1-003358 | 2" PIPE SCH XH x 1'-2 1/2" LG (BBE)                       | SA-106-B   | 6#     |
| 41   | 3   | -    | 1-003358 | 2" PIPE SCH XH x 4" LG (BOE,TOE)                          | SA-106-B   | 6#     |
| 42   | 1   | -    | 1-003363 | 3" PIPE SCH STD x 1'-8 3/4" LG (BBE)                      | SA-106-B   | 12#    |
| 43   | 1   | -    | 1-003358 | 2" PIPE SCH XH x 3'-1 3/4" LG (BBE)                       | SA-106-B   | 16#    |
| 44   | 1   | -    | 1-003358 | 2" PIPE SCH XH x 11 5/8" LG (BOE,TOE)                     | SA-106-B   | 3#     |
| 45   | 1   | -    | 1-003354 | 1 1/2" PIPE SCH XH x 1 5/8" LG (BBE)                      | SA-106-B   | 1#     |
| 46   | 1   | -    | 1-003354 | 1 1/2" PIPE SCH XH x 2'-7" LG (BBE)                       | SA-106-B   | 4#     |
| 47   | 1   | -    | 1-003363 | 3" PIPE SCH STD x 3'-2 1/4" LG (BBE)                      | SA-106-B   | 12#    |
| 48   | 1   | -    | 1-003358 | 2" PIPE SCH XH x 5'-8 1/2" LG (BBE)                       | SA-106-B   | 28#    |
| 49   | 1   | -    | 1-003358 | 2" PIPE SCH XH x 1'-2 3/4" LG (BBE)                       | SA-106-B   | 6#     |
| 50   | 1   | -    | 1-003358 | 2" PIPE SCH XH x 6 3/8" LG (BBE)                          | SA-106-B   | 1#     |
| 51   | 1   | -    | 1-003358 | 2" PIPE SCH XH x 5'-9" LG (BBE)                           | SA-106-B   | 30#    |
| 52   | 2   | -    | 1-003363 | 3" PIPE SCH STD x 4" LG (BOE,TOE)                         | SA-106-B   | 3#     |
| 53   | 1   | -    | 1-003358 | 2" PIPE SCH XH x 4" LG (BBE)                              | SA-106-B   | 2#     |
| 54   | 1   | -    | 1-003363 | 3" PIPE SCH STD x 11" LG (BBE)                            | SA-106-B   | 6#     |
| 55   | 1   | -    | 1-003363 | 3" PIPE SCH STD x 6" LG (BBE)                             | SA-106-B   | 4#     |
| 56   | 1   | -    | 1-003358 | 2" PIPE SCH XH x 2'-9" LG (BBE)                           | SA-106-B   | 14#    |
| 57   | 1   | -    | 1-003363 | 3" PIPE SCH STD x 2'-3 1/8" LG (BBE)                      | SA-106-B   | 18#    |
| 58   | 2   | -    | 1-003363 | 3" PIPE SCH STD x 5'-2 3/4" LG (BBE)                      | SA-106-B   | 72#    |
| 59   | 1   | -    | 1-003363 | 3" PIPE SCH STD x 10 3/4" LG (BBE)                        | SA-106-B   | 6#     |
| 60   | 1   | -    | 1-003363 | 3" PIPE SCH STD x 9 3/8" LG (BBE)                         | SA-106-B   | 6#     |
| 61   | 2   | -    | 1-003363 | 3" PIPE SCH STD x 5 3/4" LG (BBE)                         | SA-106-B   | 8#     |
| 62   | 2   | -    | 1-003363 | 3" PIPE SCH STD x 1 7/8" LG (BBE)                         | SA-106-B   | 2#     |
| 63   | 1   | -    | 1-003363 | 3" PIPE SCH STD x 3'-6 1/8" LG (BBE)                      | SA-106-B   | 24#    |
| 64   | 1   | -    | 1-003363 | 3" PIPE SCH STD x 2'-8 3/8" LG (BBE)                      | SA-106-B   | 19#    |
| 65   | 1   | -    | 1-003374 | 6" PIPE SCH STD x 6'-11 3/4" LG (BBE)                     | SA-106-B   | 133#   |
| 66   | 1   | -    | 1-003363 | 3" PIPE SCH STD x 4'-0 3/4" LG (BBE)                      | SA-106-B   | 30#    |
| 67   | 1   | -    | 1-003419 | 2" PIPE SCH XH x 2'-11" LG (BBE)                          | SA-333-GR6 | 14#    |
| 68   | 1   | -    | 1-003358 | 2" PIPE SCH XH x 1 3/8" LG (BBE)                          | SA-106-B   | 1#     |
| 69   | 1   | -    | 1-003358 | 2" PIPE SCH XH x 1'-0 3/4" LG (BBE)                       | SA-106-B   | 6#     |
| 70   | 2   | -    | 1-003419 | 2" PIPE SCH XH x 1'-1 1/8" LG (BBE)                       | SA-333-GR6 | 14#    |
| 71   | 2   | -    | 1-003363 | 3" PIPE SCH STD x 1'-0 1/4" LG (BBE)                      | SA-333-GR6 | 14#    |
| 72   | 2   | -    | 1-003431 | 4" PIPE SCH STD x 11 3/4" LG (BBE)                        | SA-333-GR6 | 20#    |
| 73   | 4   | -    | 1-003436 | 6" PIPE SCH STD x 10 3/4" LG (BBE)                        | SA-333-GR6 | 68#    |

| REV. NO. | DATE     | REVISION                                      | BY  | APP'D |
|----------|----------|-----------------------------------------------|-----|-------|
| 0        | 01/14/10 | ISSUED FOR FABRICATION                        | JAH | JAM   |
| 1        | 01/21/10 | REVISED RADIOGRAPHY AND MPI REQUIREMENT NOTES | JAH | JAM   |
| 2        | 03/22/10 | AS BUILT                                      | JAH |       |
|          |          |                                               |     |       |
|          |          |                                               |     |       |
**BILTON**  
Welding & Manufacturing Ltd.  
BOX 6106  
5815 37 Street  
INNISFAIR, AB  
CANADA  
403-227-7799  
1-888-227-4923  
FAX 227-7796

This drawing is property of BILTON WELDING & MANUFACTURING LTD and is loaned to the recipient for their confidential use only. In consideration of the loan of this drawing the recipient promises and agrees that it shall not be used in any way detrimental to the interests of BILTON WELDING & MANUFACTURING LTD, that it shall be returned upon request, and shall not be reproduced, copied, lent, or otherwise disposed of, directly or indirectly, without the written consent of BILTON WELDING & MANUFACTURING LTD.

**BARRICK ENERGY INC.**  
PUMP AND BLENDING SKID - TAG SK-500  
SPOOLING DETAILS 2 of 2

DATE: 01/11/09  
SHEET: 5 OF 5  
DRAWN BY: JAH  
PURCHASE ORDER: 71049P-028  
LOCATION: 02-02-069-22 W5M  
APP'D BY: JAM

SALE ORDER: 001723  
JOB ORDER:  
D1216  
DRAWING NO.:  
C969-5  
REV. 2

FILE PATH:

CERTIFIED  
AS BUILT