


A

B

C

D

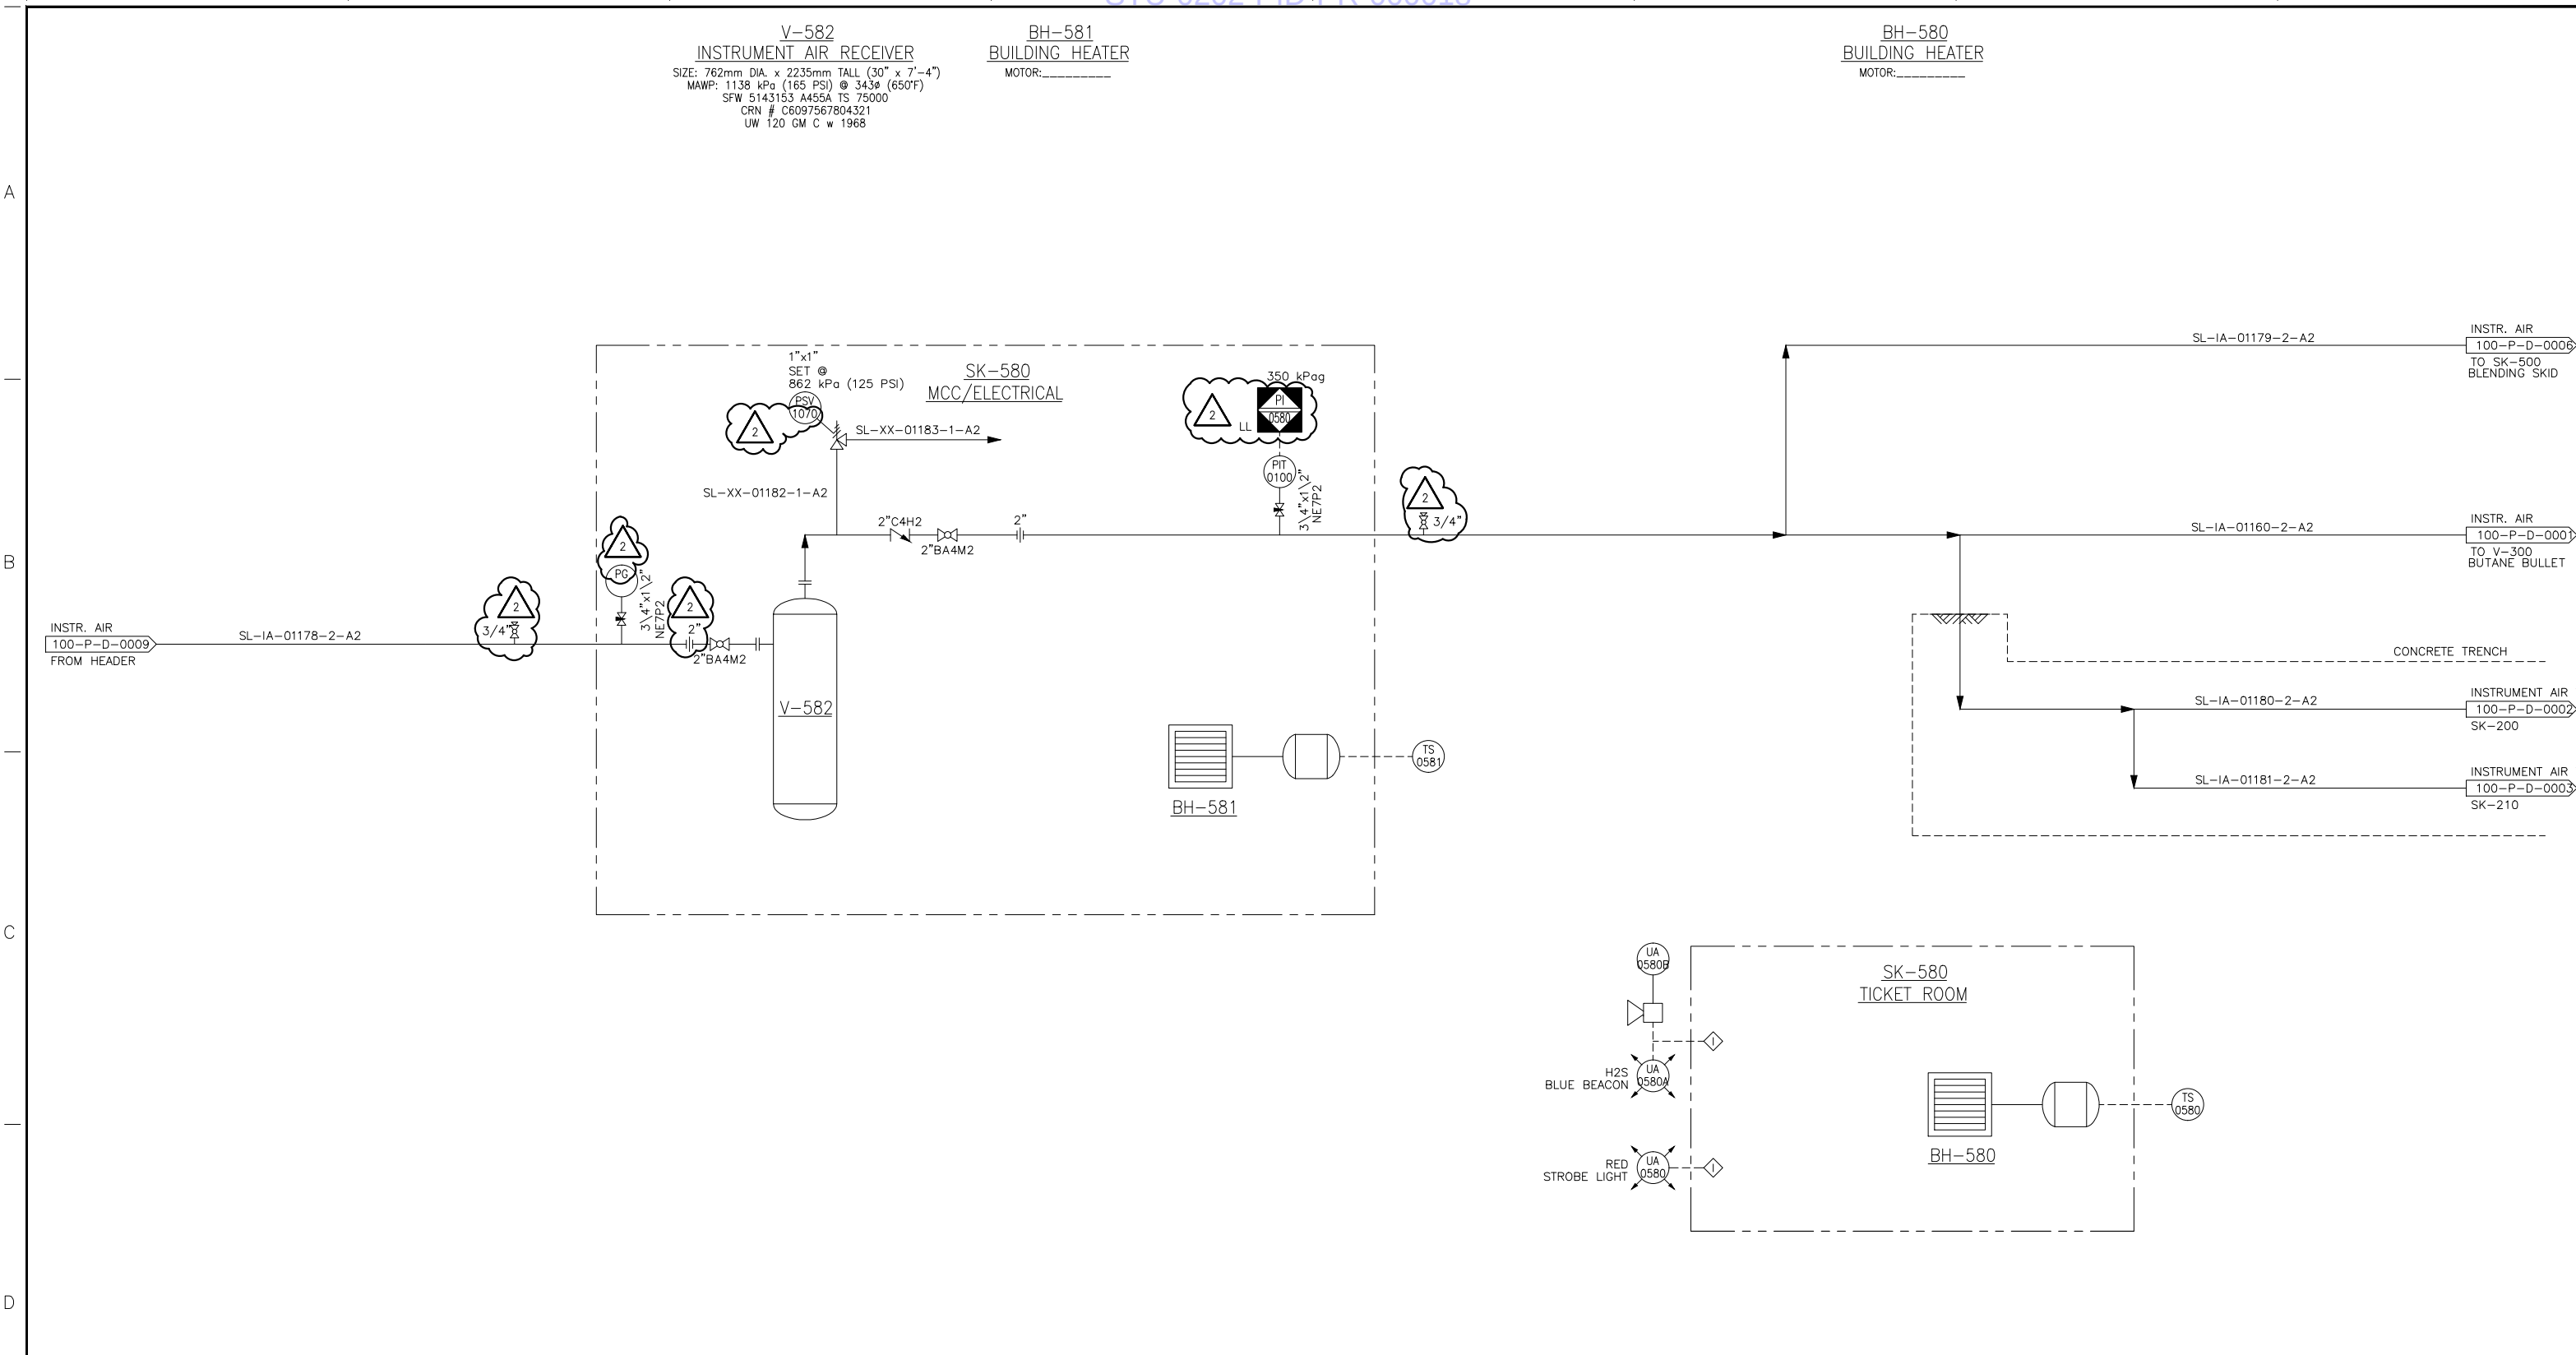

REFERENCE DRAWINGS

DWG. NO.

NO.

DATE

PROJECT DESCRIPTION

PROJ.

BY

APPD.

0

10 01 15

ISSUED FOR CONSTRUCTION

SAW-100

JL

SAW

1

10 07 16

AS BUILT PER FIELD MARK-UPS

SAW-100

JL

SAW

2

18 04 06

AS FOUND IN FIELD

ML

ISSUE STAGE

DATE

BY

CHKD.

APPD.

0 - ISSUED FOR CONSTRUCTION

10 01 15

JL

RSN

SAW

1 - AS BUILT PER FIELD MARK-UPS

10 07 16

JL

RSN

SAW

2 - AS FOUND IN FIELD

18 04 06

ML

MF

REV. NUMBER

DATE

BY

CHKD.

APPD.

0

10 01 15

JL

RSN

SAW

1

10 07 16

JL

RSN

SAW

2

18 04 06

ML

MF

ENGINEER'S STAMP

PERMIT No. P10437

PROFESSIONAL STAMP AFFIXED ABOVE SHALL APPLY ONLY TO REV(S)

2

THIS PID WAS PARTIALLY AS-BUILT ON MAY 3, 2018, AND MUST FIRST BE FULLY AS-BUILT PRIOR TO BE RELIED UPON FOR TECHNICAL PURPOSES.

CAPITAL ENGINEERING

S.A.W. ENGINEERING LTD.

BARRICK

STURGEON LAKE

SITE TYPE BUTANE/CRUDE OIL BLENDING FACILITY

MAIN LSD. 02-02-069-22 W5M

SCALE NONE EPCM No. SAW-100

TITLE MCC BUILDING PIPING AND INSTRUMENTATION DIAGRAM

AREA STURGEON LAKE

FILE NO. 100-P-D-0007