






[illegible]

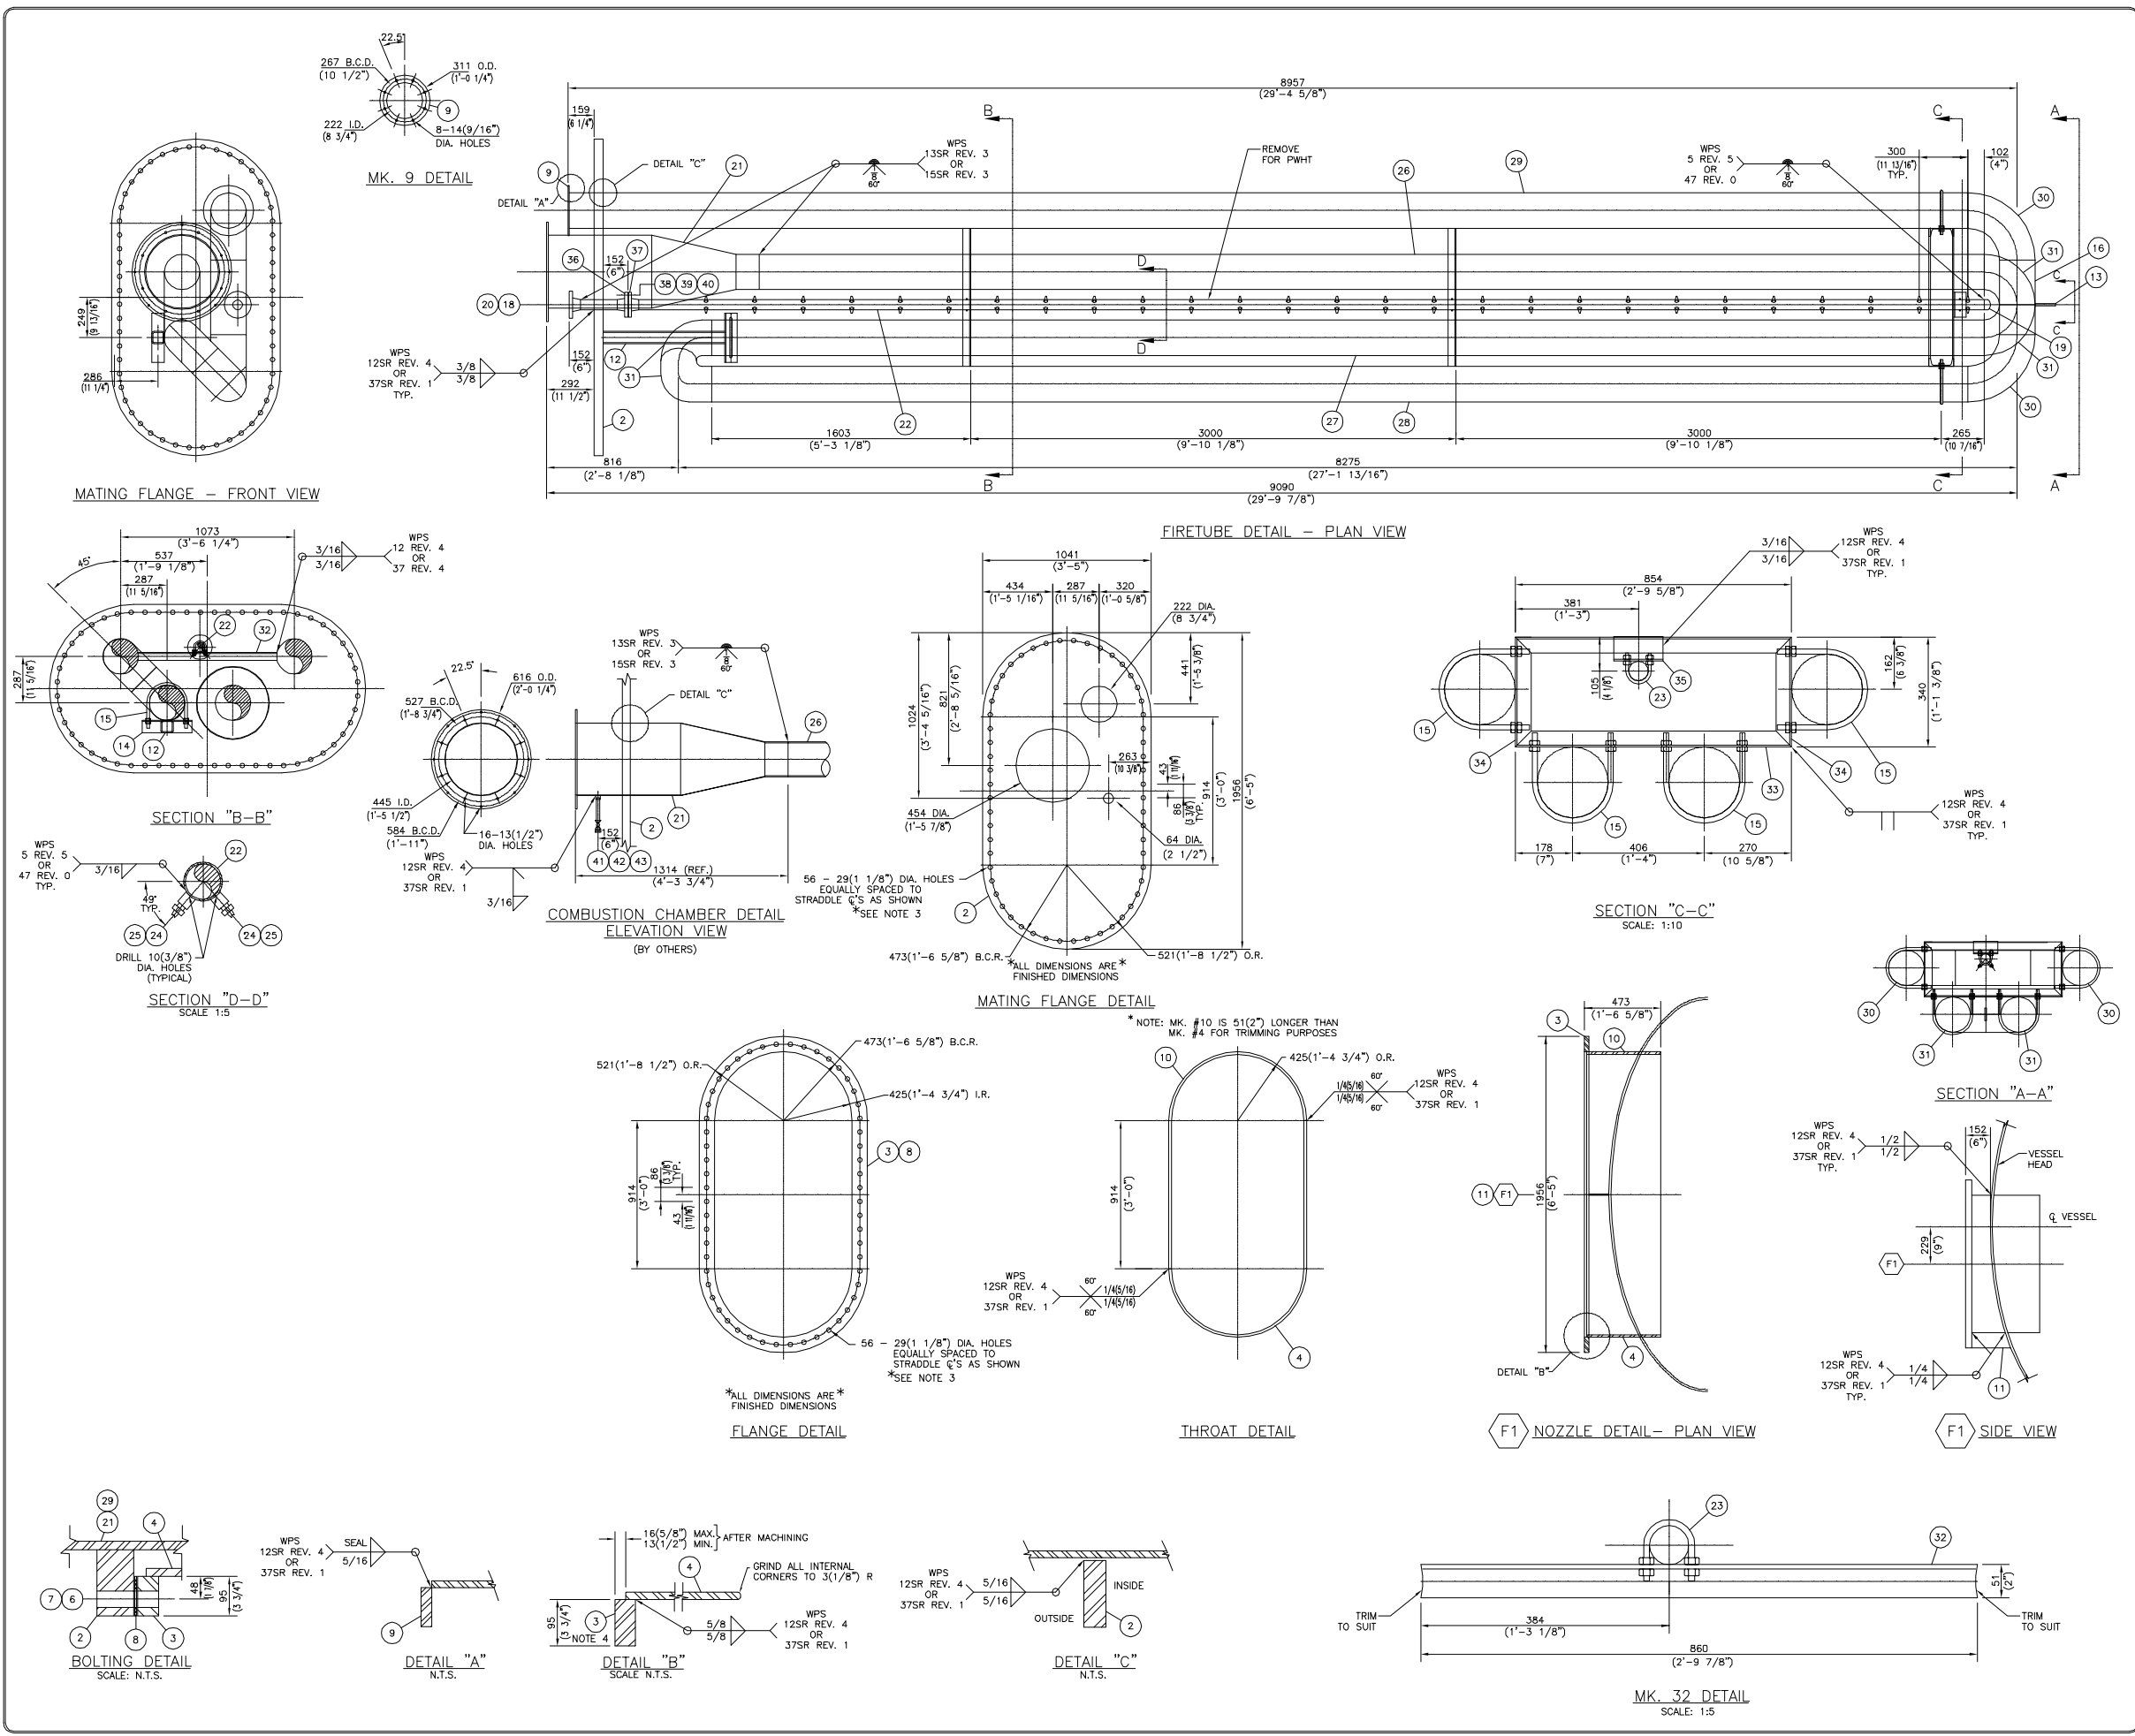


| MATERIAL LIST                                                                                                                                                                                                                                     |              |                                               |                  |          |
|---------------------------------------------------------------------------------------------------------------------------------------------------------------------------------------------------------------------------------------------------|--------------|-----------------------------------------------|------------------|----------|
| MK                                                                                                                                                                                                                                                | QTY          | DESCRIPTION                                   | MATERIAL         | WT       |
| 1                                                                                                                                                                                                                                                 |              |                                               |                  |          |
| 2                                                                                                                                                                                                                                                 | 1            | PLATE 2 1/4" THK. x 3'-5" x 6'-5" LG.         | (*) SA-516-70N   | 1586     |
| 3                                                                                                                                                                                                                                                 | 1            | PLATE 1 1/8" THK. x 3'-5" x 6'-5" LG.         | (*) SA-516-70N   | 226      |
| 4                                                                                                                                                                                                                                                 | 1            | PLATE 5/8" x 1'-6" x 7'-3 5/8" LG.            | (*) SA-516-70N   | 280      |
| 5                                                                                                                                                                                                                                                 |              |                                               |                  |          |
| 6                                                                                                                                                                                                                                                 | 56           | STUD 1" DIA. x 7" LG.                         | SA-193-B7M       | 50       |
| 7                                                                                                                                                                                                                                                 | 112          | HEX NUT 1" NOM.                               | SA-194-2HM       | 25       |
| 8                                                                                                                                                                                                                                                 | 1            | GASKET 1/8" THK. x 3'-5" x 6'-5" LG.          | GARLOC           | 2        |
| 9                                                                                                                                                                                                                                                 | 1            | PLATE 3/8" x 8 3/4" I.D. x 1'-0 1/4" O.D.     | G40.21-44W       | 8        |
| 10                                                                                                                                                                                                                                                | 1            | PLATE 5/8" x 1'-6" x 7'-5 5/8" LG.            | (*) SA-516-70N   | 286      |
| 11                                                                                                                                                                                                                                                | 1            | PLATE 1/2" x 3 3/4" x 10 9/16" LG.            | (*) SA-516-70N   | 6        |
| 12                                                                                                                                                                                                                                                | 1            | HSS 3" x 3" x 1/4" x 2'-5 9/16" LG.           | (*) SA-36        | 22       |
| 13                                                                                                                                                                                                                                                | 1            | PLATE 1/2" THK. x 3" x 5" LG.                 | (*) SA-516-70N   | 2        |
| 14                                                                                                                                                                                                                                                | 1            | ANGLE 3" x 3" x 1/4" x 1'-0" LG.              | G40.21-44W       | 9        |
| 15                                                                                                                                                                                                                                                | 5            | U-BOLT 5/8" x 8" NPS C/W 2 NUTS               | C.S.             | 14       |
| 16                                                                                                                                                                                                                                                | 1            | PIPE 8" SCH 40 x 1'-6 1/4" LG. SMLS BBE       | SA-106-B         | 43       |
| 17                                                                                                                                                                                                                                                |              |                                               |                  |          |
| 18                                                                                                                                                                                                                                                | 1            | FLANGE 2" CLASS 300 RFWN x SCH 160 BORE       | SA-105N          | 8        |
| 19                                                                                                                                                                                                                                                | 1            | PIPE CAP 2" SCH 10S "WELDED"                  | SA403-WP304 S.S. | 4        |
| 20                                                                                                                                                                                                                                                | 1            | PIPE 2" SCH 160 x 9" LG. SMLS BBE             | SA-106-B         | 5        |
| 21                                                                                                                                                                                                                                                | 1            | COMBUSTION CHAMBER DETAILS                    | (*) BY OTHERS    | -        |
| 22                                                                                                                                                                                                                                                | 1            | PIPE 2" SCH 10S x 27'-3 7/8" LG. "WELDED" BBE | SA312-TP304 S.S. | 71       |
| 23                                                                                                                                                                                                                                                | 3            | U-BOLT 3/8" x 2 NPS C/W 2 NUTS                | C.S.             | 3        |
| 24                                                                                                                                                                                                                                                | 54           | V-JETS 1/4" NPT MODEL H1/4U4030               | 303 S.S.         | 5        |
| 25                                                                                                                                                                                                                                                | 54           | HALF CPLG. 1/4" 3000# SCR'D                   | SA182-F316L S.S. | 5        |
| 26                                                                                                                                                                                                                                                | 1            | PIPE 8" SCH 40 x 24'-10 1/8" LG. SMLS BBE     | SA-106-B         | 711      |
| 27                                                                                                                                                                                                                                                | 1            | PIPE 8" SCH 40 x 25'-9 3/4" LG. SMLS BBE      | SA-106-B         | 738      |
| 28                                                                                                                                                                                                                                                | 1            | PIPE 8" SCH 40 x 25'-5 3/4" LG. SMLS BBE      | SA-106-B         | 728      |
| 29                                                                                                                                                                                                                                                | 1            | PIPE 8" SCH 40 x 28'-4 3/8" LG. SMLS BBE      | SA-106-B         | 811      |
| 30                                                                                                                                                                                                                                                | 2            | ELBOW 8" SCH 40 x 90° L.R.                    | SA-234-WPB       | 74       |
| 31                                                                                                                                                                                                                                                | 4            | ELBOW 8" SCH 40 x 90° S.R.                    | SA-234-WPB       | 34       |
| 32                                                                                                                                                                                                                                                | 2            | ANGLE 2" x 2" x 1/4" x 2'-9 7/8" LG.          | (*) SA-36        | 18       |
| 33                                                                                                                                                                                                                                                | 2            | CHANNEL C6 x 8.2# x 2'-9 5/8" LG.             | G40.21-44W       | 46       |
| 34                                                                                                                                                                                                                                                | 2            | CHANNEL C8 x 8.2# x 1'-1 3/8" LG.             | G40.21-44W       | 18       |
| 35                                                                                                                                                                                                                                                | 1            | ANGLE 3" x 3" x 1/4" x 6" LG.                 | G40.21-44W       | 2        |
| 36                                                                                                                                                                                                                                                | 1            | FLANGE 2" CLASS 150 RFWN x SCH 10S BORE       | SA-105N          | 6        |
| 37                                                                                                                                                                                                                                                | 1            | FLANGE 2" CLASS 150 RFWN x SCH 10S BORE       | SA-182-F304 S.S. | 6        |
| 38                                                                                                                                                                                                                                                | 1            | GASKET 2" CLASS 150 x 1/8" THK.               | 316 S.S. GRAPHOL | 1        |
| 39                                                                                                                                                                                                                                                | 4            | STUD 5/8" DIA. x 3" LG.                       | SA-193-B7M       | 1        |
| 40                                                                                                                                                                                                                                                | 8            | HEX NUT 5/8" NOM.                             | SA-194-2HM       | 1        |
| 41                                                                                                                                                                                                                                                | 1            | HALF COUPLING 1/2" CLASS 3000 F.S. SCR'D      | SA-105           | 1        |
| 42                                                                                                                                                                                                                                                | 1            | NIPPLE 1/2" SCH XS x 6" LG. SMLS TBE          | SA-106-B         | 1        |
| 43                                                                                                                                                                                                                                                | 1            | HEX PLUG 1/2" CLASS 3000 F.S. THR'D           | SA-105           | 1        |
| SUBTOTAL                                                                                                                                                                                                                                          |              |                                               |                  | 5856     |
| x 1.06                                                                                                                                                                                                                                            |              |                                               |                  |          |
| TOTAL (lbs.)                                                                                                                                                                                                                                      |              |                                               |                  | 6207     |
| NOTES:                                                                                                                                                                                                                                            |              |                                               |                  |          |
| 1. RADIOGRAPHY 10% ON FIRETUBE SEAMS, 100% ON FIRETUBE THROAT LONG SEAMS                                                                                                                                                                          |              |                                               |                  |          |
| 2. ALL DIMENSIONS ARE IN METRIC & IMPERIAL UNITS. DIMENSIONS IN BRACKETS ARE IMPERIAL HARD CONVERSIONS FOR SHOP REFERENCE ONLY.                                                                                                                   |              |                                               |                  |          |
| 3. MATCH DRILL MK #2 AND 3.                                                                                                                                                                                                                       |              |                                               |                  |          |
| 4. MACHINE FACE OF MK. #2 & MK. #3                                                                                                                                                                                                                |              |                                               |                  |          |
| MK #3 MIN. CALC. THK. = 0.857                                                                                                                                                                                                                     |              |                                               |                  |          |
| MK #2 MIN. CALC. THK. (INCLUDING C.A.) = 2.052"                                                                                                                                                                                                   |              |                                               |                  |          |
| 5. SEE DWG. NO. V-11699-C106 FOR STACK DETAILS.                                                                                                                                                                                                   |              |                                               |                  |          |
| 6. SEE DWG. NO. V-11699-0107 FOR FIRETUBE SUPPORTS.                                                                                                                                                                                               |              |                                               |                  |          |
| 7. AN ADDITIONAL 51(2") WAS ADDED TO THE LENGTH OF MK.11 FOR TRIMMING PURPOSES.                                                                                                                                                                   |              |                                               |                  |          |
| 8. TRIM CORNERS TO 13(1/2") RADIUS.                                                                                                                                                                                                               |              |                                               |                  |          |
| 9. FIRETUBE MEETS ASME CODE, 2001, ADDENDA JULY 1ST, 2003.                                                                                                                                                                                        |              |                                               |                  |          |
| 10. ITEMS IDENTIFIED WITH A (*) ARE ATTACHED TO THE PRESSURE ENVELOPE & REQUIRE A HEAT NUMBER TO BE HARD STAMPED & RECORDED BY Q.C..                                                                                                              |              |                                               |                  |          |
| REVISIONS                                                                                                                                                                                                                                         |              |                                               |                  |          |
| NO                                                                                                                                                                                                                                                | DATE (d/m/y) | ISSUED FOR CONSTRUCTION                       | BY               | APPD     |
|                                                                                                                                                                                                                                                   |              |                                               |                  |          |
| THIS DRAWING IS THE PROPERTY OF UNIVERSAL INDUSTRIES CORP. AND IS TO BE USED ONLY IN CONJUNCTION WITH PERFORMANCE OF WORK BY UNIVERSAL INDUSTRIES CORP.. REPRODUCTION OR USE OF IN WHOLE OR IN PART FOR ANY OTHER PURPOSE IS EXPRESSLY FORBIDDEN. |              |                                               |                  |          |
| UNIVERSAL INDUSTRIES                                                                                                                                                                                                                              |              |                                               |                  |          |
| Ph: (780) 875-6161 Fax: (780) 875-6169                                                                                                                                                                                                            |              |                                               |                  |          |
| CLIENT                                                                                                                                                                                                                                            |              |                                               |                  |          |
| DEER CREEK ENERGY LTD.                                                                                                                                                                                                                            |              |                                               |                  |          |
| C/O BOWER DAMBERGER ROLSETH ENGINEERING LTD.                                                                                                                                                                                                      |              |                                               |                  |          |
| JOSLYN PHASE 2, SAGD FACILITY                                                                                                                                                                                                                     |              |                                               |                  |          |
| DWG TITLE                                                                                                                                                                                                                                         |              |                                               |                  |          |
| RECYCLE TREATER TR-805                                                                                                                                                                                                                            |              |                                               |                  |          |
| 2438mm(8'-0") O.D. x 10668mm(35'-0") S/S                                                                                                                                                                                                          |              |                                               |                  |          |
| FIRETUBE ASSEMBLY 8" DIA. FORCED AIR (4 PASS)                                                                                                                                                                                                     |              |                                               |                  |          |
| SCALE                                                                                                                                                                                                                                             | DWN BY       | DWG. NO.                                      | SHEET NO.        | REV. NO. |
| 1:20                                                                                                                                                                                                                                              | E. WILSON    | V-11699-D105                                  | 1 of 1           |          |
| DATE (d/m/y)                                                                                                                                                                                                                                      | CHKD         | APPD                                          |                  |          |
| 29/01/05                                                                                                                                                                                                                                          |              |                                               |                  |          |
| DWG/K11699/10511699                                                                                                                                                                                                                               |              |                                               |                  |          |

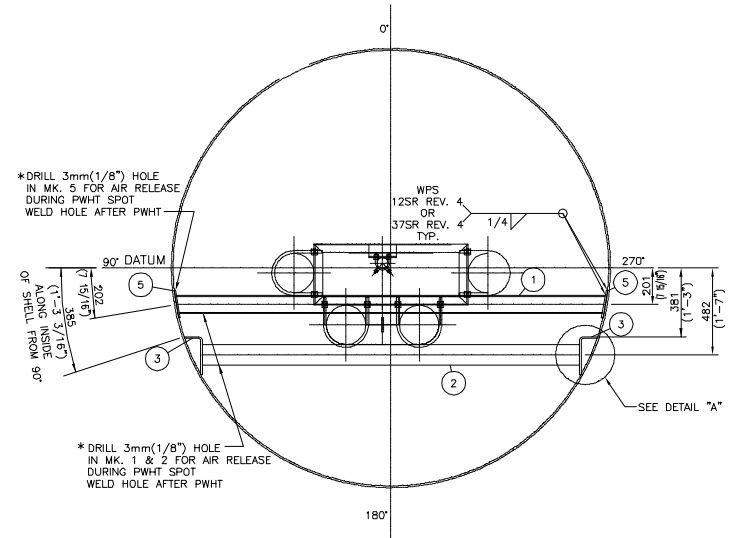

SECTION "A-A"

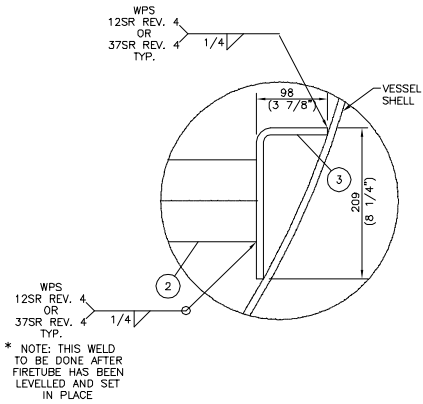

DETAIL "A"  
SCALE: 1:5

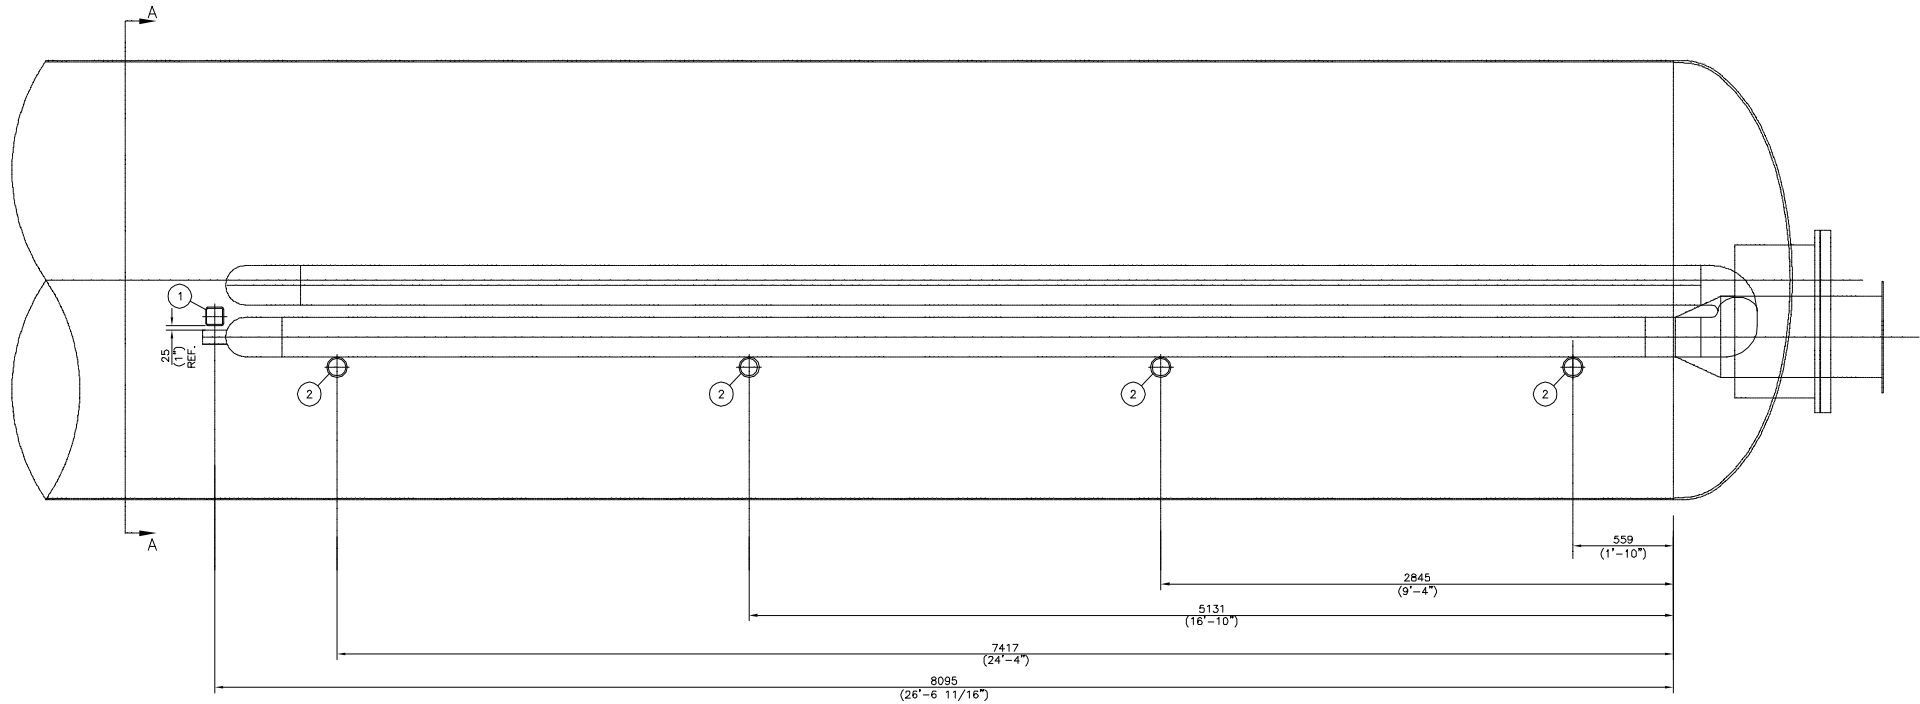

ELEVATION

MATERIAL LIST

| MK | QTY | DESCRIPTION                              | MATERIAL       | WT  |
|----|-----|------------------------------------------|----------------|-----|
| 1  | 1   | HSS 4" x 4" x 1/4" x 7'-9 3/4" LG.       | G40.21-44W     | 95  |
| 2  | 4   | PIPE 4" SCH XS x 6'-10 3/8" LG. SMLS PBE | SA-106-B       | 411 |
| 3  | 8   | PLATE 3/8" THK. x 6" x 11 1/2" LG.       | (*) SA-36      | 59  |
| 4  |     |                                          |                |     |
| 5  | 2   | REPAD: PLATE 3/8" THK. x 6" DIA.         | (*) SA-516-70N | 13  |
| 6  |     |                                          |                |     |
| 7  |     |                                          |                |     |
| 38 |     |                                          | SUBTOTAL       | 578 |
| 39 |     |                                          | x 1.06         |     |
| 40 |     |                                          | TOTAL (lbs.)   | 612 |

NOTES:  
1. ALL DIMENSIONS ARE IN S.I. & IMPERIAL UNITS. DIMENSIONS IN BRACKETS ARE IMPERIAL HARD CONVERSIONS FOR SHOP REFERENCE ONLY.  
2. ITEMS IDENTIFIED WITH A (\*) ARE ATTACHED TO THE PRESSURE ENVELOPE & REQUIRE A HEAT NUMBER TO BE HARD STAMPED & RECORDED BY Q.C..

|    |              |                         |     |      |
|----|--------------|-------------------------|-----|------|
| △  |              |                         |     |      |
| △  |              |                         |     |      |
| △  | 11/02/05     | ISSUED FOR CONSTRUCTION | EEW |      |
| NO | DATE (d/m/y) | REVISIONS               | BY  | APPD |
|    |              | REVISIONS               |     |      |


THIS DRAWING IS THE PROPERTY OF UNIVERSAL INDUSTRIES CORP. AND IS TO BE USED ONLY IN CONJUNCTION WITH PERFORMANCE OF WORK BY UNIVERSAL INDUSTRIES CORP.. REPRODUCTION OR USE OF IN WHOLE OR IN PART FOR ANY OTHER PURPOSE IS EXPRESSLY FORBIDDEN.




CLIENT  
DEER CREEK ENERGY LTD.  
C/O BOWER DAMBERGER ROLSETH ENGINEERING LTD.  
JOSLYN PHASE 2, SAGD FACILITY

DWG TITLE  
2438mm(8'-0") O.D. x 10668mm(35'-0") S/S  
FIRETUBE SUPPORT DETAIL


|                          |                     |                         |                     |               |
|--------------------------|---------------------|-------------------------|---------------------|---------------|
| SCALE<br>1:20            | DWN BY<br>E. WILSON | DWG NO.<br>V-11699-D107 | SHEET NO.<br>1 of 1 | REV. NO.<br>△ |
| DATE (d/m/y)<br>08/02/05 | CHKD<br>APPD        |                         |                     |               |

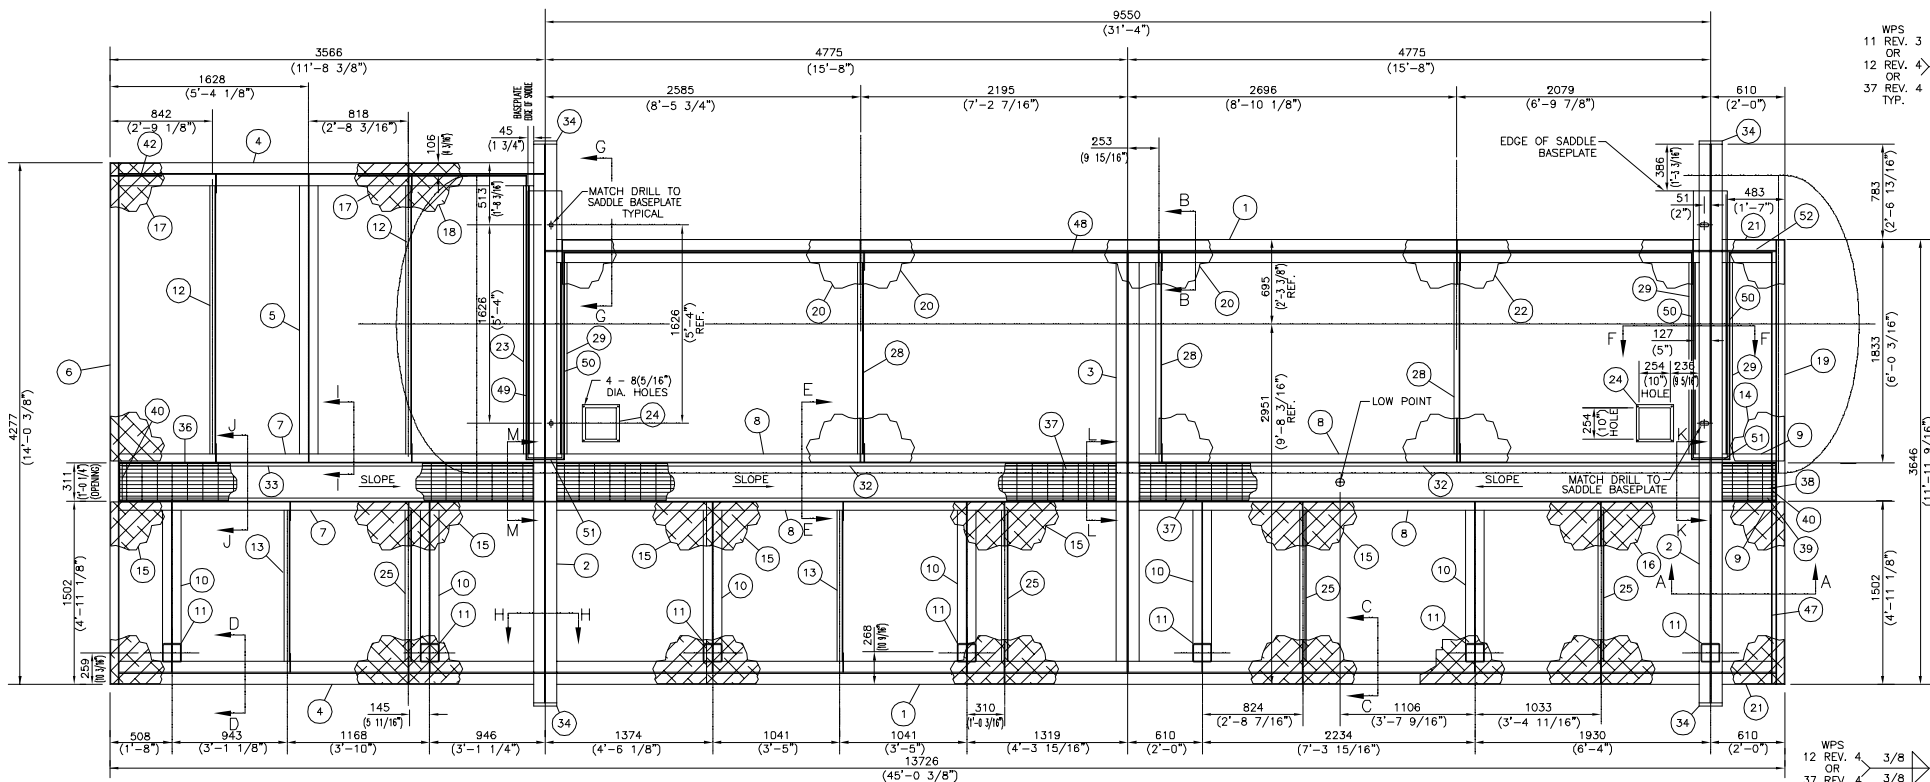


PLAN VIEW

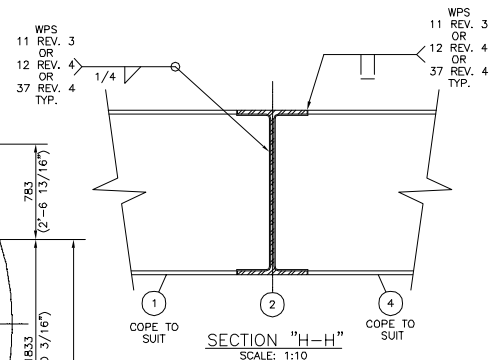


SECTION "H-H"

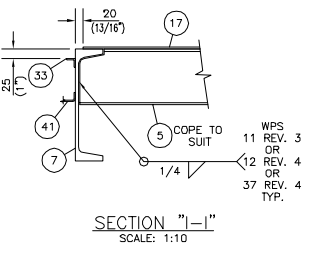


SECTION "I-I"

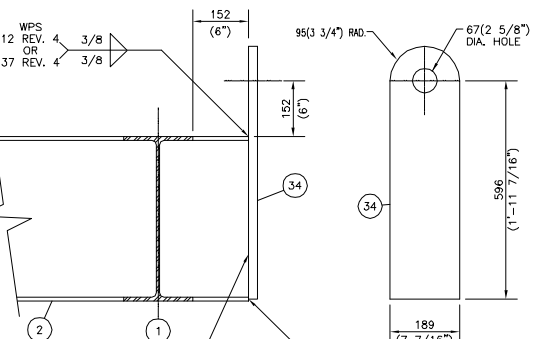


SECTION "G-G"

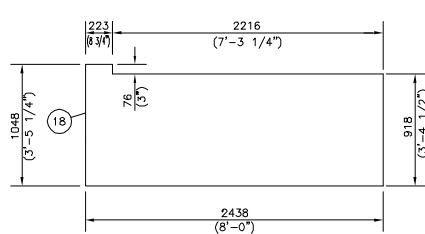


MK. 18 DETAIL

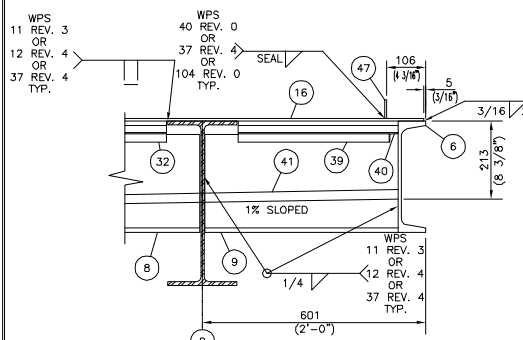


SECTION "A-A"

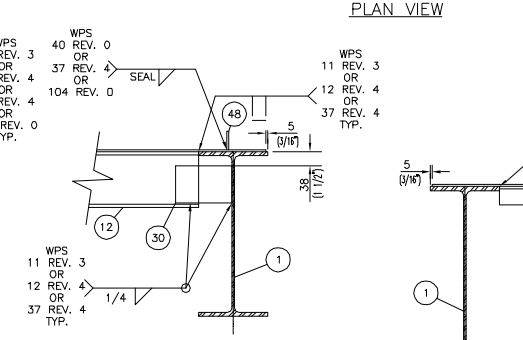


SECTION "B-B"

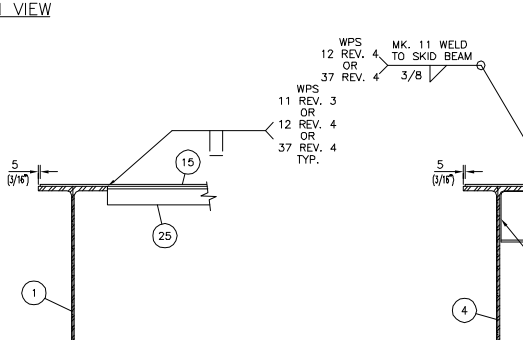


SECTION "C-C"

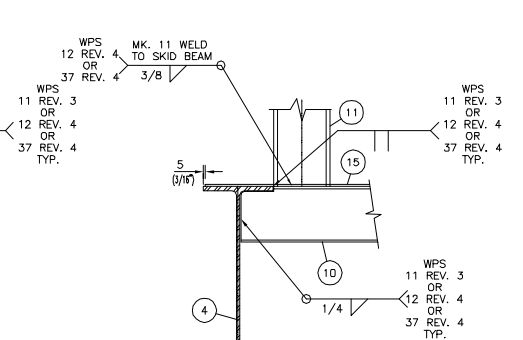


SECTION "D-D"

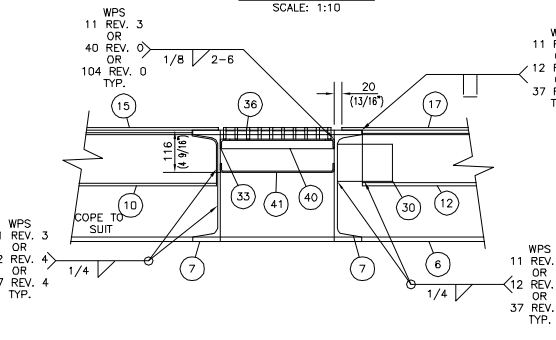


SECTION "J-J"

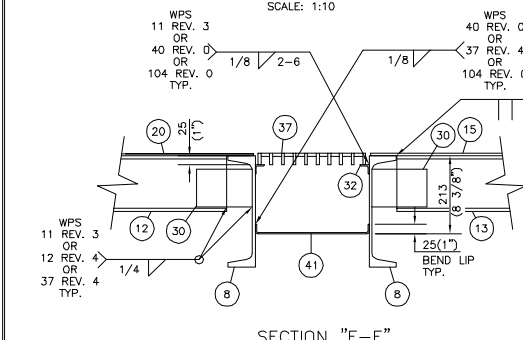


SECTION "E-E"

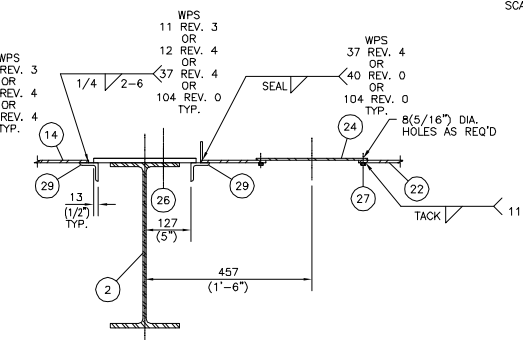


SECTION "F-F"

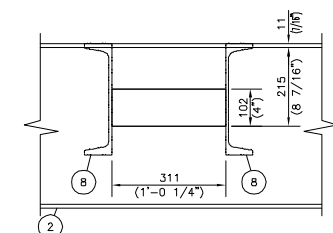

MK. 2 TROUGH CUTOUT AT SECTION "K-K"

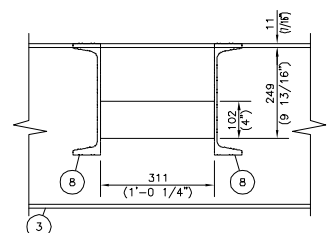

MK. 3 TROUGH CUTOUT AT SECTION "L-L"

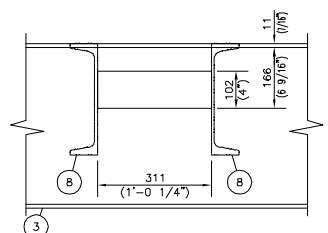

MK. 2 TROUGH CUTOUT AT SECTION "M-M"

- NOTES:
1. ALL DIMENSIONS ARE IN S.I. & IMPERIAL UNITS. DIMENSIONS IN BRACKETS ARE IMPERIAL HARD CONVERSIONS FOR SHOP REFERENCE ONLY.
  2. SANDBLAST TO SSPC-SP6 AND APPLY 2 TO 3 MILS. DFT. OF PRIMER AND ONE TOP COAT OF F34 WARM GREY ENAMEL TO COMPLETE SKID.
  3. APPLY 51(2") OF FIRE RESISTANT SPRAY-ON POLYURETHANE INSULATION TO THE UNDERSIDE OF ENTIRE SKID.
  4. STITCH WELD UNDERSIDE OF CHECKER PLATE TO SKID MEMBERS.

MATERIAL LIST

| MK           | QTY | DESCRIPTION                                                             | MATERIAL              | WT    |
|--------------|-----|-------------------------------------------------------------------------|-----------------------|-------|
| 1            | 2   | BEAM W18 x 41# x 31'-3 11/16" LG.                                       | G40.21-44W            | 2567  |
| 2            | 2   | BEAM W18 x 41# x 15'-0 3/8" LG.                                         | G40.21-44W            | 1233  |
| 3            | 1   | BEAM W18 x 41# x 11'-3 13/16" LG.                                       | G40.21-44W            | 464   |
| 4            | 2   | BEAM W18 x 41# x 11'-5 5/16" LG.                                        | G40.21-44W            | 938   |
| 5            | 1   | BEAM W6 x 15# x 7'-8 13/16" LG.                                         | G40.21-44W            | 116   |
| 6            | 1   | CHANNEL C12 x 20.7# x 14'-0 3/8" LG.                                    | G40.21-44W            | 290   |
| 7            | 2   | CHANNEL C12 x 20.7# x 11'-5 5/16" LG.                                   | G40.21-44W            | 474   |
| 8            | 4   | CHANNEL C12 x 20.7# x 15'-7 11/16" LG.                                  | G40.21-44W            | 1295  |
| 9            | 2   | CHANNEL C12 x 20.7# x 1'-8 15/16" LG.                                   | G40.21-44W            | 72    |
| 10           | 6   | BEAM W6 x 15# x 4'-7" LG.                                               | G40.21-44W            | 413   |
| 11           | 7   | HSS 6" x 6" x 3/8" x 9'-4 5/16" LG.                                     | G40.21-44W            | 1801  |
| 12           | 2   | CHANNEL C6 x 8.2# x 7'-2 11/16" LG. (CLIP ON BOTH ENDS)                 | G40.21-44W            | 118   |
| 13           | 2   | CHANNEL C6 x 8.2# x 4'-0 3/4" LG. (CLIP ON BOTH ENDS)                   | G40.21-44W            | 67    |
| 14           | 1   | PLATE 3/16" x 1'-5 13/16" x 5'-11 3/16" LG.                             | G40.21-44W            | 67    |
| 15           | 5   | CHECKER PLATE 1/4" x 8'-0" x 4'-10 3/4" LG.                             | G40.21-44W            | 2000  |
| 16           | 1   | CHECKER PLATE 1/4" x 4'-11 1/16" x 4'-10 3/4" LG.                       | G40.21-44W            | 246   |
| 17           | 1   | CHECKER PLATE 1/4" x 8'-0" x 8'-0" LG.                                  | G40.21-44W            | 653   |
| 18           | 1   | CHECKER PLATE 1/4" x 3'-5 1/4" x 8'-0" LG.                              | G40.21-44W            | 281   |
| 19           | 1   | CHANNEL C12 x 20.7# x 11'-11 9/16" LG.                                  | G40.21-44W            | 248   |
| 20           | 3   | PLATE 3/16" x 8'-0" x 5'-11 13/16" LG.                                  | G40.21-44W            | 1100  |
| 21           | 2   | BEAM W18 x 41# x 1'-8 15/16" LG.                                        | G40.21-44W            | 143   |
| 22           | 1   | PLATE 3/16" x 6'-4" x 5'-11 13/16" LG.                                  | G40.21-44W            | 291   |
| 23           | 1   | ANGLE 2" x 2" x 1/4" x 7'-2 11/16" LG.                                  | G40.21-44W            | 23    |
| 24           | 2   | PLATE 11 ga. x 1'-0" x 1'-0" LG.                                        | A-569                 | 10    |
| 25           | 4   | ANGLE 2" x 2" x 1/4" x 4'-0 3/4" LG.                                    | G40.21-44W            | 52    |
| 26           | 4   | BOLT 1" DIA. x 2 1/2" LG. C/W HEX NUT & WASHER                          | A-325                 | 5     |
| 27           | 8   | BOLT 1/4" DIA. x 1" LG. C/W NUT                                         | Gr.5                  | 2     |
| 28           | 3   | CHANNEL C6 x 8.2# x 5'-1 13/16" LG. (CLIP ON BOTH ENDS)                 | G40.21-44W            | 127   |
| 29           | 3   | ANGLE 2" x 2" x 1/4" x 5'-1 13/16" LG.                                  | G40.21-44W            | 49    |
| 30           | 14  | CLIP: FLATBAR 1/4" x 4" x 6" LG.                                        | G40.21-44W            | 24    |
| 31           |     |                                                                         |                       |       |
| 32           | 4   | ANGLE 1" x 1" x 1/8" x 15'-0 9/16" LG.                                  | G40.21-44W            | 48    |
| 33           | 2   | ANGLE 1" x 1" x 3/16" x 11'-0 11/16" LG.                                | G40.21-44W            | 18    |
| 34           | 4   | PLATE 1" THK. x 7 7/16" x 2'-3 3/16" LG.                                | SA-516-70             | 233   |
| 35           |     |                                                                         |                       |       |
| 36           | 1   | GRATING 1'-0" WIDE x 11'-1 7/16" LG.; TYPE 19-4 C/W 1 1/4" x 3/16" BARS | GALVANIZED G40.21-44W | 99    |
| 37           | 2   | GRATING 1'-0" WIDE x 15'-0 5/16" LG.; TYPE 19-4 C/W 1 1/4" x 3/16" BARS | GALVANIZED G40.21-44W | 266   |
| 38           | 1   | GRATING 1'-0" WIDE x 11'-5 1/8" LG.; TYPE 19-4 C/W 1 1/4" x 3/16" BARS  | GALVANIZED G40.21-44W | 13    |
| 39           | 2   | ANGLE 1" x 1" x 3/16" x 1'-4 3/8" LG.                                   | G40.21-44W            | 2     |
| 40           | 2   | ANGLE 1" x 1" x 3/16" x 1'-0 1/4" LG.                                   | G40.21-44W            | 2     |
| 41           | 1   | PLATE 10 ga x 1'-2" x 44'-6 11/16" LG.                                  | A-569                 | 292   |
| 42           | 1   | FLATBAR 3/16" x 2" x 11'-2 3/16" LG.                                    | G40.21-44W            | 14    |
| 43           |     |                                                                         |                       |       |
| 44           |     |                                                                         |                       |       |
| 45           |     |                                                                         |                       |       |
| 46           |     |                                                                         |                       |       |
| 47           | 1   | FLATBAR 3/16" x 2" x 11'-7 3/16" LG.                                    | G40.21-44W            | 15    |
| 48           | 1   | FLATBAR 3/16" x 2" x 30'-3 5/8" LG.                                     | G40.21-44W            | 39    |
| 49           | 1   | FLATBAR 3/16" x 2" x 7'-7 1/2" LG.                                      | G40.21-44W            | 10    |
| 50           | 3   | FLATBAR 3/16" x 2" x 5'-6 7/8" LG.                                      | G40.21-44W            | 21    |
| 51           | 2   | FLATBAR 3/16" x 2" x 1'-0" LG.                                          | G40.21-44W            | 3     |
| 52           | 1   | FLATBAR 3/16" x 2" x 1'-2 7/16" LG.                                     | G40.21-44W            | 2     |
| SUBTOTAL     |     |                                                                         |                       | 16246 |
| TOTAL (lbs.) |     |                                                                         |                       | 17221 |

|           |                         |           |         |
|-----------|-------------------------|-----------|---------|
| 03/03/05  | ISSUED FOR CONSTRUCTION | EEW       |         |
| NO        | DATE (d/m/y)            | REVISIONS | BY APPD |
| REVISIONS |                         |           |         |


THIS DRAWING IS THE PROPERTY OF UNIVERSAL INDUSTRIES CORP. AND IS TO BE USED ONLY IN CONJUNCTION WITH PERFORMANCE OF WORK BY UNIVERSAL INDUSTRIES CORP.. REPRODUCTION OR USE OF IN WHOLE OR IN PART FOR ANY OTHER PURPOSE IS EXPRESSLY FORBIDDEN.



CLIENT: DEER CREEK ENERGY LTD.  
C/O BOWER DAMBERGER ROLSETH ENGINEERING LTD.  
JOSLYN PHASE 2, SAGD FACILITY  
LSD 14-28-95-12 W4M


DWG TITLE: RECYCLE TREATER TR-805  
2438mm(8'-0") O.D. x 10668mm(35'-0") S/S  
SKID PLAN VIEW AND DETAILS

|                |                   |                      |                  |            |
|----------------|-------------------|----------------------|------------------|------------|
| SCALE: 1:30    | DWN BY: E. WILSON | DWG NO: V-11699-D108 | SHEET NO: 1 OF 1 | REV. NO: 0 |
| DATE: 10/02/05 | CHKD: APPD        |                      |                  |            |

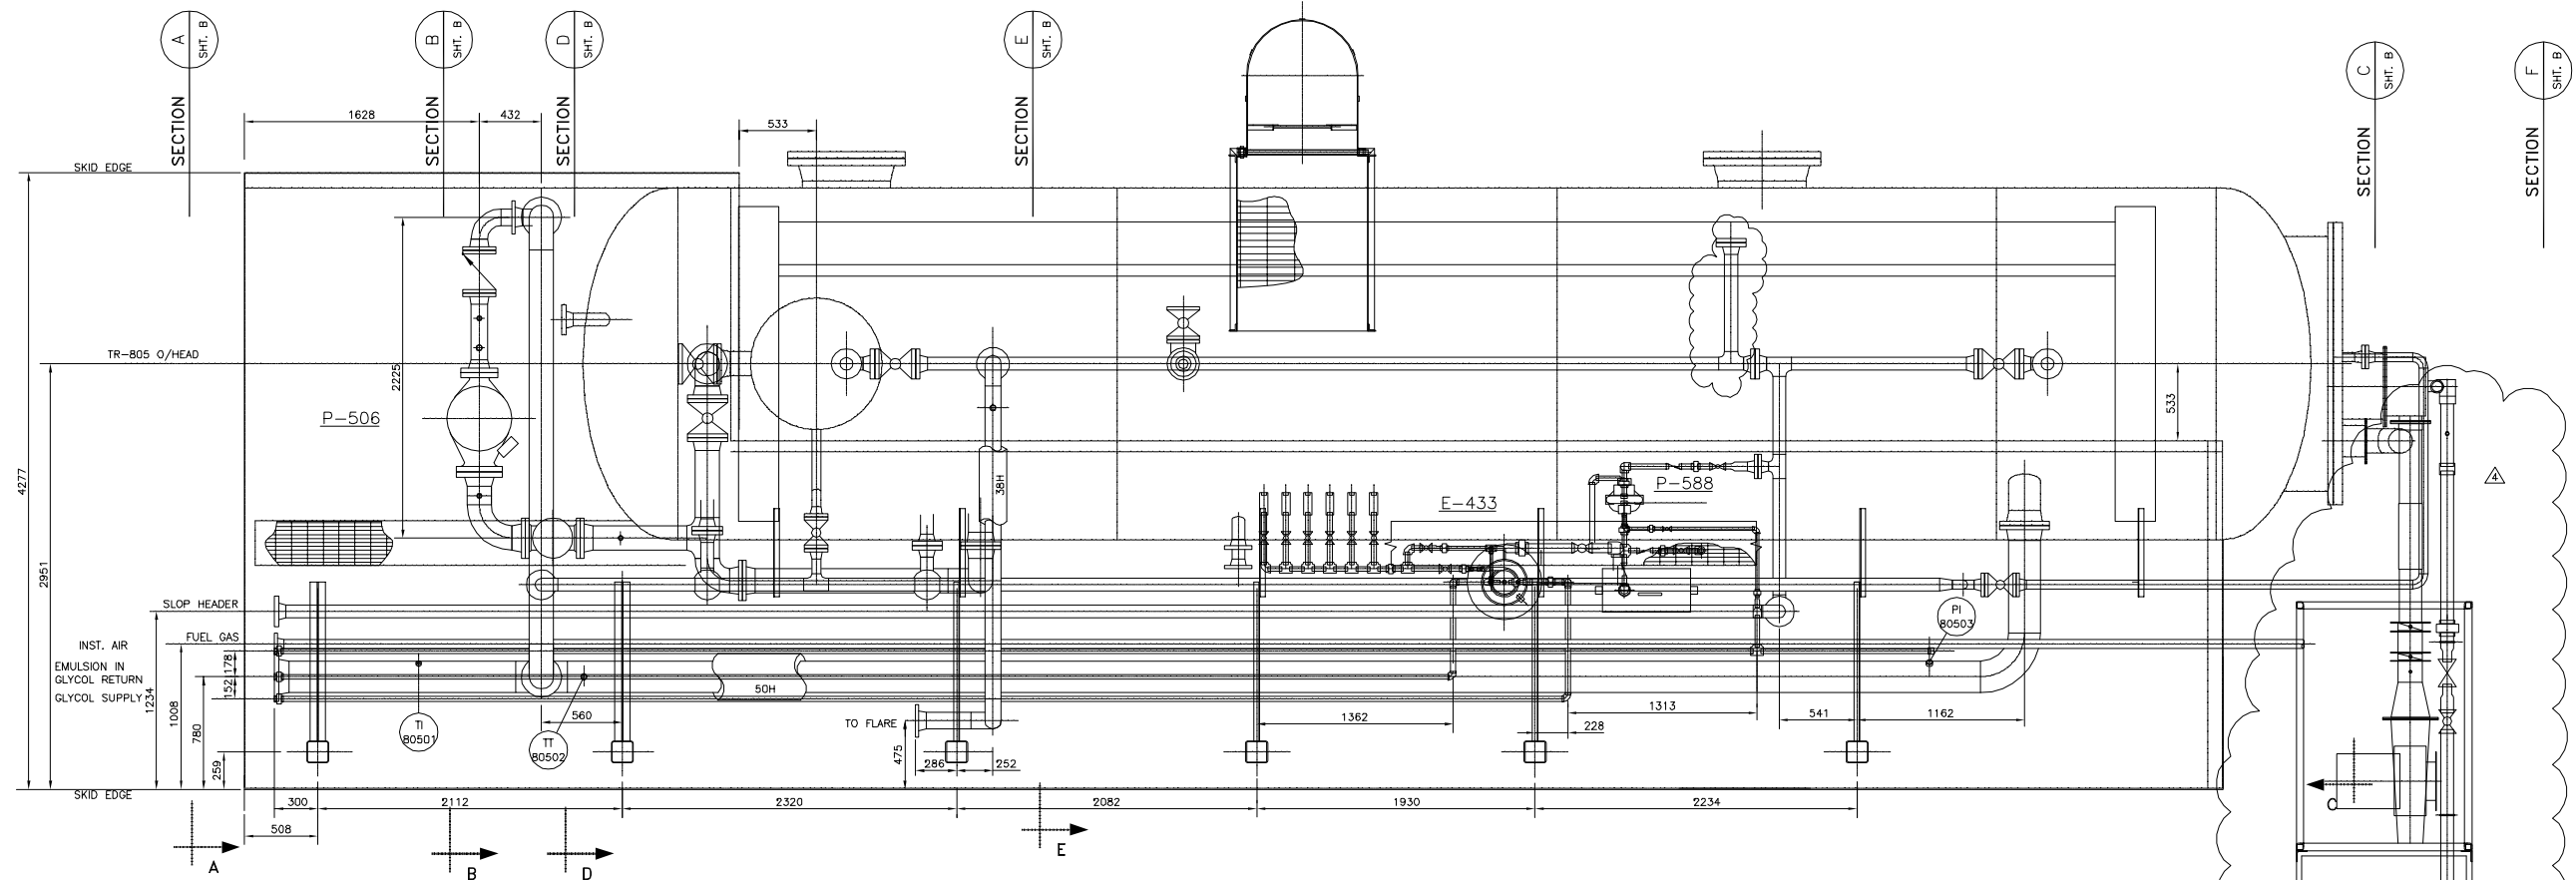

PLAN VIEW

PSV  
80504  
3L4  
SET @ 345 kPa

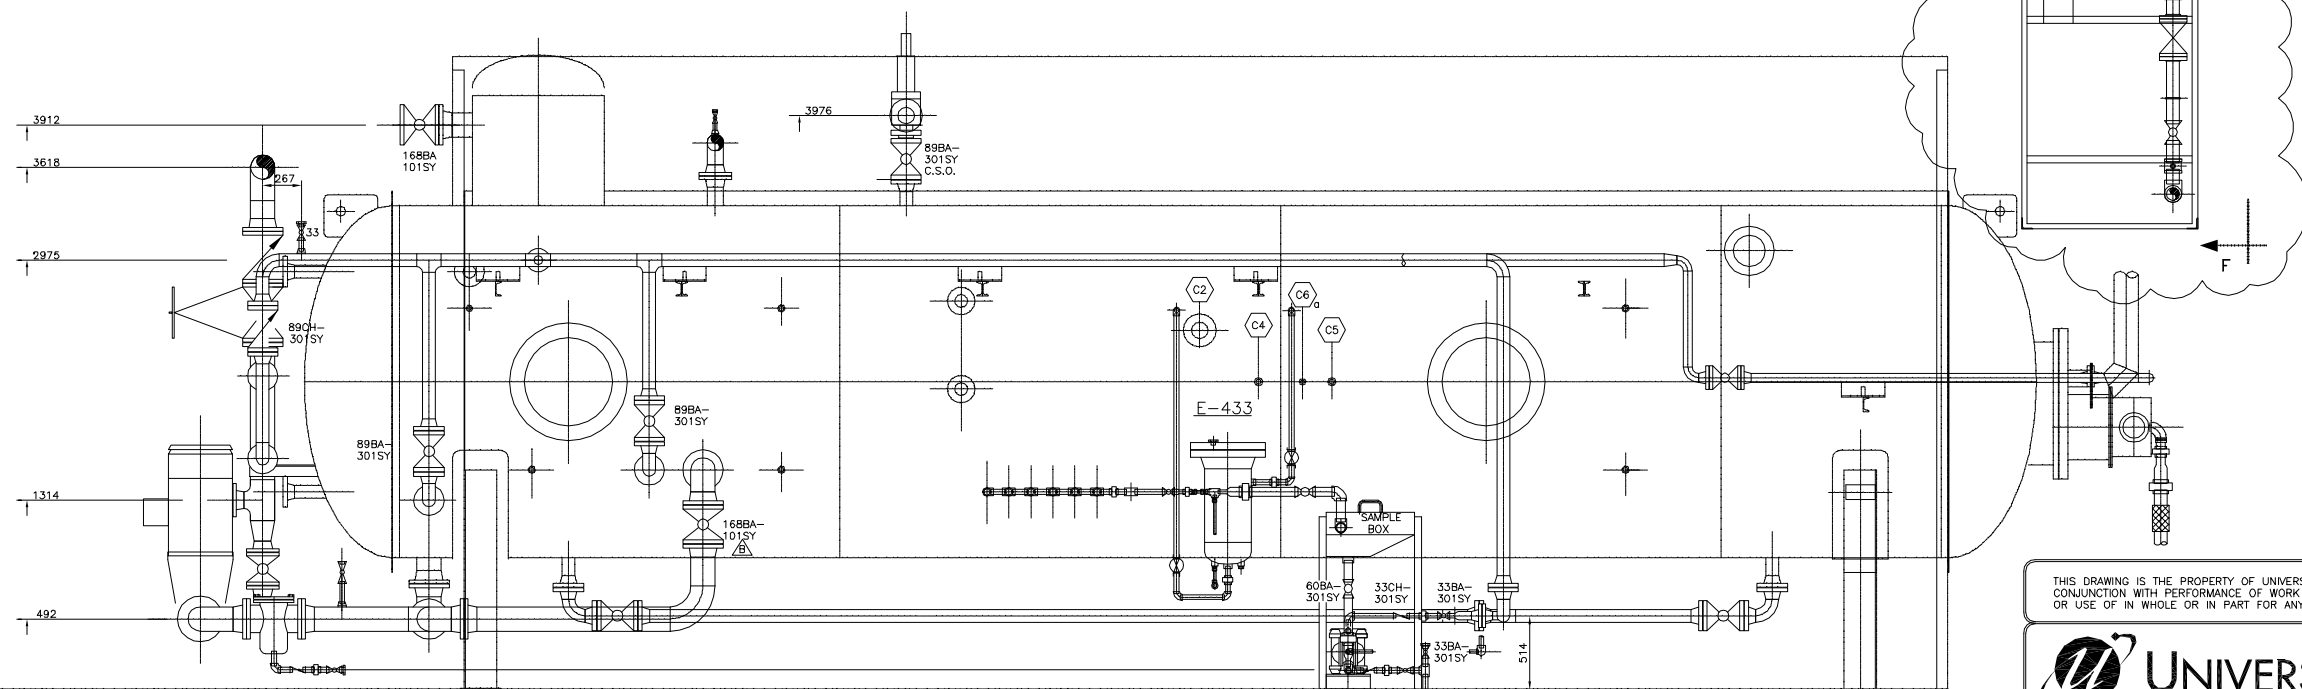

ELEVATION VIEW

DATUM  
T.O. SKID

THIS DRAWING IS THE PROPERTY OF UNIVERSAL INDUSTRIES CORP. AND IS TO BE USED ONLY IN CONJUNCTION WITH PERFORMANCE OF WORK BY UNIVERSAL INDUSTRIES CORP. REPRODUCTION OR USE OF IN WHOLE OR IN PART FOR ANY OTHER PURPOSE IS EXPRESSLY FORBIDDEN.




CLIENT  
DEER CREEK ENERGY LTD.  
C/O BOWER DAMBERGER ROLSETH ENGINEERING LTD.  
JOSLYN PHASE 2, SAGD FACILITY  
LSD 14-28-95-12 W4M

DWG TITLE  
RECYCLE TREATER TR-805  
2438mm(8'-0") O.D. x 10668mm(35'-0") S/S  
PIPING LAYOUT - PLAN & ELEVATION VIEW


|           |                                                  |     |      |
|-----------|--------------------------------------------------|-----|------|
| 27/05/05  | ADDED BLOWER AND FUEL GAS SKID                   | EEW |      |
| 13/04/05  | UPDATE PAINT & COATING SPEC.                     | EEW | LU   |
| 08/04/05  | FOR APPROVAL BLOWER SKID LOCATION                | EEW | LU   |
| 18/03/05  | REVISED AS PER PIPING SPOOLS                     | EEW | LU   |
| 03/03/05  | ISSUED FOR CONSTRUCTION                          | EEW | LU   |
| 18/02/05  | ADDED N10, N11; CHANGED AS PER CUSTOMER COMMENTS | EEW | LU   |
| 25/01/05  | ISSUED FOR CUSTOMER APPROVAL                     | EEW | LU   |
| NO        | DATE (d/m/y)                                     | BY  | APPD |
| REVISIONS |                                                  |     |      |

|              |          |        |           |         |              |           |          |
|--------------|----------|--------|-----------|---------|--------------|-----------|----------|
| SCALE        | 1:25     | DWN BY | E. WILSON | DWG NO. |              | SHEET NO. | REV. NO. |
| DATE (d/m/y) | 24/12/04 | CHKD   | APPD      |         | V-11699-D111 | A OF -    | 4        |


DWG\K11699\11111699SHTA

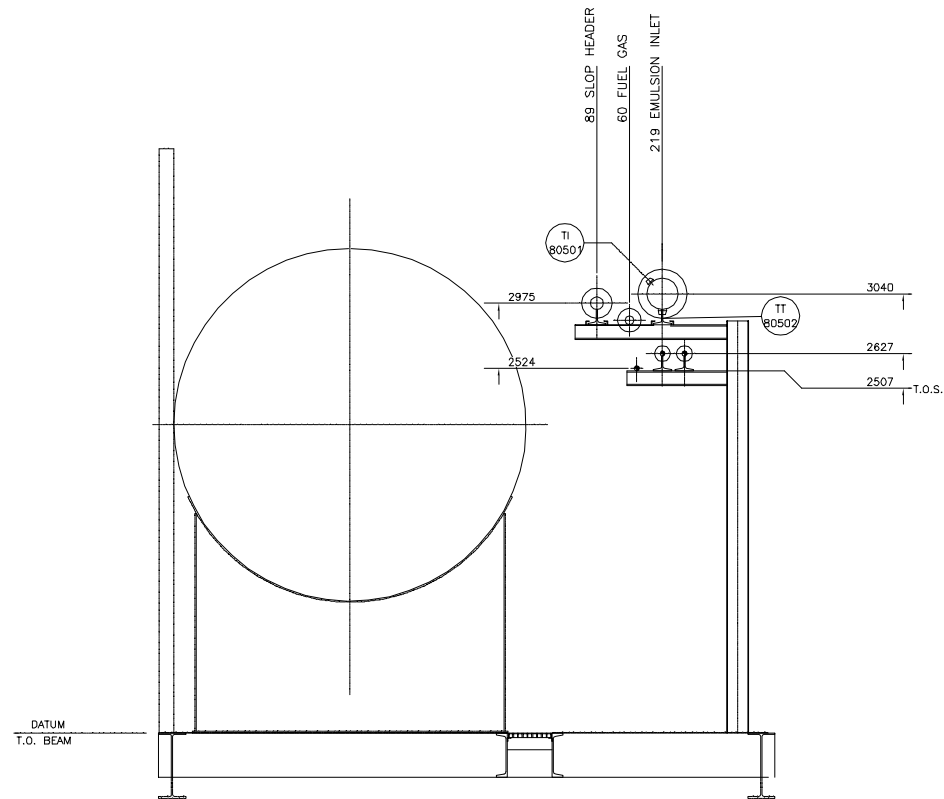


SECTION "A-A"

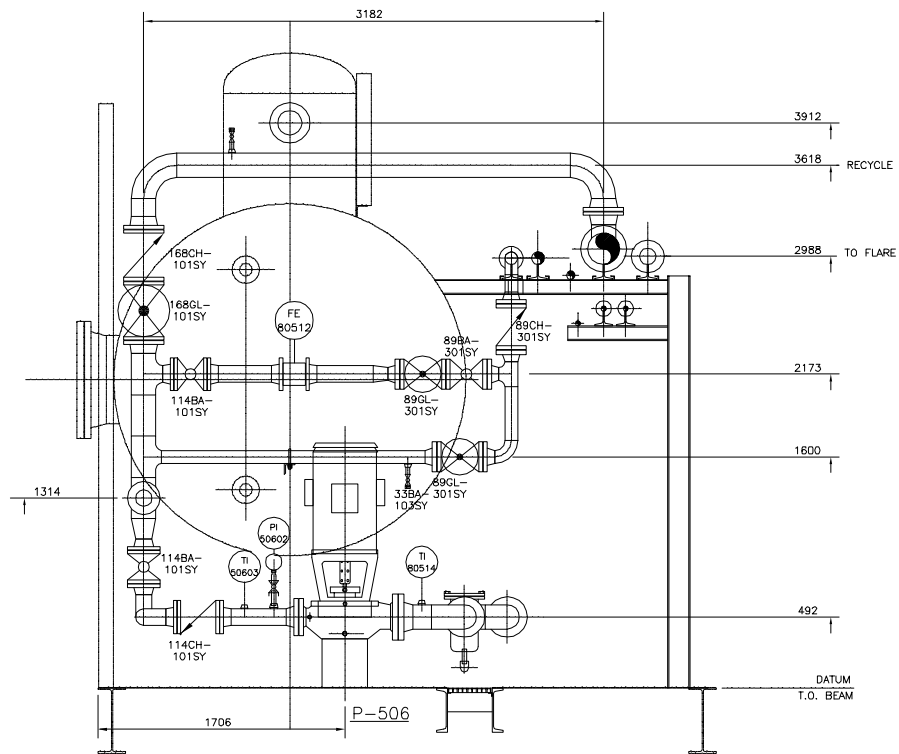


SECTION "B-B"

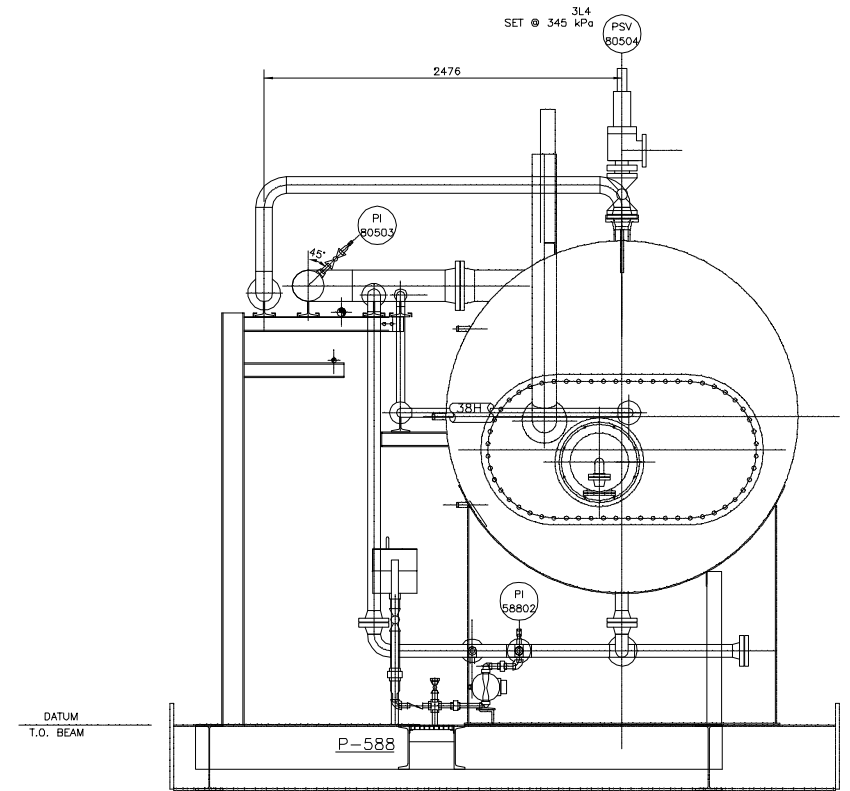


SECTION "C-C"

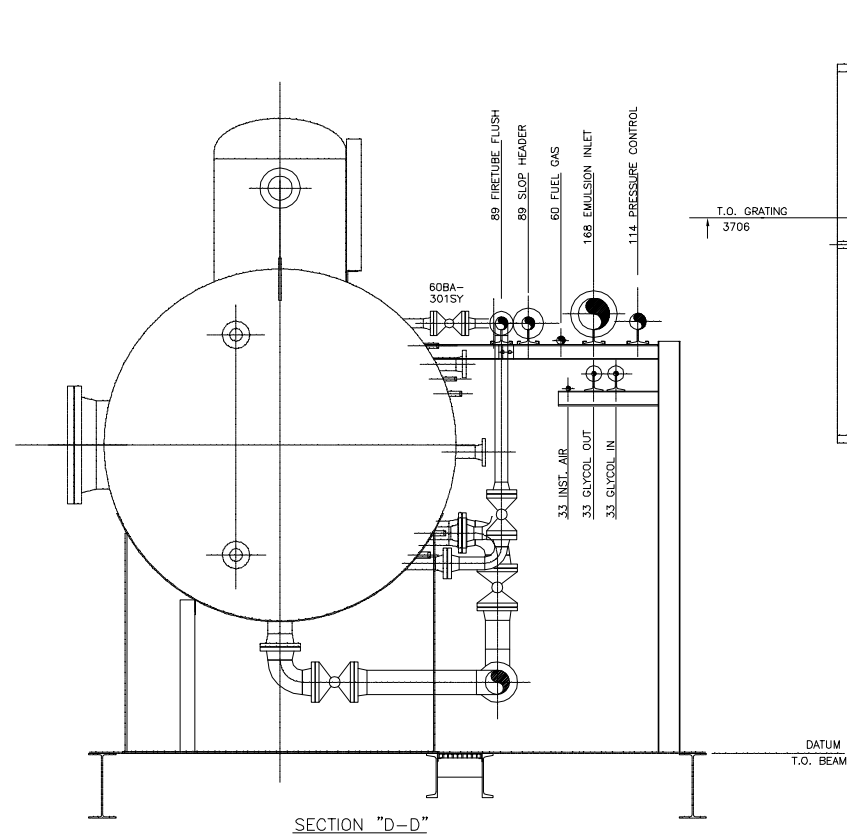

SECTION "D-D"

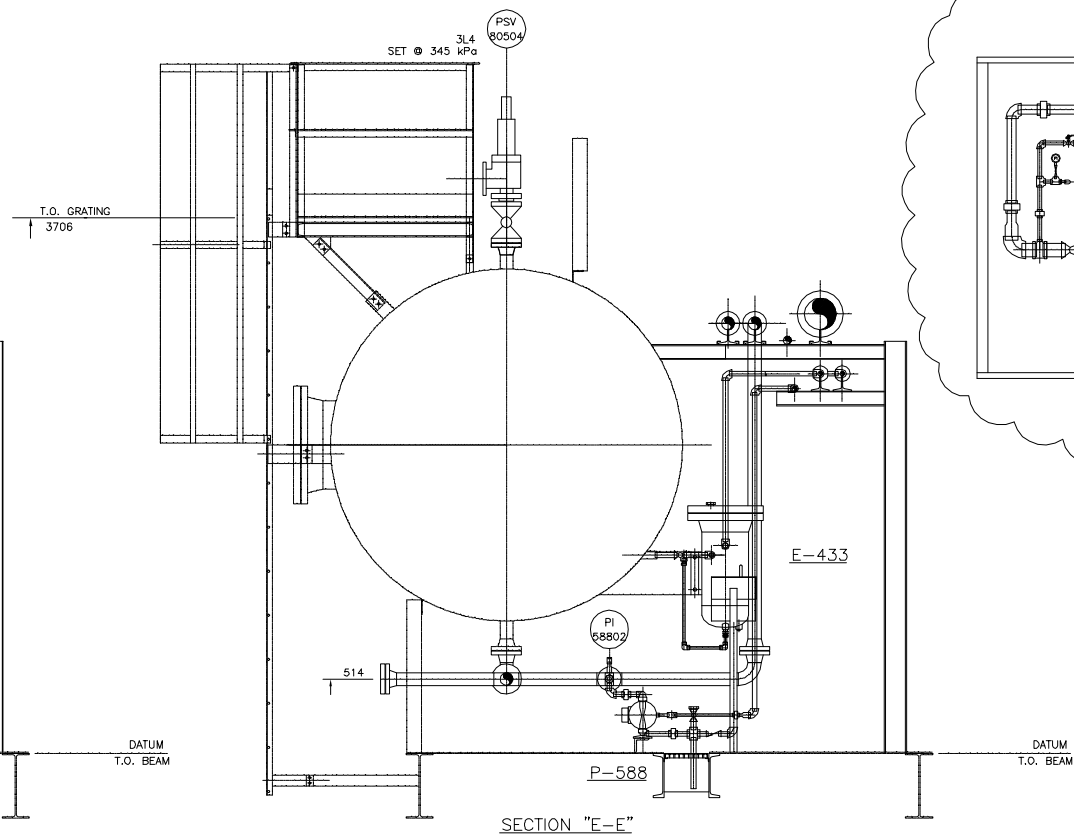

SECTION "E-E"

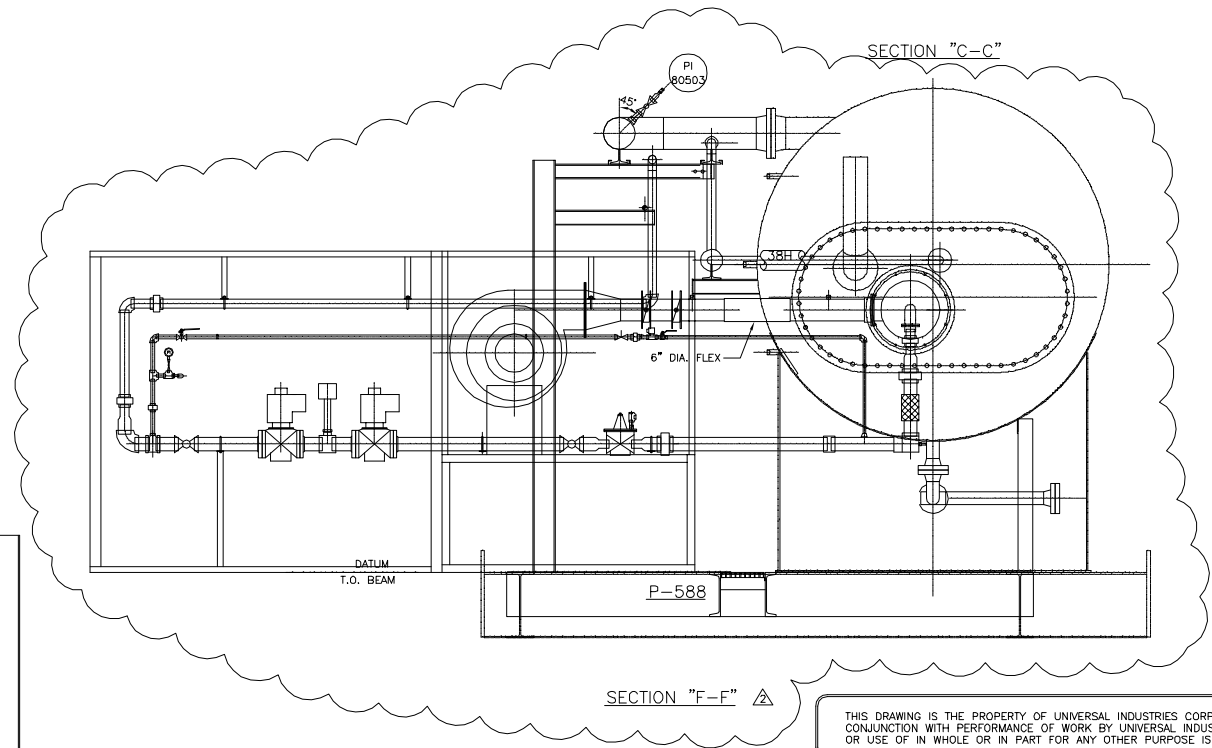

SECTION "F-F"

THIS DRAWING IS THE PROPERTY OF UNIVERSAL INDUSTRIES CORP. AND IS TO BE USED ONLY IN CONJUNCTION WITH PERFORMANCE OF WORK BY UNIVERSAL INDUSTRIES CORP. REPRODUCTION OR USE OF IN WHOLE OR IN PART FOR ANY OTHER PURPOSE IS EXPRESSLY FORBIDDEN.



CLIENT: DEER CREEK ENERGY LTD.  
C/O BOWER DAMBERGER ROLSETH ENGINEERING LTD.  
JOSLYN PHASE 2, SAGD FACILITY  
LSD 14-28-95-12 W4M

DWG TITLE: RECYCLE TREATER TR-805  
2438mm(8'-0") O.D. x 10668mm(35'-0") S/S  
PIPING LAYOUT - SECTIONS

| NO | DATE (d/m/y) | REVISIONS                                         | BY  | APPD |
|----|--------------|---------------------------------------------------|-----|------|
| 1  | 27/05/05     | ADDED VIEW "F-F", BLOWER SKID                     | EEW |      |
| 2  | 18/03/05     | REVISED AS PER PIPING SPOOLS                      | EEW | LU   |
| 3  | 03/03/05     | ISSUED FOR CONSTRUCTION                           | EEW | LU   |
| 4  | 18/02/05     | ADDED N10 & N11, CHANGED AS PER CUSTOMER COMMENTS | EEW | LU   |
| 5  | 25/01/05     | ISSUED FOR CUSTOMER APPROVAL                      | EEW | LU   |

|                        |                   |                       |                   |             |
|------------------------|-------------------|-----------------------|-------------------|-------------|
| SCALE: 1:25            | DWN BY: E. WILSON | DWG NO.: V-11699-D111 | SHEET NO.: B OF - | REV. NO.: 2 |
| DATE (d/m/y): 24/12/04 | CHKD: APPD:       |                       |                   |             |







| PROCESS INSTRUMENTATION |     |       |          |                                                                                                                |          |             |
|-------------------------|-----|-------|----------|----------------------------------------------------------------------------------------------------------------|----------|-------------|
| MK                      | QTY | SIZE  | RATING   | DESCRIPTION                                                                                                    | MATERIAL | TAG         |
| LIQUID CONTROL VALVE    |     |       |          |                                                                                                                |          |             |
| 1                       | 1   | 4"    | CL. 150  | FISHER 1051-V500 CONTROL VALVE C/W SIZE 40 ACTUATOR, NACE                                                      |          | LCV-80511   |
| 2                       | 1   |       |          | FISHER DCV-6020AC C/W AUTO CALIBRATE, 4-20 mA OUTPUT+ HART-NO DIAGNOSTIC                                       |          | LY-80511    |
| 3                       | 1   | 4"    | CL. 150  | FISHER 1051-V200 CONTROL VALVE C/W SIZE 40 ACTUATOR, NACE                                                      |          | PCV-80540   |
| 4                       | 1   |       |          | FISHER DCV-6020AC C/W AUTO CALIBRATE, 4-20 mA OUTPUT+ HART-NO DIAGNOSTIC                                       |          | LY-80540    |
| GAUGES                  |     |       |          |                                                                                                                |          |             |
| 5                       | 1   | 1/2"  | -        | WIKA 4" DIA. WET C/W 316 S.S., BOURDON TUBE & SILICON FILLED DIAPHRAGM SEAL, 0-60 PSIG                         |          | PI-50602    |
| 6                       | 1   | 1/2"  | -        | WIKA 4" DIA. WET C/W 316 S.S., BOURDON TUBE & SILICON FILLED DIAPHRAGM SEAL, 0-60 PSIG                         |          | PI-58802    |
| 7                       | 1   | 1/2"  | -        | WIKA 4" DIA. WET C/W 316 S.S., BOURDON TUBE & SILICON FILLED DIAPHRAGM SEAL, 0-60 PSIG                         |          | PI-80503    |
| 8                       | 1   | 1/2"  | -        | WIKA 4" DIA. WET C/W 316 S.S., BOURDON TUBE & SILICON FILLED DIAPHRAGM SEAL, 0-60 PSIG                         |          | PI-80515    |
| 9                       | 1   | -     | -        | TREND 0-200°C C/W 5" FACE, 1/2" x 3" STEM & 3/4" S.S. T-WELL                                                   |          | TI/TW-50603 |
| 10                      | 1   | -     | -        | TREND 0-200°C C/W 5" FACE, 1/2" x 6" STEM & 3/4" S.S. T-WELL                                                   |          | TI/TW-80501 |
| 11                      | 1   | -     | -        | TREND 0-200°C C/W 5" FACE, 1/2" x 12" STEM & 3/4" S.S. T-WELL                                                  |          | TI/TW-80505 |
| 12                      | 1   | -     | -        | TREND 0-200°C C/W 5" FACE, 1/2" x 3" STEM & 3/4" S.S. T-WELL                                                   |          | TI/TW-80510 |
| 13                      | 1   | -     | -        | TREND 0-200°C C/W 5" FACE, 1/2" x 3" STEM & 3/4" S.S. T-WELL                                                   |          | TI/TW-80514 |
| 14                      | 1   | -     | -        | TREND 0-200°C C/W 5" FACE, 1/2" x 12" STEM & 3/4" S.S. T-WELL                                                  |          | TI/TW-80529 |
| 15                      | 1   | -     | -        | TREND 0-200°C C/W 5" FACE, 1/2" x 12" STEM & 3/4" S.S. T-WELL                                                  |          | TI/TW-80530 |
| 16                      | 1   | -     | -        | TREND 0-200°C C/W 5" FACE, 1/2" x 12" STEM & 3/4" S.S. T-WELL                                                  |          | TI/TW-80531 |
| 17                      | 1   | -     | -        | TREND 0-200°C C/W 5" FACE, 1/2" x 12" STEM & 3/4" S.S. T-WELL                                                  |          | TI/TW-80532 |
| 18                      | 1   | -     | -        | TREND 0-200°C C/W 5" FACE, 1/2" x 12" STEM & 3/4" S.S. T-WELL                                                  |          | TI/TW-80533 |
| 19                      | 1   | -     | -        | TREND 0-200°C C/W 5" FACE, 1/2" x 12" STEM & 3/4" S.S. T-WELL                                                  |          | TI/TW-80534 |
| METERS                  |     |       |          |                                                                                                                |          |             |
| 20                      | 1   | 4"    | -        | WAFER STYLE McCROMETER V-CONE FLOW METER VH-04Q15N3 C/W CENTERING RING KIT                                     |          | FE-80512    |
| 21                      | 1   | 4"    | -        | WAFER STYLE McCROMETER V-CONE FLOW METER VH-04Q15N3 C/W CENTERING RING KIT                                     |          | FE-80528    |
| 22                      | 1   | -     | -        | (DETAILS REQUIRED FROM OWNER)                                                                                  |          | FE-80535    |
| REGULATORS              |     |       |          |                                                                                                                |          |             |
| 23                      | 1   | -     | -        | FISHER 67 CFR REGULATOR C/W STD. TRIM AND PRESSURE INDICATOR                                                   |          | PCV-80511   |
| 24                      | 1   | -     | -        | FISHER 67 CFR REGULATOR C/W STD. TRIM AND PRESSURE INDICATOR                                                   |          | PCV-80540b  |
| 25                      | 1   | -     | -        | MASTER PNEUMATIC FILTER/REGULATOR CFDR1004G C/W 1/2" GAUGE                                                     |          | PCV-58802   |
| TRANSMITTERS            |     |       |          |                                                                                                                |          |             |
| 26                      | 1   | -     | -        | ROSEMOUNT 3051CD2A02A1AS2M5B4C6 DIFFERENTIAL PRESSURE TRANSMITTER C/W TWO 1199DDB15AFFW72DAA1G DIAPHRAGM SEALS |          | dPT-80508   |
| 27                      | 1   | -     | -        | ROSEMOUNT 3051CD2A02A1AS2M5B4C6 DIFFERENTIAL PRESSURE TRANSMITTER C/W TWO 1199DDB15AFFW72DAA1G DIAPHRAGM SEALS |          | dPT-80511   |
| 28                      | 1   | -     | -        | ROSEMOUNT 3051CD2A02A1AS5C6 DIFFERENTIAL PRESSURE TRANSMITTER C/W 5 VALVE MANIFOLD MODEL 0305RC52B11B4         |          | FT-80512    |
| 29                      | 1   | -     | -        | ROSEMOUNT 3051CD2A02A1AS5C6 DIFFERENTIAL PRESSURE TRANSMITTER C/W 5 VALVE MANIFOLD MODEL 0305RC52B11B4         |          | FT-80528    |
| 30                      | 1   | -     | -        | ROSEMOUNT 2088G2S2ZA1S1M5B4C6 PRESSURE TRANSMITTER C/W 1199WDC15AFFW72DAA1G REMOTE DIAPHRAGM SEAL              |          | PIT-80540   |
| 31                      | 1   | -     | -        | ROSEMOUNT 3144PD1A1M5B4K6 TEMPERATURE INDICATING TRANSMITTER 4-20 Ma                                           |          | TT-80502    |
| 32                      | 1   | -     | -        | ROSEMOUNT RTD MODEL 0068R21C30A060T28E6 C/W S.S. THERMOWELL                                                    |          | TE/TW-80502 |
| 33                      | 1   | -     | -        | ROSEMOUNT 3144PD1A1M5B4K6 TEMPERATURE INDICATING TRANSMITTER 4-20 Ma                                           |          | TT-80506    |
| 34                      | 1   | -     | -        | ROSEMOUNT RTD MODEL 0068R21C30A120T28E6 C/W S.S. THERMOWELL                                                    |          | TE-80506    |
| RELIEF VALVE            |     |       |          |                                                                                                                |          |             |
| 35                      | 1   | 3"x4" | CL. 150  | RELIEF VALVE, FARRIS 3"-150x4"-150 MODEL 26LB10L-12/00 NACE 1 TRIM, SET AT 345 kPag                            |          | PSV-80504   |
| PUMPS                   |     |       |          |                                                                                                                |          |             |
| 36                      | 1   | 1"x1" | -        | WARREN RUPP SANDPIPER 2 DBL DIAPHRAGMS PUMP S1FB1AGTANS000                                                     |          | P-588       |
| 37                      | 1   | 4"x6" | -        | UNION 4x6x8 VLK API-610 VERTICAL INLINE CENTRIFUGAL PUMP                                                       |          | P-506       |
| BURNER INSTRUMENTATION  |     |       |          |                                                                                                                |          |             |
| 38                      | 1   | 2"    | -        | MURPHY 2" NPT ELECTRIC LEVEL SWITCH MODEL # L1200-SSSF C/W SS FLOAT                                            |          | LSL-80507   |
| 39                      | 1   | 3"    | -        | PRESSURE REGULATOR                                                                                             |          | PRV-80517   |
| 40                      | 1   | 3"    | -        | SOLENOID VALVE                                                                                                 |          | SAV-80506   |
| 41                      | 1   | 3"    | -        | SHUT-OFF VALVE                                                                                                 |          | SDV-80519   |
| 42                      | 1   | 2"    | -        | RATIO VALVE 10315                                                                                              |          | PCV-80537   |
| 43                      | 1   | 3"    | -        | ALOR ADJ. VALVE 30212                                                                                          |          | -           |
| 44                      | 1   | 1/2"  | -        | ADJ. PILOT COCK 102627                                                                                         |          | -           |
| 45                      | 2   | 1/2"  | -        | SOLENOID VALVE                                                                                                 |          | SAV-80526   |
| 46                      | 1   | 1/2"  | -        | PRESSURE INDICATOR                                                                                             |          | PI-80525    |
| 47                      | 1   | 3/4"  | -        | PRESSURE REGULATOR                                                                                             |          | PRV-80524   |
| 48                      | 1   | -     | -        | BLOWER SMJ 101023 20 HP                                                                                        |          | K-603       |
| 49                      | 1   | -     | -        | AIR FLOW SW. JD2                                                                                               |          | PSL-80539   |
| 50                      | 1   | -     | -        | 124BV-B 500915                                                                                                 |          | -           |
| 51                      | 1   | -     | -        | 124BV-AB 500998                                                                                                |          | TCV-80538   |
| 52                      | 1   | -     | -        | MOD. MOTOR M9484E 4003 4-20mA 82176                                                                            |          | -           |
| 53                      | 1   | -     | -        | BURNER IJ8                                                                                                     |          | -           |
| 54                      | 2   | 3"    | CL. 2000 | BALL VALVE RP SCR'D, NACE                                                                                      | C.S.     | NUTRON      |
| 55                      | 8   | 1/2"  | CL. 800  | NEEDLE VALVE SCR'D                                                                                             | -        | -           |
| 56                      | 1   | 1/2"  | -        | PRESSURE INDICATOR                                                                                             |          | PI-80520    |
| 57                      | 1   | 1/2"  | -        | PRESSURE INDICATOR                                                                                             |          | PI-80516    |
| 58                      | 1   | 1/2"  | -        | PRESSURE INDICATOR                                                                                             |          | PI-80521    |
| 59                      | 1   | 1/2"  | -        | HIGH PRESSURE SWITCH                                                                                           |          | PSH-80536   |
| 60                      | 1   | 1/2"  | -        | LOW PRESSURE SWITCH                                                                                            |          | PSL-80536   |

| MK  | QTY | SIZE | RATING   | DESCRIPTION                                                 | MATERIAL | BRAND              |
|-----|-----|------|----------|-------------------------------------------------------------|----------|--------------------|
| 70  | 4   | 6"   | CL. 150  | BALL VALVE RP RF HT4/PEEK SEATS, 316 S.S. BALL & STEM, NACE | -        | KUKA               |
| 71  | 8   | 4"   | CL. 150  | BALL VALVE RP RF HT4/PEEK SEATS, 316 S.S. BALL & STEM, NACE | -        | KUKA               |
| 72  | 1   | 4"   | CL. 150  | BALL VALVE RF C.S.O., NACE                                  | -        | KUKA               |
| 73  | 10  | 3"   | CL. 300  | BALL VALVE RP RF HT4/PEEK SEATS, 316 S.S. BALL & STEM, NACE | -        | KUKA               |
| 74  | 1   | 3"   | CL. 150  | BALL VALVE RF C.S.O, NACE                                   | -        | KUKA               |
| 75  | 1   | 2"   | CL. 300  | BALL VALVE RP RF HT4/PEEK SEATS, 316 S.S. BALL & STEM, NACE | -        | KUKA               |
| 76  | -   | 2"   | CL. 2000 | BALL VALVE RP SCR'D, NACE                                   | C.S.     | NUTRON             |
| 77  | 1   | 2"   | CL. 2000 | BALL VALVE RP SCR'D, SPRING LOADED, NACE                    | C.S.     | NUTRON             |
| 78  | 11  | 1"   | CL. 2000 | BALL VALVE RP SW x SCR'D, NACE                              | C.S.     | NUTRON             |
| 79  | 8   | 1"   | CL. 2000 | BALL VALVE RP SCR'D, NACE                                   | C.S.     | NUTRON             |
| 80  | 1   | 3/4" | CL. 2000 | BALL VALVE RP SCR'D, NACE                                   | C.S.     | NUTRON             |
| 81  |     |      |          |                                                             |          |                    |
| 82  | 1   | 6"   | CL. 150  | GLOBE VALVE RF, BOLTED BONNET, SWIVEL PLUG                  | -        | NAVCO              |
| 83  | 2   | 3"   | CL. 300  | GLOBE VALVE RF, BOLTED BONNET, SWIVEL PLUG                  | -        | NAVCO              |
| 84  | 1   | 4"   | CL. 150  | GLOBE VALVE RF, BOLTED BONNET, SWIVEL PLUG                  | -        | NAVCO              |
| 85  | 1   | 1"   | CL. 800  | GLOBE VALVE SW, OS & Y, BOLTED BONNET                       | -        | NAVCO              |
| 86  | 1   | 1"   | CL. 800  | GLOBE VALVE SCR'D, OS & Y, BOLTED BONNET                    | -        | NAVCO              |
| 87  | 1   | 1"   | CL. 800  | GATE VALVE SW, OS & Y, BOLTED BONNET                        | -        | NAVCO              |
| 88  |     |      |          |                                                             |          |                    |
| 89  |     |      |          |                                                             |          |                    |
| 90  | 2   | 6"   | CL. 150  | SWING CHECK VALVE RF, BOLTED TRIM, RENEWABLE SEAT, NACE     | -        | NAVCO/<br>WHEATLEY |
| 91  | 4   | 4"   | CL. 150  | SWING CHECK VALVE RF, BOLTED TRIM, RENEWABLE SEAT, NACE     | -        | NAVCO/<br>WHEATLEY |
| 92  | 1   | 3"   | CL. 300  | SWING CHECK VALVE RF, BOLTED TRIM, RENEWABLE SEAT, NACE     | -        | NAVCO/<br>WHEATLEY |
| 93  | 5   | 1"   | CL. 800  | SWING CHECK VALVE SCR'D, LIFTING CHECK, NACE                | -        | NAVCO/<br>WHEATLEY |
| 94  |     |      |          |                                                             |          |                    |
| 95  | 2   | 1/2" | CL. 800  | NEEDLE VALVE SCR'D                                          | -        | -                  |
| 96  |     |      |          |                                                             |          |                    |
| 97  |     |      |          |                                                             |          |                    |
| 98  | 1   | 6"   | CL. 150  | FLANGED BASKET TYPE STRAINER MODEL: SERIES B150F STYLE 1    | C.S.     | IFC                |
| 99  |     |      |          |                                                             |          |                    |
| 100 |     |      |          |                                                             |          |                    |
| 101 |     |      |          |                                                             |          |                    |
| 102 |     |      |          |                                                             |          |                    |
| 103 |     |      |          |                                                             |          |                    |

|                                                                                                                                                                                                                                                   | 31/03/05            | UPDATED INSTRUMENTS LIST |                         | EEW  |                     |               |
|---------------------------------------------------------------------------------------------------------------------------------------------------------------------------------------------------------------------------------------------------|---------------------|--------------------------|-------------------------|------|---------------------|---------------|
|                                                                                                                                                                                                                                                   | 28/03/05            | REVISIONS AS SHOWN       |                         | EEW  | LU                  |               |
|                                                                                                                                                                                                                                                   | 18/03/05            | ISSUED FOR CONSTRUCTION  |                         | EEW  | LU                  |               |
| NO                                                                                                                                                                                                                                                | DATE (d/m/y)        | REVISIONS                | BY                      | APPD |                     |               |
| REVISIONS                                                                                                                                                                                                                                         |                     |                          |                         |      |                     |               |
| THIS DRAWING IS THE PROPERTY OF UNIVERSAL INDUSTRIES CORP. AND IS TO BE USED ONLY IN CONJUNCTION WITH PERFORMANCE OF WORK BY UNIVERSAL INDUSTRIES CORP.. REPRODUCTION OR USE OF IN WHOLE OR IN PART FOR ANY OTHER PURPOSE IS EXPRESSLY FORBIDDEN. |                     |                          |                         |      |                     |               |
| <div><div></div><div>UNIVERSAL INDUSTRIES</div><div>Ph: (780) 875-6161      Fax: (780) 875-6169</div></div>                                                  |                     |                          |                         |      |                     |               |
| CLIENT<br>DEER CREEK ENERGY LTD.<br>JOSLYN PHASE 2, SAGD BATTERY                                                                                                                                                                                  |                     |                          |                         |      |                     |               |
| DWG TITLE<br>RECYCLE TREATER TR-805<br>PROCESS AND INSTRUMENTATION DIAGRAM<br>PROCESS INSTRUMENTATION LIST                                                                                                                                        |                     |                          |                         |      |                     |               |
| SCALE<br>N.T.S.                                                                                                                                                                                                                                   | DWN BY<br>E. WILSON |                          | DWG NO.<br>V-11699-D113 |      | SHEET NO.<br>2 of 2 | REV. NO.<br>2 |
| DATE (d/m/y)<br>16/03/05                                                                                                                                                                                                                          | CHKD                | APPD                     |                         |      |                     |               |

\\DWG\\H11699\\11311699SHT2

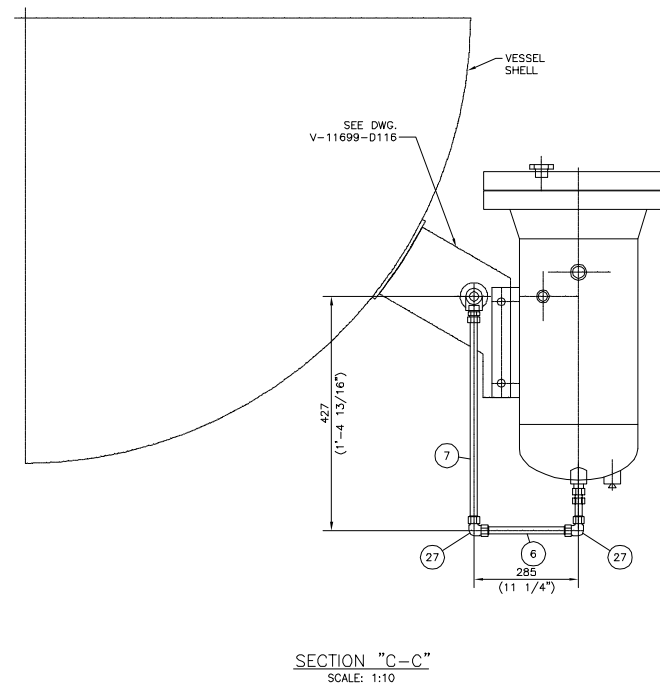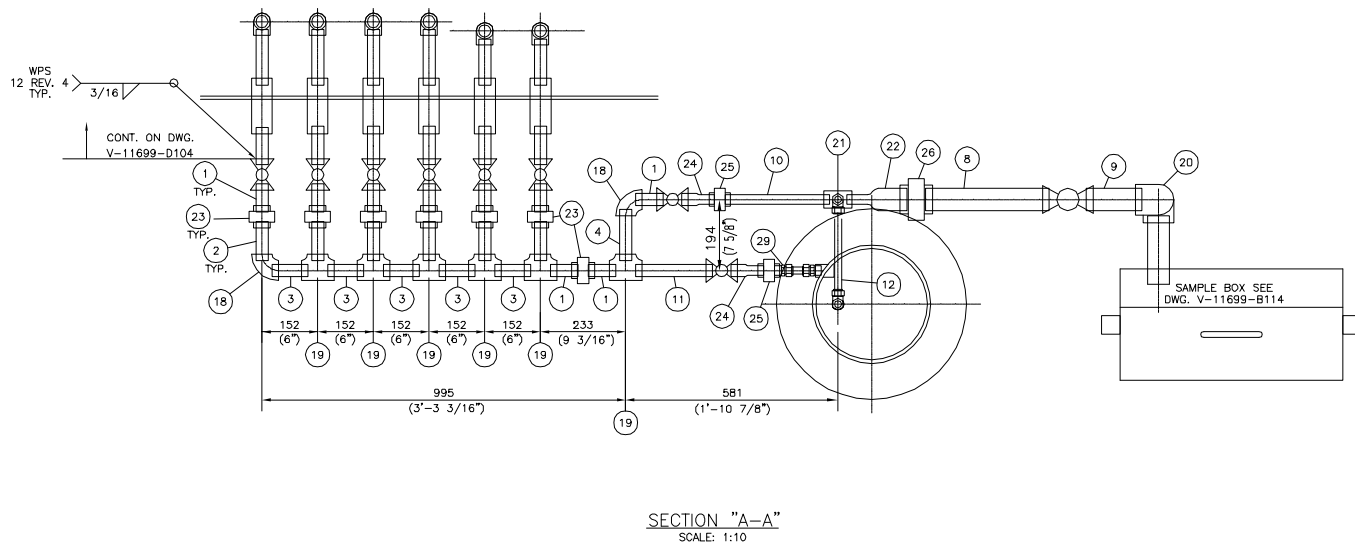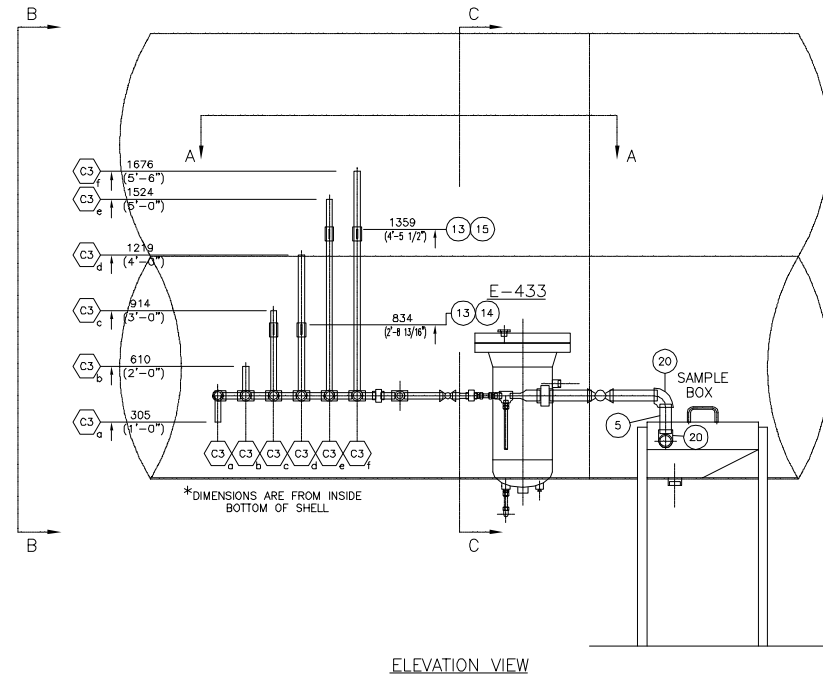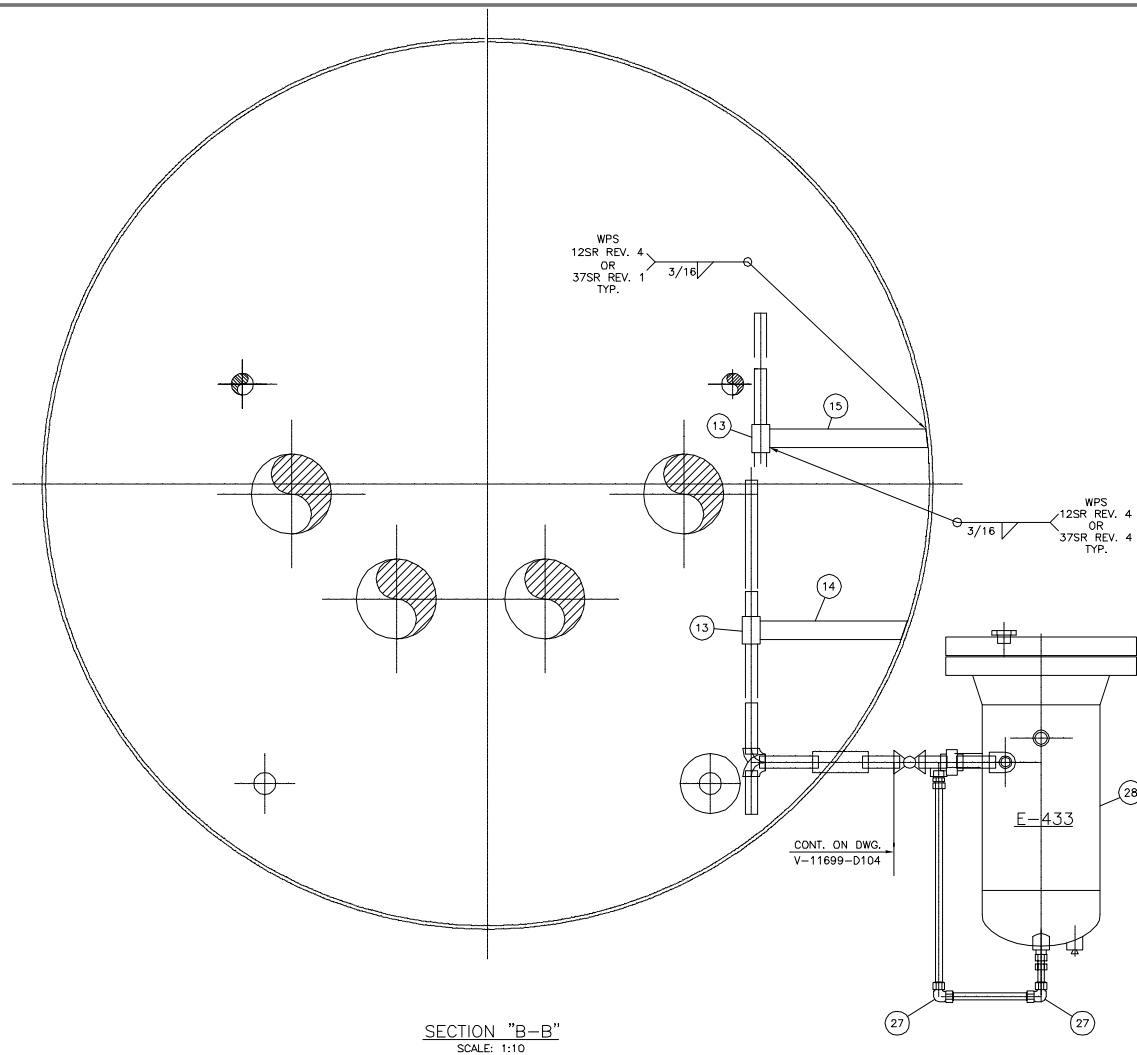

## MATERIAL LIST

| MK | QTY | DESCRIPTION                                             | MATERIAL                  | WT  |
|----|-----|---------------------------------------------------------|---------------------------|-----|
| 1  | 9   | NIPPLE 1" SCH XS x 3" LG. SMLS TBE                      | SA-106-B                  | 5   |
| 2  | 6   | PIPE 1" SCH XS x 4 3/16" LG. SMLS TBE                   | SA-106-B                  | 1   |
| 3  | 5   | PIPE 1" SCH XS x 3 7/8" LG. SMLS TBE                    | SA-106-B                  | 4   |
| 4  | 1   | PIPE 1" SCH XS x 5 1/2" LG. SMLS TBE                    | SA-106-B                  | 1   |
| 5  | 1   | PIPE 2" SCH XS x 6 7/16" LG. SMLS TBE                   | SA-106-B                  | 3   |
| 6  | 1   | TUBING 3/4" x 0.065" WALL x 10 1/16" LG.                |                           | 1   |
| 7  | 1   | TUBING 3/4" x 0.065" WALL x 1'-10 3/4" LG.              |                           | 1   |
| 8  | 1   | PIPE 2" SCH XS x 1'-1 5/16" LG. SMLS TBE                | SA-106-B                  | 6   |
| 9  | 1   | NIPPLE 2" SCH XS x 6" LG. SMLS TBE                      | SA-106-B                  | 3   |
| 10 | 1   | PIPE 3/4" SCH XS x 11 3/16" LG. SMLS TBE                | SA-106-B                  | 1   |
| 11 | 1   | PIPE 1" SCH XS x 8 1/4" LG. SMLS TBE                    | SA-106-B                  | 2   |
| 12 |     |                                                         |                           |     |
| 13 | 4   | PIPE 1 1/2" SCH XS x 3" LG. SMLS PBE                    | SA-106-B                  | 4   |
| 14 | 2   | FLATBAR 1/4" THK. x 2" x 1'-3 7/8" LG. (*)              | SA-36                     | 5   |
| 15 | 2   | FLATBAR 1/4" THK. x 2" x 1'-5 1/16" LG. (*)             | SA-36                     | 5   |
| 16 |     |                                                         |                           |     |
| 17 |     |                                                         |                           |     |
| 18 | 2   | ELBOW 1" CLASS 3000 F.S. SCR'D x 90'                    | SA-105                    | 5   |
| 19 | 6   | TEE 1" CLASS 3000 F.S. SCR'D                            | SA-105                    | 18  |
| 20 | 2   | ELBOW 2" CLASS 3000 F.S. SCR'D x 90'                    | SA-105                    | 11  |
| 21 | 1   | TEE 3/4" CLASS 3000 F.S. SCR'D                          | SA-105                    | 2   |
| 22 | 1   | SWAGE 2" x 3/4" SCH XS TBE                              | SA-234-WPB                | 2   |
| 23 | 7   | UNION 1" CLASS 3000 F.S. SCR'D                          | SA-105                    | 12  |
| 24 | 2   | SWAGE 1" x 3/4" SCH XS TBE                              | SA-234-WPB                | 2   |
| 25 | 2   | UNION 3/4" CLASS 3000 F.S. SCR'D                        | SA-105                    | 2   |
| 26 | 1   | UNION 2" CLASS 3000 F.S. SCR'D                          | SA-105                    | 5   |
| 27 | 2   | UNION ELBOW 3/4" x 90' TUBING (PARKER 12EE12)           | S.S.                      | 1   |
| 28 | 1   | SAMPLE COOLER                                           | REF. DWG. EDS-6036(11699) | 496 |
| 29 | 1   | MALE CONNECTOR 3/4" NPT x 3/4" TUBING (PARKER 12MSC12N) | S.S.                      | 1   |
| 30 |     |                                                         |                           |     |
| 31 |     |                                                         |                           |     |
| 32 |     |                                                         |                           |     |
| 33 |     |                                                         |                           |     |
| 34 |     |                                                         |                           |     |
| 35 |     |                                                         |                           |     |
| 36 |     |                                                         |                           |     |
| 37 |     |                                                         |                           |     |
| 38 |     |                                                         |                           |     |
| 39 |     |                                                         |                           |     |
| 40 |     |                                                         |                           |     |

NOTES:  
1. ALL DIMENSIONS ARE IN S.I. & IMPERIAL UNITS. DIMENSIONS IN BRACKETS ARE IMPERIAL HARD CONVERSIONS FOR SHOP REFERENCE ONLY.  
2. ITEMS IDENTIFIED WITH A (\*) ARE ATTACHED TO THE PRESSURE ENVELOPE & REQUIRE A HEAT NUMBER TO BE HARD STAMPED & RECORDED BY Q.C..

SUBTOTAL x 1.06  
TOTAL (lbs.) 635

|          |              |                         |           |     |      |
|----------|--------------|-------------------------|-----------|-----|------|
| NO       | DATE (d/m/y) | ISSUED FOR CONSTRUCTION | REVISIONS | BY  | APPD |
| 02/03/05 |              |                         |           | EEW |      |


















THIS DRAWING IS THE PROPERTY OF UNIVERSAL INDUSTRIES CORP. AND IS TO BE USED ONLY IN CONJUNCTION WITH PERFORMANCE OF WORK BY UNIVERSAL INDUSTRIES CORP. REPRODUCTION OR USE OF IN WHOLE OR IN PART FOR ANY OTHER PURPOSE IS EXPRESSLY FORBIDDEN.



CLIENT  
DEER CREEK ENERGY LTD.  
C/O BOWER DAMBERGER ROLSETH ENGINEERING LTD.  
JOSLYN PHASE 2, SAGD FACILITY

DWG TITLE  
RECYCLE TREATER TR-805  
2438mm(8'-0") O.D. x 10668mm(35'-0") S/S  
SAMPLE SYSTEM

|                          |                     |                         |                     |               |
|--------------------------|---------------------|-------------------------|---------------------|---------------|
| SCALE<br>1:20            | DWN BY<br>E. WILSON | DWG NO.<br>V-11699-D122 | SHEET NO.<br>1 OF 1 | REV. NO.<br>0 |
| DATE (d/m/y)<br>23/02/05 | CHKD<br>APPD        |                         |                     |               |

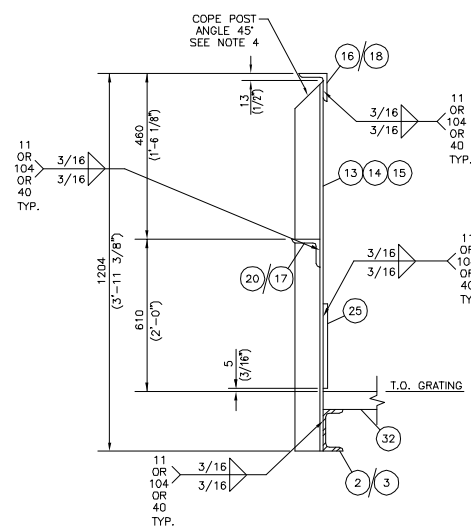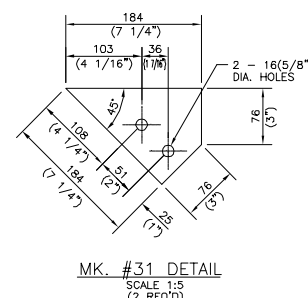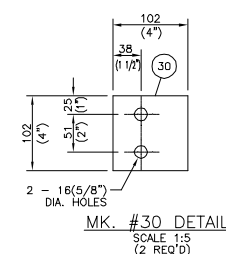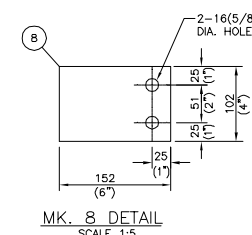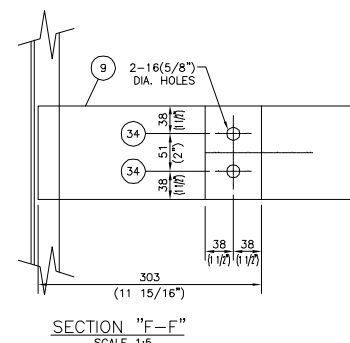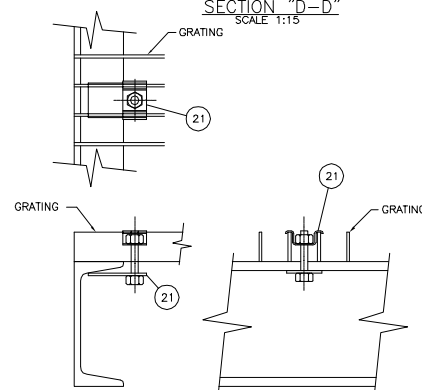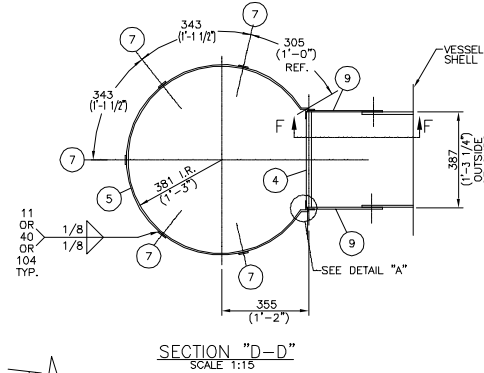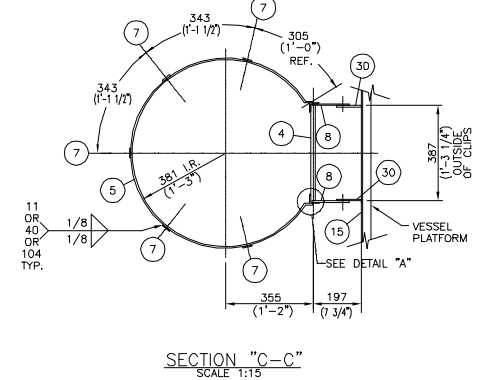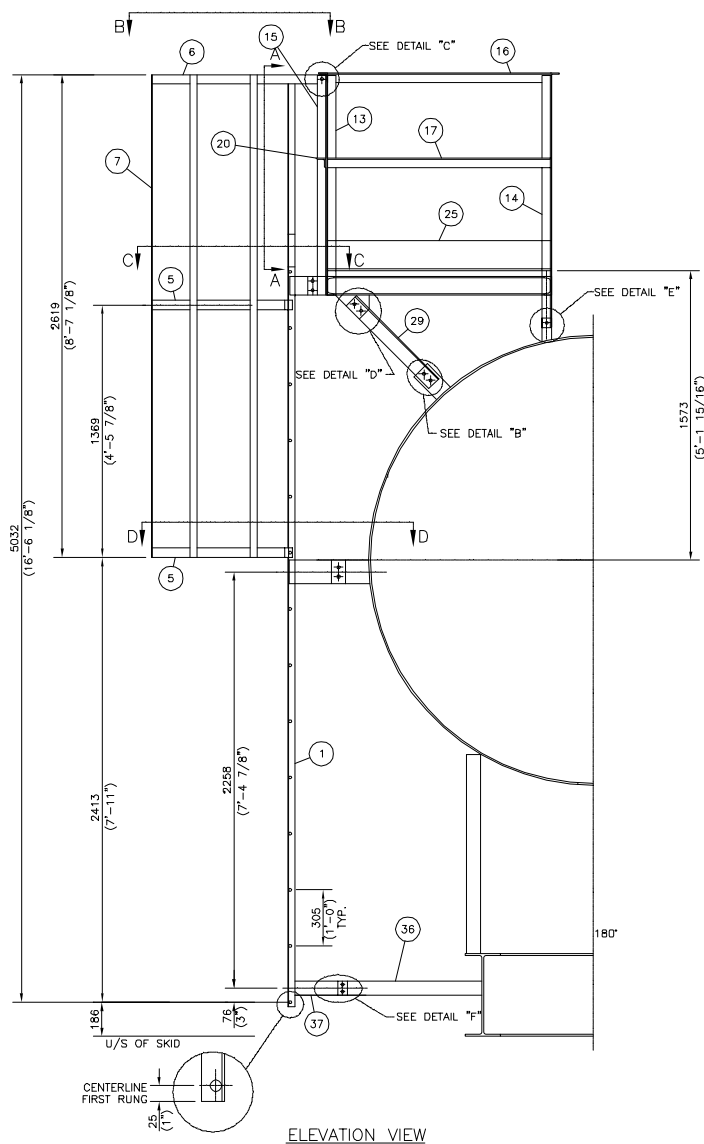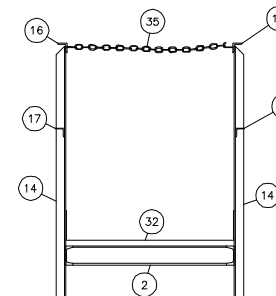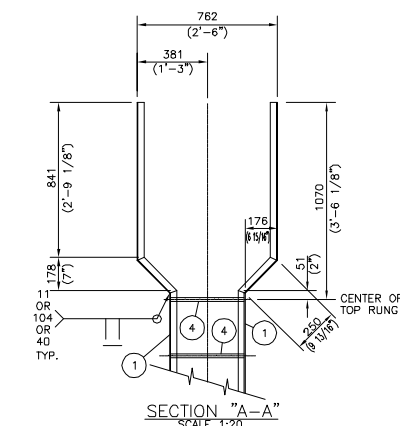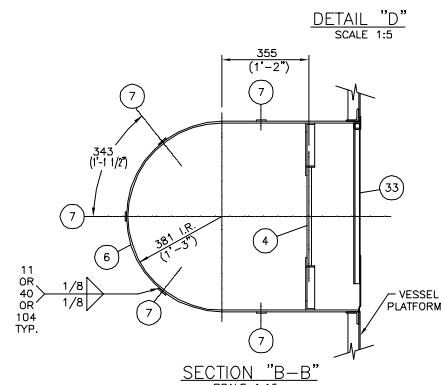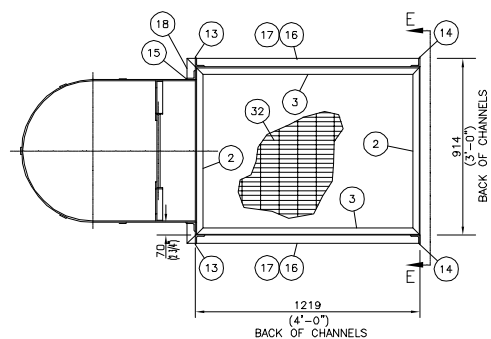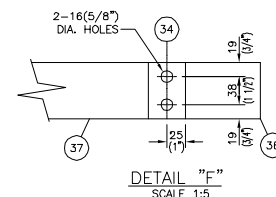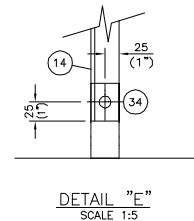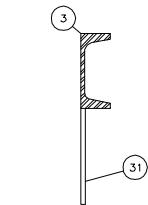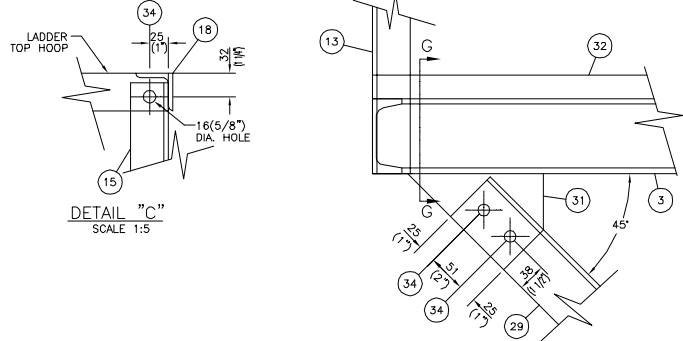

| MATERIAL LIST |     |                                                                |                              |     |
|---------------|-----|----------------------------------------------------------------|------------------------------|-----|
| MK            | QTY | DESCRIPTION                                                    | MATERIAL                     | WT  |
| 1             | 2   | ANGLE 1 1/2" x 1 1/2" x 3/16" x 16'-10 1/8" LG.                | G40.21-44W                   | 61  |
| 2             | 2   | CHANNEL C4 x 5.4# x 3'-0" LG.                                  | G40.21-44W                   | 42  |
| 3             | 2   | CHANNEL C4 x 5.4# x 4'-0" LG.                                  | G40.21-44W                   | 33  |
| 4             | 14  | ROUND BAR 5/8" DIA. x 1'-3 3/4" LG.                            | G40.21-44W                   | 32  |
| 5             | 2   | FLATBAR 1/4" THK. x 2" x 6'-8" LG. (STOCK HOOP)                | G40.21-44W                   | 23  |
| 6             | 1   | FLATBAR 1/4" THK. x 2" x 7'-10 3/4" LG.                        | G40.21-44W                   | 13  |
| 7             | 5   | FLATBAR 3/16" THK. x 1 1/2" x 8'-7 1/8" LG.                    | G40.21-44W                   | 55  |
| 8             | 2   | FLATBAR 1/4" THK. x 4" x 6" LG.                                | G40.21-44W                   | 5   |
| 9             | 2   | PLATE 1/4" THK. x 5" x 1'-0" LG.                               | G40.21-44W                   | 9   |
| 10            |     |                                                                |                              |     |
| 11            |     |                                                                |                              |     |
| 12            |     |                                                                |                              |     |
| 13            | 2   | ANGLE 2" x 2" x 1/4" x 3'-10 7/8" LG.                          | G40.21-44W                   | 25  |
| 14            | 2   | ANGLE 2" x 2" x 1/4" x 4'-5 13/16" LG.                         | G40.21-44W                   | 29  |
| 15            | 2   | ANGLE 2" x 2" x 1/4" x 3'-10 7/8" LG.                          | G40.21-44W                   | 25  |
| 16            | 2   | ANGLE 2" x 2" x 1/4" x 4'-1 3/4" LG.                           | G40.21-44W                   | 26  |
| 17            | 2   | ANGLE 2" x 2" x 1/4" x 3'-11 1/2" LG.                          | G40.21-44W                   | 25  |
| 18            | 2   | ANGLE 2" x 2" x 1/4" x 4 1/2" LG.                              | G40.21-44W                   | 2   |
| 19            |     |                                                                |                              |     |
| 20            | 2   | ANGLE 2" x 2" x 1/4" x 4 1/4" LG.                              | G40.21-44W                   | 2   |
| 21            | 4   | FISHER & LUDLOW GRATING SADDLE CLIPS C/W BOTTOM PLATE          | C.S.<br>GALVANIZED           | 1   |
| 22            |     |                                                                |                              |     |
| 23            |     |                                                                |                              |     |
| 24            |     |                                                                |                              |     |
| 25            | 2   | FLATBAR 3/16" THK. x 6" x 4'-0" LG.                            | G40.21-44W                   | 31  |
| 26            |     |                                                                |                              |     |
| 27            |     |                                                                |                              |     |
| 28            |     |                                                                |                              |     |
| 29            | 2   | ANGLE 3" x 3" x 1/4" x 2'-1 1/16" LG.                          | G40.21-44W                   | 20  |
| 30            | 2   | FLATBAR 1/4" THK. x 4" x 4" LG.                                | G40.21-44W                   | 2   |
| 31            | 2   | PLATE 1/4" THK. x 5 1/8" x 7 1/4" LG.                          | G40.21-44W                   | 5   |
| 32            | 1   | GRATING 3'-0" x 4'-0" LG; TYPE 19-4<br>C/W 1 1/4" x 3/16" BARS | GALV. SERRATED<br>G40.21-44W | 106 |
| 33            | 1   | PLATFORM SAFETY GATE                                           | REF. DWG.<br>V-11699-A126    | 13  |
| 34            | 24  | BOLT 1/2" DIA. x 1 1/2" LG. C/W HEX NUT & WASHER               | A-325                        | 4   |
| 35            | 1   | PROOF CHAIN 3/16" THK. x 3'-0" LG. TOTAL                       | C.S.                         | 4   |
| 36            | 2   | FLATBAR 1/4" THK. x 3" x 2'-6 13/16" LG.                       | G40.21-44W                   | 13  |
| 37            | 2   | FLATBAR 1/4" THK. x 3" x 11 1/4" LG.                           | G40.21-44W                   | 5   |
| 38            |     |                                                                |                              |     |
| 39            |     |                                                                |                              |     |
| 40            |     |                                                                |                              |     |

**NOTES:**

1. ALL DIMENSIONS ARE IN S.I. & IMPERIAL UNITS. DIMENSIONS IN BRACKETS ARE IMPERIAL HARD CONVERSIONS FOR SHOP REFERENCE ONLY.
2. SANDBLAST TO SSPC-SP6 AND APPLY ONE COAT ALKYD 1.5 - 2 MILS DFT
3. TWO COATS OF ENAMEL BLACK (5B) 1.5-3MILS DFT.
4. HANGRAILS, MIDDLE RAIL SUPPORTS & KICK PLATES ONE COAT SAFETY YELLOW (Y-18)
5. GRIND EDGES SMOOTH.
6. MK'S 16 & 18 TO BE MITRED 45° ONE END ONLY.

|           |              |                         |     |      |
|-----------|--------------|-------------------------|-----|------|
| △         |              |                         |     |      |
| △         |              |                         |     |      |
| △         | 01/03/05     | ISSUED FOR CONSTRUCTION | EEW |      |
| NO        | DATE (d/m/y) | REVISIONS               | BY  | APPD |
| REVISIONS |              |                         |     |      |

THIS DRAWING IS THE PROPERTY OF UNIVERSAL INDUSTRIES CORP. AND IS TO BE USED ONLY IN CONJUNCTION WITH PERFORMANCE OF WORK BY UNIVERSAL INDUSTRIES CORP.. REPRODUCTION OR USE OF IN WHOLE OR IN PART FOR ANY OTHER PURPOSE IS EXPRESSLY FORBIDDEN.



CLIENT  
DEER CREEK ENERGY LTD.  
C/O BOWER DAMBERGER ROLSETH ENGINEERING LTD.  
JOSLYN PHASE 2, SAGD FACILITY

DWG TITLE

RECYCLE TREATER TR-805  
2438mm(8'-0") O.D. x 10668mm(35'-0") S/S  
LADDER AND ACCESS PLATFORM DETAILS

|                          |                     |      |                             |                         |                                                                                                       |
|--------------------------|---------------------|------|-----------------------------|-------------------------|-------------------------------------------------------------------------------------------------------|
| SCALE<br>1:20            | DWN BY<br>E. WILSON |      | DWG NO.<br><br>V-11699-D124 | SHEET NO.<br><br>1 OF 1 | REV. NO.<br><br> |
| DATE (d/m/y)<br>16/02/05 | CHKD                | APPD |                             |                         |                                                                                                       |

## GENERAL NOTES

## DESIGN

DESIGN CODE - ASME SECTION VIII, DIVISION 1 20.01 ADDENDA JULY 1st, 2003

DESIGN PRESSURE OR MAWP (HOT & CORRODED) 2500 kPag (363 psig) DESIGN TEMPERATURE 185°C (365°F)

MAWP (HOT & CORRODED) LIMITED BY -

RADIOGRAPHY (TOP HEAD TO SHELL) UW-12(d) NONE JOINT EFFICIENCY 0.85

RADIOGRAPHY (BOTTOM HEAD TO SHELL) UW-12(d) NONE JOINT EFFICIENCY 0.85

POST WELD HEAT TREATMENT NONE ADDITIONAL CODES NONE

CORROSION ALLOWANCE 1.6 mm(1/16")

HYDRO-TEST PRESSURE 3759 kPag (545 psig)

SERVICE WATER CAPACITY 0.051m<sup>3</sup> (1.81 ft<sup>3</sup>)

WEIGHT:dry 238 kg (525 lbs) operating design

OVERALL LENGTH N/A OVERALL HEIGHT 933mm (3'-0 3/4")

MINIMUM DESIGN METAL TEMPERATURE -29°C (-20°F) @ MAWP

## REGISTRATION

REGISTERED IN \_\_\_\_\_ SASKATCHEWAN/ALBERTA \_\_\_\_\_  
CRN NUMBER \_\_\_\_\_ P1006.23 \_\_\_\_\_  
MFR SERIAL NUMBER \_\_\_\_\_ 05-03-64 \_\_\_\_\_  
REFERENCE CRN NO. \_\_\_\_\_  
FOR REGISTERING \_\_\_\_\_

## PAINTING AND INSULATION

INTERNAL FINISH NONE

EXTERNAL FINISH SANDBLAST TO SSPC-SP6 AND APPLY 1 COAT PRIMER  
AND ONE FINISH COAT WARM GREY.

INSULATION NONE

## MATERIAL SPECIFICATIONS

SHELL MATERIAL SA-106-B SMLS

HEADS  
1. MATERIAL SA-105 TYPE RFWN CLASS 300  
2. MATERIAL SA-234-WPB TYPE PIPE CAP  
3. MATERIAL \_\_\_\_\_ TYPE \_\_\_\_\_

FLANGE N/A PIPE SA-106-B

WELD FITTINGS SA-234-WPB TUBES 316 S.S.



NONPRESSURE SA-36 OR EQUIV. COUPLING SA-105

WELDOLET N/A THREAOLET N/A

STUD BOLTS SA-193-B7 HEX NUTS SA-194-2H

GASKETS 316 S.S. GRAPHOIL

## NOZZLE SCHEDULE

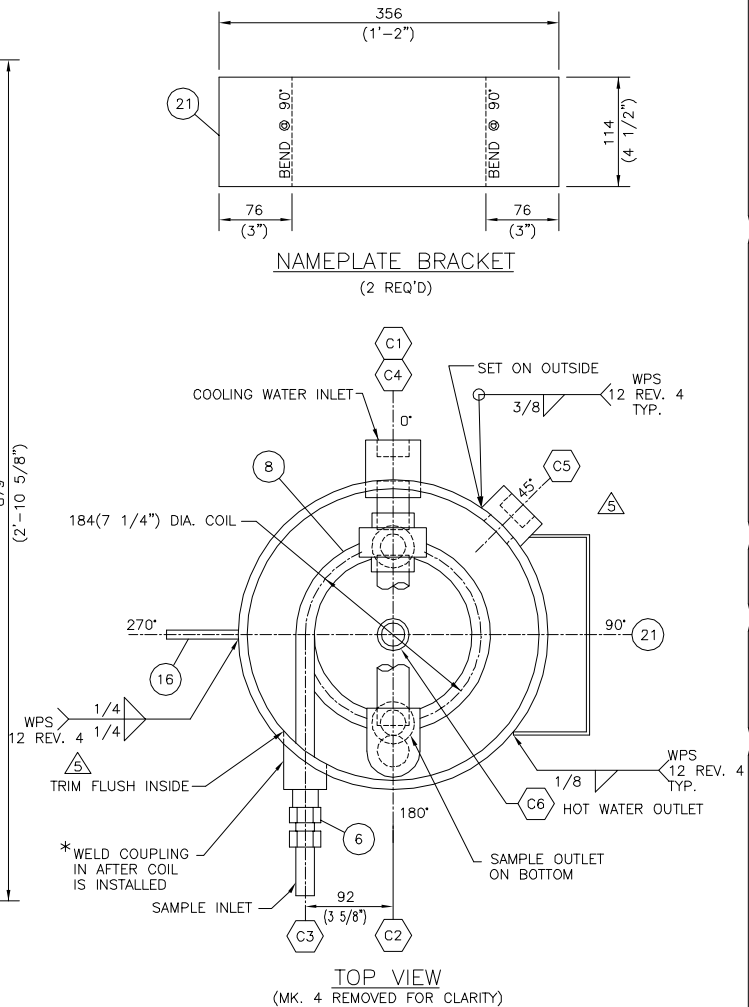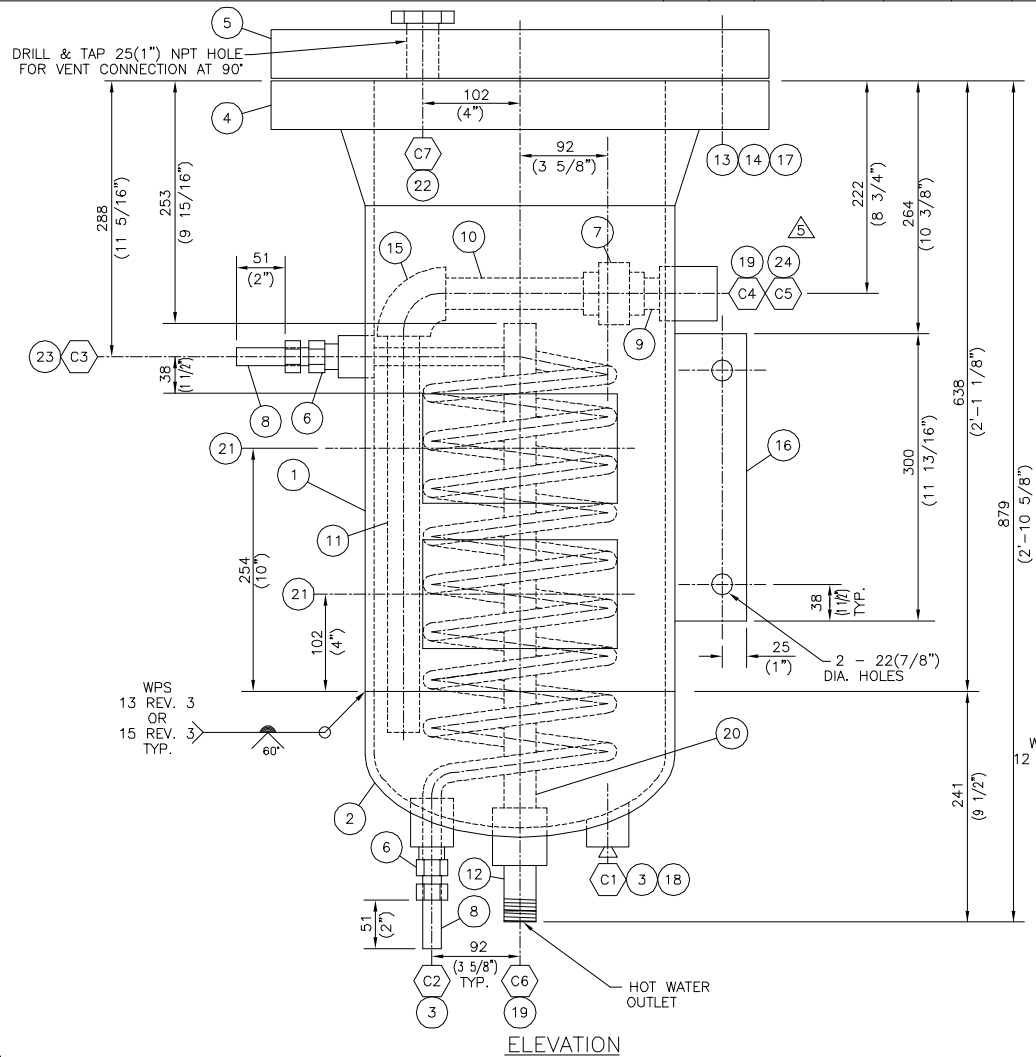[illegible]

## MATERIAL LIST

| QTY. | DESCRIPTION                                             | MATERIAL          | WT  |
|------|---------------------------------------------------------|-------------------|-----|
| 1    | PIPE 12" SCH STD x 1'-8" LG. SMLS BBE                   | SA-106-B          | 83  |
| 2    | PIPE CAP 12" SCH STD                                    | SA-234-WPB        | 30  |
| 3    | FULL COUPLING 3/4" CL. 6000 F.S. SCR'D                  | SA-105            | 1   |
| 4    | FLANGE 12" CLASS 300 RFWN x SCH STD BORE                | SA-105            | 142 |
| 5    | BLIND FLANGE 12" CLASS 300 RF                           | SA-105            | 184 |
| 6    | TUBE X MALE PIPE, MALE CONNECTOR(SWAGelok SS-1210-1-12) | 316 S.S.          | 1   |
| 7    | UNION 1" CL. 3000 F.S. SCR'D                            | SA-105            | 3   |
| 8    | TUBING 3/4" x 0.065" WALL THICKNESS x 20'-0" LG.        | 316 S.S.          | 5   |
| 9    | NIPPLE 1" SCH 80 x 2" LG. SMLS TBE                      | SA-106-B          | 1   |
| 10   | PIPE 1" SCH 80 x 7" LG. SMLS TBE                        | SA-106-B          | 1   |
| 11   | PIPE 1" SCH 80 x 1'-5" LG. SMLS TOE                     | SA-106-B          | 3   |
| 12   | NIPPLE 1" SCH 80 x 3" LG. SMLS TBE                      | SA-106-B          | 1   |
| 13   | GASKET 12" CLASS 300 RF x 1/8" THK.                     | 316 S.S. GRAPHOIL | 1   |
| 14   | STUDS 1 1/8" DIA. x 6 1/2" LG.                          | SA-193-B7M        | 12  |
| 15   | ELBOW 1" CL. 3000 F.S. SCR'D                            | SA-105            | 2   |
| 16   | PLATE 3/8" THK. x 3" x 11 13/16" LG. (*)                | SA-36             | 4   |
| 17   | HEX NUTS 1 1/8" NOM.                                    | SA-194-2HM        | 10  |
| 18   | HEX PLUG 3/4" CL. 3000 F.S. THR'D                       | SA-105            | 1   |
| 19   | FULL COUPLING 1" CL. 6000 F.S. SCR'D                    | SA-105            | 1   |
| 20   | PIPE 1" SCH 80 x 1'-8 1/2" LG. SMLS TOE                 | SA-106-B          | 3   |
| 21   | FLATBAR 1/8" THK. x 4 1/2" x 1'-2" LG. (*)              | SA-36             | 4   |
| 22   | HEX PLUG 1" CL. 3000 F.S. THR'D                         | SA-105            | 1   |
| 23   | LONG COUPLING 3/4" CL. 6000 F.S. SCR'D x 3" LG.         | SA-105            | 1   |
| 24   | HALF COUPLING 1" CL. 6000 F.S. SCR'D                    | SA-105            | 1   |

|                                                                                                                                     |          |         |
|-------------------------------------------------------------------------------------------------------------------------------------|----------|---------|
| NOTE:                                                                                                                               | SUBTOTAL | 496     |
| 1. ALL DIMENSIONS ARE IN S.I. & IMPERIAL UNITS. DIMENSIONS IN BRACKETS ARE IMPERIAL HARD CONVERSIONS FOR SHOP REFERENCE ONLY.       | x 1.06   |         |
| 2. THIS IS A "UM" VESSEL.                                                                                                           | TOTAL    | 526 lbs |
| 3. ITEMS IDENTIFIED WITH A (*) ARE ATTACHED TO THE PRESSURE ENVELOPE & REQUIRE A HEAT NUMBER TO BE HARD STAMPED & RECORDED BY Q.C.. |          |         |
| 4. SEE REVISION "5" FOR REGISTERED DESIGN.                                                                                          |          |         |

## COIL DATA

DESIGN CODE: ASME B31.3  
DESIGN PRESSURE: 16666 kPa (2417 psi)  
DESIGN TEMPERATURE: 185°C (365°F)  
HYDROTEST PRESSURE: 25000 kPa (3626 psi)  
SERVICE: HEAVY HYDROCARBON  
CAPACITY: 0.002 m<sup>3</sup> (0.067 ft<sup>3</sup>)  
SERIAL NO.: 05-03-64  
CRN NO. OH0260.23

|    |              |                                                                |     |      |
|----|--------------|----------------------------------------------------------------|-----|------|
| 7  | 04/03/05     | UPDATED DRAWING                                                | EEW |      |
| 6  | 27/09/04     | VESSEL DESIGN REVIEWED & FOUND TO MEET JULY 1st, 2003 ADDENDA  | EEW | JK   |
| 5  | 07/10/02     | CHANGED C5 TO HALF COUPLING, TRIM C3 FLUSH INSIDE              | EEW | JK   |
| 4  | 18/07/02     | VESSEL DESIGN REVIEWED & FOUND TO MEET JULY 1st, 2001 EDITION  | GLB | JK   |
| 3  | 28/05/02     | AS-BUILT; IMPACT TESTING NOTE ADDED.                           | GLB | JK   |
| 2  | 27/11/01     | VESSEL DESIGN REVIEWED & FOUND TO MEET JULY 31st, 2000 ADDENDA | JMA | JK   |
| 1  | 05/07/00     | REVISED SIZE OF C5                                             | JMA | JK   |
| 0  | 15/06/00     | ISSUED FOR CONSTRUCTION                                        | JMA | JK   |
| NO | DATE (d/m/y) | REVISIONS                                                      | BY  | APPD |

## REVISIONS

THIS DRAWING IS THE PROPERTY OF UNIVERSAL INDUSTRIES CORP. AND IS TO BE USED ONLY IN CONJUNCTION WITH PERFORMANCE OF WORK BY UNIVERSAL INDUSTRIES CORP.. REPRODUCTION OR USE OF IN WHOLE OR IN PART FOR ANY OTHER PURPOSE IS EXPRESSLY FORBIDDEN.



|        |                                                                                                    |
|--------|----------------------------------------------------------------------------------------------------|
| CLIENT | DEER CREEK ENERGY LTD.<br>C/O BOWER DAMBERGER ROLSETH ENGINEERING<br>JOSLYN PHASE 2, SAGD FACILITY |
|--------|----------------------------------------------------------------------------------------------------|

DWG TITLE

SAMPLE COOLER E-433  
305mm(1'-0") NOM. x 638mm(2'-1 1/8") S/F.O.F.  
GENERAL ARRANGEMENT

|                          |                       |      |                     |                     |                                                                                                   |
|--------------------------|-----------------------|------|---------------------|---------------------|---------------------------------------------------------------------------------------------------|
| SCALE<br>1:5             | DWN BY<br>J. ACKERMAN |      | DWG NO.<br>EDS-6036 | SHEET NO.<br>1 OF 1 | REV. NO.<br> |
| DATE (d/m/y)<br>16/05/00 | CHKD                  | APPD | S.O. NO.<br>11699   |                     |                                                                                                   |