




SECTION 1-1  
40.3  
677.2  
44150-600  
37.2  
100

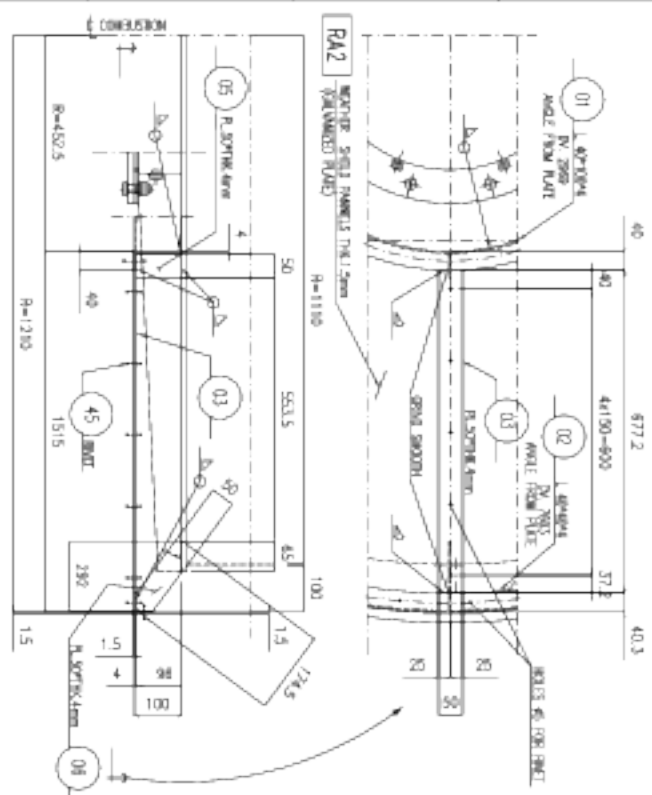


DETAIL "6"

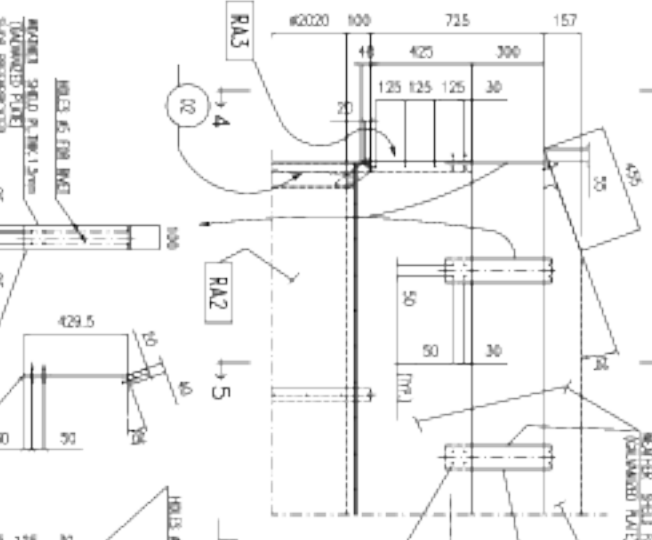


SECTION "4-4"

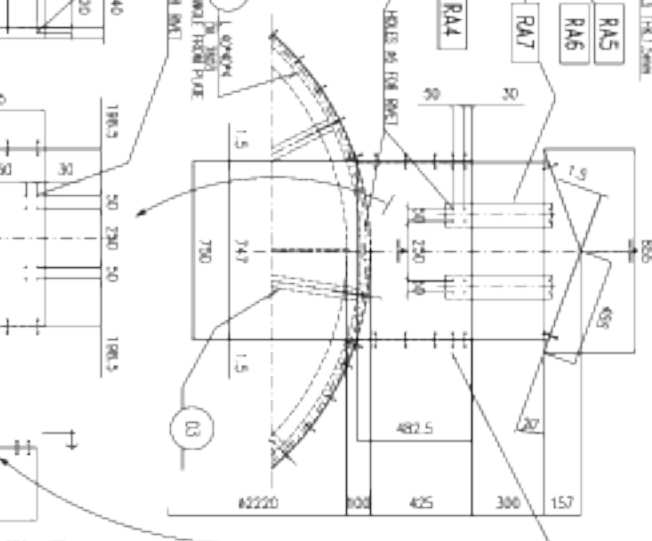


DETAIL "5-5"

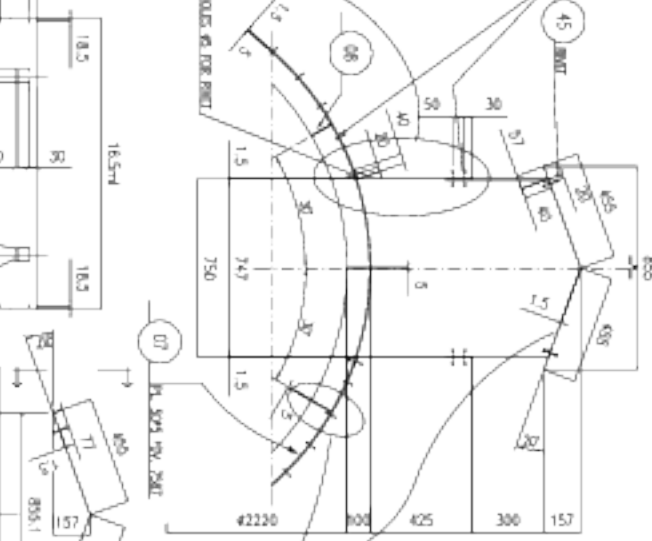


DETAIL "13"

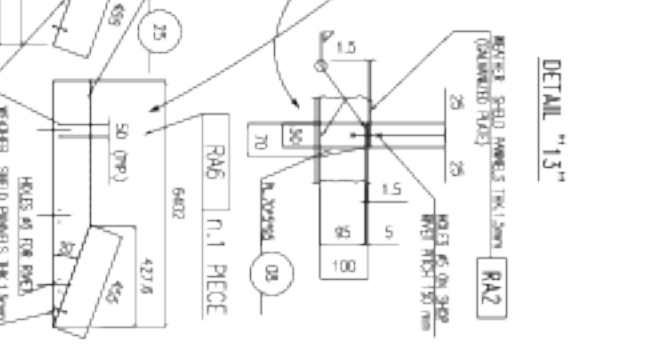


SECTION 3-3

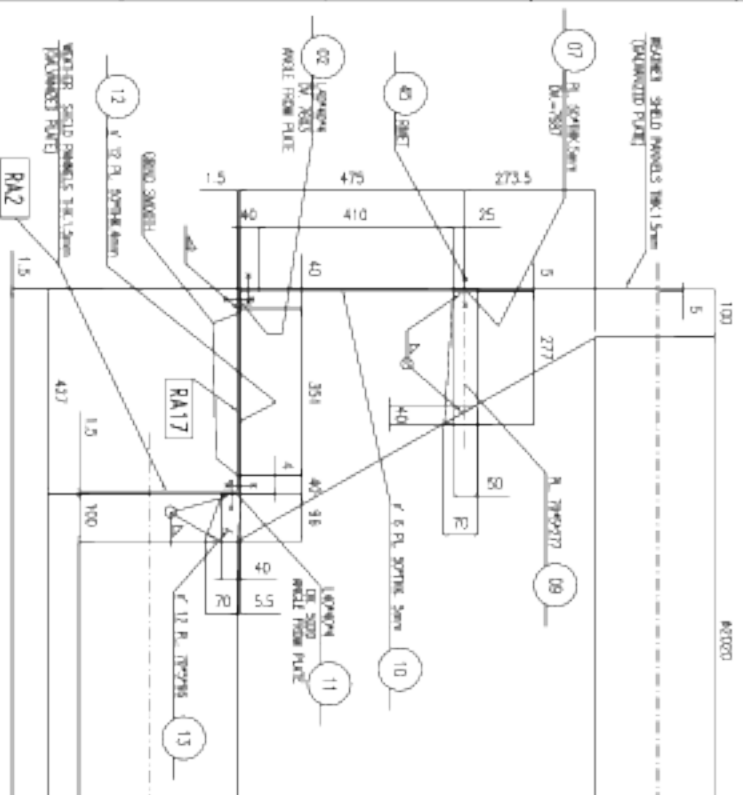





DETAIL "7"

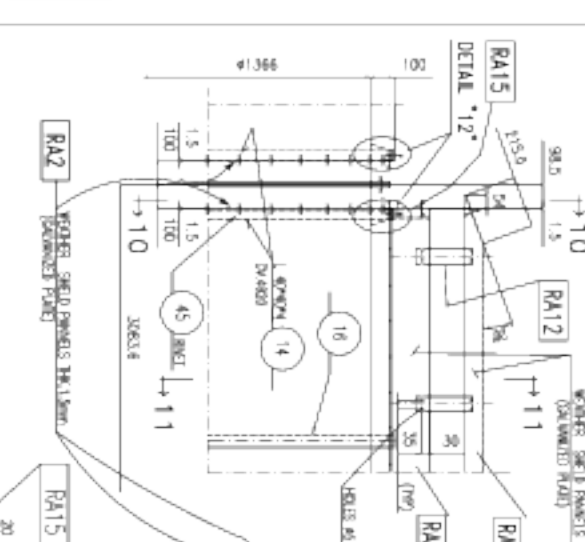

SECTION 10-10

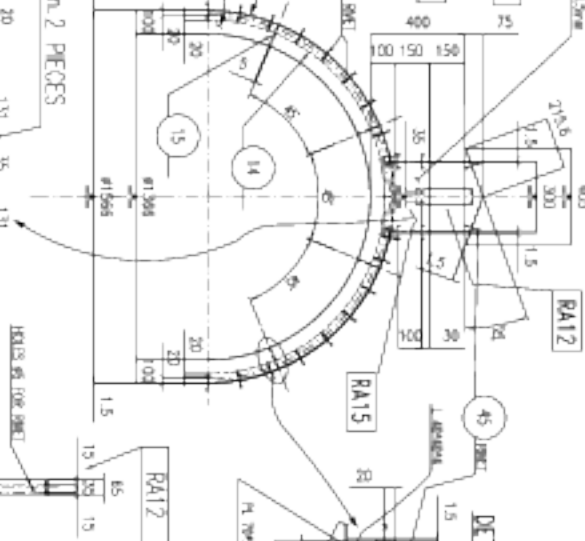

SECTION 11-11

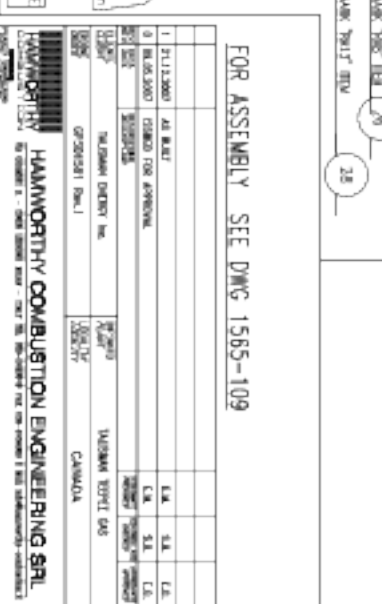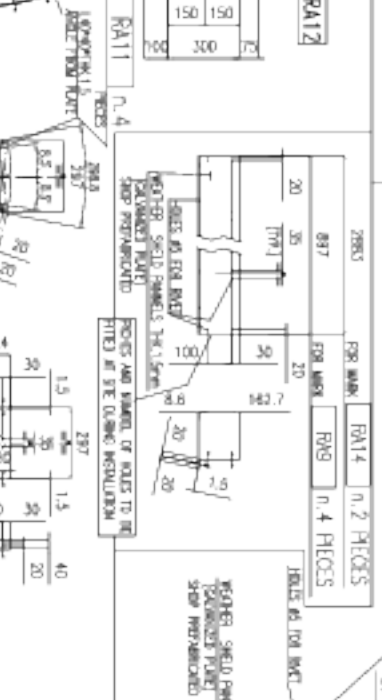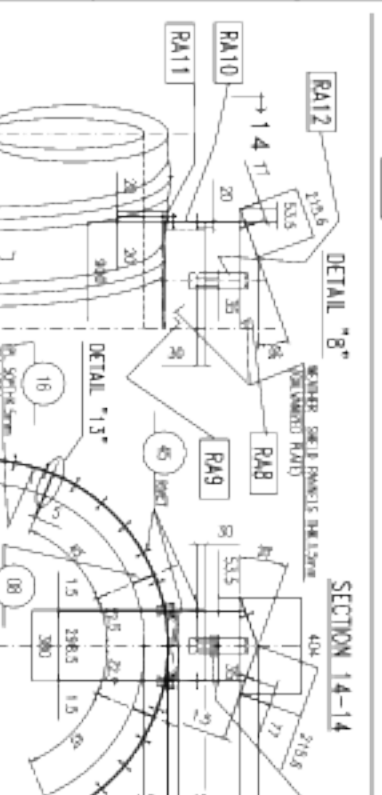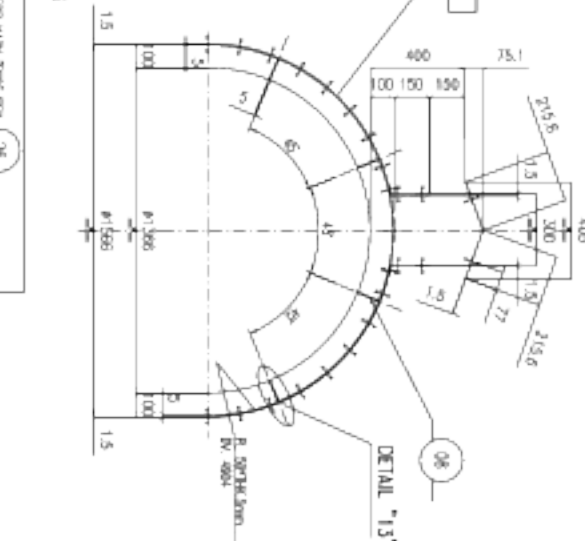

TYPICAL NOTES

- 1) PREFABRICATED PIECES
- 2) REINFORCED IRON SHALL BE WELDED AS INDICATED IN THIS DWG.

<b>FOR ASSEMBLY SEE DWG 1565-109</b>	
<b>CLIENT</b>	WAMMORTHY COMBUSTION ENGINEERING SRL
<b>PROJECT</b>	SAVED SHIELD DETAILS
<b>DRAWING NO.</b>	1565-109
<b>DATE</b>	15/05/2010
<b>SCALE</b>	1:1
<b>DESIGNER</b>	M. TITANO
<b>CHECKER</b>	M. TITANO
<b>APPROVER</b>	M. TITANO
<b>DATE</b>	15/05/2010