

SPECIFICATIONS:

**OPERATION PARAMETERS: 0.15 MMSCF/d @ 2 PSI
1300PPM H2S 274 days to fill.
GAS MUST BE DRY**

**TANK: API 12F MODIFIED ATMOSHERIC 200 BBL TANK
10' X 15' NOM. 3/16" WALL & ROOF,
1/4" PLATE FLOOR, SPC 6 COMMERCIAL
BLAST & PRIMED EXTERNALLY w/ DEVRAN 224
PAINTED ALL EXTERNAL & INSULATED SURFACES w/ DEVTHANE 359
SPC 5 WHITE METAL BLAST INTERNALLY COATED
w/ DEVOE 253 12-15MM. INSULATED w/ TRANSPANEL**

**SKID: 10' X 10' 6" X 15# WF SPC-6 COMMERCIAL BLAST PRIMED
DEVTRAN 224, PAINTED DEVTHAN 229**

LADDER & PLATFORM: AB OH &S/ CSA LADDER & PLATFORM


**FILTER BED: 1" TWIST BAR GRATING w/ #4 & #40
STAINLESS MESH, 2" THK. FOAM PAD.**

MEDIA: 54,000 LBS OF SULPHATREAT HP 410 (APPROX. 160 BBL)

**TANK PORTS: INLET/ (2) OUTLET 4" 150#, 2" 150# DRAIN
DRAIN/ SAMPLE 2" CPLG. 8" 150# SUCK OUT**

**HEATER: CCI THERMAL NORSEMAN XB3-4300T2D
ELECTRIC HEATER MOUNTED TO BOTTOM
OF FLOOR ON SLIDABLE SKID.**

**MISC: GLM STYLE SPLIT MAN DOOR. 2' X 2' MEDIA FILL
DOOR ON TOP. SAFETY RINGCIRCUMFERENCE
OF TANK. ENARDO 660 SOUR SERVICE THIEF HATCH
w/ 32 OZ INCONNEL SPRING SUPPLIED AT FACILITIES
REQUEST.**

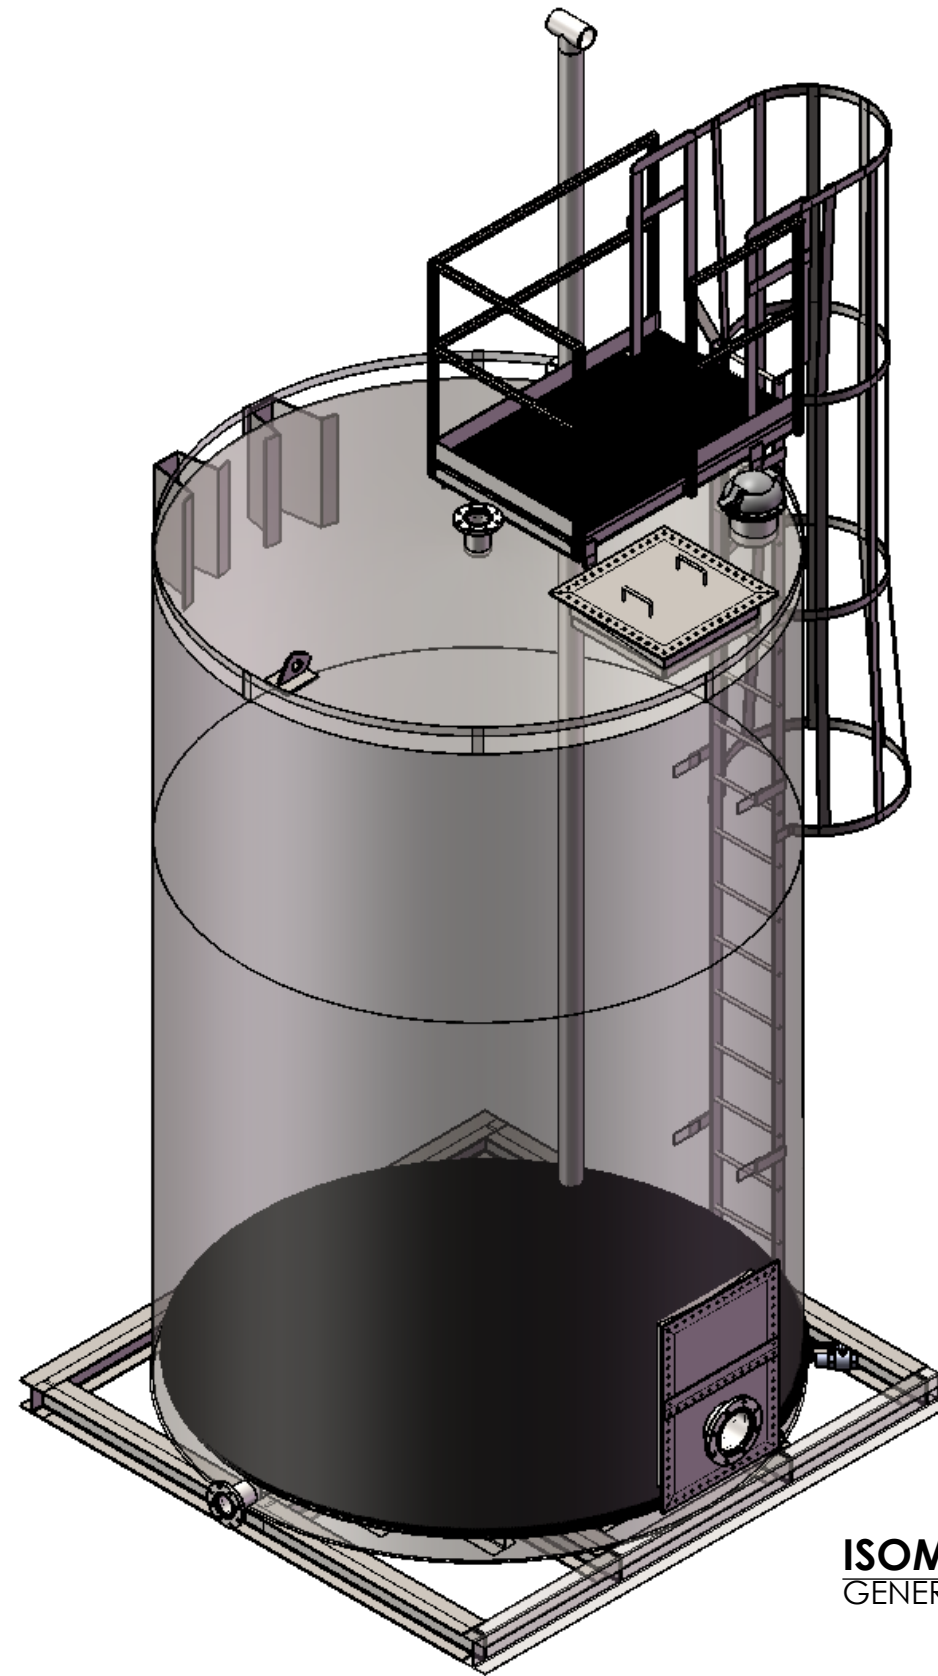

**ISOMETRIC VIEW
GENERAL ARRANGEMENT**

**Access
Manufacturing
Ltd.**

SHOP: 10828-269 RD.
BILLING: 7904 -101ST AVE,
FORT ST. JOHN, BC. V1J2A3

COMMENTS:

PROPRIETARY AND CONFIDENTIAL

THE INFORMATION CONTAINED IN THIS DRAWING IS THE SOLE PROPERTY OF ACCESS MANUFACTURING LTD. ANY REPRODUCTION IN PART OR AS A WHOLE WITHOUT THE WRITTEN PERMISSION OF ACCESS MANUFACTURING LTD. IS PROHIBITED.

UNLESS OTHERWISE SPECIFIED:

DIMENSIONS ARE IN INCHES
TOLERANCES:
FRACTIONAL ± 1/16"

MATERIAL
SA-36
FINISH
SPC-6/5 PRIME, PNT
WEIGHT(LBS)
10374

DEPARTMENT	CHK.	INITIAL	DATE
DRAFT			
OCM. APPR.			
QCM. APPR.			
PRC. APPR.			
INST. APPR.			
WELD. APPR.			

DRAWING ISSUE STATUS

NO.	DESCRIPTION	BY:	DATE:
ASBO	ISSUED FOR ASBUILT UNIT A/B/C	TL	10.10.11
CO	ISSUED FOR CONSTRUCTION	H	21.06.11
AO	ISSUED FOR APPROVAL	TL/ JA	26.05.11
GO			

DO NOT SCALE FROM DRAWING

TITLE:

CNRL
200 BBL DRY MEDIA SWEETENING TANK
GENERAL ARRANGEMENT

DRAWN BY: TL

CHECKED BY: TL

APPROVED BY: TL

SHEET 1 OF 8

SCALE: 1:100

DWG NO.: 2SWT.P11045.01.R0

SERIAL NO.: 2SWT.P11045.01/03

REV NO.: 0

PROJECT NO.

P11045