

002-UHG-02-1080
GLYCOL BLDG. HEATER #1

MFG: RUFFNECK
MODEL: AH-24A-A7D1-A1-2H
MAWP: 2068 kPag (300 PSIG)
MAWT: 150°C (300°F)

002-UHM-02-1080
GLYCOL BLDG. HEATER MOTOR #1

MFG: MARATHON ELECTRIC MOTOR
MODEL: TBD
POWER: 0.5 HP
ELECTRICAL: 575VAC/60HZ/3PH, 0.85 AMPS

002-UHG-02-1081
GLYCOL BLDG. HEATER #2

MFG: RUFFNECK
MODEL: AH-24A-A7D1-A1-2H
MAWP: 2068 kPag (300 PSIG)
MAWT: 150°C (300°F)

002-UHM-02-1081
GLYCOL BLDG. HEATER MOTOR #2

MFG: MARATHON ELECTRIC MOTOR
MODEL: TBD
POWER: 0.5 HP
ELECTRICAL: 575VAC/60HZ/3PH, 0.85 AMPS

002-UHG-02-1082
GLYCOL BLDG. HEATER #3

MFG: RUFFNECK
MODEL: AH-24A-A7D1-A1-2H
MAWP: 2068 kPag (300 PSIG)
MAWT: 150°C (300°F)

002-UHM-02-1082
GLYCOL BLDG. HEATER MOTOR #3

MFG: MARATHON ELECTRIC MOTOR
MODEL: TBD
POWER: 0.5 HP
ELECTRICAL: 575VAC/60HZ/3PH, 0.85 AMPS

002-UHG-02-1083
GLYCOL BLDG. HEATER #4

MFG: RUFFNECK
MODEL: AH-24A-A7D1-A1-2H
MAWP: 2068 kPag (300 PSIG)
MAWT: 150°C (300°F)

002-UHM-02-1083
GLYCOL BLDG. HEATER MOTOR #4

MFG: MARATHON ELECTRIC MOTOR
MODEL: TBD
POWER: 0.5 HP
ELECTRICAL: 575VAC/60HZ/3PH, 0.85 AMPS

002-EF-02-1085 TO 1096
BLDG. EXHAUST FAN #1-#12

MFG: MULTI WING AMERICA
MODEL: FFV2434
POWER: 0.549 HP

002-EFM-02-1085 TO 1096
BLDG. EXHAUST FAN MOTOR #1-#12

MFG: MARATHON
MODEL: 56T17G5321E (G666)
POWER: 0.5 HP
ELECTRICAL: 575VAC/60HZ/3PH/1.0FLA

002-EF-02-1097
BLDG. PURGE FAN

MFG: SOPER'S SUPPLY LTD.
POWER: 0.5 HP, 6 ACPH, 2754 CFM

002-EFM-02-1097
BLDG. PURGE FAN MOTOR



MFG: MARATHON
POWER: 0.5 HP (0.37 KW)
ELECTRICAL: 575VAC/3PH/60HZ

002-PLC-02-1001
COMPRESSOR CONTROL PANEL


MAKE: SPARTAN CONTROLS
MODEL: REMVUE-500

002-BU-02-1000
BUILDING


MFG: NOISE SOLUTION
DIMENSIONS:
LENGTH: 48'
WIDTH: 28.5'
HEIGHT: 24'

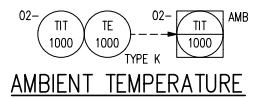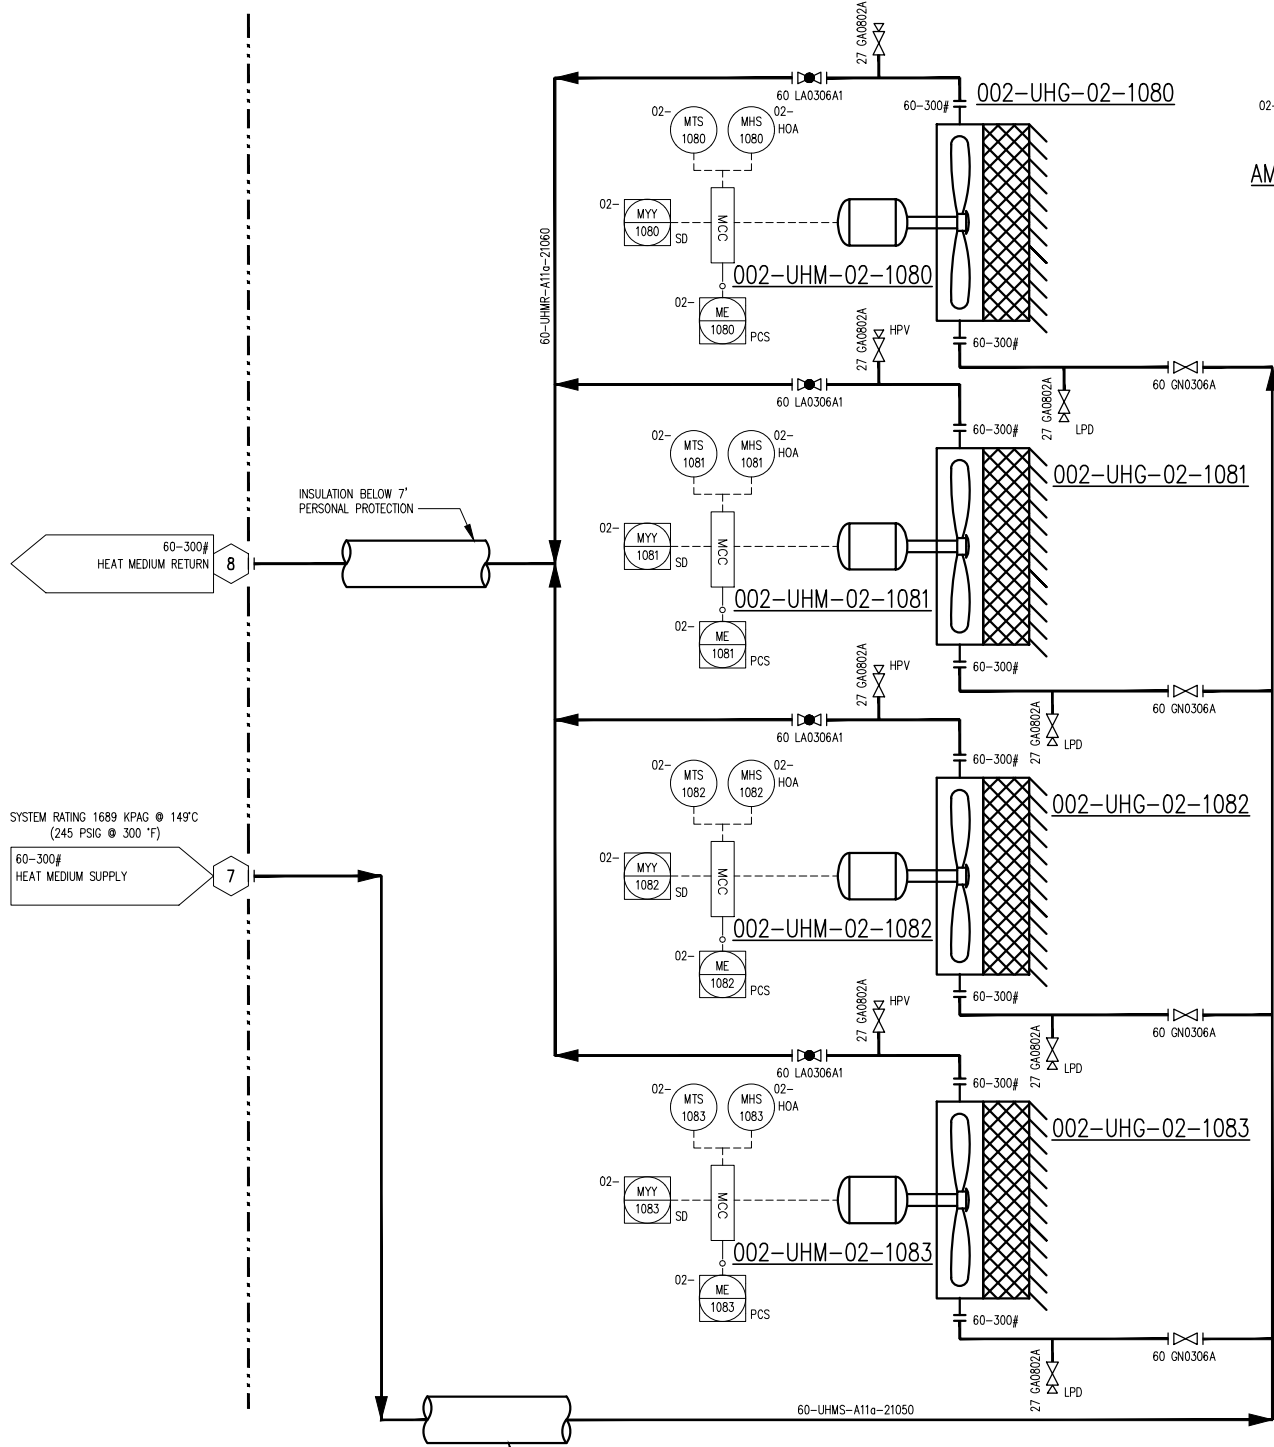


AMBIENT TEMPERATURE

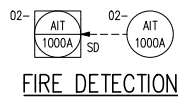


FIRE DETECTION

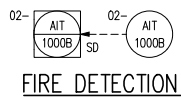


FIRE DETECTION

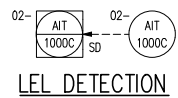


LEL DETECTION

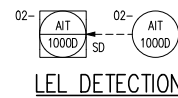


LEL DETECTION

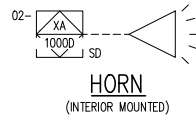


HORN
(INTERIOR MOUNTED)

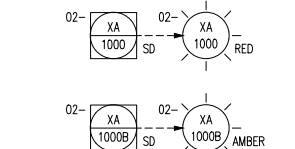


RED/AMBER BEACON LIGHTS
(EXTERIOR - 120VAC - TBC)

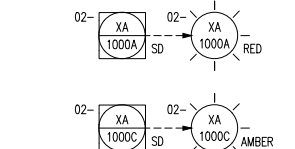


RED/AMBER BEACON LIGHTS
(INTERIOR - 120VAC - TBC)

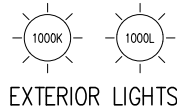


EXTERIOR LIGHTS

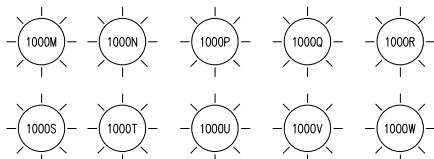


INTERIOR LIGHTS (LED LIGHTS)
(WALL MOUNTED)

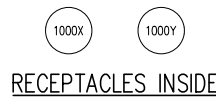


RECEPTACLES INSIDE

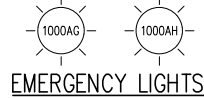

EMERGENCY LIGHTS

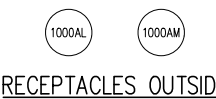

RECEPTACLES OUTSIDE





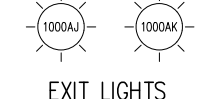


EXIT LIGHTS




BUILDING

002-PLC-02-1001

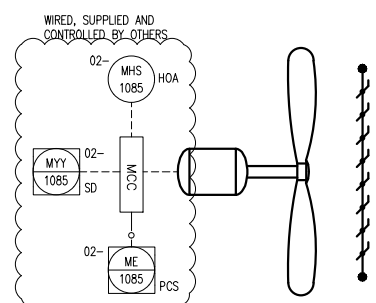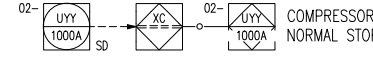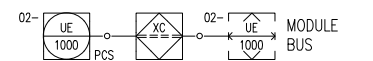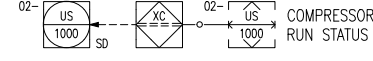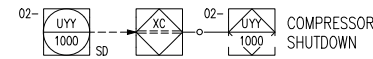

002-EFM-02-1085 TO 1096
002-EF-02-1085 TO 1096

VENT FANS (X12)

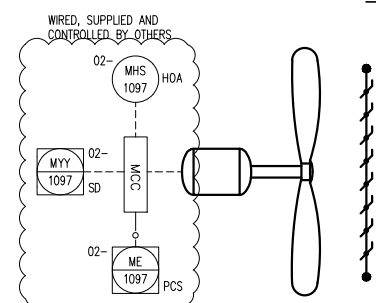

002-EFM-02-1097
002-EF-02-1097

PURGE VENT FAN

002-JBE-02-1003
208 VAC POWER
DISTRIBUTION
JUNCTION BOX

| METRIC (ACT.) | IMPERIAL (NOM.) |
|---------------|-----------------|
| 9 | 1/8" |
| 14 | 1/4" |
| 17 | 3/8" |
| 21 | 1/2" |
| 27 | 3/4" |
| 33 | 1" |
| 42 | 1-1/4" |
| 48 | 1-1/2" |
| 60 | 2" |
| 89 | 3" |
| 114 | 4" |
| 141 | 5" |
| 168 | 6" |
| 219 | 8" |
| 273 | 10" |
| 324 | 12" |
| 356 | 14" |
| 406 | 16" |
| 457 | 18" |
| 508 | 20" |

**FINAL
AS BUILT**
NAME: ALTRAN DATE: JAN 17/14

| | | | | |
|-----|---|-----------|----|-----|
| 8 | FINAL AS BUILT | JAN 17/14 | AT | LD |
| 7 | UPDATED AS BUILT, PURGE FAN ADDED | NOV 06/13 | AR | LD |
| 6 | FINAL AS BUILT - REVISED BEACON AND HORN TAGS | NOV 06/13 | AR | LD |
| 5 | FINAL AS BUILT - NO CHANGE | OCT 04/13 | AR | LD |
| 4 | REVISED VALVE TYPE | AUG 14/13 | AT | LD |
| 3 | REVISED CONTROL PHILOSOPHY | JUL 26/13 | AT | LD |
| REV | DESCRIPTION | DATE | BY | APR |

| | | | |
|------------------|----------------|------------------|------------|
| DATE | JAN 25/13 | SCALE | NTS |
| DRAWN BY | G.PAHL | CHECKED BY | L.DIOQUINO |
| PROJECT MANAGER | B.MINSHULL | APPROVED BY | A.DURHAM |
| CUST PO | Q1120562 | PROJECT ENGINEER | L.DIOQUINO |
| APEGA PERMIT No: | P8651 | OPER. CODE | |
| WORK ORDER | 002-PK-02-1000 | | |

DEVON CANADA
PROJECT NAME: FERRIER CPF
AREA: FERRIER
LSD: 11-02-039-08-W5M
WBS: 01-00348.01
CAT G3616/ARIEL KBZ 6/2

ENERFLEX
Calgary, Alberta,
Canada

P & I DIAGRAM
DRIVE TRAIN/
BUILDING COMPONENTS

DWG NO 31980-01-112

SHT 2

REV 8