


MFG: UTILE PUMP
MODEL: LGA-12-1.5-12-3

MFG: TECO WESTINGHOUSE
RATING: 575 VAC, 1.5HP, 60HZ, TEXP

MFG: EFX
CAPACITY: 271 LITERS
DIMENSIONS: 508mm (20") OD x 1981mm (78") LG. x
9.5mm (3/8") THK

MFG: YAMADA
MODEL: NDP-15BAN
MAX FLOW: 51 LPM

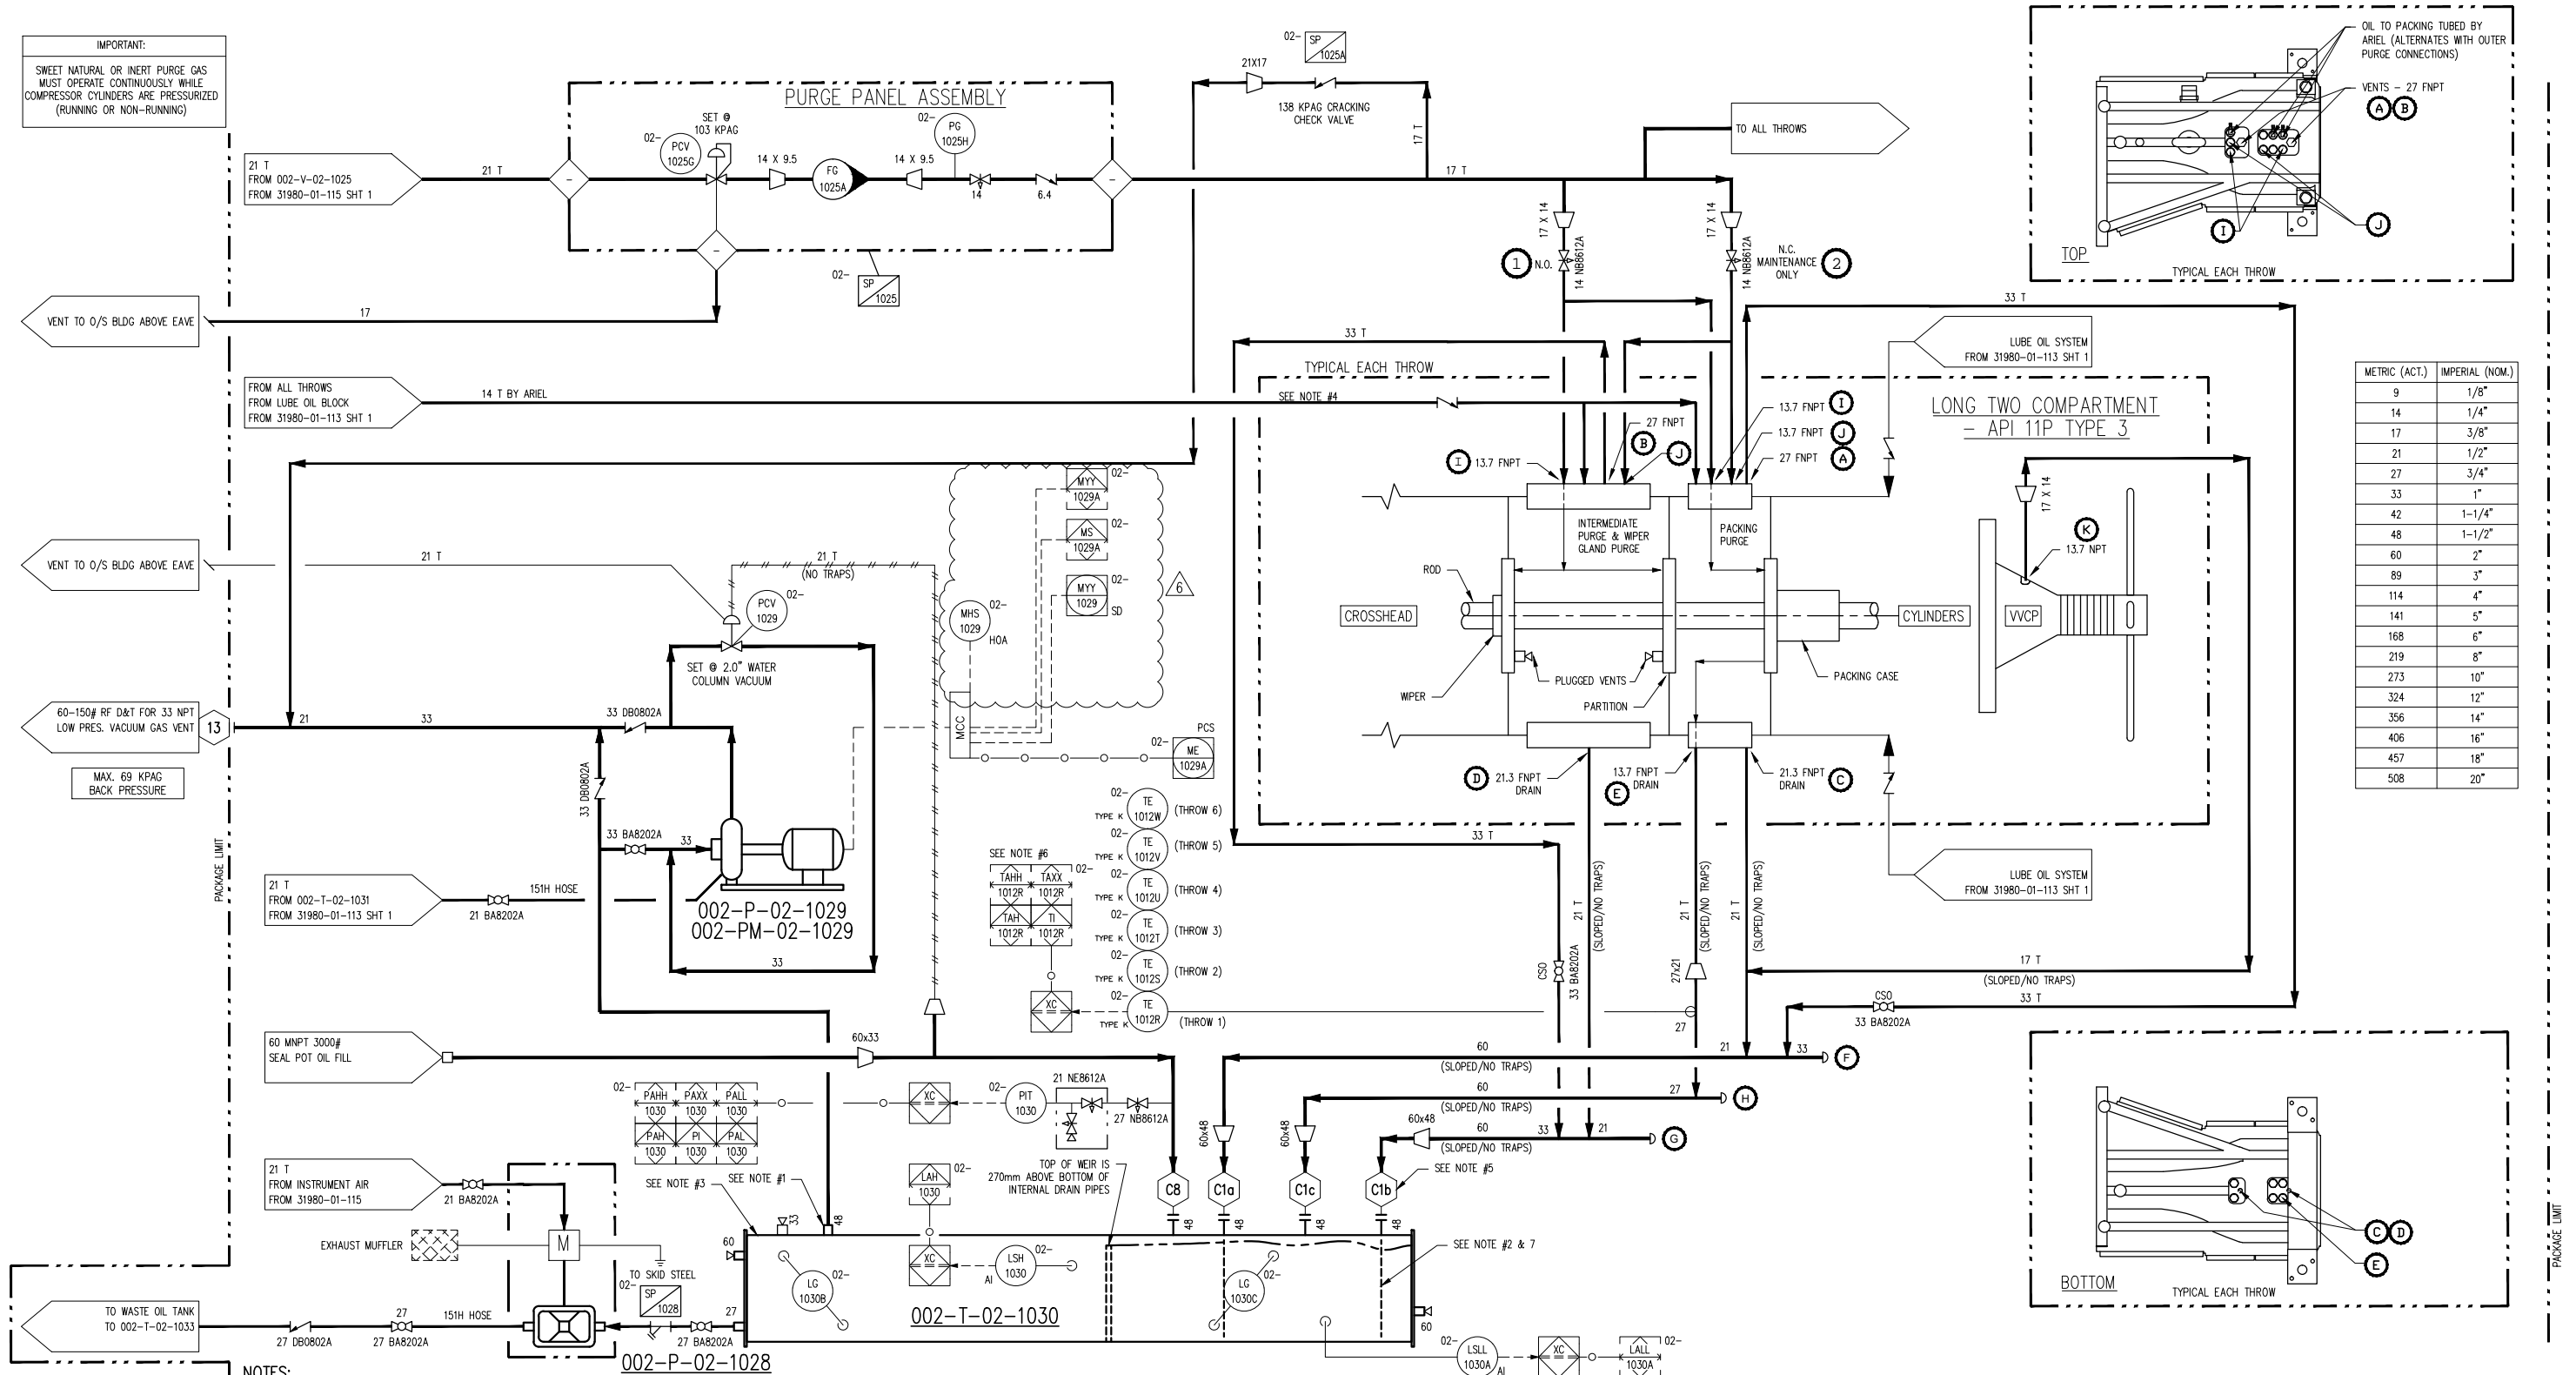

- NOTES:**
1. VENTING SOUR WASTE OIL TANK TO ATMOSPHERE IS NOT RECOMMENDED FOR SAFETY REASONS.
 2. SEAL POT TO BE CHARGED WITH OIL (SAG 30/40) PRIOR TO START UP.
 3. TOP OF OIL SEAL POT ELEVATION SHALL BE NO LESS THAN 152 CM BELOW BOTTOM OF DISTANCE PIECES.
 4. LETTER TAGS REFER TO CAC-ENG-DAN-003, "ARIEL VENTING AND DRAINING REQUIREMENTS".
 5. IF TAGS REFER TO DWG. #NUNNN-SEALPOT.
 6. PACKING TEMPERATURE SET POINTS MUST BE REVIEWED AND RESET POST START UP.
 7. T4H SET POINT = NORMAL DISCHARGE CYLINDER TEMP. - 8°C
 8. T4HH SET POINT = NORMAL DISCHARGE CYLINDER TEMP. - 3°C
 9. REFER TO CAC-ENG-DAN-001, "SOUR GAS SEAL POTS FUNCTION AND DESIGN" FOR SIZING AND SELECTION

FINAL AS BUILT

NAME T.WELSH DATE JUN 02/14

6	CONTROL TAGGING CHANGE	JUN 02/14	TW	LD	DATE	JAN 25/13	SCALE	NTS		
5	FINAL AS BUILT – NO CHANGE	MAR 06/14	TW	LD	DRAWN BY	G.PAHL	CHECKED BY	L.DIOQUINO	APPROVED BY	A.DURHAM
4	FINAL AS BUILT – NO CHANGE	OCT 04/13	AR	LD	PROJECT MANAGER	B.MINSHULL	PROJECT ENGINEER	L.DIOQUINO		
3	REVISED CONTROL PHILOSOPHY	JUL 26/13	AT	LD	CUST PO	410000990				
2	ISSUED FOR CONSTRUCTION	JUN 19/13	CS	LD	AEGGA PERMIT No:	P8651	OPER. CODE	490 5		
1	ISSUED FOR CONSTRUCTION	APR 26/13	AT	LD						
REV	DESCRIPTION	DATE	BY	APR						

DEVON CANADA
PROJECT NAME: FERRIER CPF
AREA: FERRIER
LSD: 11-02-039-08-W5M
WBS: 01-00348.01
CAT G3616/ARIEL KBZ 6/2

ENERFLEX
Calgary, Alberta,
Canada

P&I DIAGRAM
COMPR. LUBE OIL & UTILITIES
ARIEL KBZ/6 - L2C

DWG NO	31980-01-113
-----------	--------------

SHT	2
-----	---

EV 6