



THIS DRAWING IS THE EXCLUSIVE PROPERTY OF MACTRONIC A DIVISION OF FLARE INDUSTRIES AND MAY NOT BE REPRODUCED WITHOUT PERMISSION.

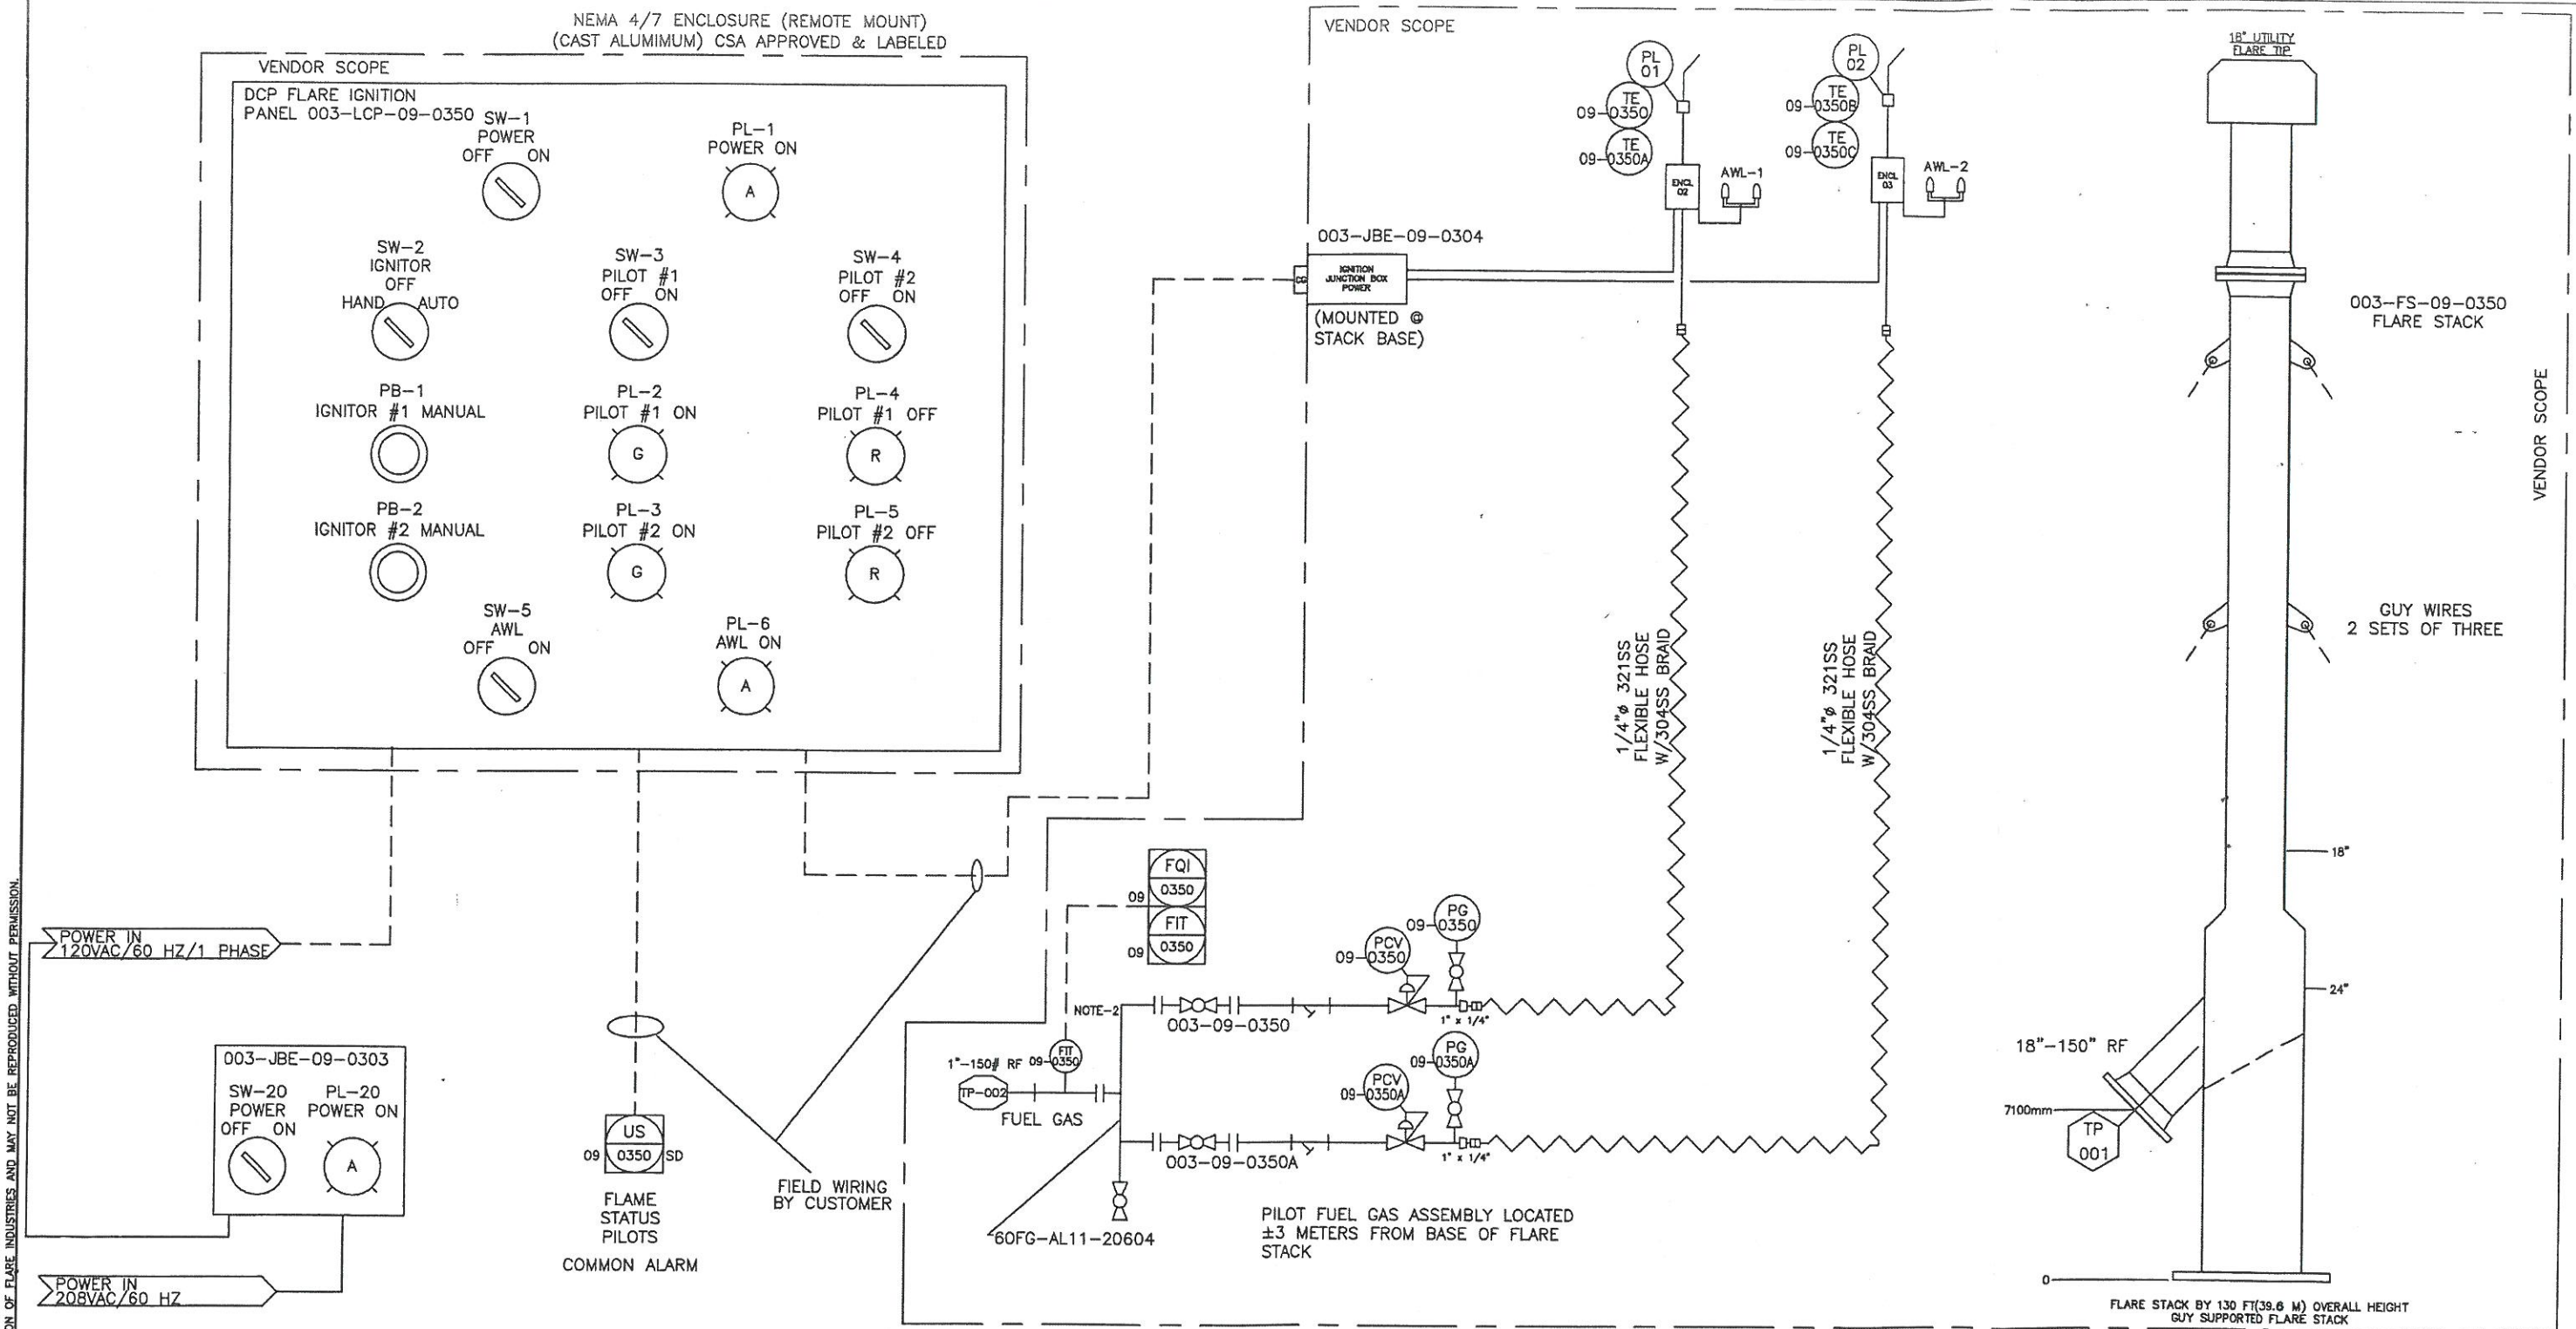

TP-001	18"-150#	FLARE STACK INLET
TP-002	1"-150#	PILOT FUEL INLET

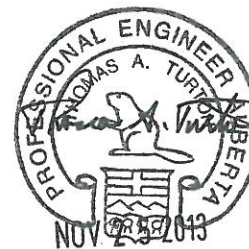

NOTES:

- 1) ALL INSTRUMENTS TAGS SHALL BE READ AS FULL TAG NUMBERS
EG:003-PCV-09-0350
- 2) THERMO MASS FLOW METER

LEGENDS
— BY OTHERS
— CABLE

REV	DATE	REVISION BLOCK	DESCRIPTION	BY
0	18-JULY-13	APPROVAL		SS
1	24-AUG-13	FABRICATION		SS
2	11-SEP-13	FABRICATION		SS
3	24-OCT-13	FABRICATION		SS
4	15-NOV-13	AS-BUILT		CSG

CLIENT: DEVON			
LOCATION	11-02-38-08 W5	P.O.:	4100001351
PROJECT	FERRIER	TAG:	003-FS-09-0350
TITLE: PIPING, INSTRUMENTATION DIAGRAM FOR DCP FLARE			
DRAWN BY:	SS	CHECKED BY:	DATE: 18-JULY-13
APP. BY:	PROJECT BY:	SCALE:	N.T.S
JOB ORDER:	13-0138	DRAWING NUMBER:	13-0138-DCP-PID
			REV. 4