


Z-2-300 DEHY #2 SKID LIMITS

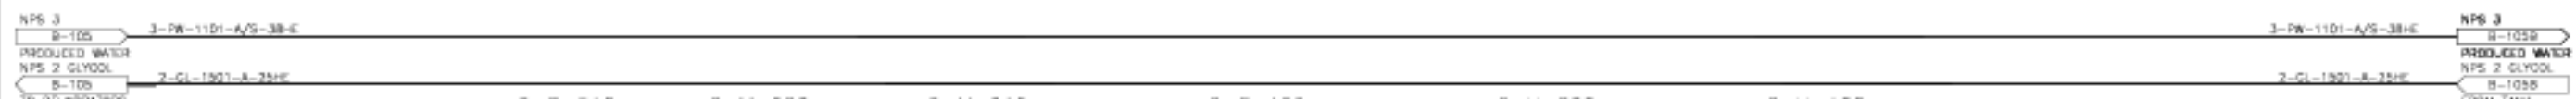

- 2-P-510**
 FUEL GAS PUMP
 UNION SK-3 (5/8")
 1 1/2 HP 400/3/60 EXP
 42 USGPH @ 253 RPM
- 2-M-920**
 GLYCOL FILTER
 OBERG MODEL 900-25
 CAP.: 15 GPM
- 2-M-910**
 CHARCOAL FILTER
 PECO MODEL 11-2-720-B
 275-15 CARBON FILTER
 218mmDD x 1232mmHG
 CAP.: 1.56 GPM
- 2-F-100**
 AIR/GLYCOL EXCHANGER
 8 x 1524mm SECTIONS OF
 TRWNS No. 32 FIN TUBE
- 2-H-800**
 GLYCOL RECONCENTRATOR
 825 000 BTU/HR
 REB.: 762mmDD x 3810mmLG
 ACCUM.: 508mmDD x 3810mmLG
 STRIPPER: 356mmDD x 2438mmLG
 CS PALL RINGS
- 2-H-100**
 BUILDING HEATER
 1.5X24X24 EXP
 24000 BTU/H

© TARTAN ENGINEERING LTD 2001

NOTES

- 1 ISSUED FOR O&G APPLICATION (PROJ. #264502)
- 2 CONCEPTUAL (PROJ. #264502)
- 3 ISSUED FOR O&G APPLICATION (PROJ. #264502)
- 4 AS-BUILT (PROJ. #264502)
- 5 RE-ISSUED FOR CONSTRUCTION
- 6 AS-BUILT (PROJ. #264502)
- 7 ISSUED FOR CONSTRUCTION (PROJ. #264502)
- 8 DESIGN REVIEW (PROJ. #264502)
- 9 PRELIMINARY DESIGN AND CLIENT REVIEW (PROJ. #264502)

REV	REVISION	DATE	DRWN BY	CHKD BY	CVL APP	PRDC APP	MECH APP	ELCC APP	INST APP	SPEI APP	PRG END	Q.A.	OWNER CHGD	OWNER APP
1		01.08.04	ML											
2		01.08.02	ML											
3		01.08.05	ML											
4		01.08.05	ML											
5		01.08.05	ML											
6		01.04.04	ER											
7		02.04.10	JO											
8		01.11.12	ML											
9		01.09.25	JO											
10		01.09.10	ML											

PERMIT	ENGINEER				
--------	----------	--	--	--	--

AEC Oil & Gas

LADYFERN CENTRAL DEHYDRATION FACILITY
b-47-H/94-H-1
DEHYDRATOR P&ID

SCALE NTS	PROJECT No 264502	DWG No A1-2645-B-105A	REV 10
--------------	----------------------	--------------------------	-----------