

**PROJECT DESCRIPTION**

ONE (1) NATURAL GAS COMPRESSOR PACKAGE  
 FOR: DEVON CANADA CORPORATION  
 LOCATION NAME: FERRIER CPF BATTERY  
 LSD: 11-02-39-08 W5M

**FABRICATED BY:**

ENERFLEX LTD.  
 CALGARY, ALBERTA, CANADA

**TANK CAPACITIES**

GLYCOL STORAGE TANK: 2124 LITERS  
 WASTE OIL STORAGE TANK: 2124 LITERS  
 ENGINE LUBE OIL DAYTANK: 650 LITERS  
 EJW SURGE TANK: 197 LITERS  
 AJW SURGE TANK: 151 LITERS

**DESIGN CRITERIA & APPLICABLE CODES**

SITE ELEVATION: 1030m ABOVE MEAN SEA LEVEL  
 BAROMETRIC PRESSURE: 89.6 KPA  
 AMBIENT TEMPERATURE: 40°C  
 WIND SPEED: 145 KMPH  
 SEISMIC ZONE: A  
 PROCESS INLET: DESIGN 1689 KPAG @ 121°C  
 PROCESS FINAL DISCHARGE: DESIGN 2068 KPAG @ 121°C  
 INSTRUMENT AIR: MINIMUM PRESSURE 550 KPAG  
 MAXIMUM PRESSURE 910 KPAG  
 APPLICABLE CODE: GALVANIZED PIPE FOR INSTRUMENT AIR HEADER (PIPE CLASS AU23)  
 CODE PIPING B31.3 - 2010  
 NON-CODE PIPING EFX C01, 1mm CA; FULL PEN. WELD ON COUPLING  
 VESSEL ASME SECTION VIII  
 EXCHANGER ASME SECTION VIII  
 STRUCTURAL CWB  
 ELECTRICAL CSA  
 REGISTRATION: VESSEL AB  
 MISCELLANEOUS: GASKETS CGI TYPE, FLEXITALLIC FLEXICARB, SPIRAL WOUND, 316 WINDINGS AND INNER RING  
 BOLTING STUDS - SA-193-B7, NUTS - SA-194-2H  
 PROCESS PIPE CARBON STEEL  
 UTILITY PIPE CARBON STEEL  
 FLANGES RAISED FACE (UNLESS OTHERWISE NOTED)  
 ELECTRICAL: RIGID ALUMINUM CONDUIT; CABLE TRAY FOR MOTOR 575 VAC  
 POWER SUPPLY  
 SUITABLE FOR USE IN: CLASS 1, ZONE 2, GROUP IIA, T3

**POWER REQUIREMENTS**

CONTROL PANEL VOL: 24 VDC AMPS: NOM: 4.0 MAX: 10  
 FIRE DETECTION: VOL: 24 VDC AMPS: NOM: 0.1 MAX: 0.3  
 LEL DETECTION: VOL: 24 VDC AMPS: NOM: 0.1 MAX: 0.3  
 INT. LIGHTS: VOL: 120 VAC AMPS: NOM: 0.2 MAX: 0.5  
 EXT. LIGHTS: VOL: 120 VAC AMPS: NOM: 0.2 MAX: 0.5  
 OIL PUMP MOTOR: VOL: 575 VAC/3 PH/60HZ 5.6 kW (7.5 HP)  
 GLYCOL PUMP MOTOR: VOL: 575 VAC/3 PH/60HZ 2.24 kW (3 HP)  
 ENGINE GLYCOL HEATER PUMP MOTOR: VOL: 575 VAC/3 PH/60HZ 0.75 kW (1 HP)  
 ENGINE OIL HEATER PUMP MOTOR: VOL: 575 VAC/3 PH/60HZ 0.75 kW (1 HP)  
 BUILDING FAN MOTORS (5+1): VOL: 575 VAC/3 PH/60HZ 0.56 kW (0.75HP)  
 AIR COOLED FAN MOTOR (2): VOL: 575 VAC/3 PH/60HZ 14.9 kW (20 HP)  
 ENGINE GLYCOL HEATER: : 575 VAC/3 PH/60HZ 18 kW (24.1 HP)  
 ENGINE OIL HEATER: VOL: 575 VAC/3 PH/60HZ 6 kW (8 HP)  
 IMMERSION HEATER: VOL: 575 VAC/3 PH/60HZ 9 kW (12 HP)  
 BUILDING HEATER MOTOR: VOL: 575 VAC/3 PH/60HZ 0.375 kW (0.5 HP)

**SYSTEM CONSUMABLES**

COMPRESSOR LUBE OIL: CPI-S5-150 1915 LITERS, 506 GALLONS  
 COMPRESSOR SEAL POT OIL: ROYAL PURPLE FDA (GRADE 22) 31 LITERS  
 ENGINE CRANKCASE LUBE OIL: SAE 40, LOW ASH, 708 LITERS  
 GLYCOL: 50% ETHYLENE INHIBITED GLYCOL/WATER SOLUTION  
 EJW CAPACITY: 341 LITERS  
 AJW CAPACITY: 61 LITERS

**DESIGN SPECIFICATION:**

ENERFLEX LTD. (EFX) SCOPE OF SUPPLY ON THIS PROJECT CONSISTS OF ONE SKIDDED GAS COMPRESSOR PACKAGE.

PACKAGE CONSISTS OF ONE (1) CATERPILLAR 3606 ENGINE DRIVING A FRICK SGCB-3524, SWEET NATURAL GAS COMPRESSOR.

PRIMER: -SSPC-SP6/NACE NO. 3, EPOXY  
 PAINT: -SSPC-SP6/NACE NO. 3 ALIFATIC URETHANE, COLOR: GRAY/BLUE OEM, ENGINE, COMPRESSOR, CONTROL VALVES  
 PROCESS PIPING: -10% RADIOGRAPHIC TESTING  
 -1.6mm (1/16") CORROSION ALLOWANCE  
 -NO PWHT  
 -SSPC-SP6  
 -NO PICKLING  
 -OILED AFTER HYDRO  
 VESSELS: -10% RADIOGRAPHIC TESTING - RT2  
 -1.6mm (1/16") CORROSION ALLOWANCE  
 -NO PWHT  
 -SSPC-SP6  
 -NO PICKLING  
 -OILED AFTER HYDRO

PROCESS	
TUBING SPECIFICATION	DL74
TUBING MATERIAL	316SS
FITTING MATERIAL	316SS C/W SS FRONT AND BACK FERRULE
TUBING TRAYS	-
OD	MINIMUM WALL THICKNESS*
1/4"	0.035"
3/8"	0.035"
1/2"	0.049"
3/4"	0.065"
1"	0.083"
SPECIAL REQUIREMENT(S):	
UTILITY	
TUBING SPECIFICATION	DL74
TUBING MATERIAL	316SS
FITTING MATERIAL	316SS C/W SS FRONT & BACK FERRULE
TUBING TRAYS	-
OD	MINIMUM WALL THICKNESS*
1/4"	0.035"
3/8"	0.035"
1/2"	0.049"
3/4"	0.065"
1"	0.083"
SPECIAL REQUIREMENT(S):	

**FINAL AS BUILT**  
 NAME: C.SMITH DATE: JAN 02/14


3	FINAL AS BUILT	JAN 02/14	CS	SG	DATE	DEC 10/12	SCALE	NTS	DEVON CANADA FERRIER CPF BATTERY SCREW CATERPILLAR G3606LE FRICK SGCB-3524	<b>ENERFLEX</b> Calgary, Alberta, Canada	P & I DIAGRAM PROJECT DESCRIPTION & OVERVIEW					
2	FINAL AS BUILT	NOV 21/13	AR	SG	DRAWN BY	A.HAMMOND	CHECKED BY	S.GURI				APPROVED BY	B.MINSHULL			
1	ISSUED FOR CONSTRUCTION	JUN 21/13	CS	SG	PROJECT MANAGER	B.MINSHULL	PROJECT ENGINEER	S.GURI								
0	ISSUED FOR CONSTRUCTION	APR 09/13	AT	SG	CUST PO	4100000964										
B	ISSUED FOR APPROVAL	FEB 08/13	AH	SG												
A	ISSUED FOR APPROVAL	JAN 18/13	AH	SG												
REV	DESCRIPTION	DATE	BY	APR	APEGGA PERMIT No:	P8651	OPER. CODE		WORK ORDER	12618-01	DWG NO	12618-01-099	SHT	1	REV	3

PLOT: 21 Oct. 2014 - 2:46pm. atrom THE INFORMATION CONTAINED HEREIN IS THE CONFIDENTIAL PROPERTY OF ENERFLEX, LTD. AND IS NOT FOR PUBLICATION, AND NO PART THEREOF SHALL BE COPIED OR COMMUNICATED TO A THIRD PARTY WITHOUT AUTHORIZATION FROM ENERFLEX, LTD.

001-PK-02-1000  
BATTERY GAS  
COMPRESSOR PACKAGE #1

001-V-02-1010  
SUCTION SCRUBBER

MFG: EFX  
SIZE: 1219mm(48") OD X 2591mm(102") S/S  
MAWP: 1689kPag(245 PSIG) @ 121°C(250°F)  
MDMT: -29°C(-20°F) @ 1689kPag(245 PSIG)  
CA: 1.6mm(1/16")  
MATL: CARBON STEEL  
ELEMENTS: NON-REMOVABLE VANEPACK  
MTR: STAINLESS STEEL (316)  
S/N: 12618014211  
CRN: WT465.2

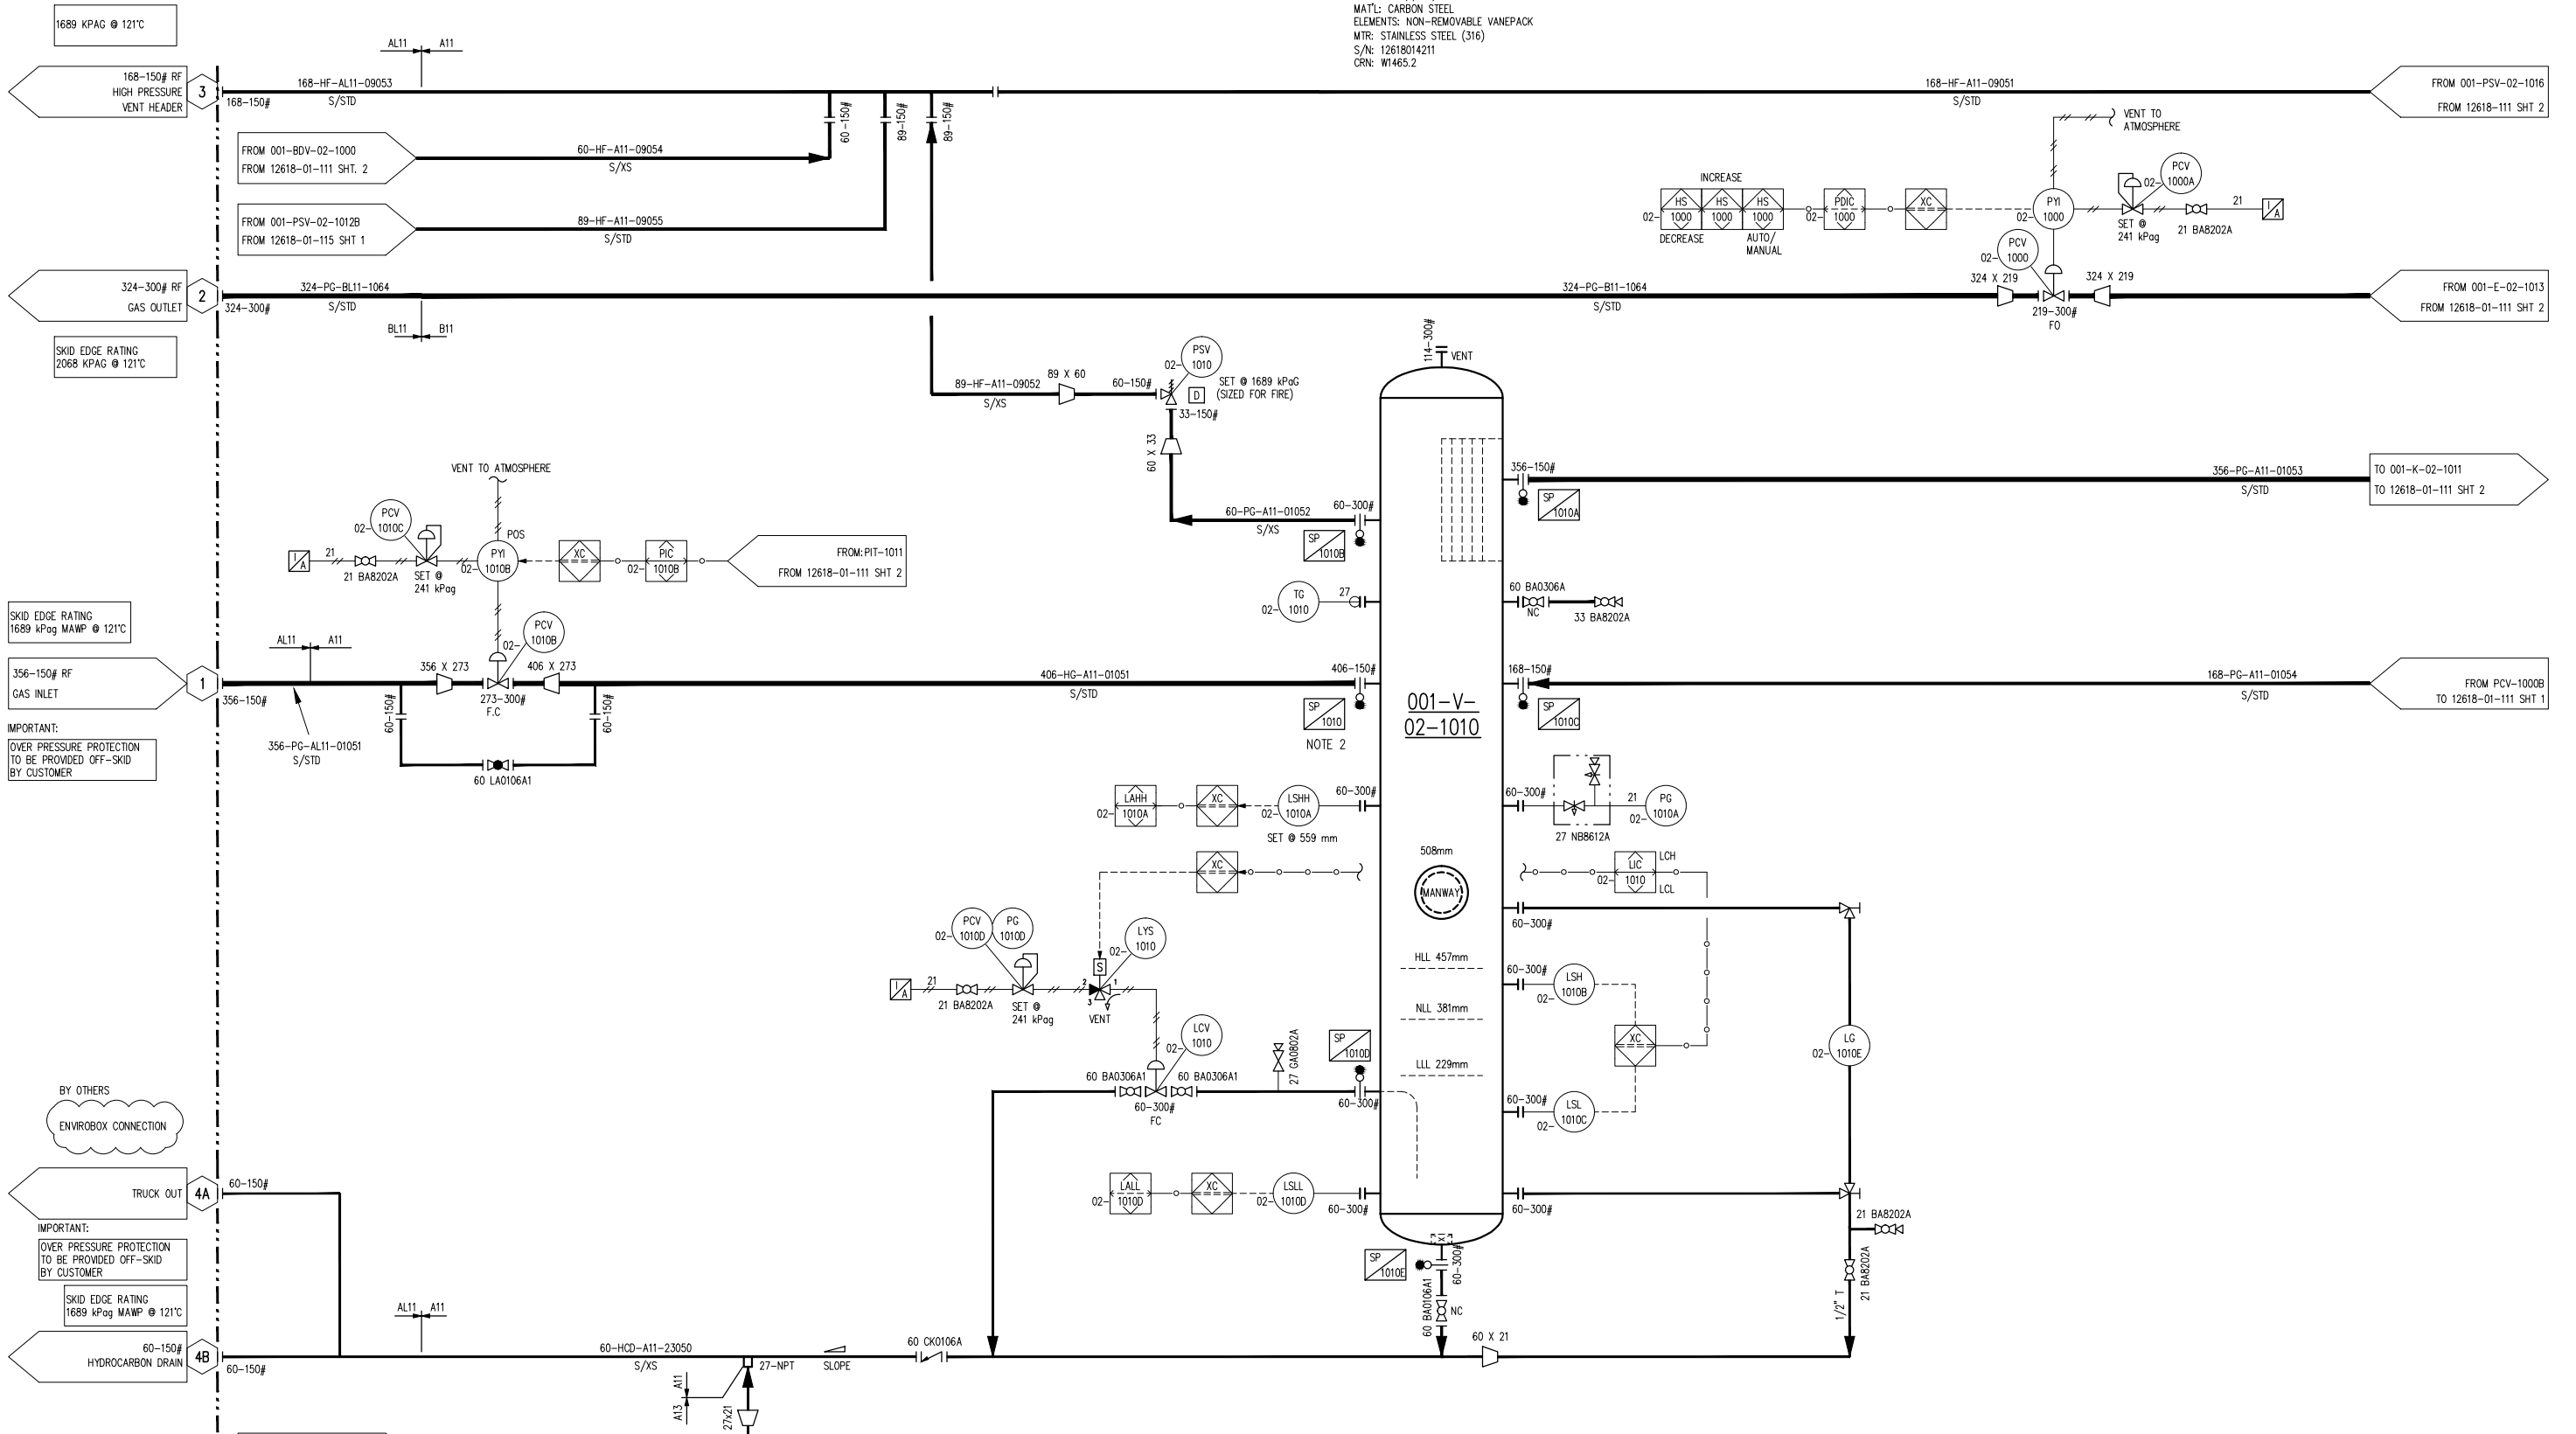

SKID EDGE RATING  
1689 kPag MAWP @ 121°C

IMPORTANT:  
OVER PRESSURE PROTECTION  
TO BE PROVIDED OFF-SKID  
BY CUSTOMER

BY OTHERS  
ENVIROBOX CONNECTION

TRUCK OUT

IMPORTANT:  
OVER PRESSURE PROTECTION  
TO BE PROVIDED OFF-SKID  
BY CUSTOMER

SKID EDGE RATING  
1689 kPag MAWP @ 121°C

HYDROCARBON DRAIN

FROM FL-02-1033  
FROM 12618-01-115 SHT. 1

- NOTES:
- LSLL-1010D TO HAVE "C" TIMER ON THE PLC.
  - SPECTACLE BLINDS ARE PCR AND APPLIED ON SUCTION SCRUBBER ONLY.
  - LG TO HAVE 45° FITTINGS.

REV	DESCRIPTION	DATE	BY	APR
4	FINAL AS BUILT	AUG 28/14	TW	AA
3	FINAL AS BUILT	JAN 02/13	CS	SG
2	FINAL AS BUILT	NOV 21/13	AR	SG
1	ISSUED FOR CONSTRUCTION	JUN 21/13	CS	SG
0	ISSUED FOR CONSTRUCTION	APR 09/13	AT	SG
B	ISSUED FOR APPROVAL	FEB 08/13	AH	SG

DATE	DEC 10/12	SCALE	NTS
DRAWN BY	A.HAMMOND	CHECKED BY	S.GURI
PROJECT MANAGER	B.MINSHULL	PROJECT ENGINEER	S.GURI
CUST PO	410000964		

DEVON CANADA FERRIER CPF  
BATTERY SCREW  
CATERPILLAR G3606LE  
FRICK SCGB-3524


**ENERFLEX**  
Calgary, Alberta,  
Canada

P & I DIAGRAM  
PROCESS GAS

DWG NO 12618-01-111  
SHT 1  
REV 4

PLOT 21 Oct. 2014-2:47pm. ation

**FINAL AS BUILT**  
NAME T.WELSH DATE AUG 28/14

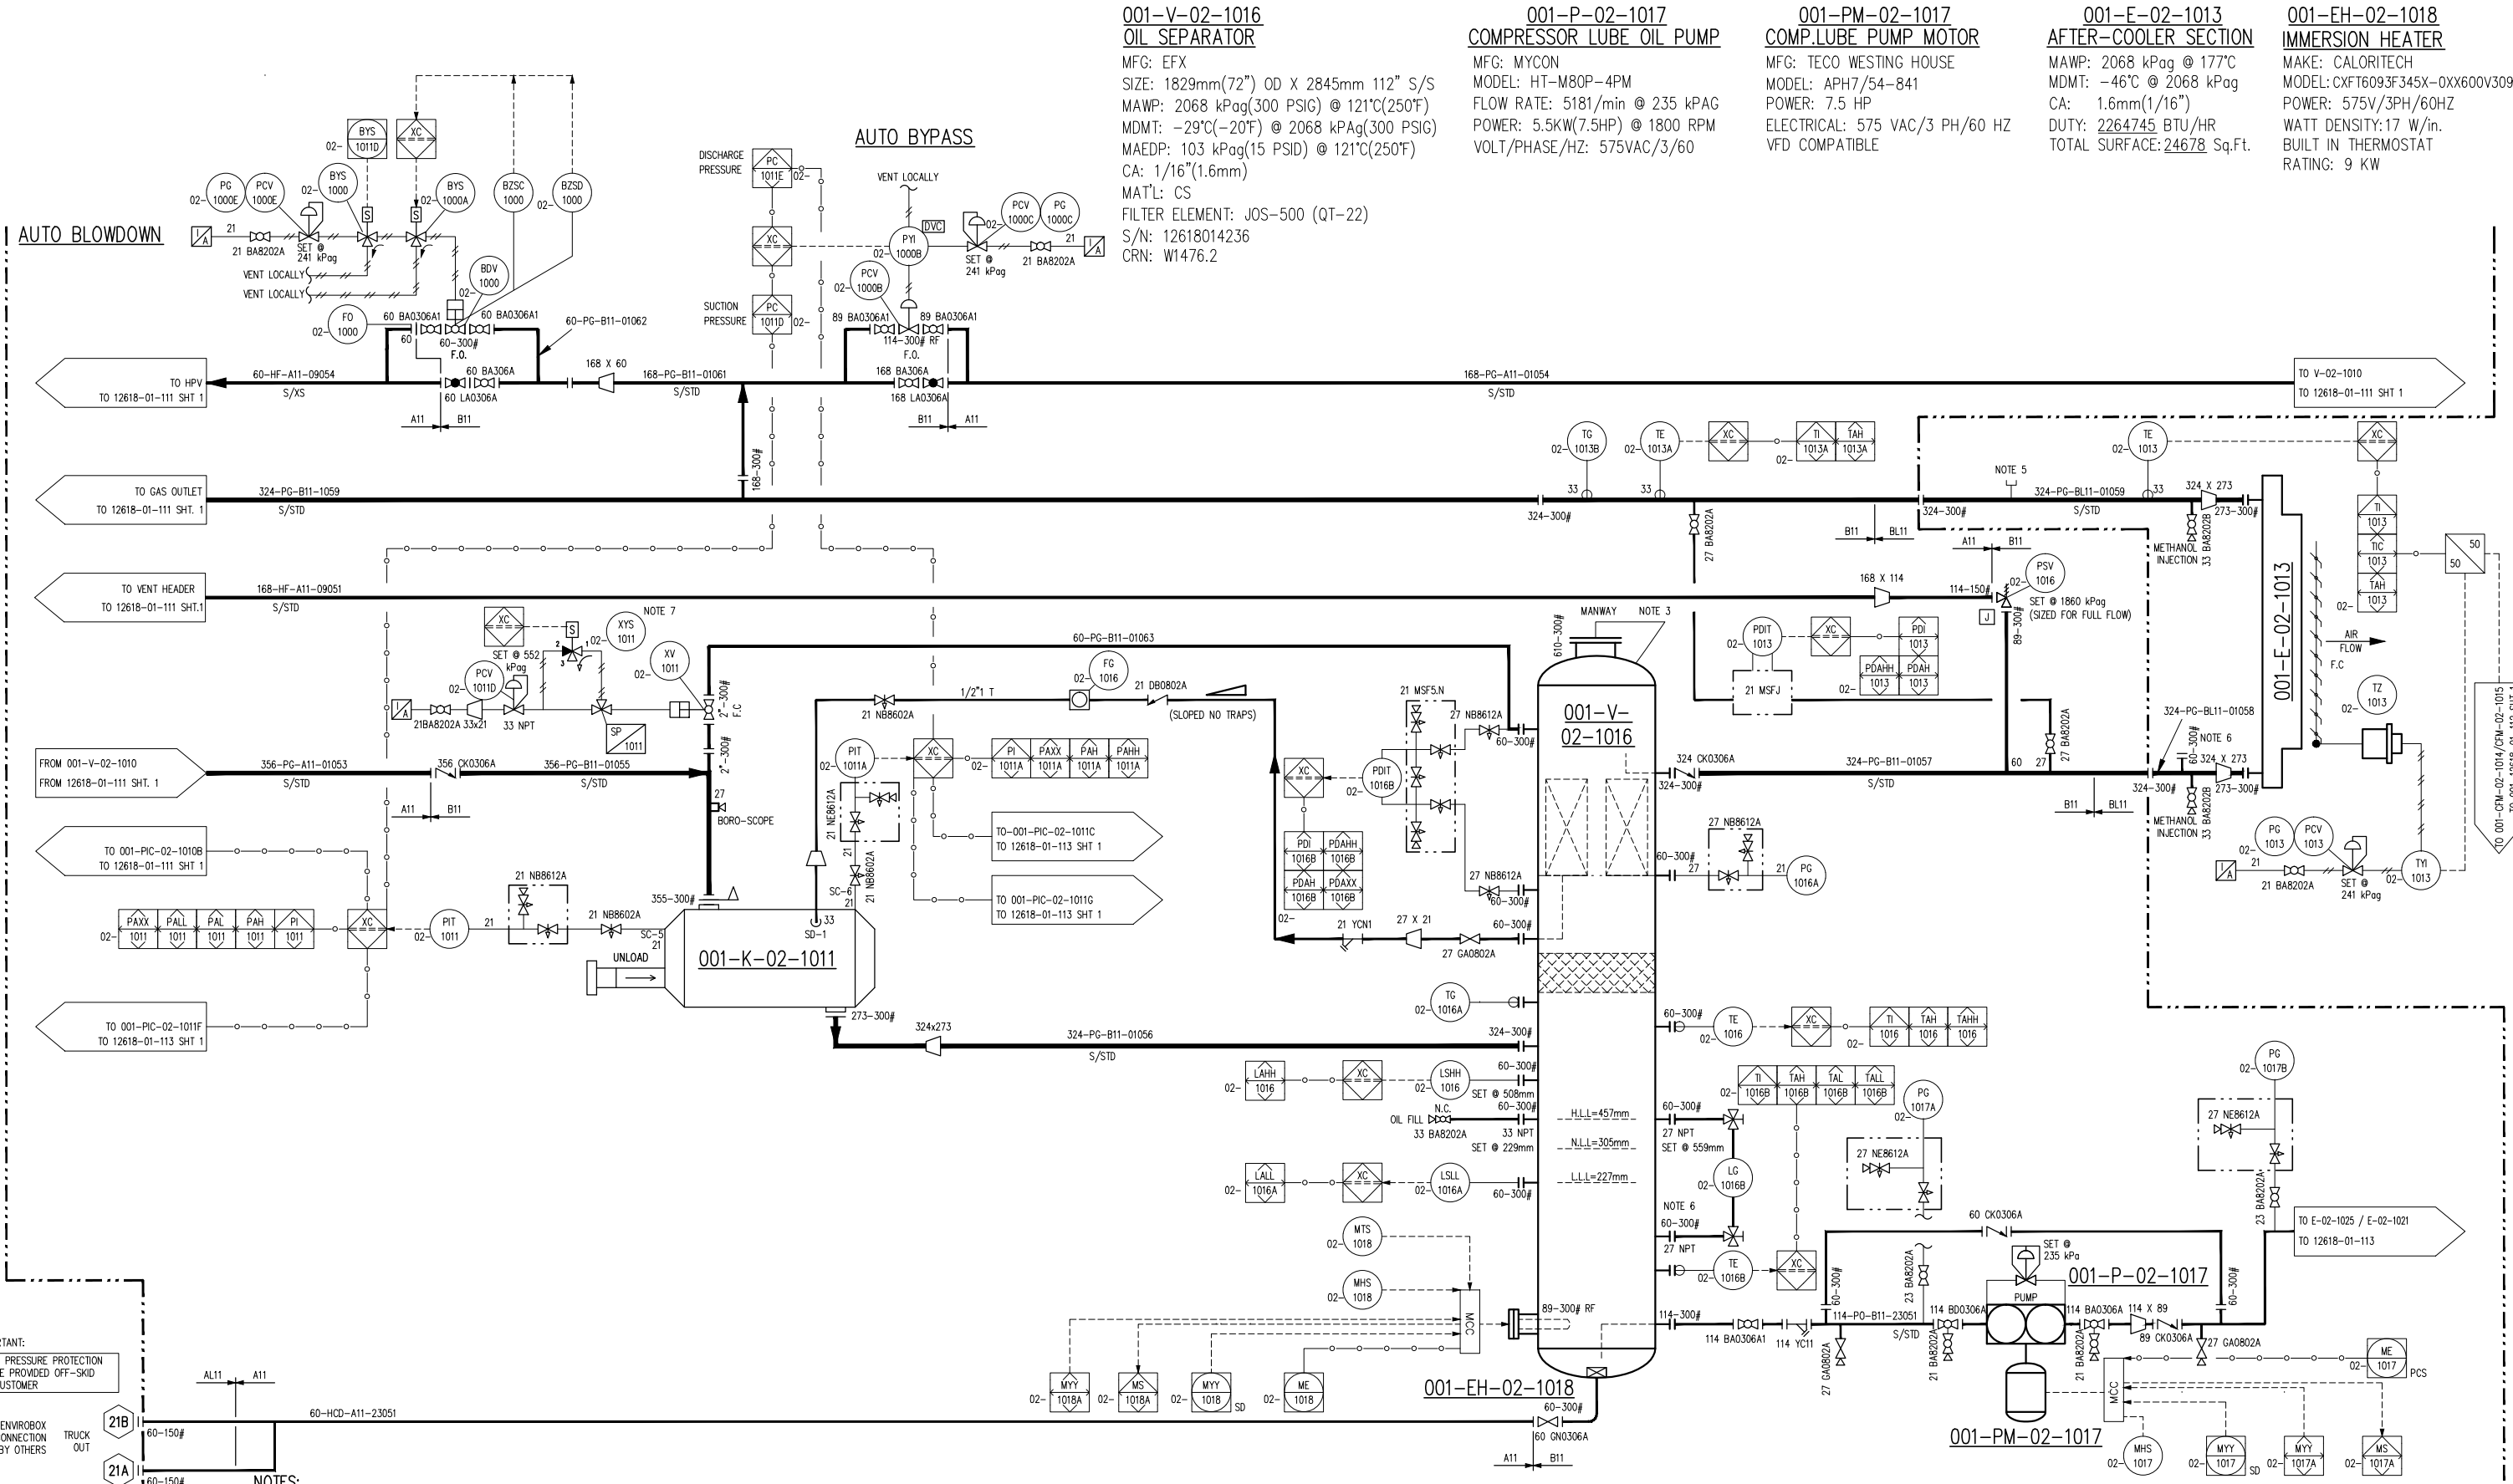

**001-V-02-1016**  
**OIL SEPARATOR**  
 MFG: EFX  
 SIZE: 1829mm(72") OD X 2845mm 112" S/S  
 MAWP: 2068 kPag(300 PSIG) @ 121°C(250°F)  
 MDMT: -29°C(-20°F) @ 2068 kPag(300 PSIG)  
 MAEDP: 103 kPag(15 PSID) @ 121°C(250°F)  
 CA: 1/16"(1.6mm)  
 MAT'L: CS  
 FILTER ELEMENT: JOS-500 (QT-22)  
 S/N: 12618014236  
 CRN: W1476.2

**001-P-02-1017**  
**COMPRESSOR LUBE OIL PUMP**  
 MFG: MYCON  
 MODEL: HT-M80P-4PM  
 FLOW RATE: 5181/min @ 235 kPag  
 POWER: 5.5KW(7.5HP) @ 1800 RPM  
 VOLT/PHASE/HZ: 575VAC/3/60

**001-PM-02-1017**  
**COMP. LUBE PUMP MOTOR**  
 MFG: TECO WESTING HOUSE  
 MODEL: APH7/54-841  
 POWER: 7.5 HP  
 ELECTRICAL: 575 VAC/3 PH/60 HZ  
 VFD COMPATIBLE

**001-E-02-1013**  
**AFTER-COOLER SECTION**  
 MAWP: 2068 kPag @ 177°C  
 MDMT: -46°C @ 2068 kPag  
 CA: 1.6mm(1/16")  
 DUTY: 2264745 BTU/HR  
 TOTAL SURFACE: 24678 Sq.Ft.

**001-EH-02-1018**  
**IMMERSION HEATER**  
 MAKE: CALORITECH  
 MODEL: CXFT6093F345X-0XX600V309KW  
 POWER: 575V/3PH/60HZ  
 WATT DENSITY: 17 W/in.  
 BUILT IN THERMOSTAT  
 RATING: 9 KW

**AUTO BLOWDOWN**

**AUTO BYPASS**

IMPORTANT:  
 OVER PRESSURE PROTECTION  
 TO BE PROVIDED OFF-SKID  
 BY CUSTOMER

ENVIROBOX  
 CONNECTION  
 BY OTHERS

- NOTES:**
1. REMOVABLE SPOOL WITH LIFTING LUGS
  2. DAVIT ARM.
  3. BOROSCOPE INSPECTION POINT TO BE LOCATED CLOSE TO STRAINER.
  4. CORROSION COUPONS.
  5. INJECTION OF CORROSION INHIBITOR.
  6. SIGHT GLASS AND GAUGE TO HAVE 45° FITTING
  7. SOLENOID WILL BE ACTIVATED AT 400 RPM DECREASING ON ENGINE.

**FINAL AS BUILT**  
 NAME: T.WELSH DATE: AUG 28/14

5	FINAL AS BUILT	AUG 28/14	TW	AA	DATE	DEC 10/12	SCALE	NTS	DEVON CANADA FERRIER CPF BATTERY SCREW CATERPILLAR G3606LE FRICK SGB-3524	<b>ENERFLEX</b> Calgary, Alberta, Canada	P & I DIAGRAM PROCESS GAS	SHT 2	REV 5
4	FINAL AS BUILT	JAN 02/14	CS	SG	DRAWN BY	A.HAMMOND	CHECKED BY	S.GURI					
3	FINAL AS BUILT	NOV 21/13	AR	SG	PROJECT MANAGER	B.MINSHULL	PROJECT ENGINEER	S.GURI	DWG NO		12618-01-111		
2	REVISED TAGGING	AUG 28/13	AT	LD	CUST PO	4100000964	OPER. CODE		WORK ORDER		12618-01		
1	ISSUED FOR CONSTRUCTION	AUG 22/13	CS	SG	APEGGA PERMIT No: P8651		OPER. CODE		WORK ORDER		12618-01		
0	ISSUED FOR CONSTRUCTION	APR 09/13	AT	SG									
REV	DESCRIPTION	DATE	BY	APR									

PLOT: 21 Oct, 2014 - 2:47pm, atlan

**001-K-02-1011**  
**SCREW GAS COMPRESSOR**  
 MFG: FRICK  
 MODEL: SGCB 3524  
 OPERATING SPEED: 3600 RPM  
 SUCTION PRESS: 280 KPAG  
 DISCHARGE PRESS: 800 KPAG  
 SUCTION FLOW DESIGN: 24.83 MMSCFD  
 OIL TEMP: 71°C (160°F)  
 MAWP: 2758 KPAG (400 PSIG)  
 MAWT: 121°C (250°F)  
 MDWP: FULL VACUUM  
 S/N: 10241B31410623Z

**001-E-02-1019**  
**SPEED INCREASER OIL COOLER**  
 MAKE: PACIFIC RIM  
 MODEL: EK-1048  
 MAWP: 1034 KPAG (150 PSIG)  
 OIL IN/OUT: 60mm (2" NPT)  
 GLYCOL IN (OUT): 48mm (1 1/2" NPT)  
 HEAT LOAD: 103,534 BTU/HR

**001-SP-02-1022**  
**SPEED INCREASER**  
 MAKE: PACIFIC RIM  
 MODEL: EMPB 1000A-DD1  
 RATIO: 1:3.612  
 INPUT: 1000 RPM  
 OUTPUT: 3612 RPM

**001-KM-02-1012**  
**COMPRESSOR GAS ENGINE**  
 MFG: CATERPILLAR  
 MODEL: G3606LE  
 BORE: 11.8 IN.  
 STROKE: 11.8 IN.  
 DISPLACEMENT: 7,762 IN CU  
 COMP. RATIO:  
 POWER: 1775 BHP @ 1000 RPM

**001-CF-02-1014**  
**AIR COOLER FAN #1**  
 MAKE: MOORE  
 MODEL: 10K-42EC  
 POWER: 16.8 HP  
 FAN DIAMETER: 3353mm (132")  
 NR. BLADES: 6  
 RPM: 227  
 PITCH: 11.6 DEGREE

**001-CFM-02-1014**  
**AIR COOLER FAN MOTOR #1**  
 MAKE: TECO  
 MODEL: IE4E 841  
 POWER: 20 HP  
 RPM: 1800 RPM : V-BELT  
 POWER SUPPLY: 575 VAC/60 HZ/ 3 PH  
 VFD: COMPATIBLE



**001-CF-02-1015**  
**AIR COOLER FAN #2**  
 MAKE: MOORE  
 MODEL: 10K-42EC  
 POWER: 16.8 HP  
 FAN DIAMETER: 3353mm (132")  
 NR. BLADES: 6  
 RPM: 227  
 PITCH: 11.6 DEGREE

**001-CFM-02-1015**  
**AIR COOLER FAN MOTOR #2**  
 MAKE: TECO  
 MODEL: IE4E 841  
 POWER: 20 HP  
 RPM: 1800 RPM : V-BELT  
 POWER SUPPLY: 575 VAC/60 HZ/ 3 PH  
 VFD: COMPATIBLE

**001-E-02-1049**  
**PACKAGE COOLER FRAME**  
 MFG: AIR-X-LIMITED  
 MODEL: 132-22F-R  
 TYPE: FORCED DRAFT  
 REQ'D AIR FLOW: 215,114 SCFM  
 AMBIENT AIR TEMP: 35°C (95°F)  
 AIR TEMP OUT: 53°C (127.5°F)  
 C/W: RECIRC. CHAMBER

**001-FL-02-1028**  
**OIL FILTER**  
 MAKE: PACIFIC RIM  
 SUPPLIED WITH GEARBOX

**001-CPL-02-1053**  
**COMPRESSOR COUPLING**  
 MFG: REXNORD  
 MODEL: 375 SERIES 71

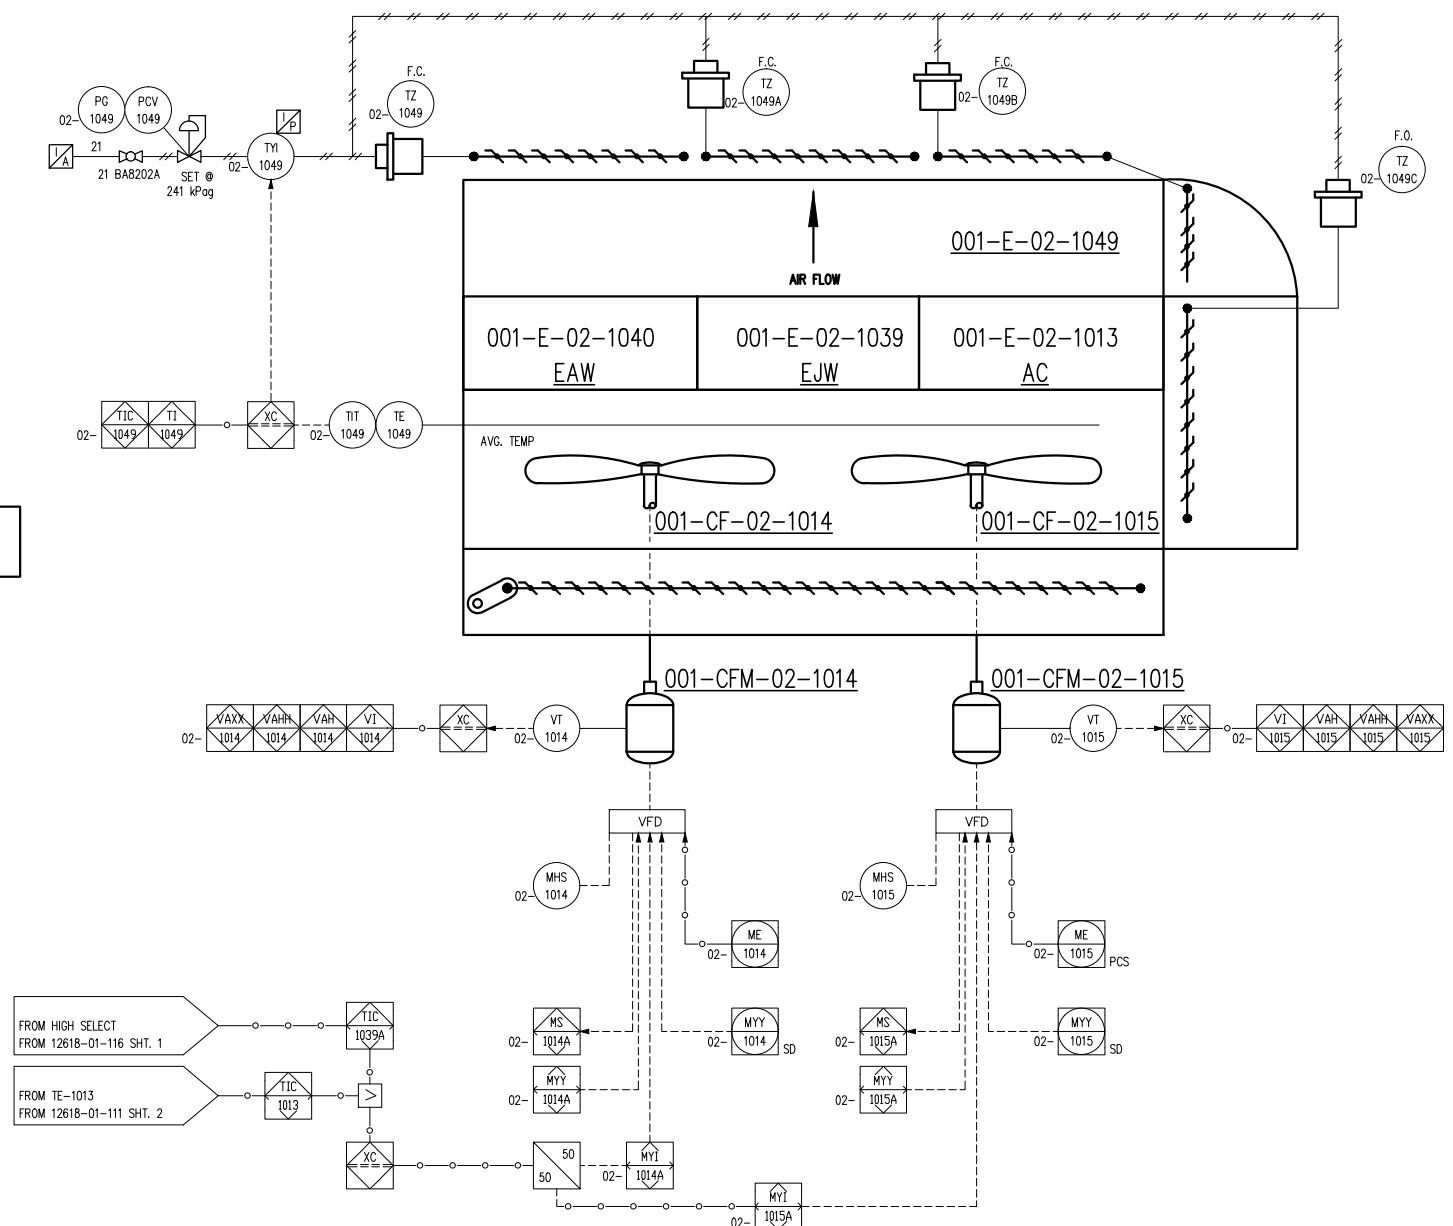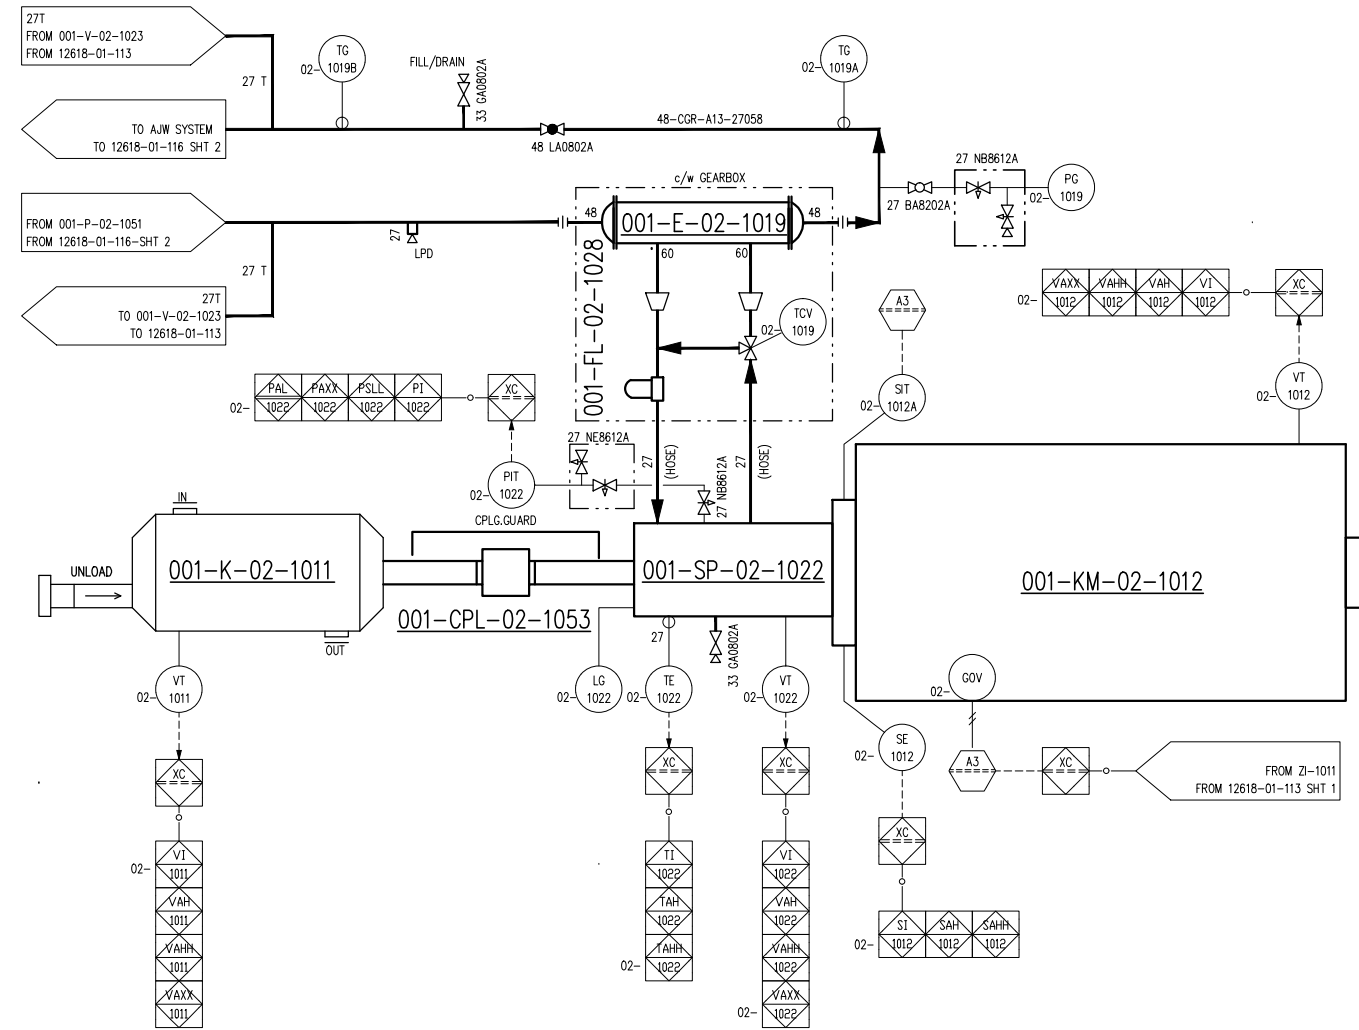

PLOT 21 Oct 2014 2:47pm, dtron

**FINAL AS BUILT**  
 NAME T.WELSH DATE AUG 28/14

5	FINAL AS BUILT	AUG 28/14	TW	AA	DATE DEC 10/12	SCALE NTS	DEVON CANADA FERRIER CPF	<b>ENERFLEX</b> Calgary, Alberta, Canada	P & I DIAGRAM DRIVE TRAIN/ CONTROL PANEL	
4	FINAL AS BUILT	JAN 02/14	CS	SG	DRAWN BY A.HAMMOND	CHECKED BY S.GURI	BATTERY SCREW CATERPILLAR G3606LE FRICK SGCB-3524			
3	FINAL AS BUILT	NOV 21/13	AR	SG	PROJECT MANAGER B.MINSHULL	PROJECT ENGINEER S.GURI				
2	REVISED TAGGING	AUG 28/13	AT	LD						
1	ISSUED FOR CONSTRUCTION	JUN 21/13	CS	SG	CUST PO 4100000964					
0	ISSUED FOR CONSTRUCTION	APR 09/13	AT	SG						
REV	DESCRIPTION	DATE	BY	APR	APEGGA PERMIT No: P8651	OPER. CODE	WORK ORDER 12618-01	DWG NO 12618-01-112	SHT 1	REV 5

001-UHG-02-1080/81/82  
GLYCOL BLDG. HEATERS  
MFG: RUFFNECK  
MODEL: AH-24A-A5  
MAWP: 2068 kPag (300 PSIG)  
MAWT: 150°C (300°F)

001-UHM-02-1080/81/82  
GLYCOL BLDG. HEATERS MOTORS  
MFG: TECO  
POWER: 0.5 HP (0.373 kW)  
ELECTRICAL: 575VAC/60HZ/3PH

001-BU-02-1000  
PACKAGE UNIT BUILDING  
MAKE: NOISE SOLUTION  
DIMENSIONS: 24'x40'x15'-6" EAVE, 4:12 ROOF  
ACOUSTIC INSULATION WALL & ROOF  
REMOVABLE ROOF PANELS  
ACOUSTIC SKIRTING  
P.ENG. STAMPED

















001-EF-02-1095  
BLDG PURGE FAN  
POWER: 0.75 HP (0.56 kW)  
16" DIA.  
6ACPH, 1957 CFM

001-EFM-02-1095  
BLDG PURGE FAN MOTOR  
MAKE: MARATHON  
POWER: 0.75 HP (0.56 kW)  
ELEC: 575 VAC/3PH/60HZ




001-EF-02-1090/1/2/3/4  
BLDG. EXHAUST FAN  
MFG: NSI  
MODEL: BVDFVRE065036030  
POWER: 0.75 HP (0.56 kW)  
24" LOW NOISE FAN  
4200 SCFM @ 0.25" WC STATIC PRESSURE

001-EFM-02-1090/1/2/3/4  
BLDG. EXHAUST FAN MOTOR  
MFG: MARATHON  
POWER: 0.75 HP (0.56 kW)  
ELECTRICAL: 575VAC/60HZ/3PH

001-PLC-02-1011  
COMPRESSOR CONTROL PANEL  
MAKE: SPARTAN CONTROLS  
MODEL: REMVUE-500

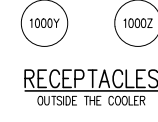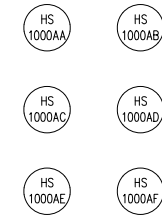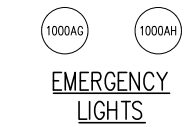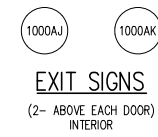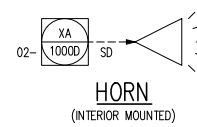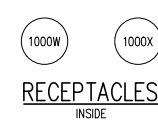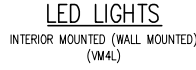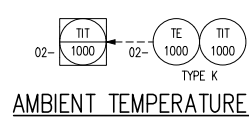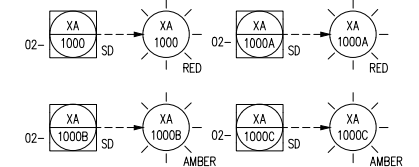
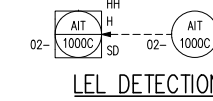
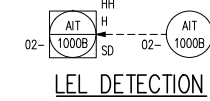
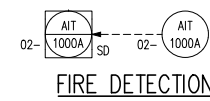
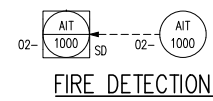
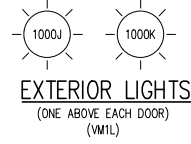
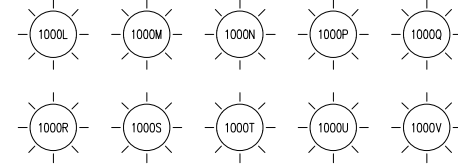
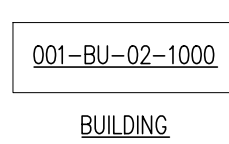


001-PLC-02-1001

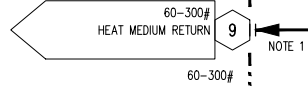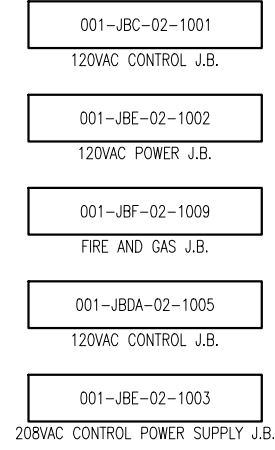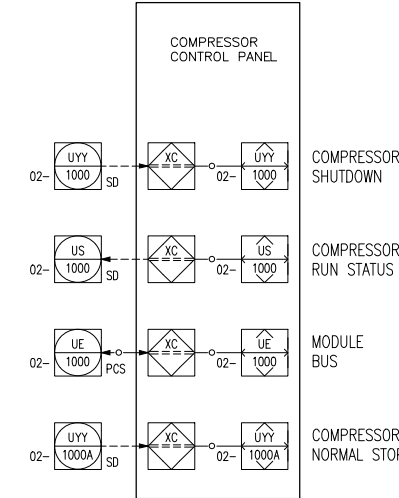

IMPORTANT:  
OVER PRESSURE PROTECTION  
TO BE PROVIDED OFF-SKID  
BY CUSTOMER

RATING  
1693 kPag MAWP @ 120°C

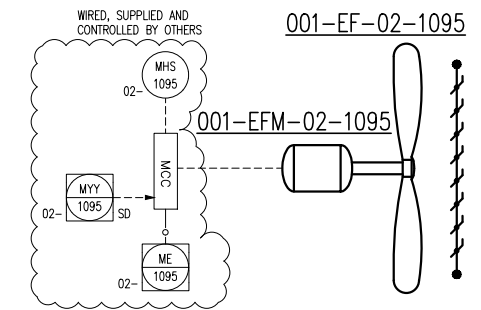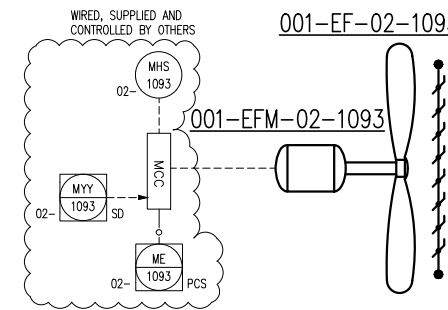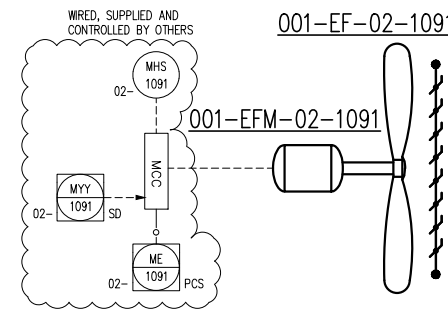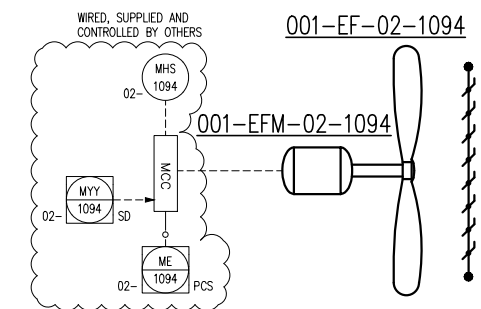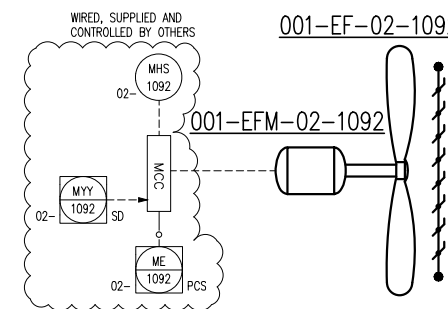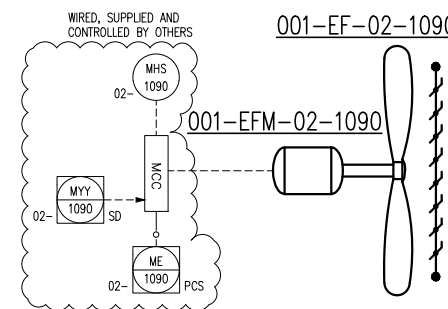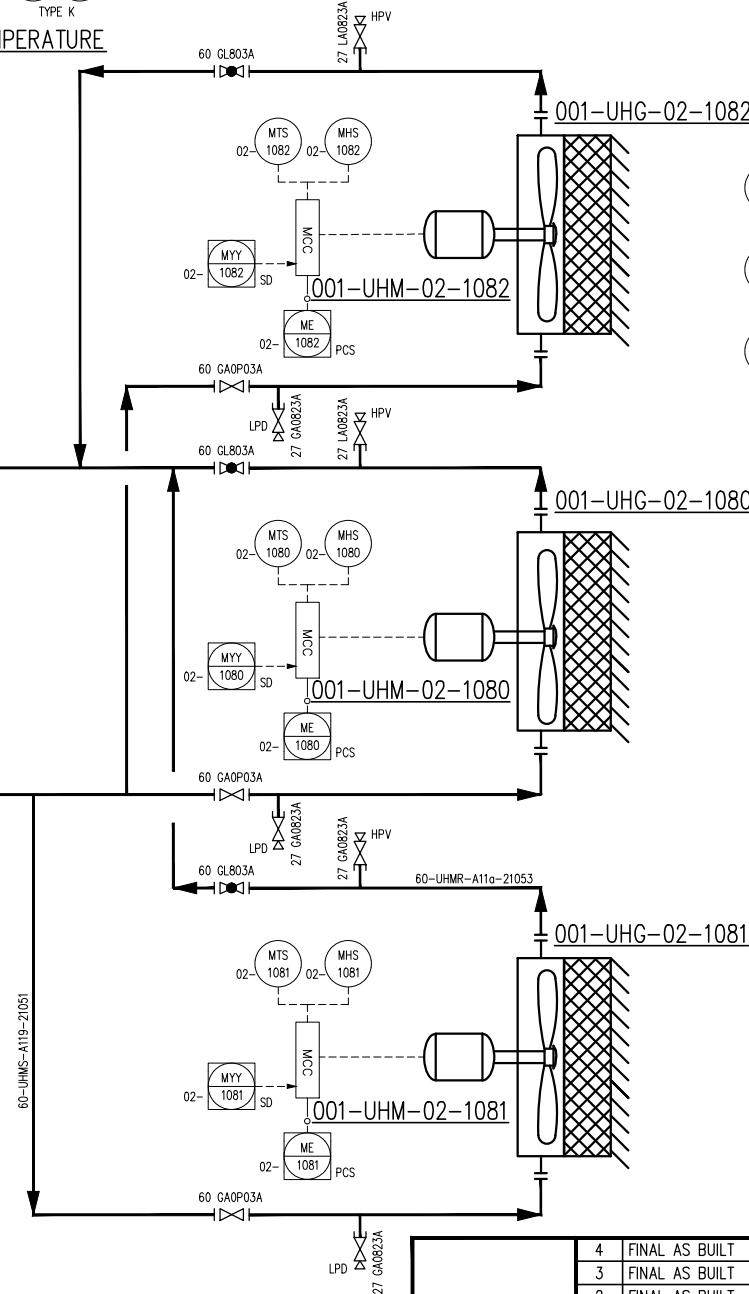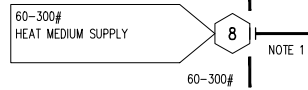

**FINAL AS BUILT**  
NAME: T.WELSH DATE: AUG 28/14

NOTES:  
1. ALL HEAT MEDIUM PIPING TO BE KEPT 7" ABOVE TOP OF STEEL.

REV	DESCRIPTION	DATE	BY	APR
4	FINAL AS BUILT	AUG 28/14	TW	AA
3	FINAL AS BUILT	JAN 02/14	CS	SG
2	FINAL AS BUILT	NOV 21/13	AR	SG
1	ISSUED FOR CONSTRUCTION	JUN 21/13	CS	SG
0	ISSUED FOR CONSTRUCTION	APR 09/13	AT	SG
B	ISSUED FOR APPROVAL	FEB 08/13	AH	SG

DATE: DEC 10/12 SCALE: NTS  
DRAWN BY: A.HAMMOND CHECKED BY: S.GURI APPROVED BY: B.MINSHULL  
PROJECT MANAGER: B.MINSHULL PROJECT ENGINEER: S.GURI  
CUST PO 410000964

DEVON CANADA FERRIER CPF  
BATTERY SCREW  
CATERPILLAR G3606LE  
FRICK SGCB-3524

**ENERFLEX**  
Calgary, Alberta,  
Canada

P & I DIAGRAM  
DRIVE TRAIN/  
BUILDING COMPONENTS

DWG NO: 12618-01-112 SHT: 2 REV: 4

**001-E-02-1025  
COMPRESSOR OIL COOLER #2**

MFG: GEA  
MODEL: FPA 10X20-130/9156-UM  
PLATE MATERIAL: 316 STAINLESS STEEL  
MAWP: 2758 KPAG (400 PSIG)  
MAWT: 177°C (350°F)  
LOAD: 1.124096 BTU/HR  
CONNECTIONS: 60mm (2")-300 IN/OUT  
WEIGHT: 70.7 KG (156 LBS)

**001-E-02-1021  
COMPRESSOR OIL COOLER #1**

MFG: GEA  
MODEL: FPA 10X20-130/9156-UM  
PLATE MATERIAL: 316 STAINLESS STEEL  
MAWP: 2758 KPAG (400 PSIG)  
MAWT: 177°C (350°F)  
LOAD: 1.124096 BTU/HR  
CONNECTIONS: 60mm (2")-300 IN/OUT  
WEIGHT: 70.7 KG (156 LBS)

**001-V-02-1023  
SEAL POT**


MFG: EFX  
MODEL: API-PLAN 52  
SIZE: 219 mm(8") OD x 958 mm(38") OAL  
MAWP: 1723 kPag @ 93°C  
SHELL MTL: 316 SS  
HEAD MTL: 316 SS  
S/N: 12618014259  
CRN: V9745.2

**001-FL-02-1024  
LUBE OIL FILTER**

MFG: EFX  
SIZE: 219mm(8 5/8") OD X 660mm(26") S/F  
MAWP: 3103 kPag @ 121°C  
MDWT: -29°C @ 3103 kPag  
CA: 1.6mm(1/16")  
ELEMENT: (1) MODEL 1833C10 10 MICRON  
MTRL: CARBON STEEL  
S/N: 12618014242  
CRN: T4404.213

**001-FL-02-1046  
LUBE OIL FILTER**

MFG: EFX  
SIZE: 219mm(8 5/8") OD X 660mm(26") S/F  
MAWP: 3103 kPag @ 121°C  
MDWT: -29°C @ 3103 kPag  
CA: 1.6mm(1/16")  
ELEMENT: (1) MODEL 1833C10 10 MICRON  
MTRL: CARBON STEEL  
S/N: 12618014241  
CRN: T4404.213

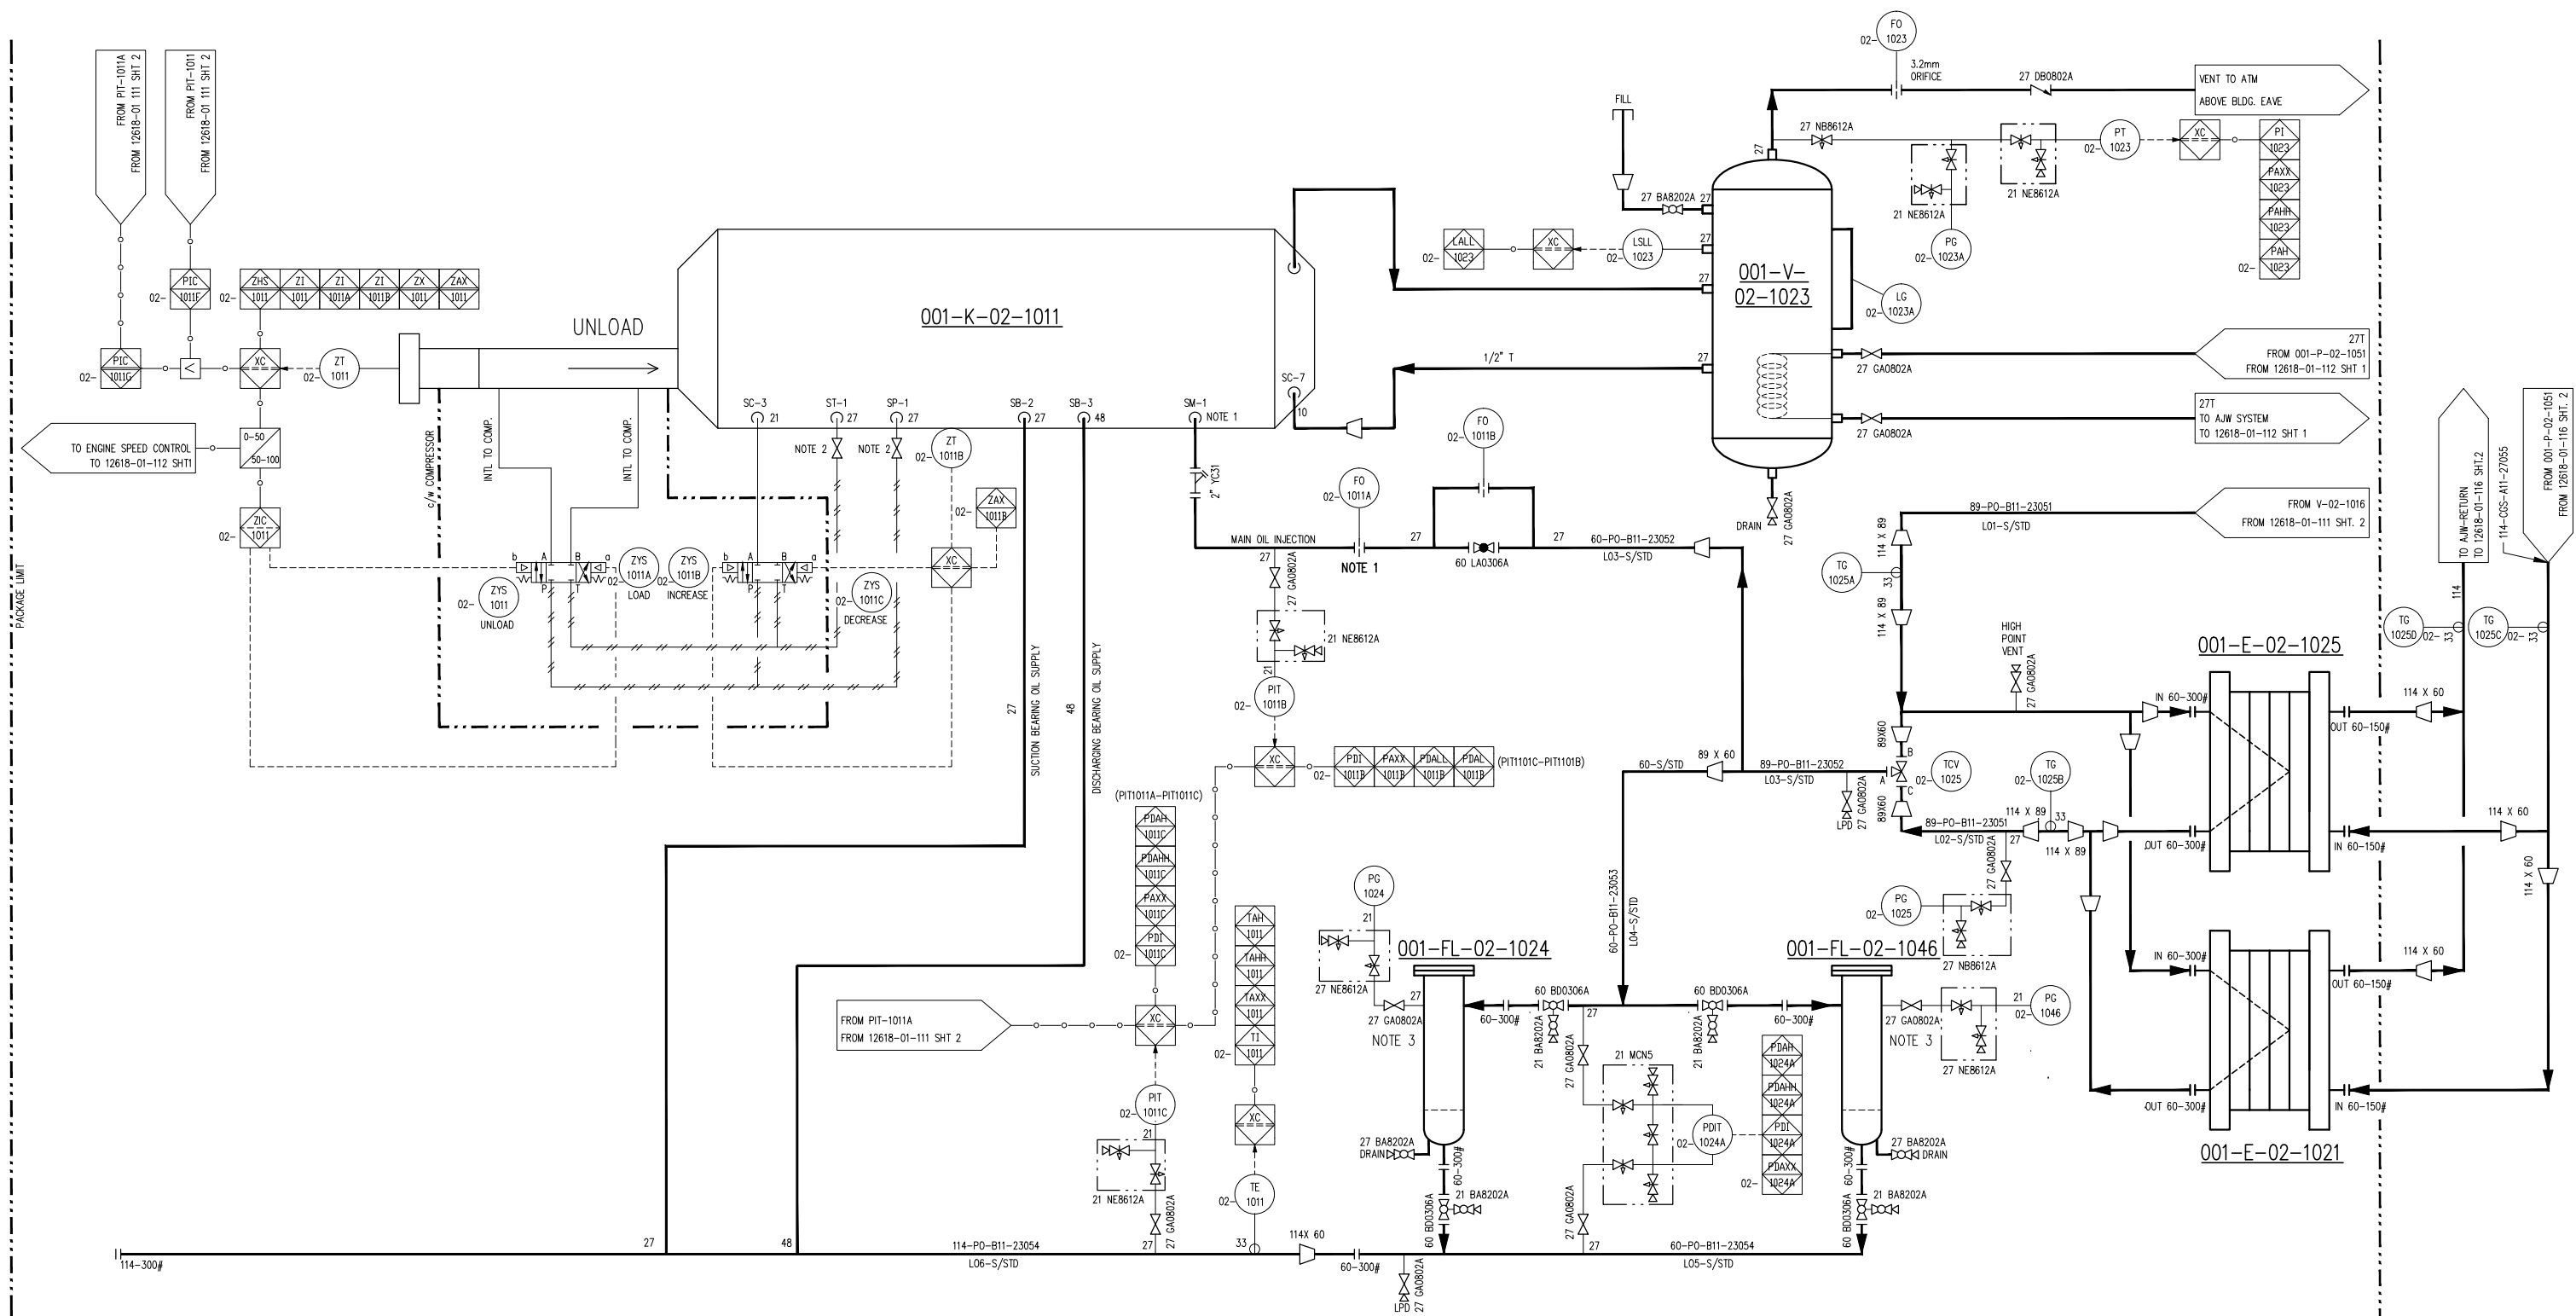

**NOTES:**

- ORIFICE SUPPLIED WITH COMPRESSOR.
- VALVES SUPPLIED WITH COMPRESSOR.
- LOCATE AS HIGH AS POSSIBLE.

**FINAL AS BUILT**  
NAME: T.WELSH DATE: AUG 28/14

REV	DESCRIPTION	DATE	BY	APR	APEGGA PERMIT No: P8651	OPER. CODE	WORK ORDER
6	FINAL AS BUILT	AUG 28/14	TW	AA	DATE DEC 10/12	SCALE NTS	DEVON CANADA FERRIER CPF
5	FINAL AS BUILT	MAY 30/14	TW	SG	DRAWN BY A.HAMMOND	CHECKED BY S.GURI	APPROVED BY B.MINSHULL
4	FINAL AS BUILT	MAY 28/14	TW	SG	PROJECT MANAGER B.MINSHULL	PROJECT ENGINEER S.GURI	
3	FINAL AS BUILT	JAN 02/14	CS	SG			
2	FINAL AS BUILT	NOV 21/13	AR	SG			
1	ISSUED FOR CONSTRUCTION	JUN 21/13	CS	SG			

DEVON CANADA FERRIER CPF  
BATTERY SCREW  
CATERPILLAR G3606LE  
FRICK SGCB-3524

**ENERFLEX**  
Calgary, Alberta,  
Canada

P & I DIAGRAM  
COMPR. LUBE OIL & UTILITIES

DWG NO: 12618-01-113 SHT: 1 REV: 6

**001-UHE-02-1026**  
**ENGINE OIL/HEATER**  
 MFG: KIM HOTSTART  
 HEATER: 6KW (805HP)  
 PUMP: 1HP (0.746 KW)  
 11GPM @ 1750RPM  
 POWER: 575V/3PH/60HZ  
 WIRED BY OTHERS

**001-T-02-1027**  
**WASTE OIL TANK**  
 MFG: EFX  
 CAPACITY: 2124 L (561 CIGS)

**001-P-02-1030**  
**ENGINE LUBE OIL PUMP**  
 MFG: CATERPILLAR  
 CAPACITY: 1401 LPM (370 GPM) @ 1000 RPM


**001-P-02-1029**  
**ENGINE PRE/POST LUBE OIL PUMP**  
 MFG: CATERPILLAR (TDI)  
 CAPACITY: 76 LPM (20 GPM)  
 AIR CONSUMPTION: 239 SCFM @ 120 PSIG

**001-FL-02-1031**  
**ENG OIL FILTER**  
 MFG: CATERPILLAR

**001-FL-02-1044/45**  
**ENGINE OIL SPINNER/FILTER**  
 MFG: T.F. HUDGINS INC.  
 MODEL: SPINNER2 (600-12HD)

**001-FL-02-1050**  
**OIL SUPPLY FILTER**  
 MFG: BALDWIN  
 MODEL: BT-251  
 27mm (3/4") NPT IN/OUT  
 DESIGN PRESSURE: 689 kPag

**001-T-02-1032**  
**ENGINE OIL DAY TANK**  
 MFG: EFX (INTEGRAL WITH CRANE RAIL)  
 CAPACITY: 650 L (172 CIGS)

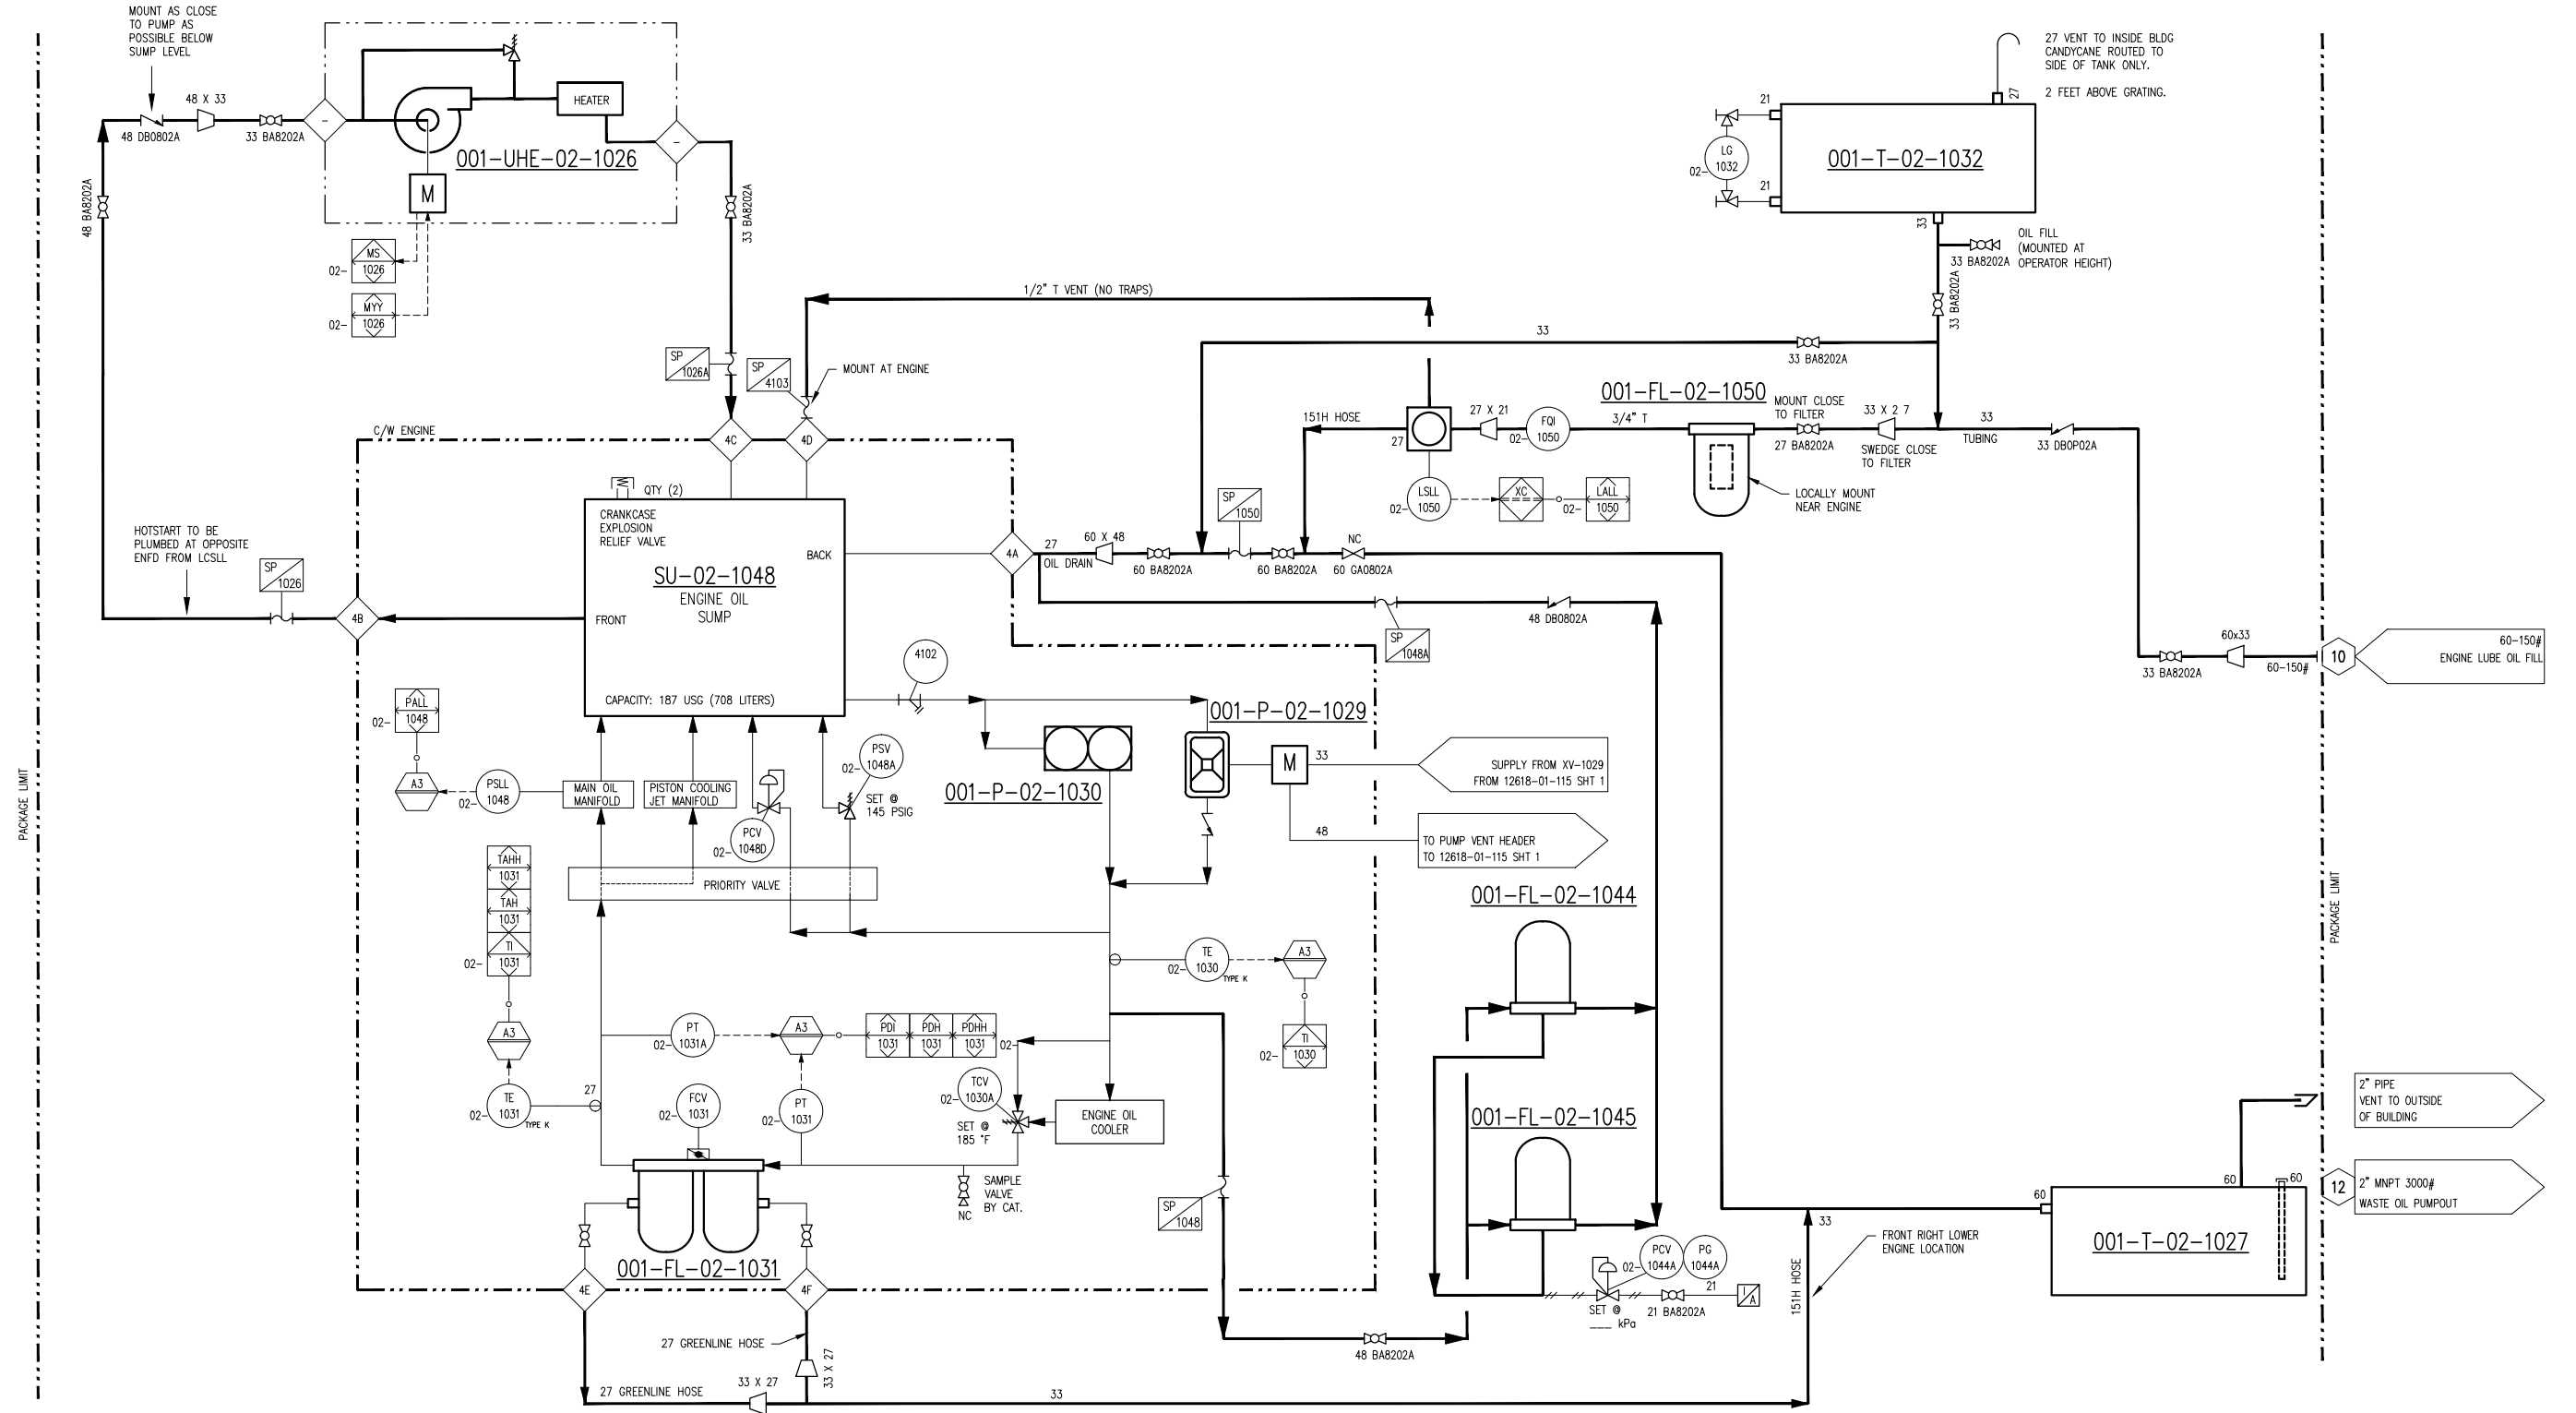

**FINAL AS BUILT**  
 NAME: C.SMITH DATE: JAN 02/14

REV	DESCRIPTION	DATE	BY	APR
3	FINAL AS BUILT	JAN 02/14	CS	SG
2	FINAL AS BUILT	NOV 21/13	AR	SG
1	ISSUED FOR CONSTRUCTION	JUN 21/13	CS	SG
0	ISSUED FOR CONSTRUCTION	APR 09/13	AT	SG
B	ISSUED FOR APPROVAL	FEB 08/13	AH	SG
A	ISSUED FOR APPROVAL	JAN 18/13	AH	SG


DATE	SCALE	NTS
DEC 10/12	SCALE	NTS
DRAWN BY: A.HAMMOND	CHECKED BY: S.GURI	APPROVED BY: B.MINSHULL
PROJECT MANAGER: B.MINSHULL	PROJECT ENGINEER: S.GURI	
CUST PO: 410000964		
APEGGA PERMIT No: P8651	OPER. CODE	WORK ORDER: 12618-01

DEVON CANADA FERRIER CPF  
 BATTERY SCREW  
 CATERPILLAR G3606LE  
 FRICK SCGB-3524

**ENERFLEX**  
 Calgary, Alberta,  
 Canada  
 DWG NO: 12618-01-114

P & I DIAGRAM  
 ENGINE LUBE  
 OIL SYSTEM  
 SHT: 1 REV: 3

001-FL-02-1033  
**FUEL GAS FILTER**  
 MFG: EFX FF-8-245-125-00  
 SIZE: 219mm (8.625") OD FILTER  
 MAWP: 1689 KPAG @ 121°C (245 PSIG @ 150°F)  
 FILTER MODEL: GCA3P30K03V  
 MFG: DANVIL  
 RISER MODEL: GA3630P222SS  
 S/N: 12618014240  
 CRN: V2458.213

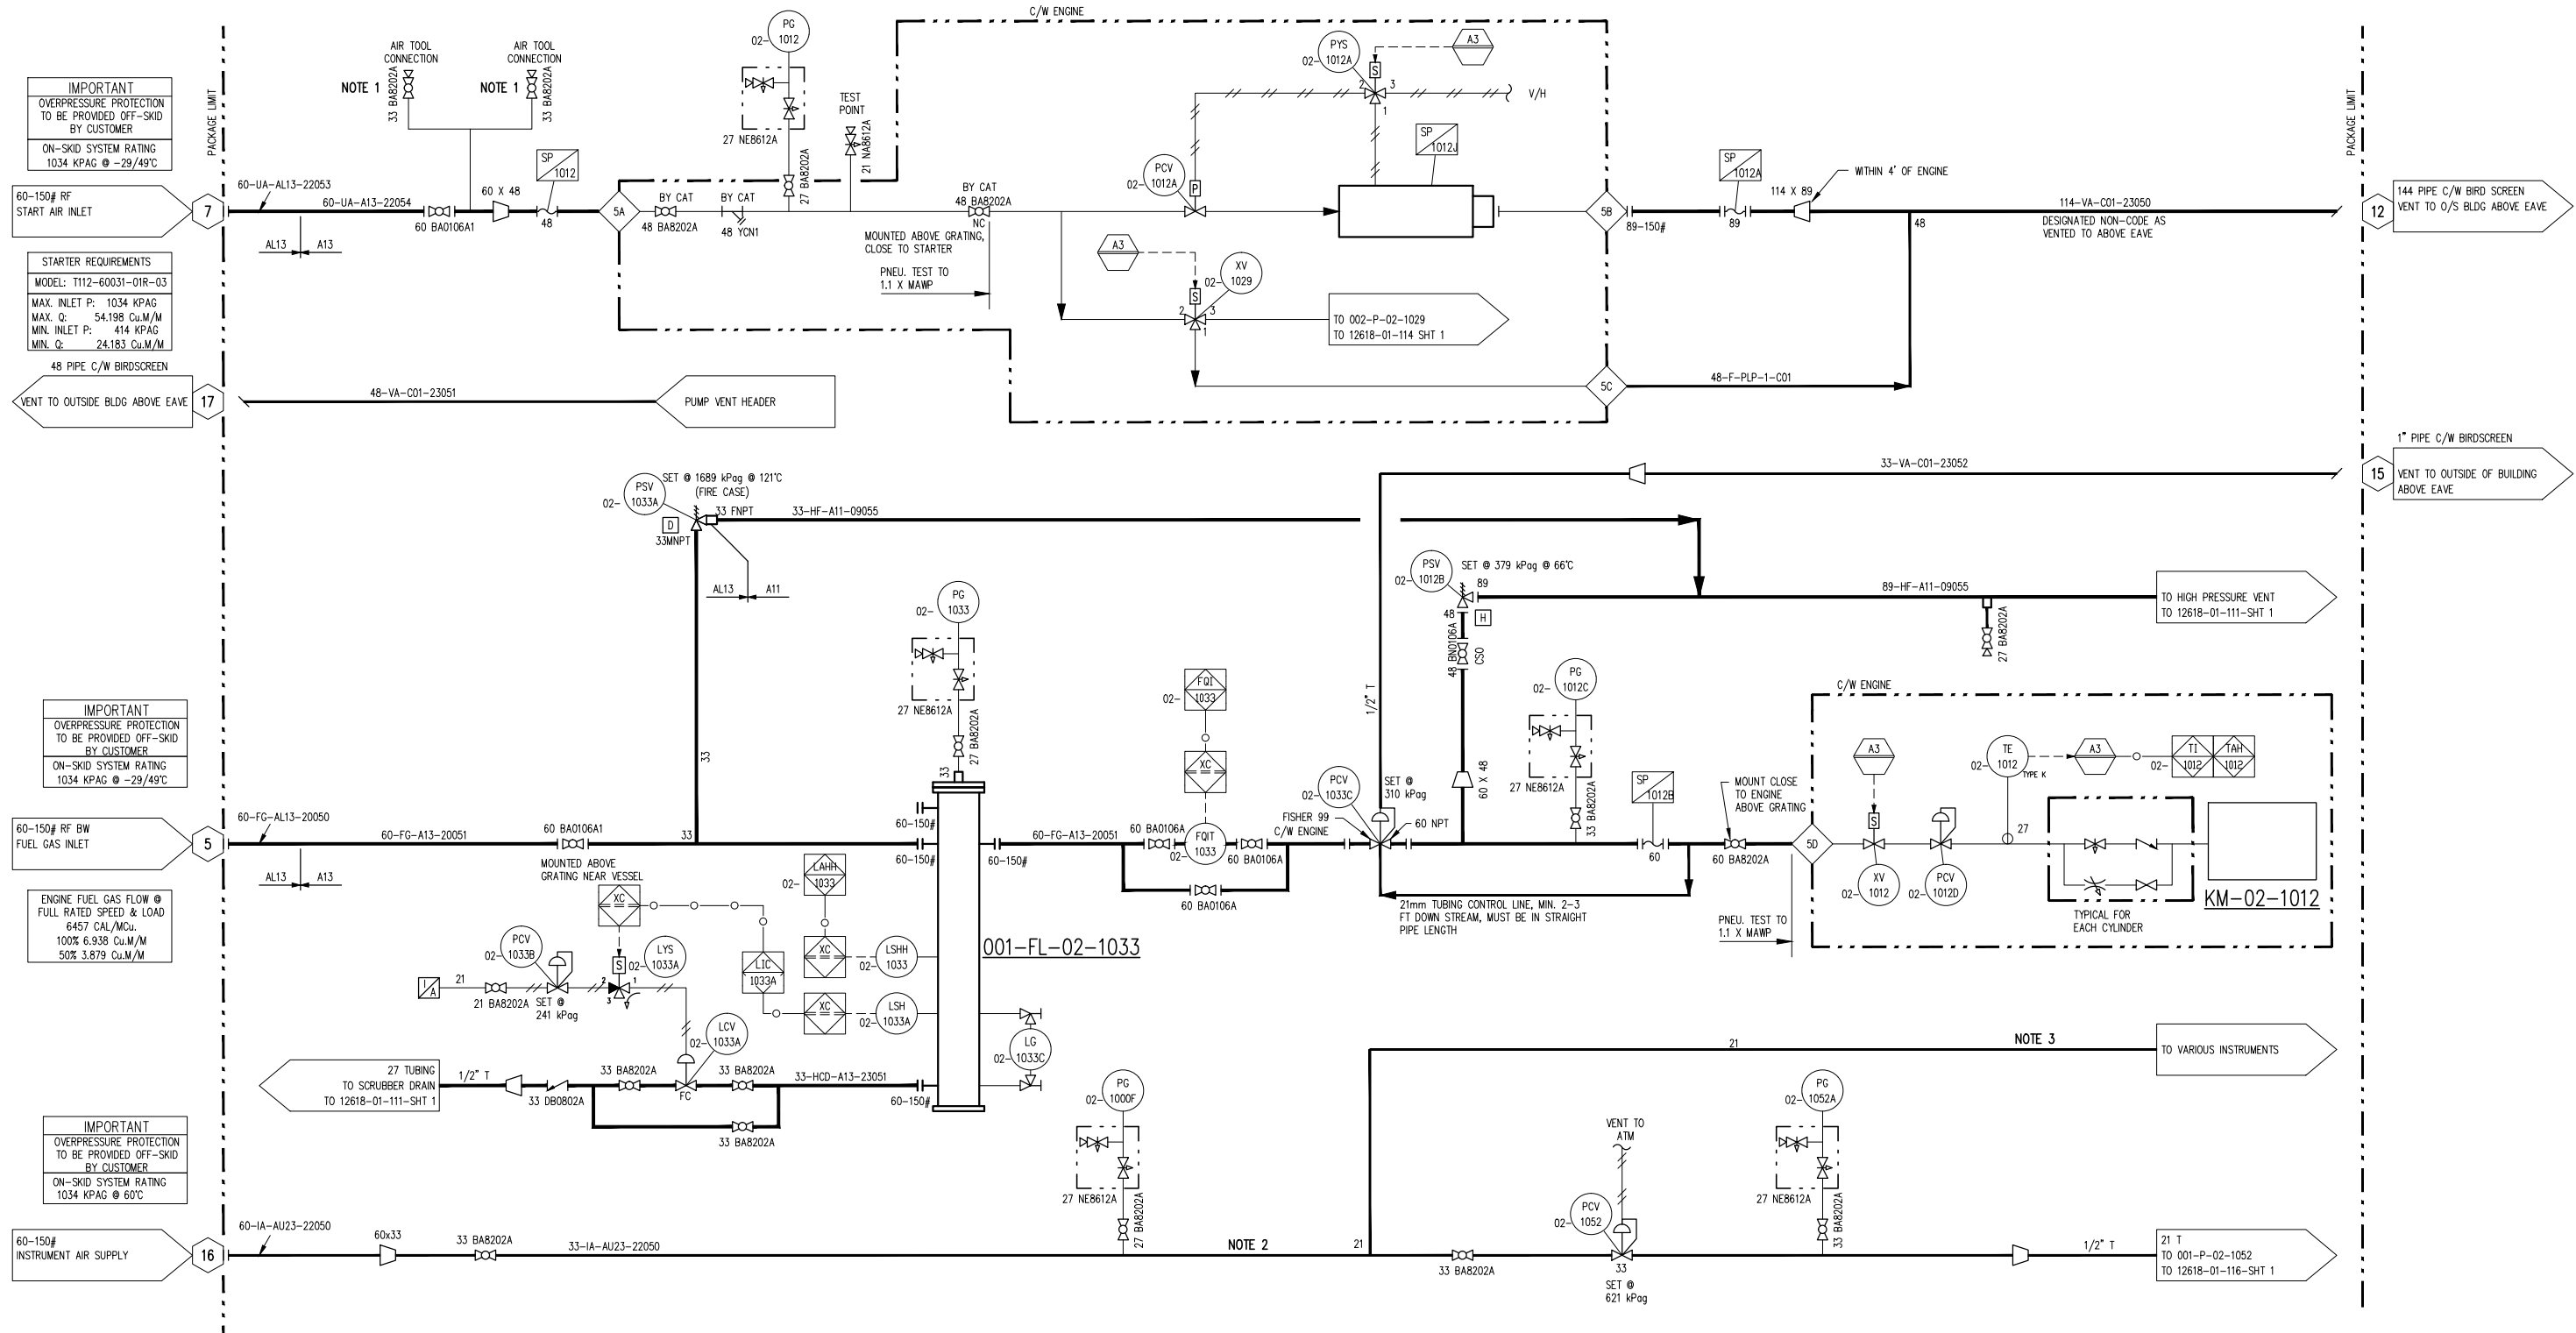

**IMPORTANT**  
 OVERPRESSURE PROTECTION TO BE PROVIDED OFF-SKID BY CUSTOMER  
 ON-SKID SYSTEM RATING 1034 KPAG @ -29/49°C

**STARTER REQUIREMENTS**  
 MODEL: T112-60031-01R-03  
 MAX. INLET P: 1034 KPAG  
 MAX. Q: 54.198 CuM/M  
 MIN. INLET P: 414 KPAG  
 MIN. Q: 24.183 CuM/M

**IMPORTANT**  
 OVERPRESSURE PROTECTION TO BE PROVIDED OFF-SKID BY CUSTOMER  
 ON-SKID SYSTEM RATING 1034 KPAG @ -29/49°C

**ENGINE FUEL GAS FLOW @ FULL RATED SPEED & LOAD**  
 6457 CAL/MCU  
 100% 6.938 CuM/M  
 50% 3.879 CuM/M

**IMPORTANT**  
 OVERPRESSURE PROTECTION TO BE PROVIDED OFF-SKID BY CUSTOMER  
 ON-SKID SYSTEM RATING 1034 KPAG @ 60°C

- NOTES:**
- AIR TOOL CONNECTION TO BE PROVIDED ON BOTH SIDES OF SKID.
  - GALVANIZED PIPE UP TO INSTRUMENT ISOLATION VALVE.
  - ISOLATION VALVE 21 BA8202A TO BE INSTALLED ON 21mm PIPE ABOVE GRATING.

**FINAL AS BUILT**  
 NAME: T.WELSH DATE: AUG 28/14

5	FINAL AS BUILT	AUG 28/14	TW	AA
4	FINAL AS BUILT	JAN 02/14	CS	SG
3	FINAL AS BUILT	NOV 21/13	AR	SG
2	ADDED DRAIN VALVE	OCT 09/13	GP	SG
1	ISSUED FOR CONSTRUCTION	JUN 21/13	CS	SG
0	ISSUED FOR CONSTRUCTION	APR 09/13	AT	SG
REV	DESCRIPTION	DATE	BY	APR

DATE	DEC 10/12	SCALE	NTS
DRAWN BY	A.HAMMOND	CHECKED BY	S.GURI
APPROVED BY	B.MINSHULL		
PROJECT MANAGER	B.MINSHULL	PROJECT ENGINEER	S.GURI
CUST PO	4100000964		
APECGA PERMIT No:	P8651	OPER. CODE	
WORK ORDER	12618-01		

DEVON CANADA FERRIER CPF  
 BATTERY SCREW  
 CATERPILLAR G3606LE  
 FRICK SGCB-3524

**ENERFLEX**  
 Calgary, Alberta, Canada

P & I DIAGRAM  
 START FUEL/ GAS SUPPLY

DWG NO	12618-01-115	SHT	1	REV	5
--------	--------------	-----	---	-----	---



**001-UHE-02-1034**  
**ENGINE GLYCOL HEATER**  
 MFG: KIM HOTSTART  
 HEATER: 18KW (24.1HP)  
 PUMP: 1HP (0.746KW)  
 40 GPM @ 3450 RPM  
 POWER: 575V/3PH/60HZ  
 WIRED BY OTHERS



**001-T-02-1035**  
**GLYCOL TANK**  
 MFG: EFX  
 CAPACITY: 2124L (561USG)

**001-P-02-1037**  
**ENGINE JACKET WATER PUMP**  
 MFG: CATERPILLAR  
 MAX. FLOW: 1596 LPM (422 GPM) @ 0.10m (33 FT) H<sub>2</sub>O  
 HEAD PRESS.

**001-P-02-1052**  
**GLYCOL TRANSFER PUMP**  
 MAKE: YAMADA  
 MODEL: NDP-25BAA  
 FLOW RATE: 46.2 GPM  
 IN/OUT CONNECTION: (1") 33mm NPT  
 AIR SUPPLY: 20-100 PSIG


**001-T-02-1036**  
**EJW SURGE TANK**  
 MFG: EFX  
 CAPACITY: 197 LITERS (52 GALLONS)  
 MAWP: 97 kPag

**001-E-02-1039**  
**ENGINE JACKET WATER COOLER SECTION**  
 MFG: AIR-X-LIMITED  
 MAWP: 97 kPag @ 149°C  
 MDMT: -29°C @ 97 kPag  
 CAPACITY: 247L (8.707 FT)<sup>3</sup>  
 HEAT DUTY: 1622175 BTU/HR

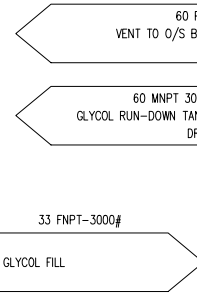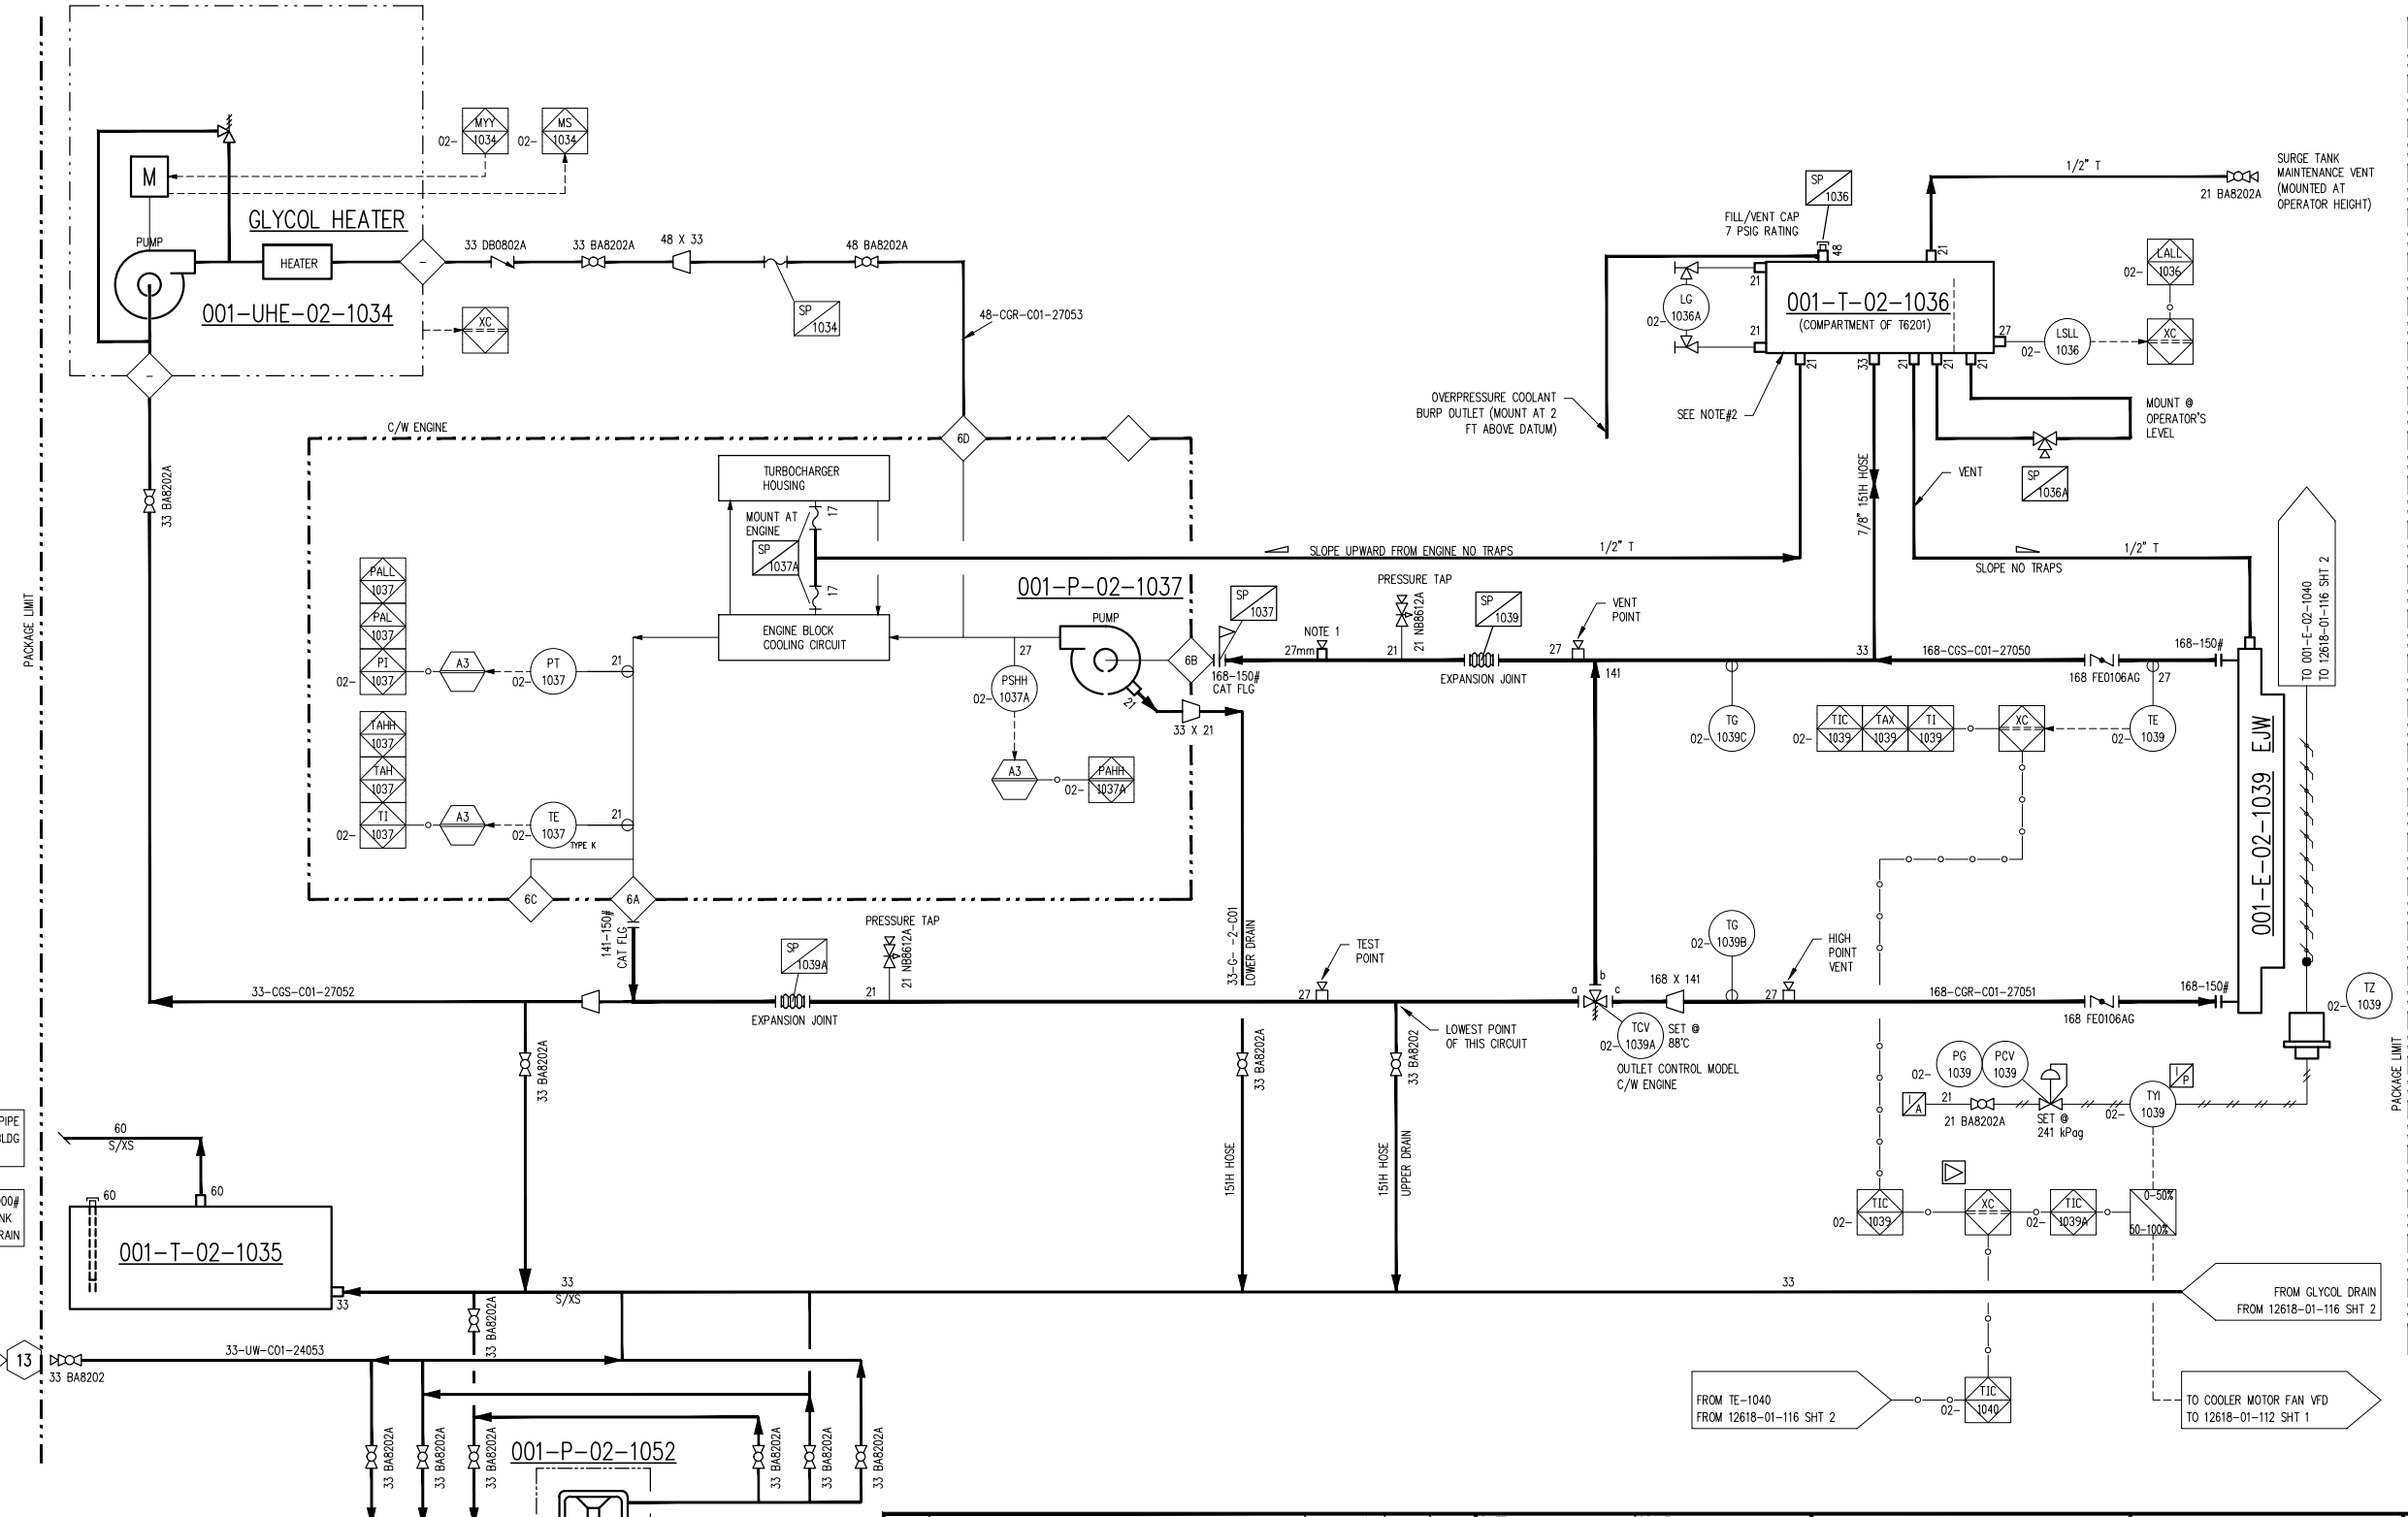

**FINAL AS BUILT**  
 NAME: C.SMITH DATE: JAN 02/14

**NOTE:**  
 1. VIEW POINT FOR BOROSCOPE

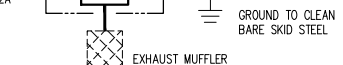

4	FINAL AS BUILT	JAN 02/14	CS	LD
3	FINAL AS BUILT	NOV 21/13	AR	LD
2	REVISED TAGGING	AUG 28/13	AT	LD
1	ISSUED FOR CONSTRUCTION	JUN 21/13	CS	SG
0	ISSUED FOR CONSTRUCTION	APR 09/13	AT	SG
B	ISSUED FOR APPROVAL	FEB 08/13	AH	SG
REV	DESCRIPTION	DATE	BY	APR

DATE	DEC 10/12	SCALE	NTS
DRAWN BY	A.HAMMOND	CHECKED BY	S.GURI
PROJECT MANAGER	B.MINSHULL	PROJECT ENGINEER	S.GURI
CUST PO	4100000964		
APECOGA PERMIT No:	P8651	OPER. CODE	

DEVON CANADA FERRIER CPF  
 BATTERY SCREW  
 CATERPILLAR G3606LE  
 FRICK SGCB-3524

**ENERFLEX**  
 Calgary, Alberta,  
 Canada

P & I DIAGRAM  
 COOLING SYSTEM  
 ENGINE JACKET WATER

DWG NO	12618-01-116	SHT	1	REV	4
--------	--------------	-----	---	-----	---


**001-P-02-1051**  
**COMP. OIL COOLANT PUMP**  
 MFG: VIKING  
 MODEL: CENTRIFUGA 2-3-54  
 CONNECTION IN/OUT: 89mm (3")-150  
 IMPALLER DIAMETER: (184mm) (7 1/4")  
 CAPACITY: 946 LPM (250 GPM) @ 11m (35 FT)  
 POWER: 3 HP

**001-PM-02-1051**  
**COMP. OIL COOLANT PUMP MOTOR**  
 MFG: WEG-NEMA PREMIUM  
 POWER: 3 HP @1800 RPM  
 FRAME: 1PLT  
 ELECTRICS: 575 VAC/3 PH/60 HZ  
 ENCLOSER: TEFC

**001-P-02-1038**  
**ENGINE AUXILIARY JACKET WATER PUMP**  
 MFG: CATERPILLAR  
 MAX. FLOW: 1495 LPM (395 GPM) @ 12m (40 FT) H2O HEAD PRESS

**001-T-02-1041**  
**GLYCOL (AJW) SURGE TANK**  
 MFG: EFX  
 CAPACITY: 151 LITERS (40 GALLONS)  
 MAWP: 97 KPAG

**001-E-02-1040**  
**ENGINE AUXILIARY WATER COOLER SECTION**  
 MFG: AIR-X-LIMITED  
 MAWP: 97 kPag @ 149°C  
 MDMT: -29°C @ 97 kPag  
 CAPACITY: 439 L (15.486 FT³)  
 DUTY: 3706340 BTU/HR

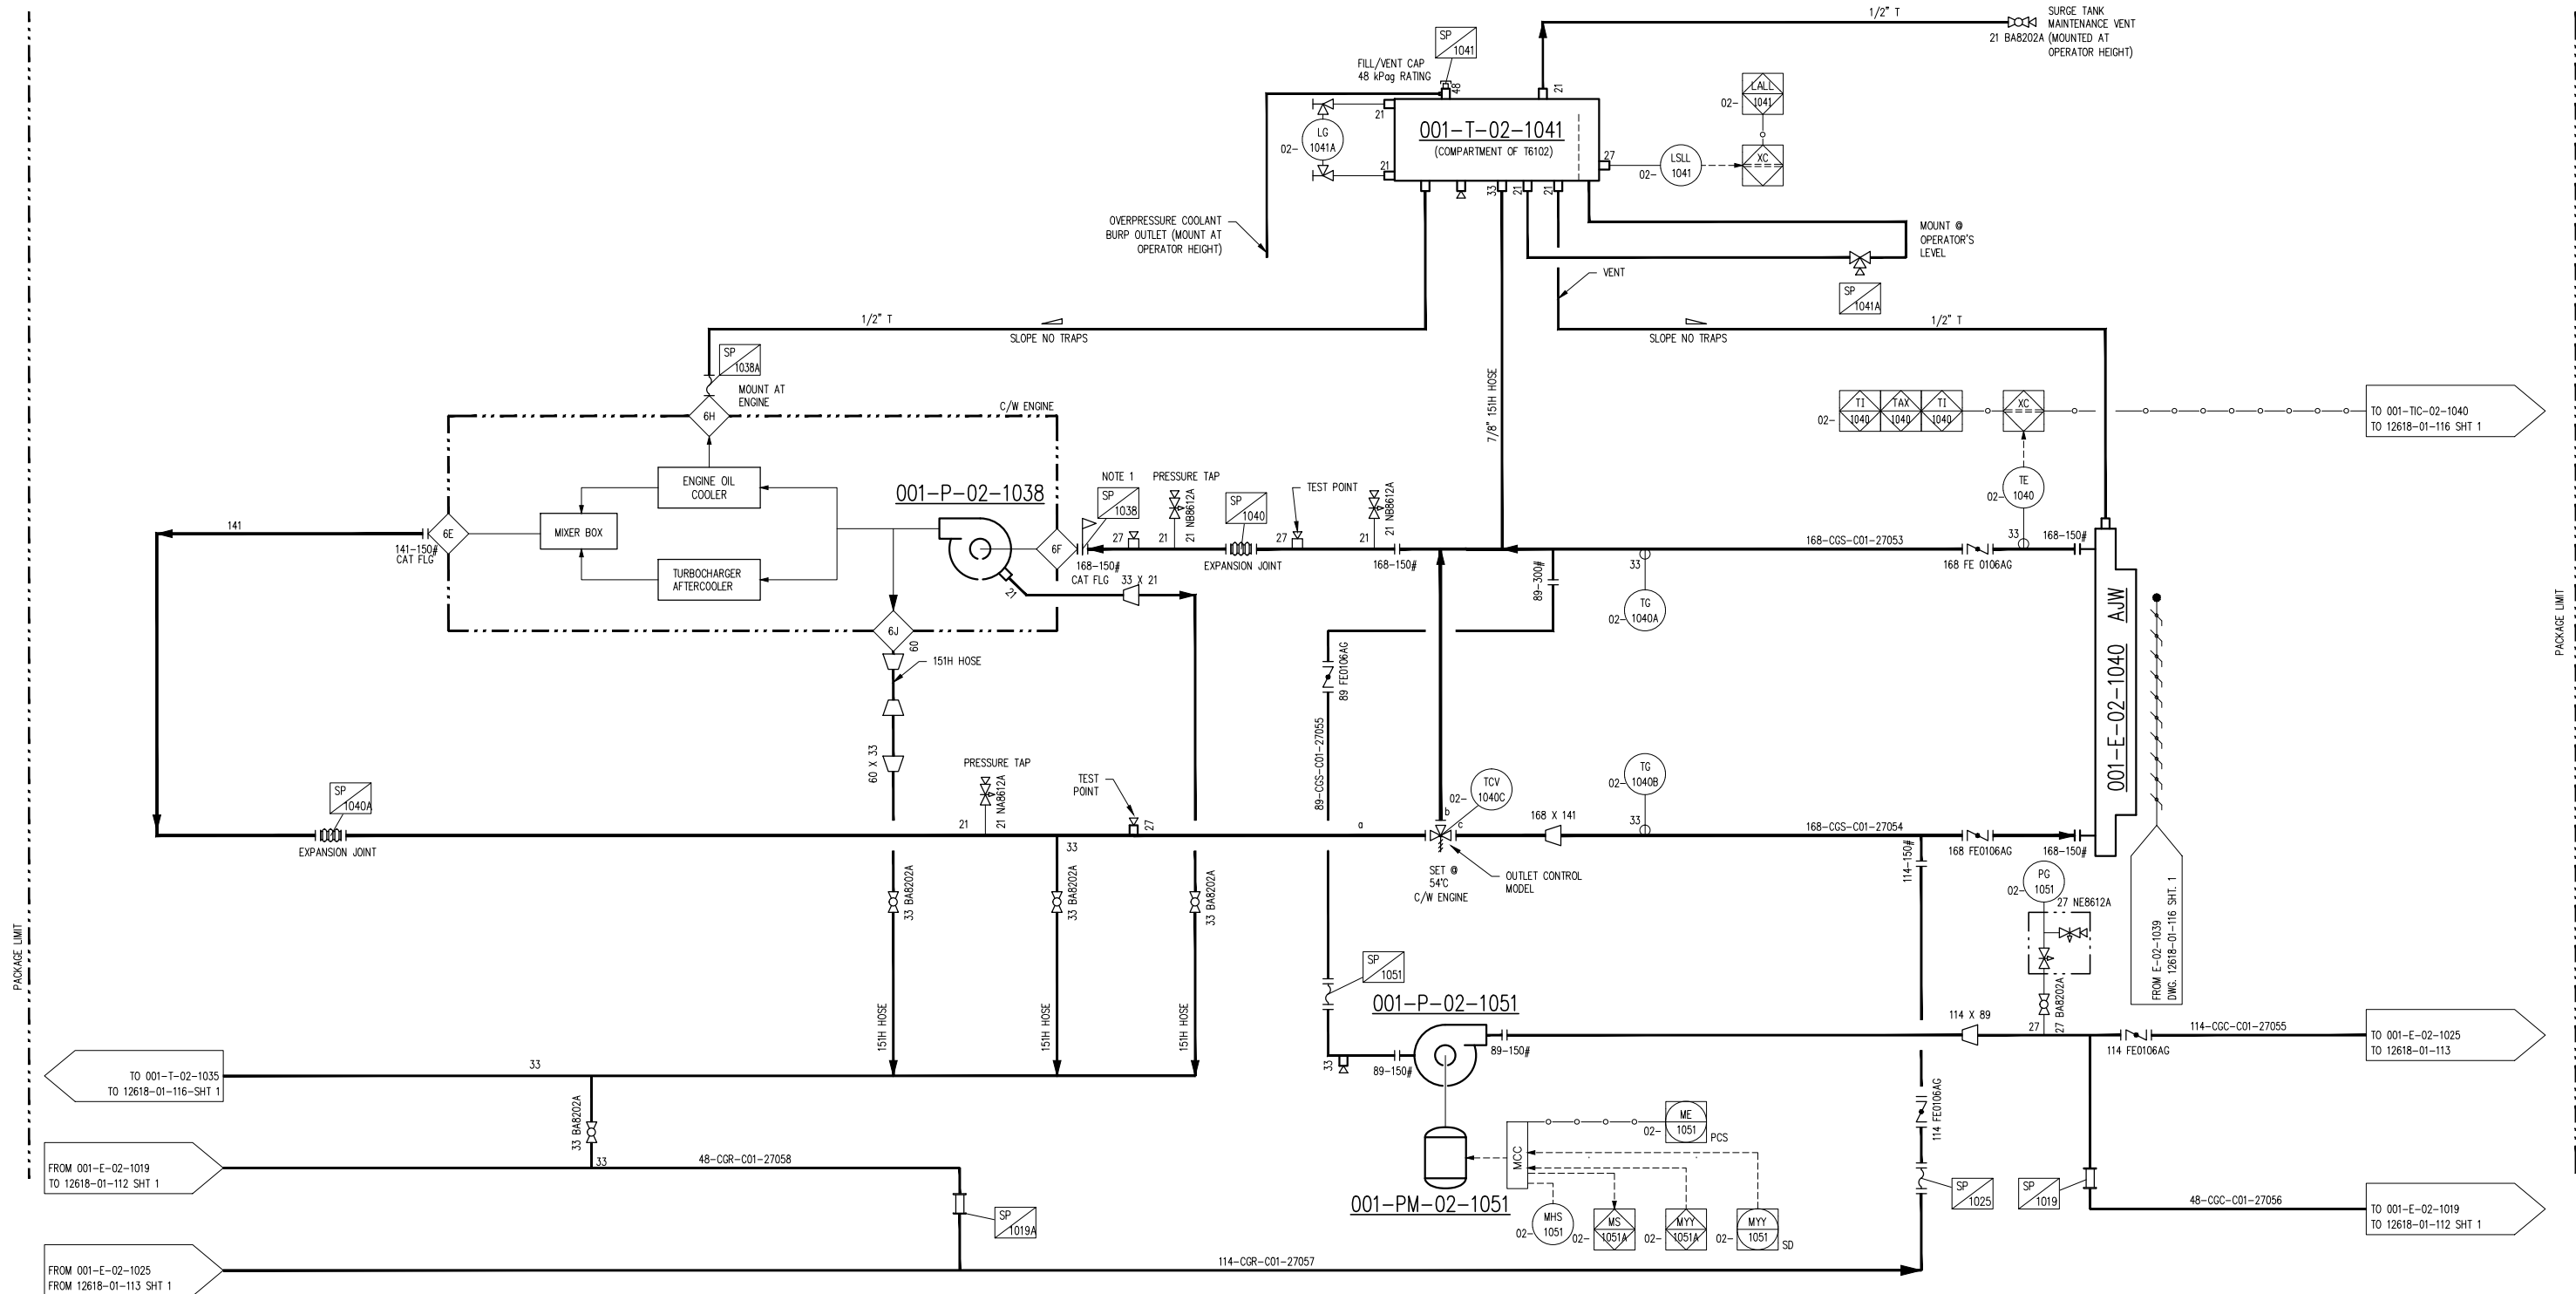

**NOTE:**  
 1. VIEW POINT FOR BOROSCOPE

**ISSUED FOR CONSTRUCTION**  
 NAME: C.SMITH DATE: JAN 02/14

3	FINAL AS BUILT	JAN 02/14	CS	SG	DATE	DEC 10/12	SCALE	NTS
2	FINAL AS BUILT	NOV 21/13	CS	SG	DRAWN BY	A.HAMMOND	CHECKED BY	S.GURI
1	ISSUED FOR CONSTRUCTION	JUN 21/13	CS	SG	APPROVED BY	B.MINSHULL	PROJECT MANAGER	B.MINSHULL
0	ISSUED FOR CONSTRUCTION	APR 09/13	AT	SG	PROJECT ENGINEER	S.GURI		
B	ISSUED FOR APPROVAL	FEB 08/13	AH	SG	CUST PO	4100000964		
A	ISSUED FOR APPROVAL	JAN 18/13	AH	SG				
REV	DESCRIPTION	DATE	BY	APR	APEGGA PERMIT No:	P8651	OPER. CODE	WORK ORDER

DEVON CANADA FERRIER CPF  
 BATTERY SCREW  
 CATERPILLAR G3606LE  
 FRICK SGCB-3524

**ENERFLEX**  
 Calgary, Alberta,  
 Canada


P & I DIAGRAM  
 COOLING SYSTEM  
 AUXILIARY JACKET WATER

DWG NO: 12618-01-116 SHT: 2 REV: 3

**001-SL-02-1020**  
**AIR INTAKE SILENCER**  
 MFG: NOISE SOLUTION INC  
 MODEL: CAEAVXX082078054  
 FLOW: 6000 SCFM  
 P. DROP: 1.2" H2O

**001-FL-02-1042**  
**AIR FILTER**  
 MFG: CATERPILLAR  
 STYLE: STANDARD DUTY, DOUBLE  
 ELEMENT HOUSING

**001-SL-02-1043**  
**EXHAUST SILENCER**  
 MFG: NOISE SOLUTION INC  
 MODEL: 2ERON 20,000 PLUS EESW2XP200018XXX  
 ORIENTATION: VERTICAL  
 DIMENSIONS: 1829mm (72") OD X 6096mm (240") LENGTH  
 CONNECTION: 457mm (18")/457mm (18") IN/OUT  
 WEIGHT: 6123 KG (13,500 LBS)  
 BACK PRESSURE: 1.98 INCHES H<sub>2</sub>O

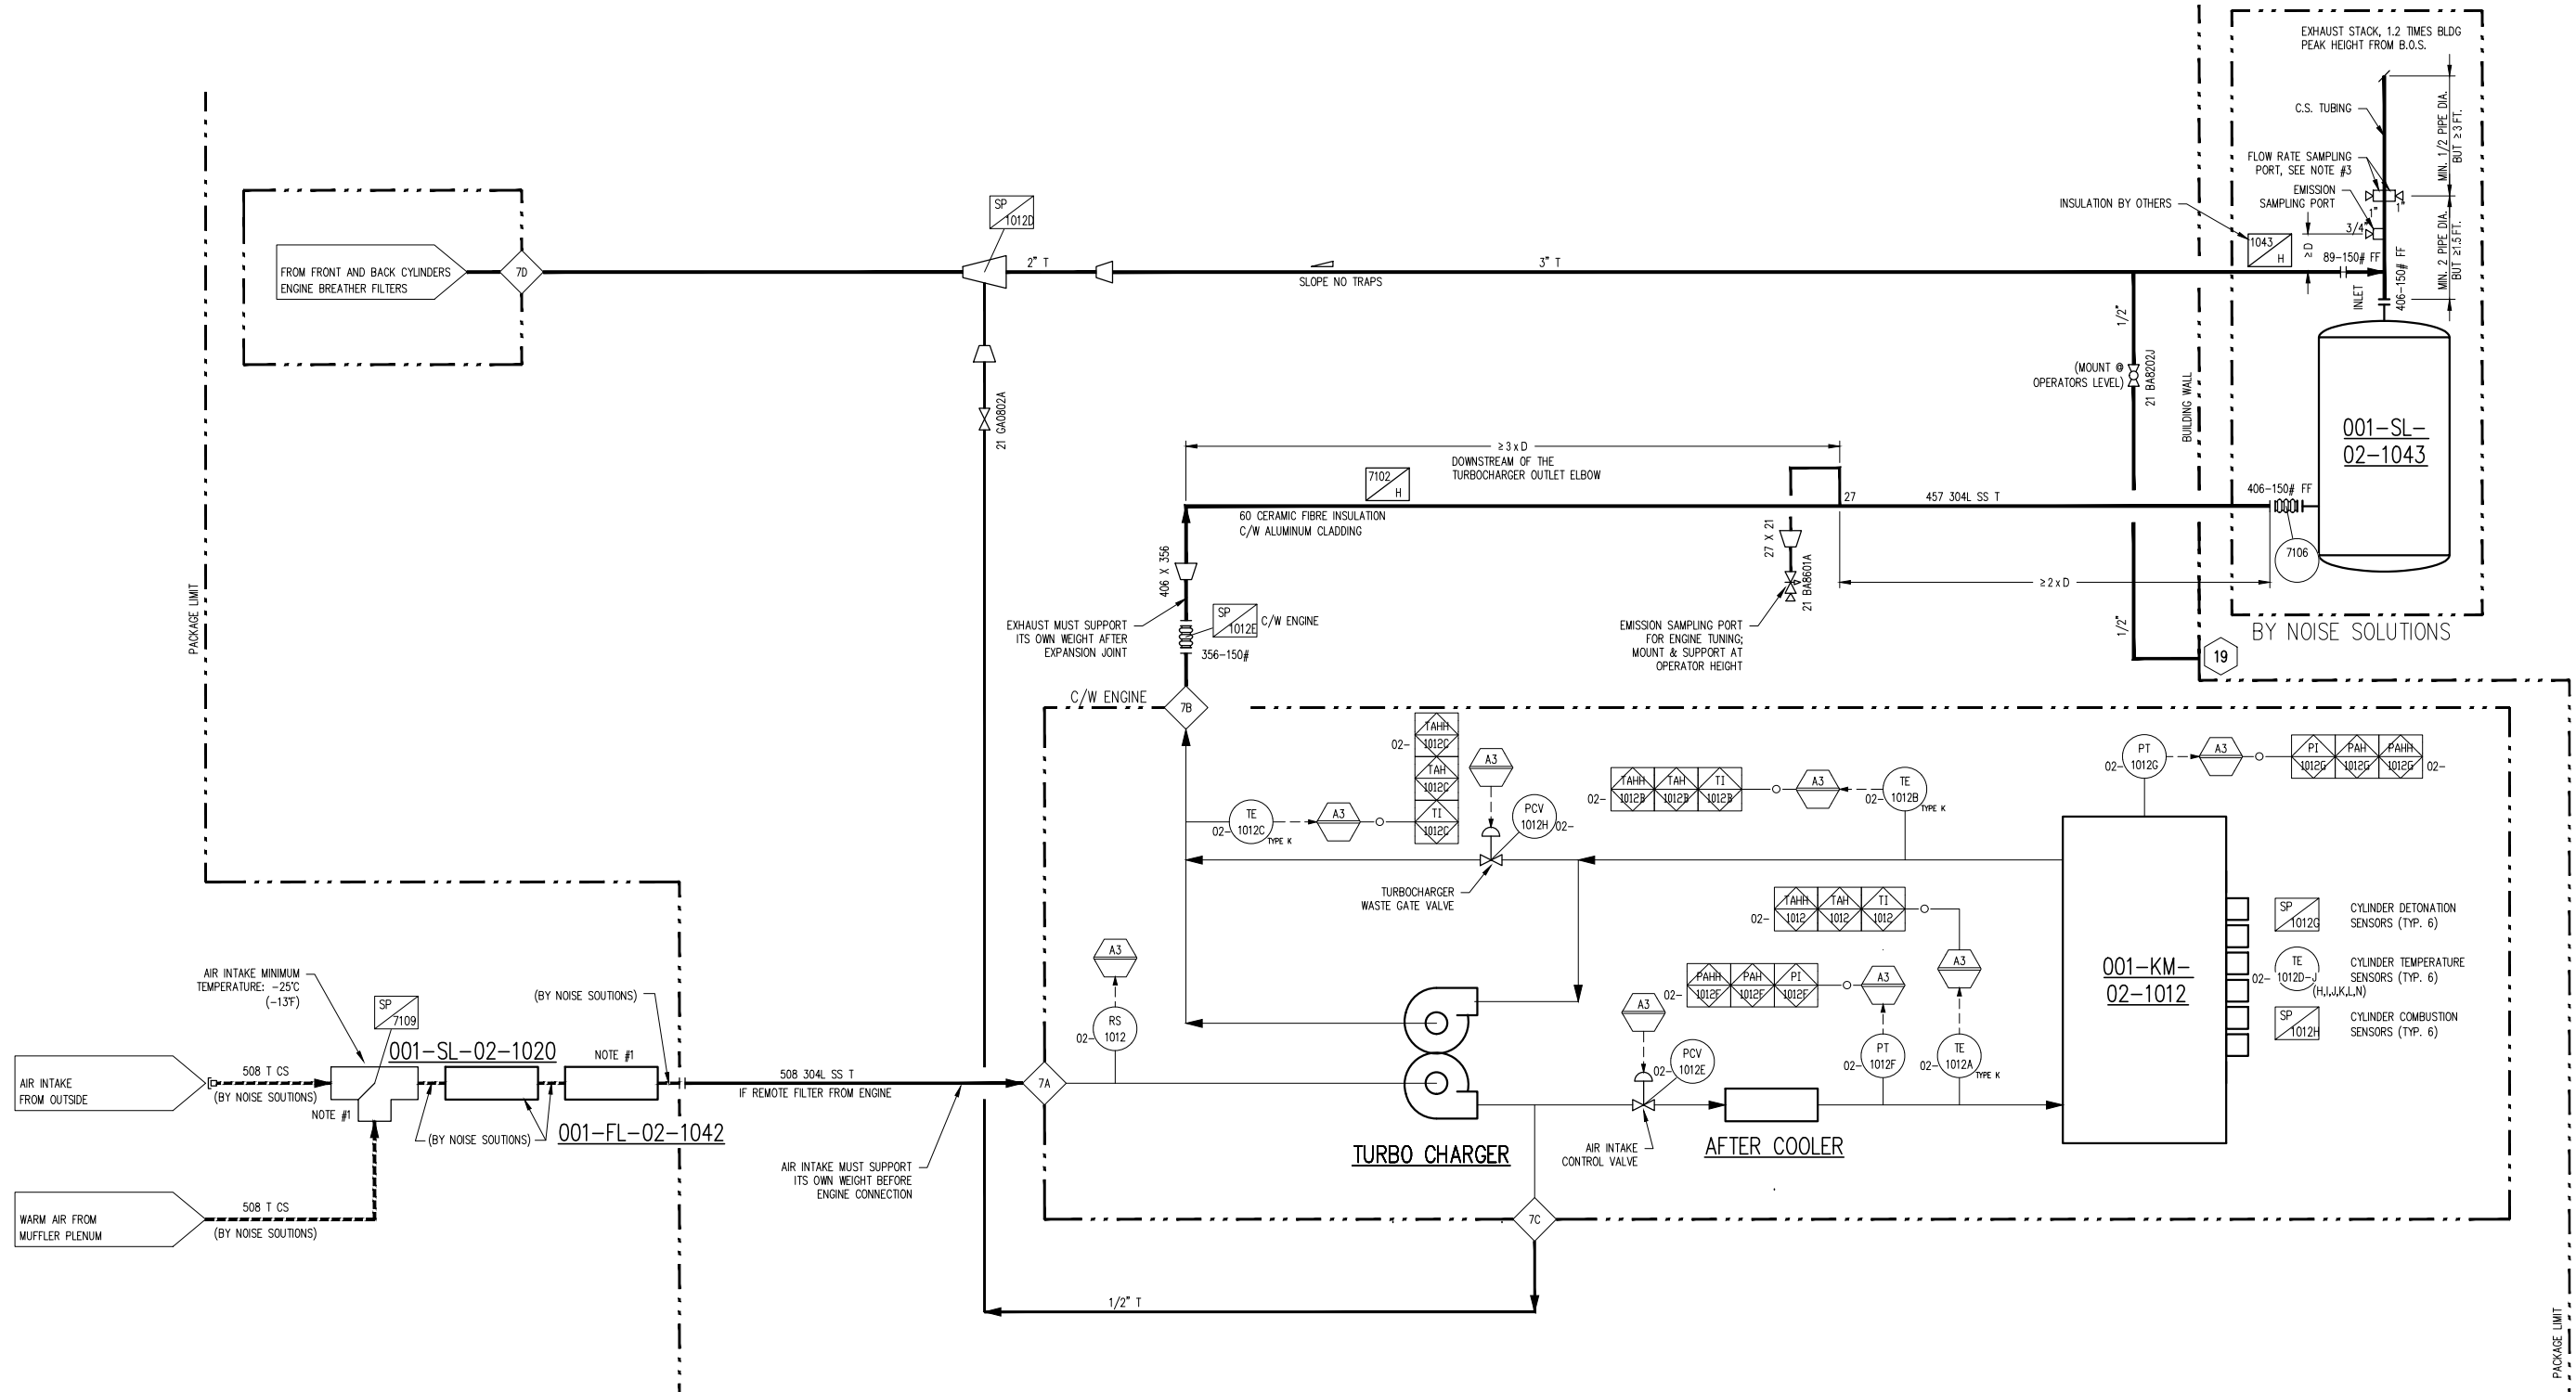

- NOTE:**
1. WARM AIR MIXING BOX AND FILTER BOX PROVIDED BY EFX. INTERCONNECT PIPING BY NOISE SOLUTIONS.
  2. SAMPLING POINT TUBING AND VALVE SHALL BE POST MOUNTED.
  3. TWO FLOW RATE SAMPLING PORTS SHALL BE PERPENDICULAR.

4	FINAL AS BUILT	AUG 28/14	TW	AA	DATE	DEC 10/12	SCALE	NTS
3	FINAL AS BUILT	JAN 02/14	CS	SG	DRAWN BY	A.HAMMOND	CHECKED BY	S.GURI
2	FINAL AS BUILT	NOV 21/13	AR	SG	APPROVED BY	B.MINSHULL	PROJECT MANAGER	B.MINSHULL
1	ISSUED FOR CONSTRUCTION	JUN 21/13	CS	SG	PROJECT ENGINEER	S.GURI	CUST PO	4100000964
0	ISSUED FOR CONSTRUCTION	APR 09/13	AT	SG				
B	ISSUED FOR APPROVAL	FEB 08/13	AH	SG				
REV	DESCRIPTION	DATE	BY	APR	APEGGA PERMIT No:	P8651	OPER. CODE	WORK ORDER

DEVON CANADA FERRIER CPF  
 BATTERY SCREW  
 CATERPILLAR G3606LE  
 FRICK SGCB-3524

**ENERFLEX**  
 Calgary, Alberta,  
 Canada

P & I DIAGRAM  
 AIR/EXHAUST SYSTEM

**FINAL AS BUILT**  
 NAME T.WELSH DATE AUG 28/14

DWG NO 12618-01-117 SHT 1 REV 4

PLOT DATE Oct 21, 2014, 09:01 AM THE INFORMATION CONTAINED HEREIN IS THE CONFIDENTIAL PROPERTY OF ENERFLEX, LTD. AND IS NOT FOR PUBLICATION, AND NO PART THEREOF SHALL BE COPIED OR COMMUNICATED TO A THIRD PARTY WITHOUT AUTHORIZATION FROM ENERFLEX, LTD.

**LINE IDENTIFICATION**  
A-B-CD-EF-GHIJ-KL,M-N

**A :** NOMINAL LINE SIZE IN INCHES  
**B :** FLUID / SERVICE  
 A AMMONIA IG INSTRUMENT GAS  
 AM AMINE L LUBE OIL  
 C CARBON DIOXIDE N NITROGEN  
 CO CARBON MONOXIDE NG NATURAL GAS  
 CW COOLING WATER O OXYGEN  
 F FREON P PROPANE  
 FG FUEL GAS PG PURGE GAS  
 G GLYCOL R REFRIGERANT  
 H HYDROGEN S STEAM  
 HE HELIUM SG SYNGAS  
 HG HYDROCARBON GAS V PRODUCED WATER  
 HL HYDROCARBON LIQUID W WATER  
 IA INSTRUMENT AIR

**C :** EQUIPMENT TYPE / MODIFIER (IF REQUIRED)  
 B BLOWER OR FAN H HEATER  
 C COMPRESSOR JB JUNCTION BOX  
 CPL CONTROL PANEL P PUMP  
 D DRIVER (MOTOR/ENGINE) T TOWER OR TANK  
 E EXCHANGER UH UNIT HEATER  
 F FILTER V PRESSURE VESSEL  
 FS FLARE STACK

**D :** EQUIPMENT NUMBER:  
 101 TO 999 SEQUENTIAL NUMBERS

**CD :** LINES TO/FROM SKID CALLED UP AS  
 INLET, OUTLET, HEADER, DRAIN, SUPPLY, ETC.

**EF :** LINE NUMBER:  
 E : 1 TO 9 SEQUENTIAL NUMBERS FROM EQUIPMENT  
 1.1 FOR 1ST BRANCH CONNECTION FROM 1ST LINE  
 1.2 FOR 2ND BRANCH CONNECTION FROM 1ST LINE  
 F : SKID/AREA REFERENCE LETTER (A, B, C,...)  
 ('X' SIGNIFIES OFF SKID/INTERCONNECTING PIPE)

**GHIJ :** PIPING SPECIFICATION  
**G :** MATERIAL GROUP  
 C CARBON STEEL  
 L LOW TEMPERATURE CARBON STEEL  
 S STAINLESS STEEL  
**H :** ANSI 16.5 FLANGE CLASS  
 0 NON CODE  
 1 150# 6 600# 15 1500#  
 3 300# 9 900# 25 2500#  
**I :** LINE MATERIAL SPECIFICATION REFERENCE:  
 PIPING SPECIFICATION NUMBER  
**J :** R RECIPROCATING PACKAGE SPECIFICATION  
 BLANK FOR PROCESS PACKAGE SPECIFICATION

**KL,M :** INSULATION (IF REQUIRED)  
**K :** INSULATION TYPE  
 C COLD HT HEAT TRACING  
 H HOT PP PERSONAL PROTECTION  
 HC HOT/COLD  
**L :** INSULATION THICKNESS IN MILLIMETERS OR INCHES (")  
**M :** TRACING (IF REQUIRED)  
 ET ELECTRICAL TRACING  
 GT GLYCOL TRACING  
 ST STEAM TRACING

**N :** PED PIPE IDENTIFICATION SUFFIX (IF REQUIRED)  
 SEP SOUND ENGINEERING PRACTICE LINE  
 CATI CATEGORY I LINE  
 CATII CATEGORY II LINE  
 CATIII CATEGORY III LINE

**EXAMPLE:** 3"-HG-V101-1A-C61R-HTXX,ET-CATII  
 3" - NOMINAL LINE SIZE  
 HG - HYDROCARBON GAS  
 V101 - PRESSURE VESSEL TAG NUMBER  
 1A - 1 FIRST LINE FROM VESSEL  
 A LOCATED ON SKID/AREA 'A'  
 C61R - C CARBON STEEL LINE  
 6 600# ANSI FLANGE RATING  
 1 LINE MATERIAL SPECIFICATION REFERENCE  
 R RECIPROCATING PACKAGE PIPE SPEC.  
 HT - HEAT TRACING INSULATION  
 XX - THICKNESS IN MILLIMETERS OR INCHES (")  
 ET - ELECTRIC TRACING  
 CATII - PED CATEGORY II LINE

**VALVE IDENTIFICATION**  
A"BCDE,F

**A :** NOMINAL VALVE SIZE IN INCHES  
**B :** TYPE  
 A ANGLE GLOBE N NEEDLE  
 B BALL P PLUG  
 C CHECK S START-UP STRAINER  
 G GATE T TEE STRAINER  
 L GLOBE U BUTTERFLY  
 M MANIFOLD Y Y PATTERN STRAINER

**C :** BODY MATERIAL  
 B BRONZE L LOW TEMP. CARBON STEEL  
 C CARBON STEEL S STAINLESS STEEL  
 I CAST IRON

**D :** END CONNECTIONS  
 1 FLANGED 150# B BUTT WELD  
 3 FLANGED 300# C SW BY NPT  
 6 FLANGED 600# F NPT BY FLANGE (MANIFOLD)  
 9 FLANGED 900# M NPT MALE BY NPT FEMALE  
 15 FLANGED 1500# N NPT (THREADED)  
 25 FLANGED 2500# S SW (SOCKETWELD)  
 T TUBE (IE: SWAGelok)

**E :** UNIQUE DESCRIPTION  
 REFER TO VALVE DATA SHEETS

**F :** MODIFIER  
 C CHAIN OPERATOR O OXYGEN SERVICE/CLEANING  
 E EXTENDED BONNET P FULL PORT DESIGN  
 G GEAR OPERATOR R RTJ FLANGED  
 L LOCKING DEVICE S SPRING HANDLE (CLOSE)  
 N NACE TRIM X SPECIAL SPECIFICATIONS

**EXAMPLE:** 6"GC11,C  
 6" VALVE SIZE 1 150#  
 G GATE 1 API-600  
 C CARBON STEEL C CHAIN OPERATOR

**LINE CODE**

———— PRIMARY PROCESS LINE  
 ——— SECONDARY PROCESS LINE  
 ——— MINOR PROCESS LINE  
 ——— AUXILIARY PROCESS LINE  
 ——— INSTRUMENT/IMPULSE LINE  
 - - - - - ELECTRIC SIGNAL  
 x x x x x x x x FILLED CAPILLARY TUBE  
 // // // // // PNEUMATIC LINE  
 ● ● ● ● ● MECHANICAL LINK  
 ○ ○ ○ ○ ○ INSTRUMENT DATA LINK  
 - - - - - INTERCONNECTING PIPING  
 - - - - - SKID LIMIT  
 - - - - - FUTURE  
 ~ ~ ~ ~ ~ SONIC OR ELECTRO-MAGNETIC SIGNAL (GUIDED)  
 · · · · · SONIC OR ELECTRO-MAGNETIC SIGNAL (UN-GUIDED)

**VALVE CONNECTIONS**  
(COMBINATIONS MAY BE USED)

———— THREADED  
 ——— SOCKET WELDED  
 ——— BUTT WELDED  
 ——— FLANGED

**VALVE TYPES**

ANGLE GLOBE VALVE GATE VALVE PLUG VALVE  
 BALL VALVE GAUGE VALVE PINCH VALVE  
 BUTTERFLY VALVE GLOBE VALVE QUICK ACTING VALVE  
 CHECK VALVE NEEDLE VALVE VALVE W/PLUG  
 DIAPHRAGM VALVE NEEDLE VALVE W/BLEED 3-WAY VALVE  
 DUMP VALVE MANIFOLD VALVE 4-WAY VALVE

**CONTROL VALVES**

DIAPHRAGM CONTROL VALVE OUTLET PRESSURE REGULATOR 3-WAY SOLENOID VALVE  
 DIAPHRAGM CONTROL VALVE W/ POSITIONER HYDRAULIC / PNEUMATIC PISTON OPERATED OR SPRING RETURN THERMOSTATIC CONTROL VALVE  
 INLET PRESSURE REGULATOR SELF-CONTAINED PNEUMATIC RELAY VALVE PRESSURE SAFETY RELIEF VALVE  
 OUTLET PRESSURE REGULATOR SELF-CONTAINED 2-WAY SOLENOID VALVE DESIGNATES API ORIFICE SIZE  
 DIFFERENTIAL PRESSURE REGULATOR SELF-CONTAINED MOTOR ACTUATED PRESSURE SAFETY RELIEF VALVE PILOT OPERATED  
 INLET PRESSURE REGULATOR ROTARY MOTOR ACTUATED DESIGNATES API ORIFICE SIZE

**INSTRUMENT IDENTIFICATION GENERAL REFERENCE (ISA - S5.1)**

FIRST LETTER	SUCCEEDING LETTERS	PRIMARY ELEMENT	INDICATOR	RECORDER	CONTROLLER			TRANS-MITTER	CONTROL		CONTROL VALVE OR REGULATOR	SELF-ACTIVATED VALVE	RELAY OR CONVERTOR
					BLIND	INDICATING	RECORDING		SWITCH	ALARM			
A	ANALYSIS		AI	AR	AC	AIC	ARC	AT	AS( )	AA( )	AV		AY
B	BURNER FLAME												
C	CONDUCTIVITY	CONTROL OR CLOSE	CI	CR	CC	CIC	CRC	CT	CS( )	CA( )	CV		CY
D	DENSITY OR MASS (DIFFERENTIAL)	DIFFERENTIAL	DI	DR	DC	DIC	DRC	DT	DS( )	DA( )	DV		DY
E	VOLTAGE	PRIMARY ELEMENT	EI	ER	EC	EIC	ERC	ET	ES( )	EA( )	EV		EY
F	FLOW (RATIO OR FRACTION)	SHUTDOWN FIRST OUT	FI	FR	FC	FIC	FRC	FT	FS( )	FA( )	FV	FCV	FY
G	GAUGING	GLASS	GI	GR	GC	GIC	GRC	GT	GS( )	GA( )	GV		
H	HAND	HIGH			HC	HIC	HRC	HT	HS( )		HV	HCV	HY
I	CURRENT	INDICATE	II	IR	IC	IIC	IRC	IT	IS( )	IA( )			IY
J	POWER (SCAN)		JI	JR	JC	JIC	JRC	JT	JS( )	JA( )			JY
K	TIME	CONTROL STATION	KI	KR	KC	KIC	KRC	KT	KS( )	KA( )	KV		KY
L	LEVEL	LOW OR LIGHT	LI	LR	LC	LIC	LRC	LT	LS( )	LA( )	LV	LCV	LY
M	MOISTURE, HUMIDITY	MIDDLE OR INTERMEDIATE	MI	MR	MC	MIC	MRC	MT	MS( )	MA( )	MV		MY
N	USER'S CHOICE												
O	USER'S CHOICE	ORIFICE OR OPEN											
P	PRESSURE OR VACUUM	POINT	PI	PR	PC	PIC	PRC	PT	PS( )	PA( )	PV	PCV	PY
Q	QUANTITY OR EVENT (INTEGRATE/TOTALIZE)		QI	QR	QC	QIC	QRC	QT	QS( )	QA( )	QV		QY
R	RELIEF OR RESTRICTION OR RADIOACTIVITY	RECORD OR PRINT	RI	RR	RC	RIC	RRC	RT	RS( )	RA( )			RY
S	SPEED OR FREQUENCY	SWITCH OR SAFETY	SI	SR	SC	SIC	SRC	ST	SS( )	SA( )			SY
T	TEMPERATURE	TRANSMIT	TI	TR	TC	TIC	TRC	TT	TS( )	TA( )	TV	TCV	TY
U	MULTI-VARIABLE	MULTIFUNCTION	UI	UR	UC	UIC	URC				UV		
V	VIBRATION OR VISCOSITY	VALVE OR DAMPER	VI	VR	VC	VIC	VRC	VT	VS( )	VA( )	VV		VY
W	WEIGHT OR FORCE	WELL	WI	WR	WC	WIC	WRC	WT	WS( )	WA( )	WV		WY
X	LIGHT	UNCLASSIFIED (DIAGNOSTIC)	XI	XR	XC	XIC	XRC	XT	XS( )	XA( )	XV		XY
Y	USER'S CHOICE	RELAY OR COMPUTE											YY
Z	POSITION	DRIVE OR ACTUATE	ZI	ZR	ZC	ZIC	ZRC	ZT	ZS( )	ZA( )			ZY

**MISCELLANEOUS**

PIPE SLOPE DIRECTION  
 VORTEX BREAKER  
 DIAPHRAGM SEAL  
 RUPTURE DISC FOR PRESSURE RELIEF  
 RUPTURE DISC FOR VACUUM RELIEF  
 EYE WASH  
 SAFETY SHOWER  
 SKID TIE-POINTS  
 INSTRUMENT AIR  
 INSTRUMENT GAS  
 CURRENT/PRESSURE  
 SPRAY NOZZLE  
 VENT CAP  
 BEVELED PIPE END  
 END CAP  
 PLUG  
 LINE BREAK

THICKNESS MM OR (")  
 INSULATION TYPE  
 INSULATION BLOCK W/ ELECTRIC HEAT TRACE  
 INSULATION BLOCK W/ GLYCOL OR STEAM HEAT TRACE  
 SPECIALTY ITEM

SIZE -RATING / TYPE PROCESS DESCRIPTION TO/FROM DRAWING/SHEET  
 CONTINUATION ARROW  
 CONTINUATION ARROW DUAL DIRECTION

(C) -CLOSE (O) -OPEN (XX) -DIAGNOSTIC SHUTDOWN (USED TO INDICATE THE DIAGNOSTIC CHECK REQ'D ON THE ANALOG INPUT)  
 (H) -HIGH ALARM (L) -LOW ALARM  
 (HH) -HIGH SHUTDOWN (LL) -LOW SHUTDOWN

**INSTRUMENTS**

LOCAL MOUNTED  
 LOCAL PANEL MOUNTED  
 LOCAL PANEL MOUNTED BEHIND OR INSIDE  
 MAIN PANEL MOUNTED  
 MAIN PANEL MOUNTED BEHIND OR INSIDE  
 BY OTHERS  
 HUMAN MACHINE INTERFACE HMI (DCS)  
 HUMAN MACHINE INTERFACE HMI (PLC)  
 ENGINE CONTROL  
 PROGRAMMABLE LOGIC CONTROLLER (PLC)  
 XC REPRESENTS GENERAL LOGIC  
 ALARM/SHUTDOWN

INTERLOCK  
 ELECTRICAL INTERLOCK (HARDWIRED)  
 THERMOWELL (THREADED)  
 THERMOWELL (SOCKET WELDED)  
 THERMOWELL (FLANGED)  
 PILOT LIGHT  
 \* COLOUR  
 (A) AMBER (B) BLUE  
 (G) GREEN (O) ORANGE  
 (R) RED (W) WHITE

**FOR REFERENCE ONLY**  
 NAME: A.HAMMOND DATE: JAN 18/13

DATE	DEC 10/12	SCALE	NTS
DRAWN BY	G.PAHL	CHECKED BY	S.GURI
PROJECT MANAGER	B.MINSHULL	APPROVED BY	B.MINSHULL
CUST PO		PROJECT ENGINEER	S.GURI
ISSUED FOR REFERENCE	JAN 18/13	AH	SG
REV	DESCRIPTION	DATE	BY

DEVON CANADA FERRIER CPF  
 BATTERY SCREW  
 CATERPILLAR G3606LE  
 FRICK SGCB-3524

**ENERFLEX**  
 Calgary, Alberta,  
 Canada






P & I DIAGRAM  
 LEGEND & SYMBOLS

DWG NO 12618-01-199 SHT 1 OF 2 REV A

PLOT DATE Oct 21, 2014, 09:08 AM THE INFORMATION CONTAINED HEREIN IS THE CONFIDENTIAL PROPERTY OF ENERFLEX, LTD., AND IS NOT FOR PUBLICATION, AND NO PART THEREOF SHALL BE COPIED OR COMMUNICATED TO A THIRD PARTY WITHOUT AUTHORIZATION FROM ENERFLEX, LTD.

**ABBREVIATIONS**

AMB	AMBIENT	M2	SQUARE METERS
ATM	ATMOSPHERE	M3	CUBIC METERS
BW	BUTT WELD	MAX	MAXIMUM
BOP	BOTTOM OF PIPE	MAWP	MAXIMUM ALLOWABLE WORKING PRESSURE
CA	CORROSION ALLOWANCE	MCC	MOTOR CONTROL CENTER
CC	CORROSION COUPON	MDMT	MINIMUM DESIGN METAL TEMPERATURE
CS	CARBON STEEL	MIN	MINIMUM
CSC	CAR SEAL CLOSED	MM	MILLIMETER
CSO	CAR SEAL OPEN	NB	NATIONAL BOARD
CUST	CUSTOMER	NC	NORMALLY CLOSED
DB	DEADBAND	NLL	NORMAL LIQUID LEVEL
Δ	DELTA (DIFFERENTIAL)	NO	NORMALLY OPEN
DBB	DOUBLE BLOCK & BLEED	NPT	NATIONAL PIPE THREAD
DEG.C	DEGREES CELSIUS	OAL	OVERALL LENGTH
DEG.F	DEGREES FARENHEIT	OD	OUTSIDE DIAMETER
DIR	DIRECT ACTING	PB	PUSH BUTTON
EL	ELEVATION	PL	PILOT LIGHT
ESD	EMERGENCY SHUTDOWN	PLC	PROGRAMMABLE LOGIC CONTROLLER
ESDV	EMERGENCY SHUTDOWN VALVE	PPD	PINTS PER DAY
FC	FAIL CLOSED	PSIA	POUNDS / SQUARE INCH ABSOLUTE
FF	FLAT FACED	PSID	POUNDS / SQUARE INCH DIFFERENTIAL
FL	FLAT LAST	PSIG	POUNDS / SQUARE INCH GAUGE
FLG	FLANGED	REV	REVERSE ACTING
FO	FAIL OPEN	RF	RAISED FACE
FOB	FLAT ON BOTTOM	RFLX	REFLEX GAUGE
FOT	FLAT ON TOP	RO	RESTRICTION ORIFICE
FT2	SQUARE FEET	RTD	RESISTANCE TEMPERATURE DEVICE
FT3	CUBIC FEET	RTJ	RING TYPE JOINT
FV	FULL VACUUM	SCFM	STANDARD CUBIC FEET PER MINUTE
FVCP	FIXED VOLUME CLEARANCE POCKET	SCR	SILICON CONTROLLED RECTIFIER
FX	FROST EXTENSION	S/F	SEAM TO FACE OF FLANGE
HI	HIGH	SO	SLIP ON
HLL	HIGH LIQUID LEVEL	SP	SETPOINT
HP	HIGH POINT	SPC	CALCULATED SETPOINT
HPV	HIGH POINT VENT	SS	SELECTOR SWITCH
HTR	HEATER	S/S	SEAM TO SEAM
ID	INSIDE DIAMETER	SVU	SUCTION VALVE UNLOADER
KGS	KILOGRAMS	SW	SOCKET WELD
KPAA	KILOPASCAL ABSOLUTE	TC/K	THERMOCOUPLE / (TYPE)
KPAD	KILOPASCAL DIFFERENTIAL	T/L	TUBE LENGTH
KPAG	KILOPASCAL GAUGE	TS/TS	TUBESHEET TO TUBESHEET
KW	KILOWATTS	VB	VORTEX BREAKER
LBS	POUNDS	V/H	VENT HEADER
LC	LOCKED CLOSED	VTA	VENT TO ATMOSPHERE
LLL	LOW LIQUID LEVEL	VTH	VENT TO HEADER
LO	LOCKED OPEN	WCP	VARIABLE VOLUME CLEARANCE POCKET
LP	LOW POINT	W/	WITH
LPD	LOW POINT DRAIN	W/O	WITHOUT

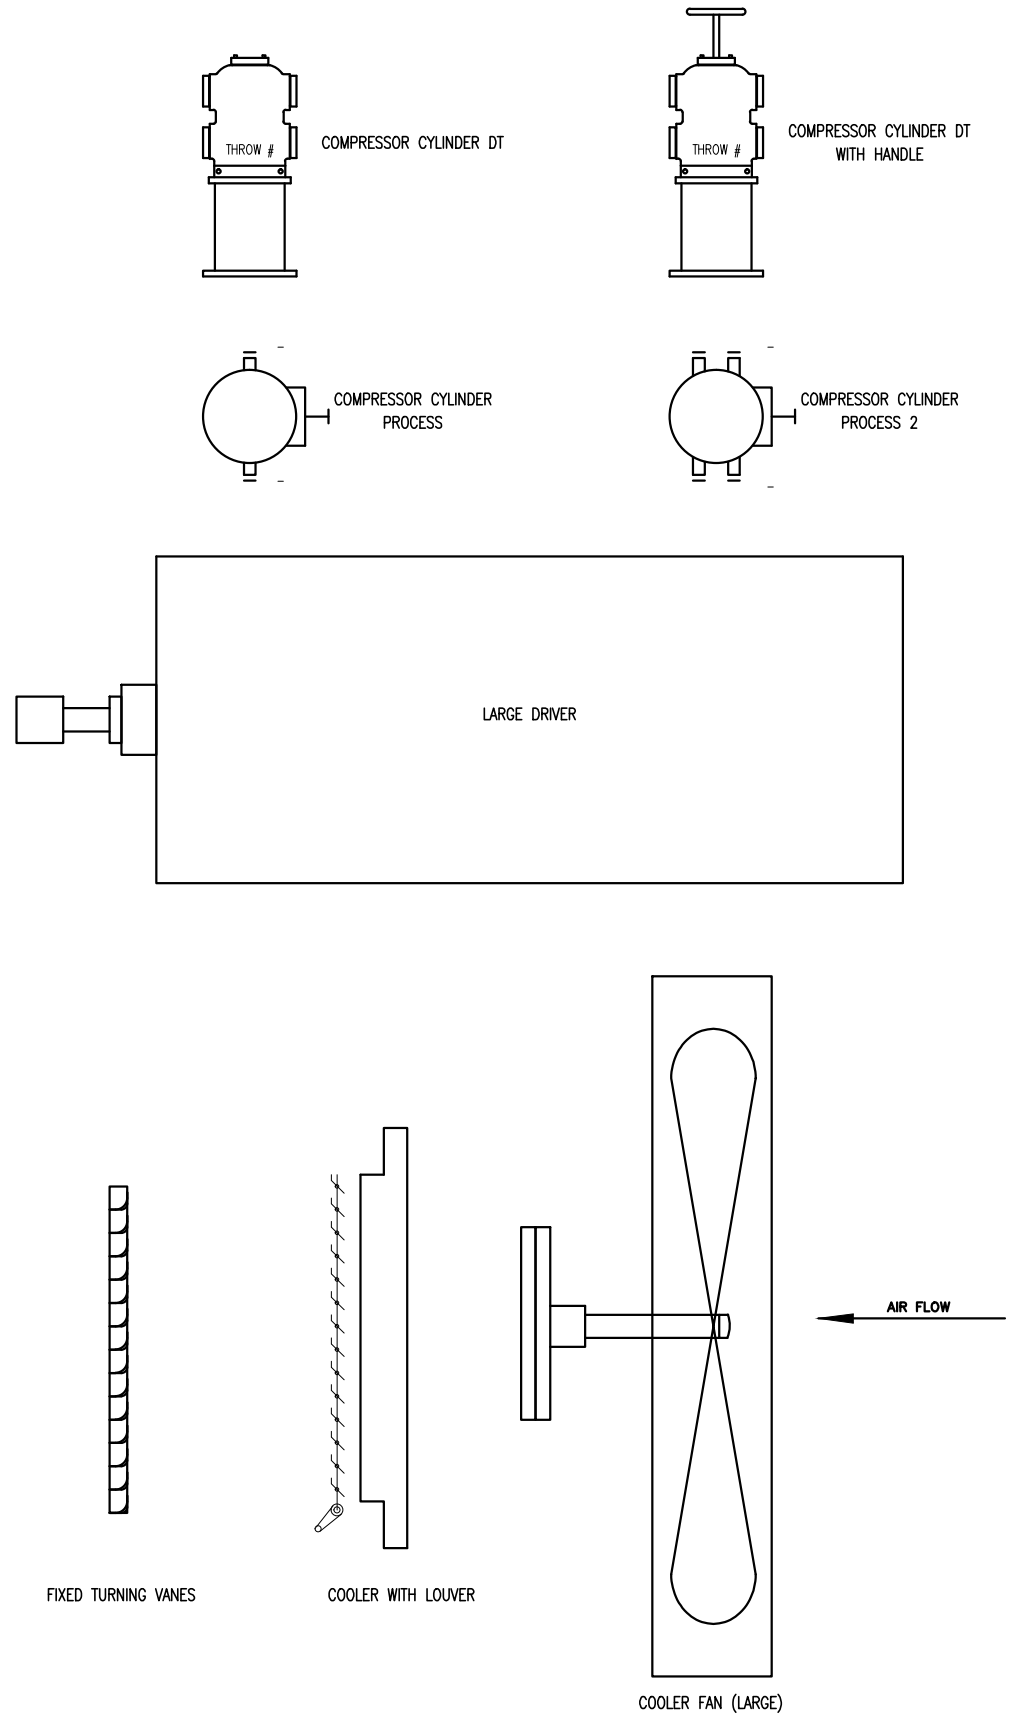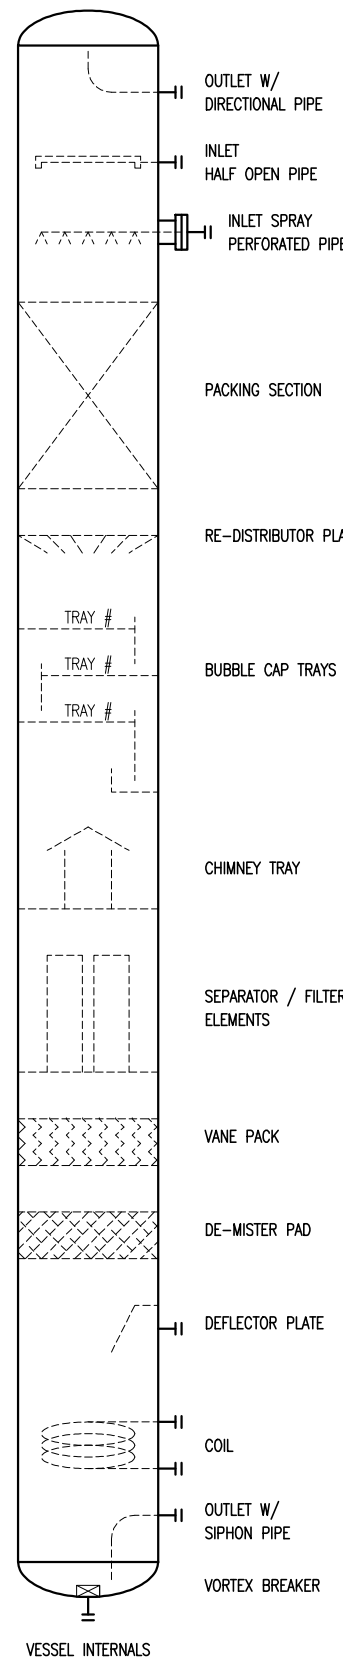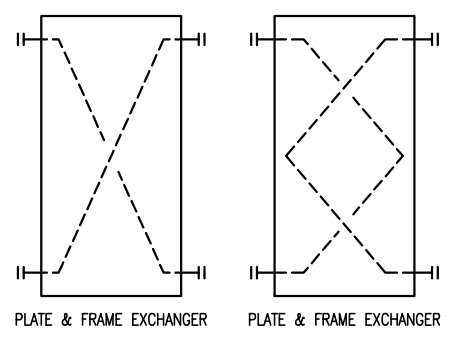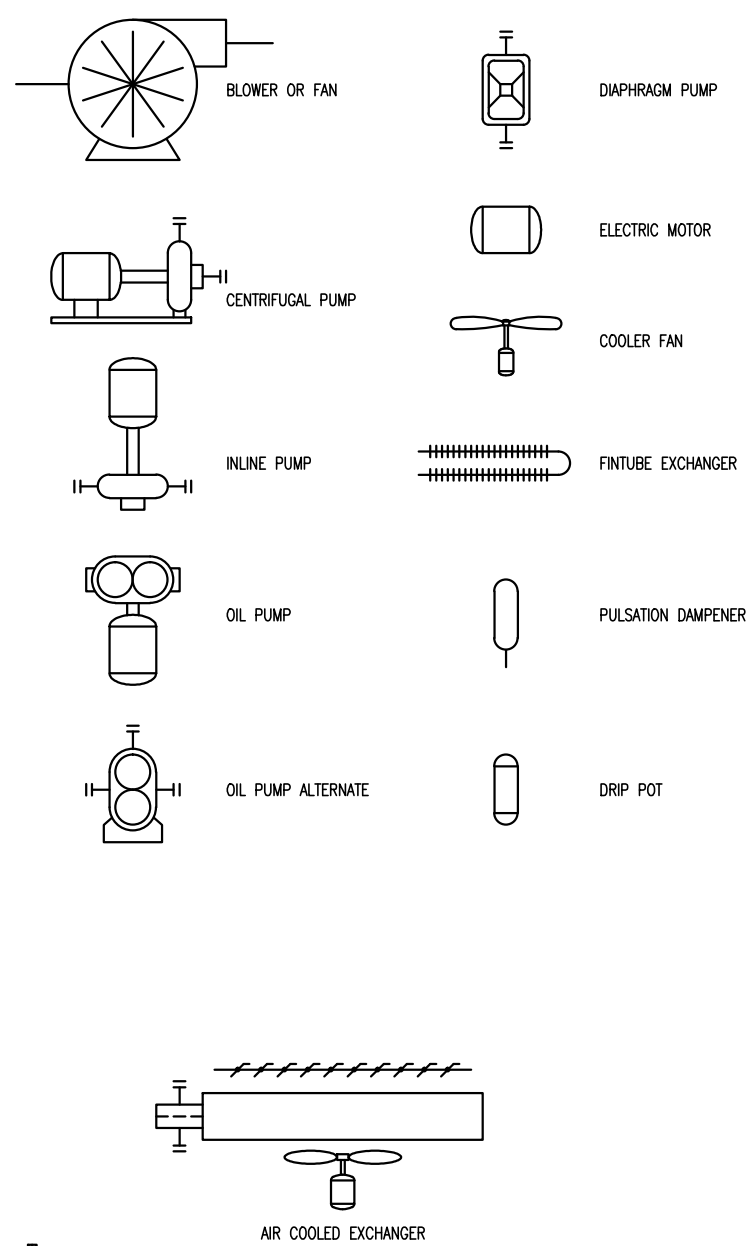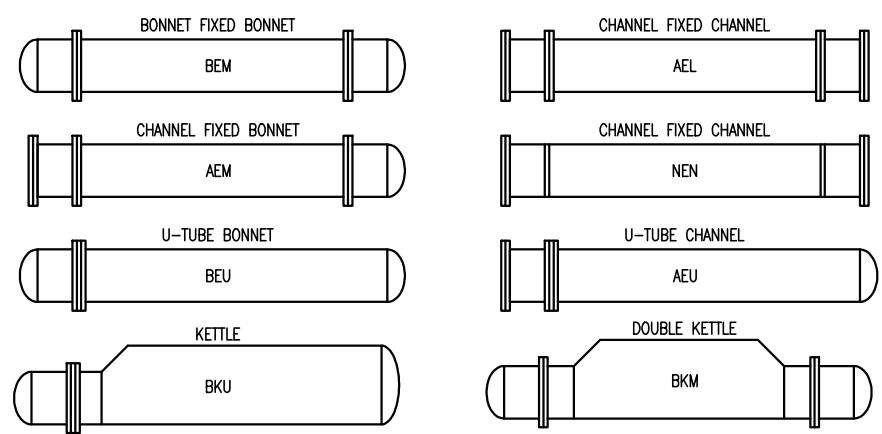

**FOR REFERENCE ONLY**  
NAME: A.HAMMOND DATE: JAN 18/13

				DATE: DEC 10/12	SCALE: NTS	DEVON CANADA FERRIER CPF		<b>ENERFLEX</b> Calgary, Alberta, Canada	P & I DIAGRAM LEGEND & SYMBOLS
				DRAWN BY: G.PAHL	CHECKED BY: S.GURI	BATTERY SCREW			
				PROJECT MANAGER: B.MINSHULL	PROJECT ENGINEER: S.GURI	CATERPILLAR G3606LE			
				CUST PO:	FRICK SGCB-3524		DWG NO: 12618-01-199		SHT: 2 OF 2
REV	DESCRIPTION	DATE	BY	APR	APEGGA PERMIT No: P8651	STEP CODE: 490 511 591	WORK ORDER: 12618-01		REV: A