


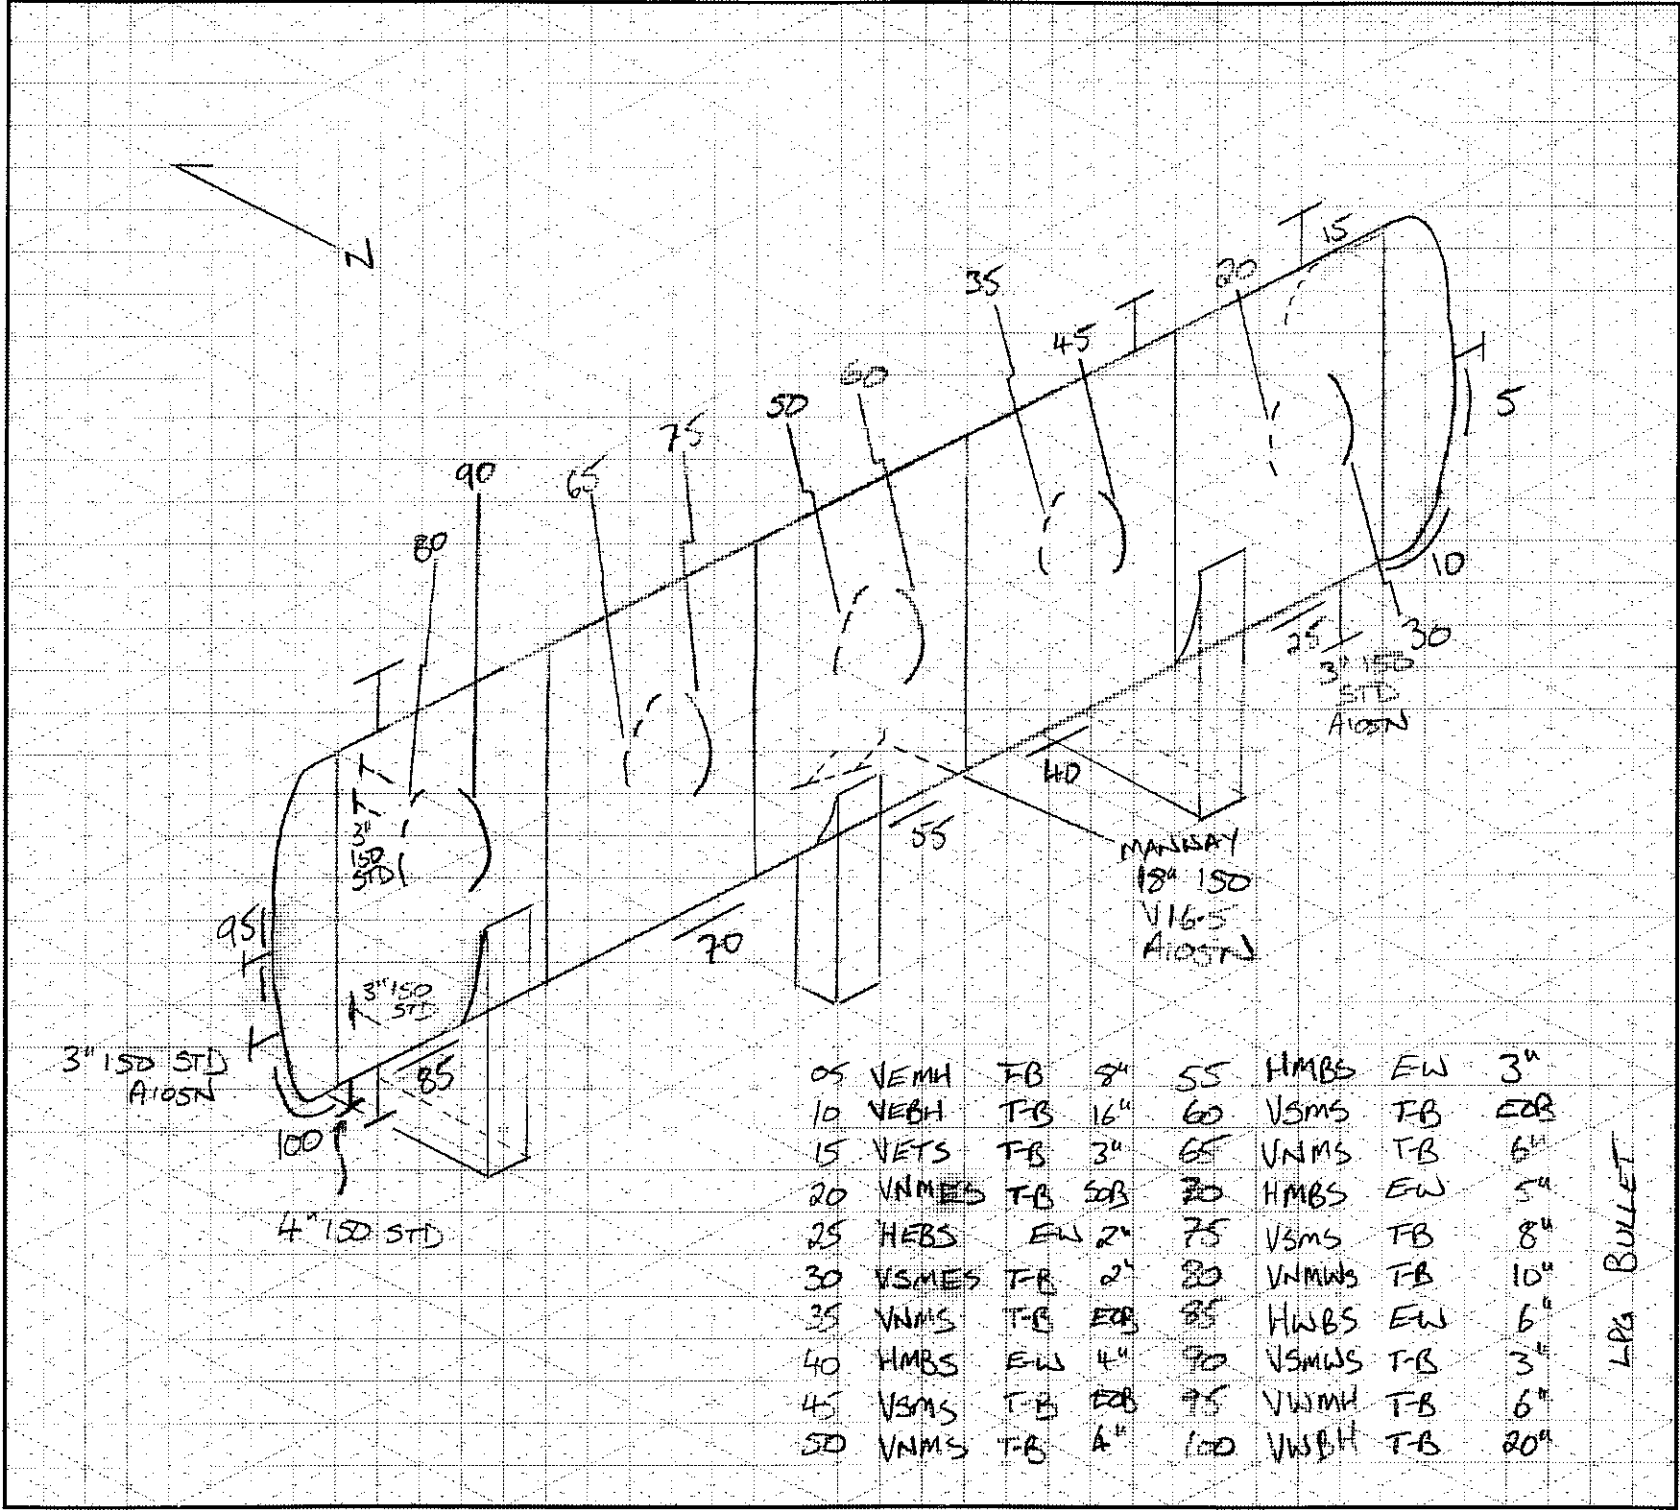

CUSTOMER: CARL FACILITY: FLOR LAKE LSD: 06-32-5503 WJ4M
P & ID: _____ DRAWN BY: _____ DATE: 28 MAY 09 DRAWING NO. _____

VESSEL INFORMATION:

Equip. No. _____ Pro. Reg. No. (A) 6818208 C.R.N. 11936-23 Serial No. 26978A Yr. Inst. _____
Code/Div. _____ Size 274340 OD X 16656mm Manufacturer: WESTERN ROBERT LTD Yr. Bld. 1985
C. Stamp: UN121A Service: GAS PWHT: NO J.E.: _____ Radiography: RT2 Insulated: NO

HEAD: _____ SHELL: _____
Top Mat'l: SA516-70 Top C.A. 0 Material: SA516-70 Nominal 19.76mm C.A. 0
Btm Mat'l: _____ Btm C.A. _____

BOOT: _____ CHANNEL: _____
Head Mat'l: _____ Head C.A. _____ Top Mat'l: _____ Top Nom.: _____ Top C.A. _____
Shell Mat'l: _____ Shell C.A. _____ Btm Mat'l: _____ Btm Nom.: _____ Btm C.A. _____
MAWP Shell Side: 1724 KPA @ Temp. 66°C MAWP Tube Side: _____ @ Temp. _____

PIPING INFORMATION:

Circuit No. _____ Line No. (s) (PLEASE PUT LINE NUMBERS ON APPLICABLE LINES ON THE DRAWING)
Piping Class _____ Yr. Bld. _____
MAWP: _____ @ Temp. _____ Size & Schedule of Piping (PLEASE PUT APPROPRIATE SIZES AND SCHEDULES OF PIPING ON DRAWING)

CAT 95.5 MS