PLANT NORTH

PLANT NORTH

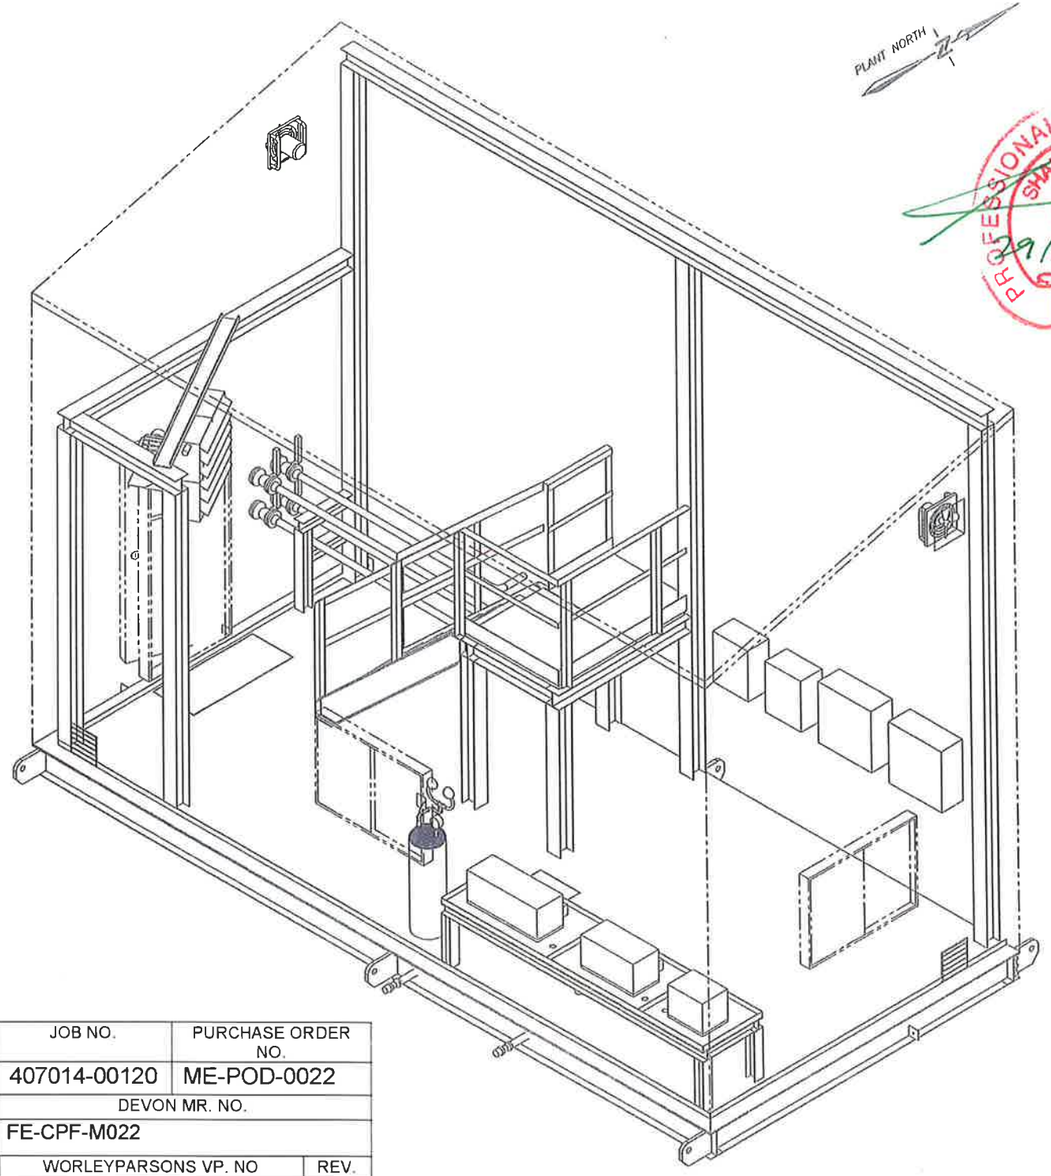

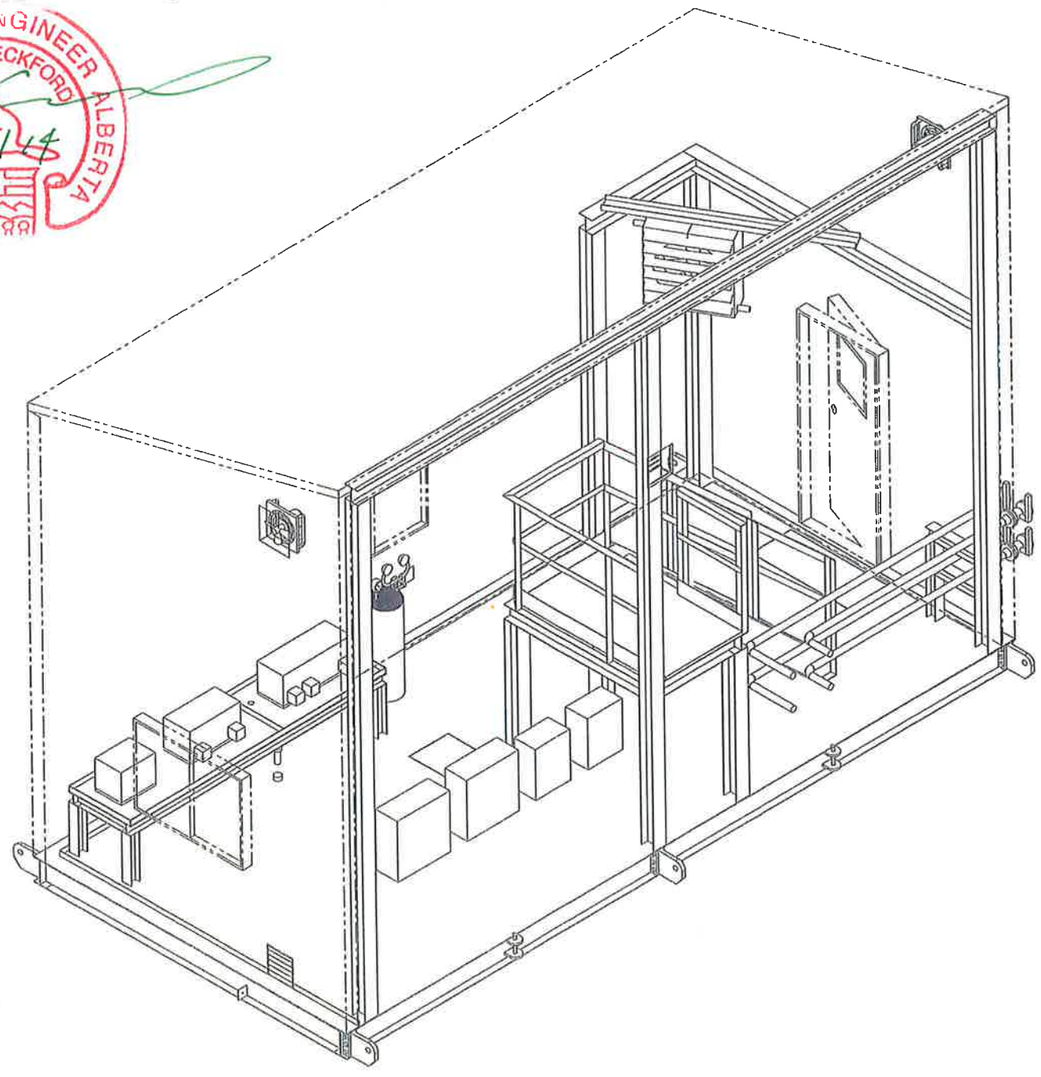

PROFESSIONAL ENGINEER ALBERTA
SHAUN ECKFORD
29/08/14

DATE	JOB NO.	PURCHASE ORDER NO.
10/02/2014	407014-00120	ME-POD-0022
VTRI-2506	DEVON MR. NO.	
	FE-CPF-M022	
EQUIP. NO.	WORLEYPARSONS VP. NO	REV.
002-PK-27-1000	407014-00120-ME-POD-0022-0188	3

NO.	REVISION	BY	CHK	DATE
1	AS BUILT	SF		09/05/14
0	ISSUED FOR CONSTRUCTION	SF		22/10/13
A	ISSUED FOR APPROVAL	BS		18/09/13

CUSTOMER REFERENCE: #407014-00120

5Blue
Process Equipment Inc.
www.5Blue.com

CUSTOMER: DEVON NEC CORPORATION

JOB NO. 5B1109-30

PROJECT:
FERRIER CENTRAL OIL BATTERY – LIQUID EXTRACTION PLANT (LEP)
LOCATION: LSD 11-02-039-08 W5M

TITLE:
CHEMICAL INJECTION PUMP PACKAGE (002-27-PK-1000)
GENERAL ARRANGEMENT – ISO VIEW

DRAWN	APP	APP	SCALE	DATE	DOC NO	SHT	REV
BS			N.T.S.	18/09/13	5B1109-02-DR-30-003	001	A

Worley Parsons
REVIEW STAMP
PROJECT NO
REVIEWED & ACCEPTED
REVIEWED & ACCEPTED AS NOTED
REVISE AS NOTED AND RESUBMIT
REVIEWED BUT NOT ACCEPTED
REVIEW NOT REQUIRED
Acceptance review of these documents does not relieve the Contractor/Supplier of responsibility for the correct and proper performance of the work, or of compliance with all Contract/Purchase Order requirements.
NAME: MH
SIGNED
DATE 17 OCT 2014