BILL OF MATERIAL

ITEM	QTY.	CODE No.	DESCRIPTION
301	1	BMU-VS2	VIB SW, MURPHY VS-2 ELECTRIC WI MANUAL RESET

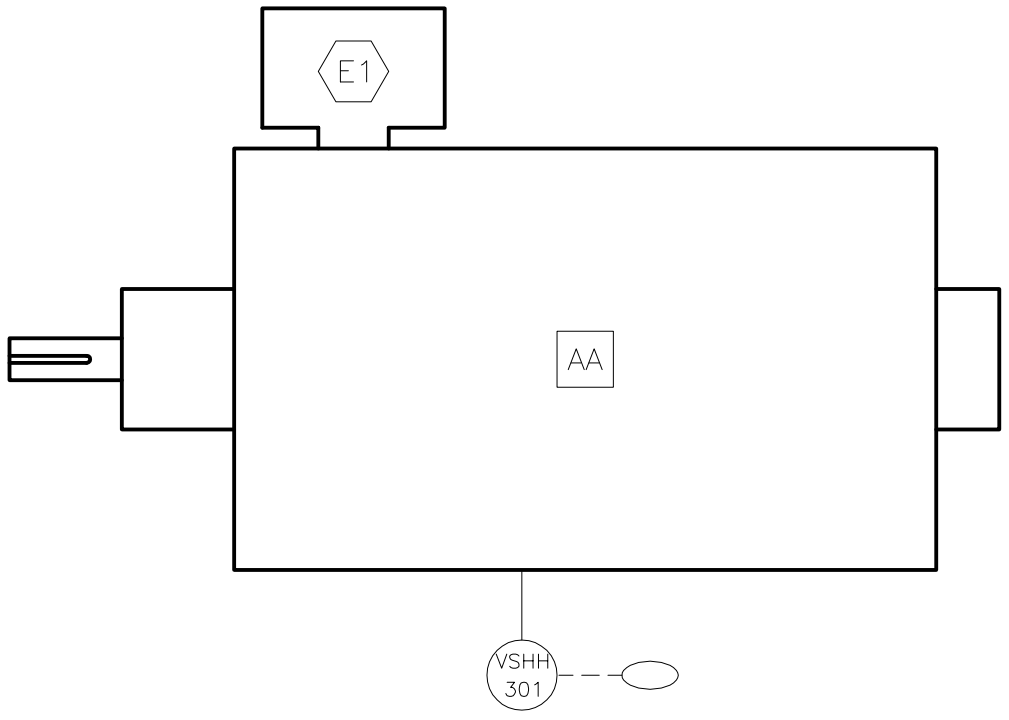

CUSTOMER CONNECTIONS:

E1 MAIN TERMINAL BOX

MAKE : TOSHIBA
FRAME: 445T
CLASSIFICATION: ODP
HP : 200
VOLTAGE: 480 VAC
PHASE: 3
FREQ.: 60
SPEED: 1800 RPM
MODEL: B2004VLF4USH
SN #: 96301956

SEE GENERAL ARRANGEMENT DRAWING (GA96044) FOR TRUE ORIENTATION.

© 1996Enerflex Systems Ltd.
REPRODUCTION OF ANY PORTION OF THESE MATERIALS WITHOUT THE EXPRESS WRITTEN CONSENT OF ENERFLEX SYSTEMS LTD. IS STRICTLY PROHIBITED. THESE MATERIALS SHALL NOT BE USED FOR ANY PURPOSE OTHER THAN THE REPAIR AND MAINTENANCE OF THE PRODUCTS TO WHICH THEY RELATE.

CAD
MAKE NO REVISIONS TO THIS REPRODUCIBLE.

FILENAME: --.DWG | ISSUE#: 0
LAST DRAWING SAVE DATE:

ENERFLEX SYSTEMS LTD.

CUSTOMER: CRESTAR ENERGY INC. LITTLE BOW, ALBERTA
JOB No.: 96044

Rev.	Description	By	Date
2	AS BUILT	T.T.	96-08-14
1	ISSUE FOR CONSTRUCTION	T.T.	96-06-17
0	FOR APPROVAL	DKW	96-06-07

ORIG DWN BY: DLL
DATE: 96/06/06
APPR'D BY:
DATE:

TITLE: STANDARD SCHEMATIC
ELECTRIC MOTOR EQUIPMENT & CONTROLS
DWG. SF96044C | OPER'N#: 24

96/08/14 16:10