

BILL OF MATERIAL


ITEM#	QTY	CODE No.	DESCRIPTION
001	2	WFM-4409	TERMOCOUPLE, ALTEMP MODEL SC-AP-24-VS-12-SS-14-UK-2.15
002	2	WFM-4410	THERMowell, ALTEMP MODEL J24-040-260
003	2	WFT-2600R	LCI 2" WFT FISHER 2600A-61 MAKE PVC DISPLACER C/W PT
004	2	WFT-129P2	WFT FISHER 129P2-418 CS SOUV 1/4" OR. NC. 0-20 PSI
005	2	WFM	LEM SW. MONITORIAL 1005 MDL 1018 BVS. 2" XP. SOUV TRAIL.
006	2	B04-489AW	C/W EXTENSION ASBL
007	2	B04-15006	LVI GAUGE, DANIEL M&B MAKE CS W/ BRFLX FLAT GLASS 2600A
008	6	WFT-007	SET GAUGE TEL. DANIEL M&B MAKE. 3/4" WPT. CS. 3730A
009	2	WML-17X314	REQ. 1/4" FISHER H81/AR-362, 3-35 PSI (NO P1)
010	1	WML-17X310	BALL VALVE, WML B136-CSS-02-52 RL 1/2" RP MAKE/LATCH HANDLE
011	1	WML-17X300	BALL VALVE, WML B136-CSS-02-52 RL 1/2" RP MAKE/LATCH HANDLE
012	1	BCO-1992S	CONSOLIDATED PSY, 1992C-S0 1-1/2" FNPT X 1-1/2" WPT. MAKE
013	1	BCO-1993S	SET @ 50 PSIG
014	1	WFM-4407	CONSOLIDATED PSY, 1993C-S0 1" WPT X 1-1/2" FNPT. 292"OR. MAKE
015	1	WFM-4407	CONTROL VALVE, FISHER 657-0-24, 1" WPT LCC BODY 3/4" OR
016	2	WML-150204	ROUNDELTY OPEN, 6-30PSI MAKE
017	4	WML-5012	TEMP CONT. MONITORIAL 5000, INDIRECT 1" W/ 12" PROBE
018	4	WML-1416	AUTO LOUVER ACTUATOR GAZDO, MOUNTED BY AIR-X
019	4	WML-17X12	THERMowell, 12" X 1" WPT. 2000 PSIG WAMP, 316SS
020	2	WML-481X14	PISTON CHECK VALVE, 1-1/2" WPT MENO 481E24-3 800W MKG MAKE+
021	1	WML-2012	ROUNDED STEEL HOSE, 2" WPT ENDS, 12' LONG
022	1	WML-1412	ROUNDED STEEL HOSE, 1-1/2" WPT ENDS, 12' LONG
023	1	WML-102	VIA SW. WAMPV VS-2 ELECTRIC W/ MANUAL RESET
024	1	WML-0011	CONE STRAINER, 6"-150W CS, 100W ABEA, 316SS, 40 MESH, SOV STD
025	1	WML-0411	CONE STRAINER, 4"-150W CS, 100W ABEA, 316SS, 40 MESH, SOV AS
026	4	WML-17X306	BALL VALV, WML B136-CSS-02-52 RL 1/2" RP MAKE W/ LATCH HANDLE
027	4	WML-17X310	BALL VALV, WML B136-CSS-02-52 RL 1/2" RP MAKE W/ LATCH HANDLE
028	1	WML-04	THERMowell, 1/2" X 3/4" WPT X 4" LONG 304SS, U = 2.12"
029	1	WML-30401	THERMowell, 1/2" X 3/4" WPT X 4" LONG 304SS, U = 2.12"
030	1	WML-002	THERMowell, 1/2" X 3/4" WPT X 2-1/2" LONG 304SS, U = 1"
031	1	WML-30251	TJ, TEND 3025 2-1/2" STEEL BW 3" D DUAL 0-250 DEG. F
032	2	WML-4403	BALL VALVE, WML B136-CSS-02-52 RL 1/2" RP MAKE, FILL PORT
033	1	WML-4408	CONTROL VALVE, FISHER 657-0-40, 2"-300W RP C/W 4590
034	1	WML-4408	HILO PRESSURE FLOW, MAKE, 3-15 PSI
035	4	WML-02C006	P1, WML T11.10, Z, BW 1/4" DUAL 0-60 PSI
036	4	WML-08	WFT BROCKET - FISHER 671W DMG, 9.6035
037	6	WML-20VS	NEBLE VALVE, WHITEY S-1154, 1/4" TBE CS
038	4	WML-0202X	VALVE, CENTURY CVC-2-WFT-B-4, 3/4" WPT X 1/2" WPT CS MAKE

GENERAL NOTES

- THIS DRAWING IS NOT TO BE USED FOR CONSTRUCTION UNLESS SIGNED AND RELEASED FOR MANUFACTURE.
- ALL PROCESS PIPING TO BE CLAIMED AS NEAR TO ALL ELBOWS AS POSSIBLE.
- REFER TO DRAWING 12-8006.
- FOR DESIGNER PARAMETERS REFER TO PROJECT SCOPE SUMMARY DRAWING, SS99044.
- FOR CUSTOMER CONNECTIONS REFER TO GENERAL ARRANGEMENT DRAWING, 0490044.
- PIPE WIPERS 1-1/2" AND SMALLER TO BE W/IN. XXH WALL THICKNESS.

CAD
MAKE ALL REFERENCES TO THIS DRAWING

LEGEND

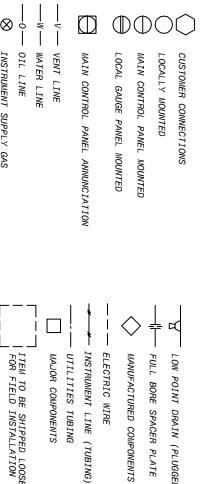

REV	DESCRIPTION	DATE	DRAWN BY	CHECKED BY
3	AS BUILT	98-08-14	T.T.	
2	RE-ISSUE FOR CONSTRUCTION	98-06-27	T.T.	
1	ISSUE FOR CONSTRUCTION	98-06-17	T.T.	
0	FOR APPROVAL	98/06/06	DLL	

ENERFLEX Manufacturing

ENERFLEX SYSTEMS LTD.
 ENKONTON
 4949, 76 Avenue SE.
 Calgary, Alberta
 T2C 0S8

CONSULTANT: VISTA PROJECTS
 150, 15th Avenue SW
 Calgary, Alberta
 T2C 0S8

FOR: CRESTAR ENERGY INC.
 (LITTLE BOW)

TITLE: PROCESS & INSTRUMENTATION DIAGRAM
 AREA: JGA/2, TOSHIBA 200DP, AIR-X-CHANGERS 72EH
 COMPRESSOR PACKAGE

DATE: 98/06/04
 DWG. No.: P96044
 OPER. No.: 30

© 1996 Enerflex Systems Ltd. THESE MATERIALS ARE THE PROPERTY OF ENERFLEX SYSTEMS LTD. ANY REPRODUCTION OF ANY PORTION OF THESE MATERIALS WITHOUT THE WRITTEN CONSENT OF ENERFLEX SYSTEMS LTD. IS PROHIBITED. THIS DRAWING IS TO BE USED FOR THE REPAIR AND MAINTENANCE OF THE PRODUCTS OF ENERFLEX SYSTEMS LTD.