
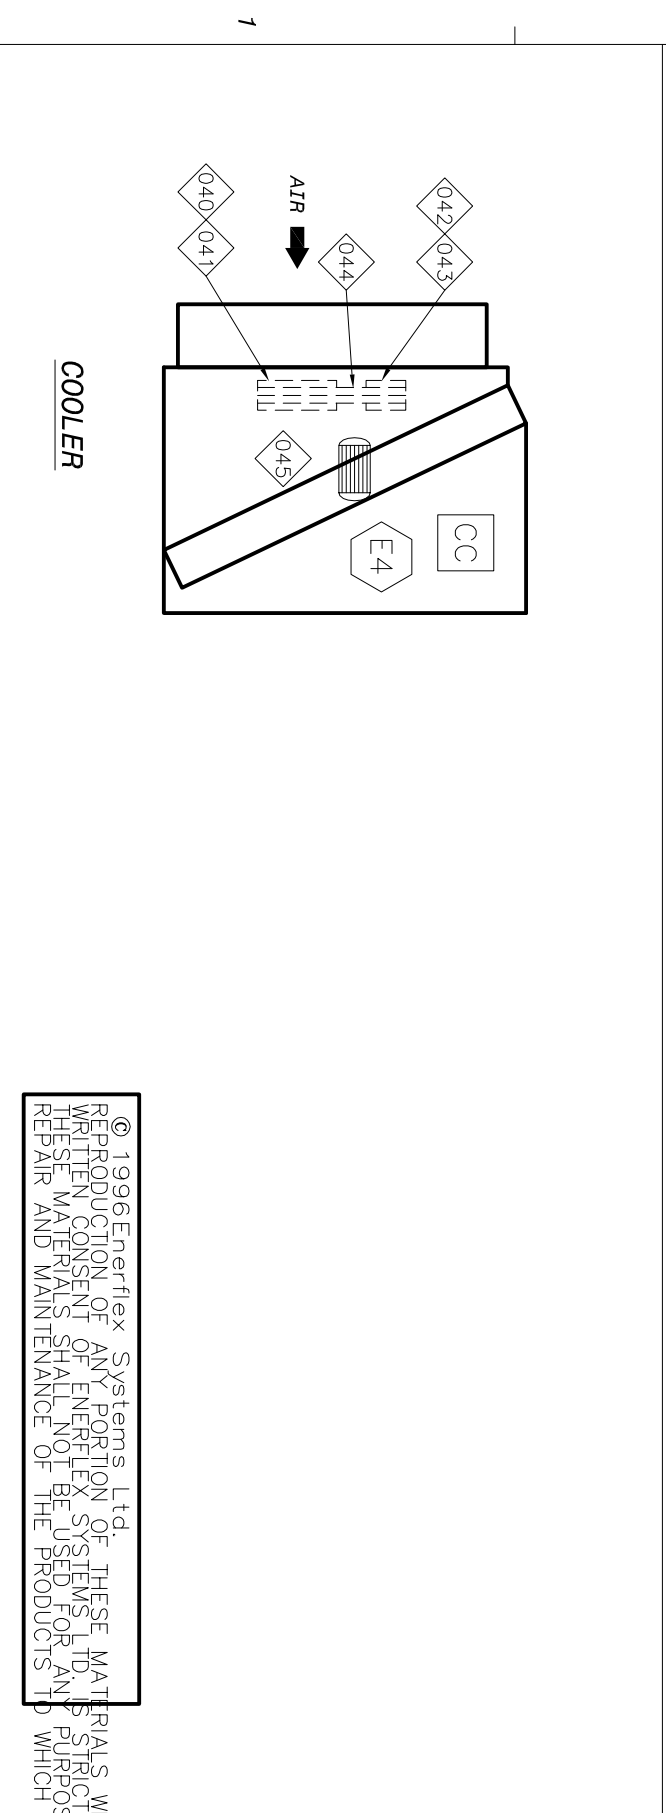
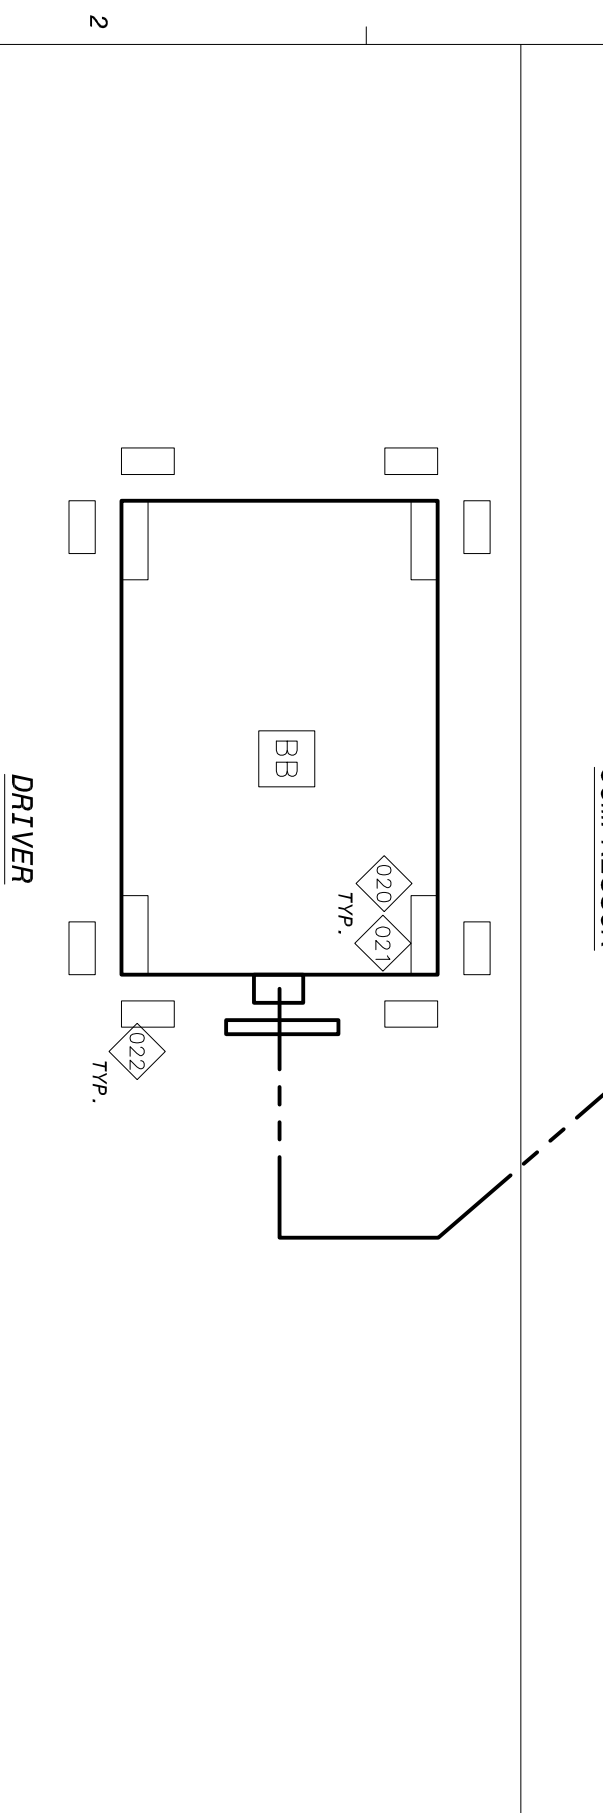


# BILL OF MATERIAL

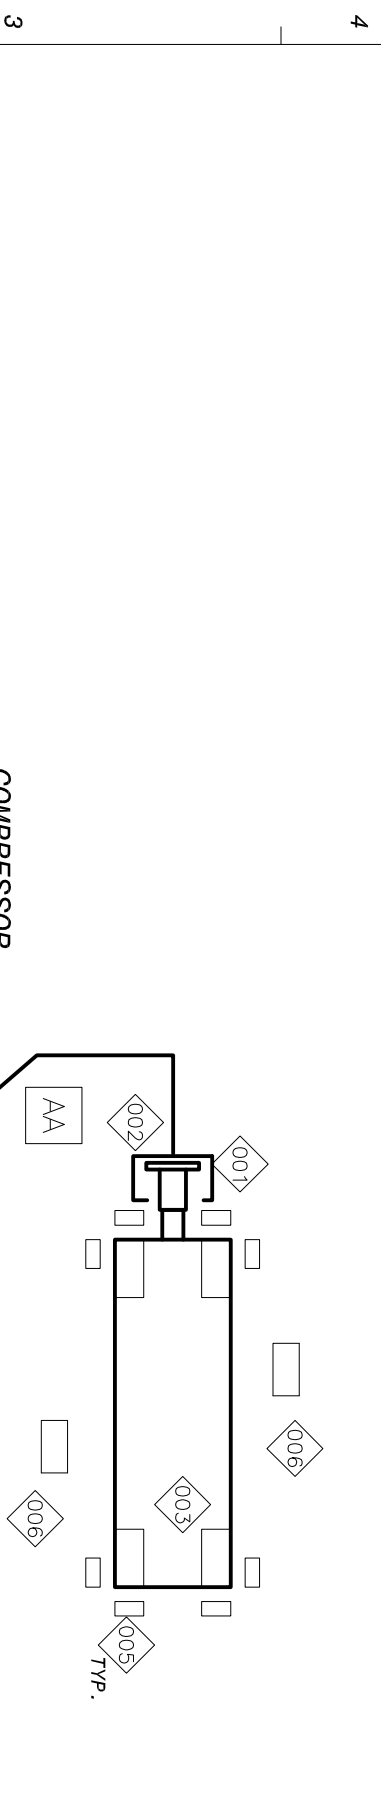

ITEM	QTY.	CODE No.	DESCRIPTION
001	1	BFO-H35	CPLG, FORMFLEX 35-HSH WI FINISH BORE HUBS
002	1	ENB-2F	HUB BORE: 2.623" +/- .001" KEY WAY: 5/8" X 5/16"
003	1	XCOUPLINGUA	COUPLING GUARD
004	4	X-MOUNT-COMP	FRAME CORNER MOUNTING BLOCKS
005	1	MPV	SET JACKING BLOCKS
006	2	AAR-GSH	DISTANCE PIECE SUPPORTS
AA	4	X-MOUNT-ENG.	SET MOUNTING PADS
020	4	X-MOUNT-ENG.	SET MOUNTING PADS
021	4	X-SHIMS	SET OF SHIMS
022	8	MPV	SET JACKING BLOCKS
040	1	ZPNP6-4402	SHEAVE, (BY AIR-X-CHANGERS)
041	1	ZPNP6-4403	BUSHING, (BY AIR-X-CHANGERS)
042	1	ZPNP6-4402	SHEAVE, (BY AIR-X-CHANGERS)
043	1	ZPNP6-4403	BUSHING, (BY AIR-X-CHANGERS)
044	1	X-BELT-COOLER	V-BELT SET, (BY AIR-X-CHANGERS)
045	1	ZPNP6-4404	ELECTRIC MOTOR, 10HP, 1800RPM, 3/60/230-460V, XP,CSA, BY AIR-X-CHANGERS

© 1996 Enerflex Systems Ltd.  
 REPRODUCTION OF ANY PORTION OF THESE MATERIALS WITHOUT THE EXPRESS WRITTEN CONSENT OF ENERFLEX SYSTEMS LTD. IS STRICTLY PROHIBITED. THESE MATERIALS SHALL NOT BE USED FOR ANY PURPOSE OTHER THAN THE REPAIR AND MAINTENANCE OF THE PRODUCTS WHICH THEY RELATE.

FILENAME: <b>---.DWG</b> LAST DRAWING SAVE DATE: <b>96/06/27 11:46</b>	ISSUES: <b>0</b>	 ENERFLEX SYSTEMS LTD.	CUSTOMER: <b>CRESTAR ENERGY INC.</b> <b>LITTLE BOW, ALBERTA</b>	JOB No.: <b>96044</b>	AS BUILT RE-ISSUE FOR CONSTRUCTION ISSUE FOR CONSTRUCTION FOR APPROVAL	T. T. <b>96-08-14</b> T. T. <b>96-06-27</b> T. T. <b>96-06-17</b> DWG <b>96-06-07</b>	ORG DWN BY: <b>DLL</b> DATE: <b>96/06/06</b>	TITLE: <b>DRIVE TRAIN EQUIPMENT</b>	DWG: <b>SF96044F</b>	OPER#N#: <b>28</b>
---	------------------	---------------------------	--	-----------------------	---	--	---	-------------------------------------	----------------------	--------------------