


P&ID # _____
REF. # _____

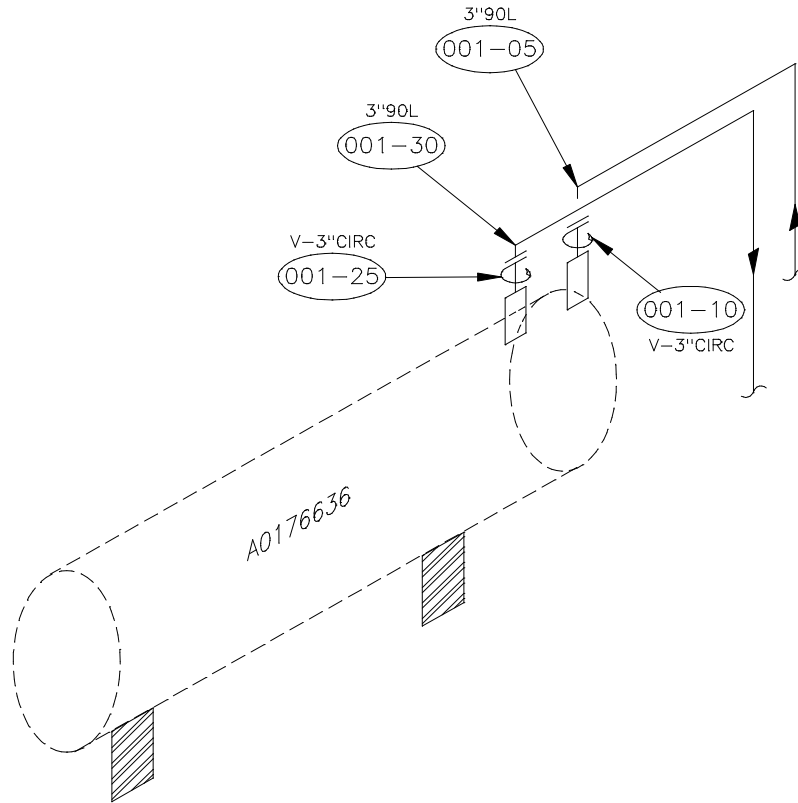

PIPING DATA

THICKNESS MEASUREMENT LOCATION:	SIZE	PROC.	LINE #	SPEC.	SCH.	NOM.THK.	ASTM * CORR. ALLW. ** CALCULATED CORR. ALLW.	MIN.THK.	CAL.THK.	FLG. RATING
001-05/30	3"				80	7.6mm	ASTM	6.7mm		
001-10/25	3"				80	7.6mm	1.6mm	6.0mm		

COMMENTS: 2011/02 - OUT OF SERVICE

APACHE CORPORATION
CHINCHAGA GAS PLANT
UNIT #1 - COMMON UTILITIES

SALT BATH HEATER (EAST) PIPING

TECH.: M.M.	REV.DATE: 2011/02	DWG.DATE: 2000/05
CAD: A.L.	REVISION: 2	DRAWING: 001A