


P&ID # \_\_\_\_\_  
REF. # \_\_\_\_\_

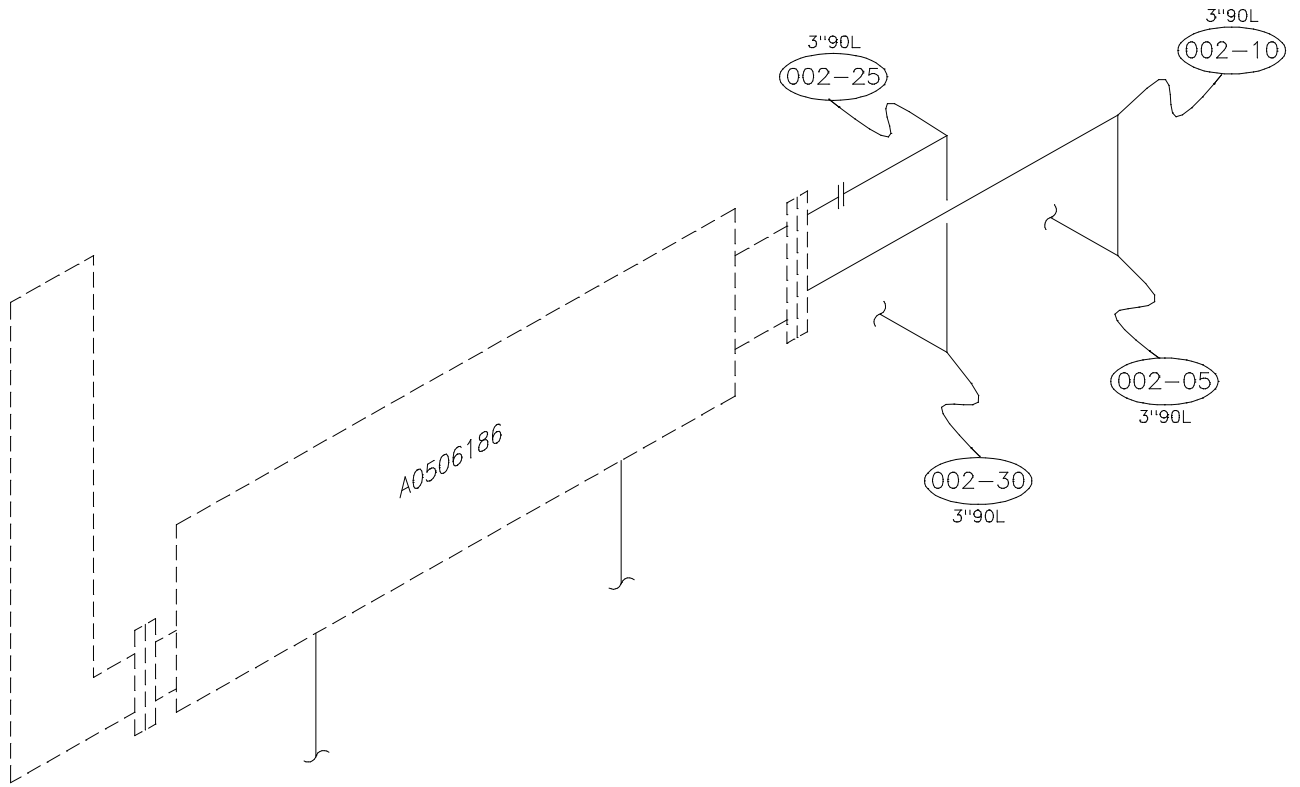

### PIPING DATA

THICKNESS MEASUREMENT LOCATION:	SIZE	PROC.	LINE #	SPEC.	SCH.	NOM.THK.	ASTM * CORR. ALLW. ** CALCULATED CORR. ALLW.	MIN.THK.	CAL.THK.	FLG. RATING
002-05-30	3"				80	7.6mm	ASTM	6.7mm		

COMMENTS: 2011/02 - OUT OF SERVICE

---



---



---

APACHE CORPORATION  
CHINCHAGA GAS PLANT  
UNIT #1 - COMMON UTILITIES  
LSD 01-24-096-05W6M

SALT BATH HEATER PIPING

TECH.: M.M.	REV.DATE: 2011/02	DWG.DATE: 2005/04
CAD: A.L.	REVISION: 1	DRAWING: 002A