


TML	Description	SOB
05	HO2IE W-N	SOB
10	VTNH T-B	@kucukle
15	VTNUS T-B	2"
20	VOI T-B	6"
25	VPMUS T-B	8"
30	VLLS T-B	SOB
35	VLLS T-B	SOB
40	VBSH T-B	1"
45	VO2LN T-B	2"
50	VO2DE T-B	3"
55	VO2OE T-B	SOB

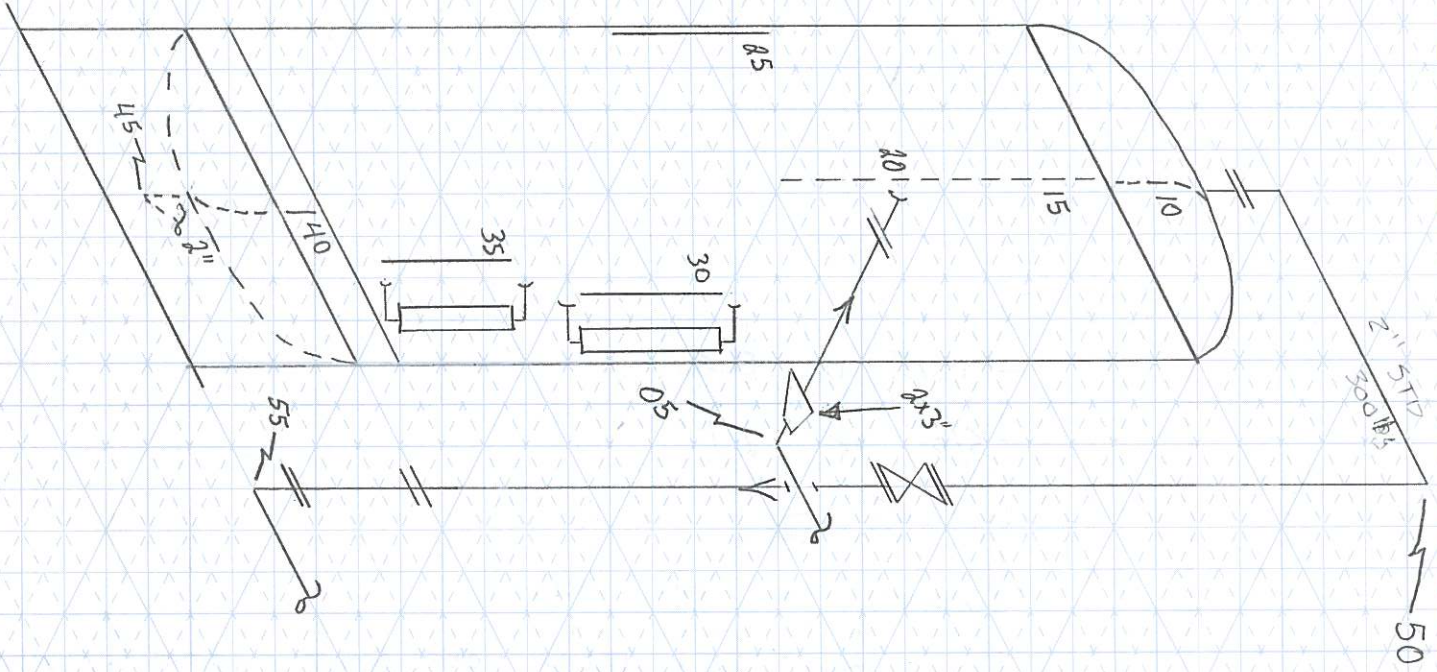

TEST SEPARATOR

CUSTOMER: CML FACILITY: Dawson LSD: 01-05-090-16W5
 P & ID: _____ DRAWN BY: Nes F. DATE: 13 MAY 09 DRAWING NO. 36

VESSEL INFORMATION:
 Equip. No. _____ Pro.Reg.No (A) 0425927 C.R.N. K1930.2 Serial No 214924 Yr. Inst. _____
 Code/Div. _____ Size: 30" ID/OD X _____ Manufacturer: Bromely Yr. Blt. 2002
 C. Stamp U Service: SWEET PWHT: NO J.E.: _____ Radiography: RT-2 Insulated: NO

HEAD:
 Top Mat'l _____ Top Nom 0.750" Top C.A. 0.0625" SHELL: Material _____ Nominal 0.875" C.A. 0.0625"
 Btm Mat'l _____ Btm Nom. _____ Btm C.A. _____

BOOT: Head Mat'l _____ Head Nom _____ Head C.A. _____ CHANNEL: Top Mat'l _____ Top Nom. _____ Top C.A. _____
 Shell Mat'l _____ Shell Nom. _____ Shell C.A. _____ Btm Mat'l _____ Btm Nom. _____ Btm C.A. _____
 MAWP Shell side: 720 PSI @ Temp. 100°F MAWP Tube Side: _____ @ Temp. _____

PIPING INFORMATION:
 Circuit No. _____ Line No. (s) (PLEASE PUT LINE NUMBERS ON APPLICABLE LINES ON THE DRAWING)
 Piping Class _____ Service: _____ Yr. Blt. _____
 MAWP: _____ @ Temp. _____ Size & Schedule of Piping (PLEASE PUT APPROPRIATE SIZES AND SCHEDULES OF PIPING ON DRAWING)

A0425927 UT Readings
Readings in Inches

	PNT 1	PNT 2	PNT 3
LOC 5	0.155	0.186	0.171
LOC 10	0.727	0.783	0.744
LOC 15	0.892	0.898	0.892
LOC 20	0.888	0.895	0.892
LOC 25	0.890	0.897	0.892
LOC 30	0.887	0.896	0.894
LOC 35	0.888	0.895	0.891
LOC 40	0.754	0.806	0.762
LOC 45	0.365	0.379	0.376
LOC 50	0.223	0.230	0.223
LOC 55	0.168	0.191	0.174