


- V-1000 INLET SEPARATOR
 - V-1200 FUEL GAS SCRUBBER
 - F-1020 FUEL GAS FILTER
 - P-3410/3420/3430 METHANOL PUMP
 - F-3411/3421/3431 COALESCING FILTER
 - BH-1300/1310 BUILDING HEATER
 - F-3412/3422/3432 DESSICANT FILTER
- 10KW Elec. heater was installed.

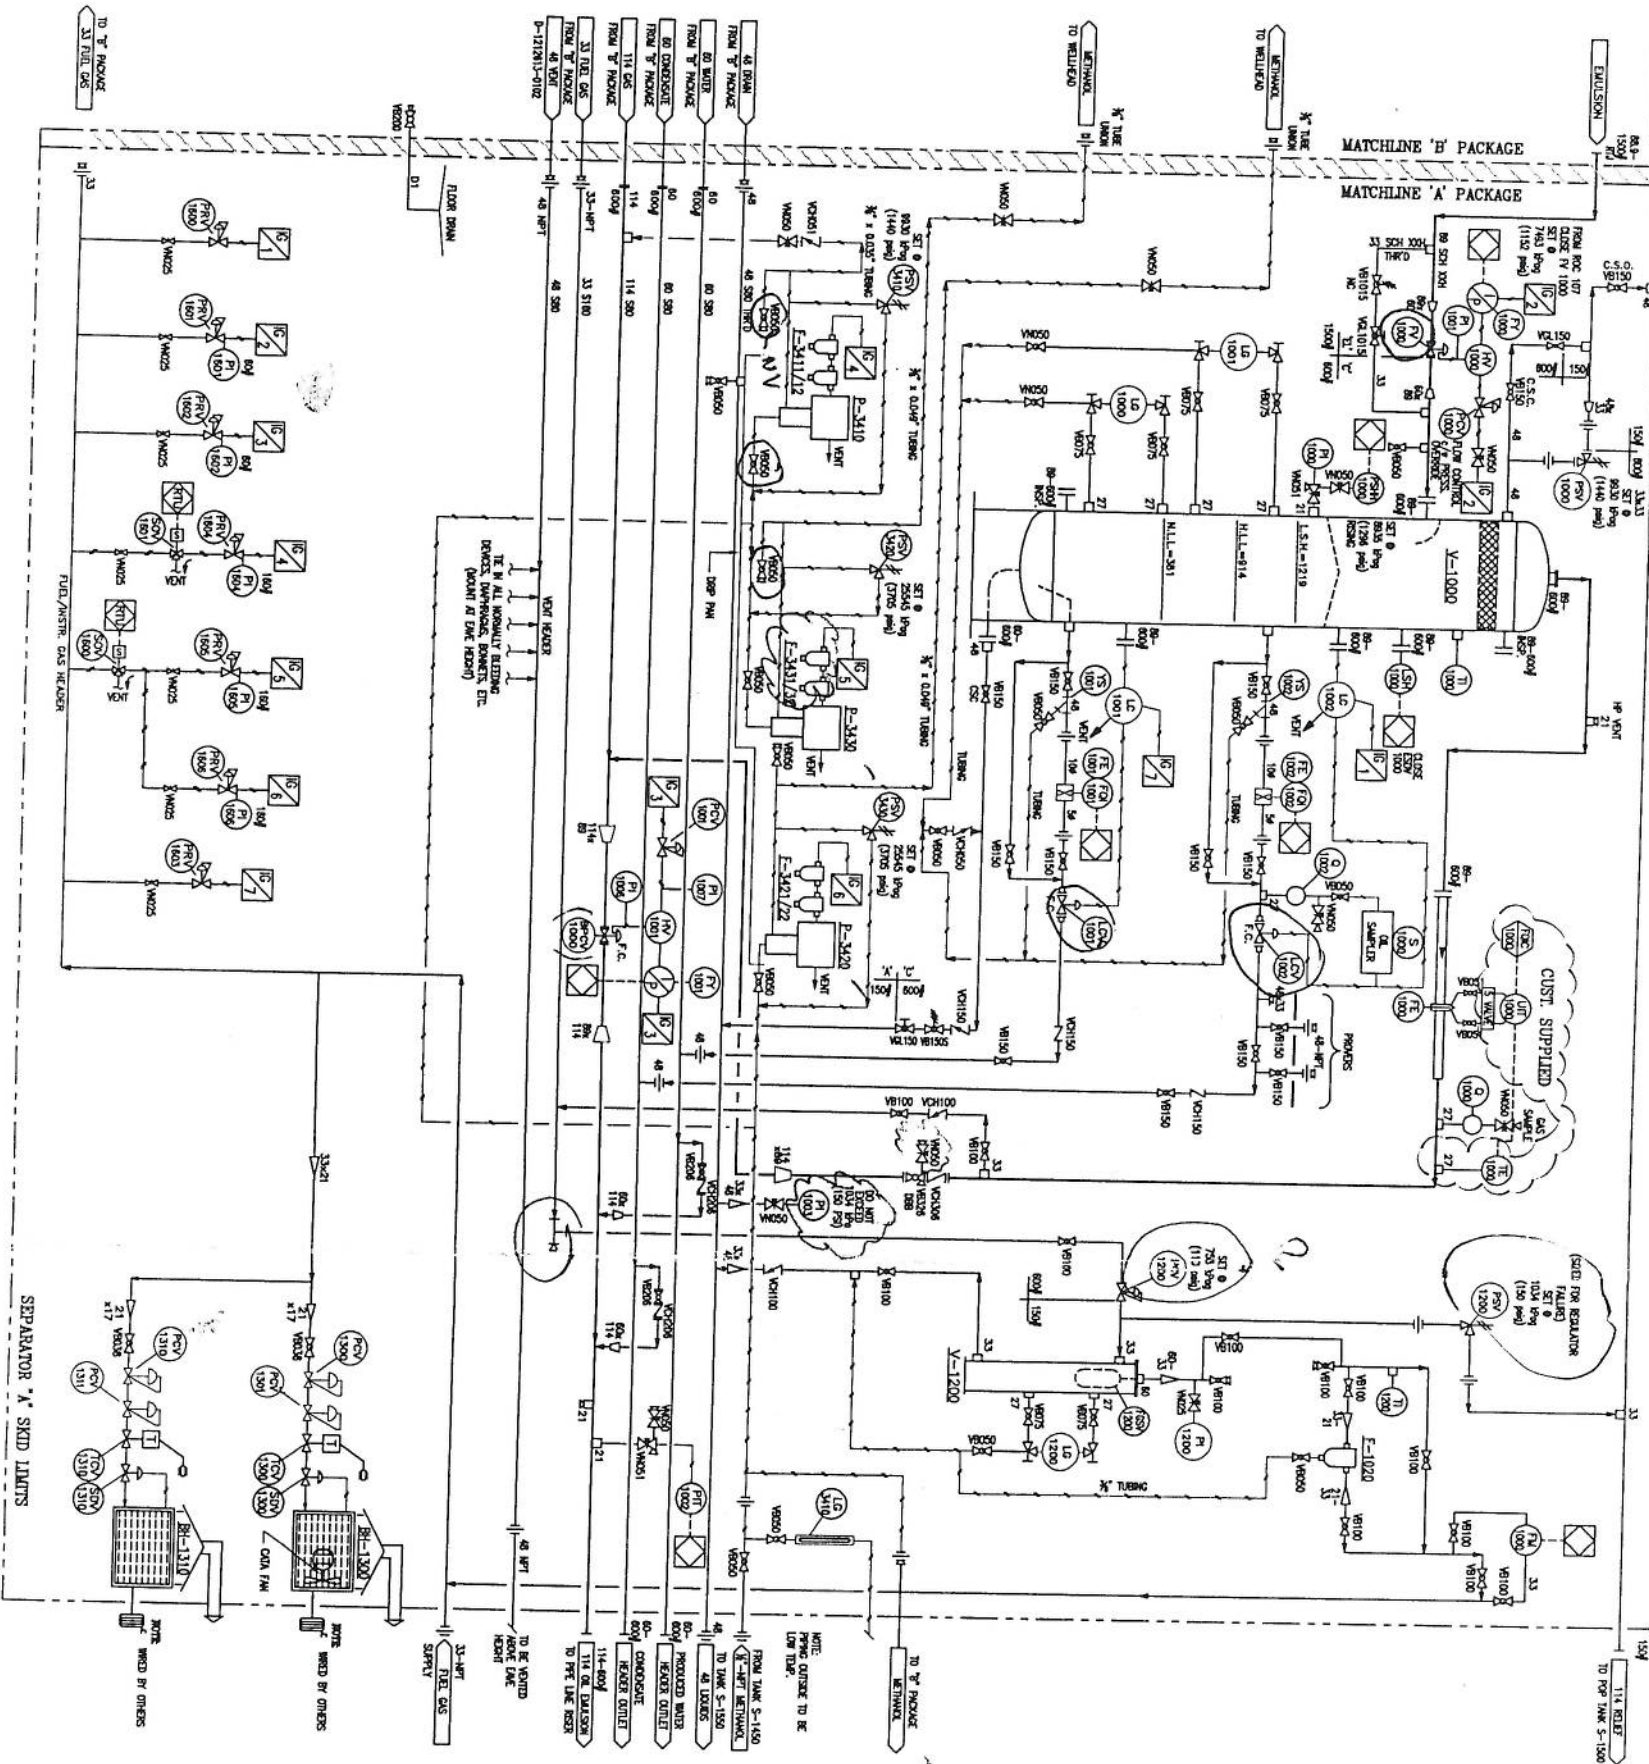

ITEM	QTY	REMARKS
BH-1300	1	BUILDING HEATER
BH-1310	1	BUILDING HEATER
F-1020	1	FUEL GAS FILTER
F-3411/3421/3431	3	COALESCING FILTER
F-3412/3422/3432	3	DESSICANT FILTER
P-3410/3420/3430	3	METHANOL PUMP
V-1000	1	INLET SEPARATOR
V-1200	1	FUEL GAS SCRUBBER


MOSS FABRICATION LTD.
 CALGARY ALBERTA
 mossfab@mossfabrication.com
 TYPE 'A' SEPARATOR PACKAGE - 8 & -9 ONLY
 DEVON P.O. 4100001027 - RACHEL
 SEPARATOR SKID V-1000 P&ID

RELEASED FOR FABRICATION
 JAN - 7 2013

NO.	DATE	BY	DESCRIPTION
1	JAN 07/13	AGL	ISSUED FOR CONSTRUCTION
2	JAN 07/13	AGL	REVISED FOR CONSTRUCTION